
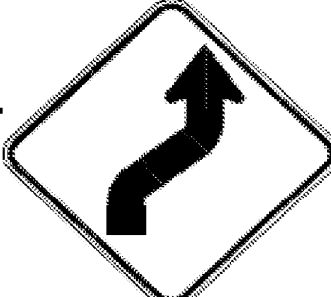






DIRECTION	MILEPOINT	LOCATION CODE (SHEET 2)	SIGN CODE	WIDTH (IN)	HEIGHT (IN)	SHEETING REMARKS	SIGN LEGEND FOR ALL POST LENGTHS AND INSTALLATION DATES SEE ORIGINAL RECORD PLANS	NEW SIGNS		EXISTING SIGNS			EXIST POST		NUMBER OF NEW POSTS	SQUARE STEEL (IN) (LB / FT)			TUBULAR STEEL Ø (IN) (LB / FT)				SIGN FRAME REQUIRED	REMARKS	SIGN DETAIL					
								"A"	"B"	RETAIN	SALVAGE FROM	SALVAGE TO	REMOVE	RETAIN		REMOVE	1.75	2.00	2.50	FOUNDATION	3.00	3.50			4.00	5.00	DETAIL IN SHS	DETAIL ON SHEET NUMBER	DETAIL ON STD SHEET NUMBER	
																	1.88	2.42	3.35		7.60	9.00			10.80	14.60				
SHARON VT14							FY-FLUORESCENT YELLOW FYG-FLUORESCENT YELLOW GREEN															"SHS"-STANDARD HIGHWAY SIGNS								
	NB	0.000																						(SEE SHEET 29)						
	NB	0.008	C	VR-017	24	30	LEGAL LOAD LIMIT 24,000 LBS			1														SHAREHART RD TH-43						
	NB	0.014	D	R1-1	30	30	STOP			1																				
	NB	0.600	A	VW-054	30	30	HIDDEN DRIVE RIGHT						1																	
	NB	0.620	A	VW-054	30	30		6.25						1			X							INSTALL 100' +/- NORTH OF ORIGINAL SIGN LOCATION			E-154			
	NB	2.775	A	W1-4R	30	30							1																	
			A	W13-1	18	18							1																	
	NB	2.805	A	W1-4R	30	30		6.25						1			X							INSTALL 160' NORTH OF ORIGINAL SIGN LOCATION	X					
			A	W13-1	18	18		2.25																	X					
	NB	2.864	A	S3-1	30	30	SCHOOL BUS STOP AHEAD						1																	
	NB	2.906	A	W12-2	36	36							1																	
			A	W12-2	30	30		6.25						1			X								X					
	NB	2.948	A	OM-3R	12	36							1																	
			A	OM-3R	12	36	FY	3.00						1			X								X					
	NB	2.960	B	W1-6	48	24							1																	
			B	W1-6	48	24		8.00						2			X								X					
SIGN SUMMARY SHEET							SHEET TOTALS	32.00	0.00	2	0	0	7	0	0	6	90								PROJECT NAME: Hartford-East Montpelier VT14					
								SF	SF	EA	EA	EA	EA	EA	EA	EA	FT								PROJECT NUMBER: STPG SIGN(21)					
VERMONT AGENCY OF TRANSPORTATION							TOWN TOTALS	447.0	0.0	11.0	1.0	1.0	93	0.0	0.0	64	960.0									FILE NAME: Sharon.xls	PLOT DATE: 6/10/2009			
																									PROJECT MANAGER: N. Avery	DRAWN BY: T. Guazzoni				
																									DESIGNED BY: D. Crosslev	CHECKED BY: S. Menard				
																									SHARON SHEET 1	SHEET 16 OF 162				