

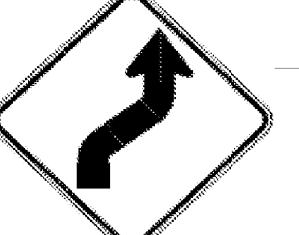






DIRECTION	MILEPOINT	LOCATION CODE (SHEET 2)	SIGN CODE	WIDTH (IN)	HEIGHT (IN)	SHEETING REMARKS	SIGN LEGEND FOR ALL POST LENGTHS AND INSTALLATION DATES SEE ORIGINAL RECORD PLANS	NEW SIGNS		EXISTING SIGNS				EXIST POST		NUMBER OF NEW POSTS	SQUARE STEEL (IN) (LB / FT)			TUBULAR STEEL Ø (IN) (LB / FT)				SIGN FRAME REQUIRED	REMARKS	SIGN DETAIL			
								"A"	"B"	RETAIN	SALVAGE FROM	SALVAGE TO	REMOVE	RETAIN	REMOVE		1.75	2.00	2.50	FOUNDATION	3.00	3.50	4.00			5.00	DETAIL IN SHS	DETAIL ON SHEET NUMBER	DETAIL ON STD SHEET NUMBER
SHARON VT14							FY-FLUORESCENT YELLOW FYG-FLUORESCENT YELLOW GREEN															"SHS"-STANDARD HIGHWAY SIGNS							
SB	4.390	F	R2-1	24	30		SPEED LIMIT 50	5.00		1	1	1		X	1		X							PLAN ERROR					
SB	3.649	F	VW-059	30	30		HIDDEN DRIVE																						
SB	3.610	F	W7-1	30	30																								
		F	W7-1	30	30			6.25							2		X								X				
		F	VW-054R	30	30			6.25																			E-154		
SB	3.138	F	W1-4R	30	30																								
		F	W13-1	18	18																								
		F	W1-4R	30	30			6.25							1		X								X				
		F	W13-1	18	18			2.25																	X				
SB	3.050	F	VW-054R	30	30		HIDDEN DRIVE RIGHT																						
SB	3.004	F	S3-1	30	30																								
		F	S3-1	30	30			6.25							2		X								X				
		F	VW-054R	30	30			6.25																			E-154		
SB	2.977	F	W12-2	36	36																								
		F	W12-2	30	30			6.25							1		X								X				
SIGN SUMMARY SHEET							SHEET TOTALS	44.75 39.75	0.00	0	1	1	8 7	0	0	7	105						PROJECT NAME: Hartford-East Montpelier VT14 PROJECT NUMBER: STPG SIGN(21)						
VERMONT AGENCY OF TRANSPORTATION							TOWN TOTALS	447.0	0.0	11.0	1.0	1.0	93	0.0	0.0	64	960.0						FILE NAME: Sharon.xls PROJECT MANAGER: N. Avery DESIGNED BY: D. Crossley SHARON SHEET 13				PLOT DATE: 6/10/2009 DRAWN BY: T. Guazzoni CHECKED BY: S. Menard SHEET 28 OF 162		