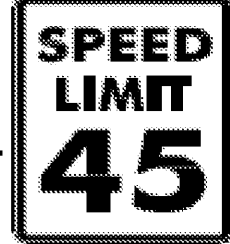


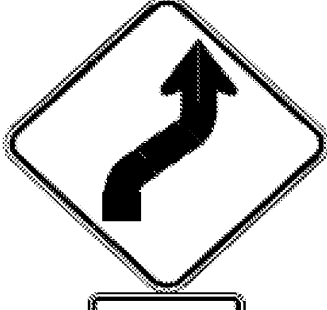





DIRECTION	MILEPOINT	LOCATION CODE (SHEET 2)	SIGN CODE	WIDTH (IN)	HEIGHT (IN)	SHEETING REMARKS	SIGN LEGEND	NEW SIGNS		EXISTING SIGNS				EXIST POST		NUMBER OF NEW POSTS	SQUARE STEEL (IN)			TUBULAR STEEL Ø (IN)				SIGN FRAME REQUIRED	REMARKS	SIGN DETAIL			
								"A"	"B"	RETAIN	SALVAGE FROM	SALVAGE TO	REMOVE	RETAIN	REMOVE		1.75	2.00	2.50	FOUNDATION	3.00	3.50	4.00			5.00	DETAIL IN SHS	DETAIL ON SHEET NUMBER	DETAIL ON STD SHEET NUMBER
																	(LB / FT)				(LB / FT)								
ROYALTON VT 14							FY-FLUORESCENT YELLOW FYG-FLUORESCENT YELLOW GREEN															"SHS"-STANDARD HIGHWAY SIGNS							
			A R2-1	24	30			5.00							1	X								X					
NB	4.940		A W12-2	36	36								1	X															
			A VW-268	36	36									1															
			A W12-2	36	36	FY			9.00																X				
			A VW-268	36	36	FY			9.00																	6			
NB	5.000		A W1-3R	36	36								1	X															
			A W13-1	24	24									1															
			A W1-3R	36	36	FY			9.00							2	X								X				
			A W13-1	24	24	FY			4.00																X				
NB	5.040		A VW-353	30	30								1	X															
			A W16-2	30	24									1															
			A VW-353	36	36	FY			9.00																	6			
			A W-16-2	30	24	FY			5.00																X				
NB	5.120		A W12-2	36	36		12' - 1" CLEARANCE UP/DOWN ARROWS			1				X										X					
NB	5.128		A OM-3R	12	36							1	NA													SIGN BOLTED TO ABUTMENT			
SIGN SUMMARY SHEET							SHEET TOTALS	50.00	0.00	1	0	0	7	0	0	5	75												
VERMONT AGENCY OF TRANSPORTATION								SF	SF	EA	EA	EA	EA	EA	EA	EA	EA	FT											
							TOWN TOTALS	973.5	0.0	62.0	9.0	9.0	190	0.0	0.0	152	2280.0												

PROJECT NAME: **East Montpelier-Hartford VT14**
PROJECT NUMBER: **STPG SIGN(21)**
FILE NAME: **Royalton.xls** PLOT DATE: **6/10/2009**
PROJECT MANAGER: **N. Avery** DRAWN BY: **T. Guazzoni**
DESIGNED BY: **D. Crosslev** CHECKED BY: **S. Menard**
ROYALTON SHEET 8 SHEET **37** OF **162**