




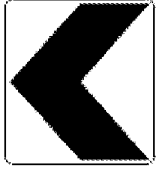
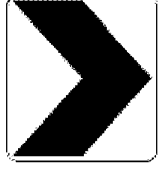


DIRECTION	MILEPOINT	LOCATION CODE (SHEET 2)	SIGN CODE	WIDTH (IN)	HEIGHT (IN)	SHEETING REMARKS	SIGN LEGEND FOR ALL POST LENGTHS AND INSTALLATION DATES SEE ORIGINAL RECORD PLANS	NEW SIGNS		EXISTING SIGNS				EXIST POST		NUMBER OF NEW POSTS	SQUARE STEEL (IN) (LB / FT)			TUBULAR STEEL Ø (IN) (LB / FT)				SIGN FRAME REQUIRED	REMARKS	SIGN DETAIL			
								"A"	"B"	RETAIN	SALVAGE FROM	SALVAGE TO	REMOVE	RETAIN	REMOVE		1.75	2.00	2.50	FOUNDATION	3.00	3.50	4.00			5.00	DETAIL IN SHS	DETAIL ON SHEET NUMBER	DETAIL ON STD SHEET NUMBER
																	1.88	2.42	3.35		7.60	9.00	10.80			14.60			
<b>ROYALTON VT 14</b>							FY-FLUORESCENT YELLOW FYG-FLUORESCENT YELLOW GREEN															"SHS"-STANDARD HIGHWAY SIGNS							
NB	6.020	A	R2-1	24	30																								
		A	R2-1	24	30			5.00																X					
NB	6.376	C	VR-017	24	30			5.00																		E-141			
NB	6.380	C	VR-017	24	30		LEGAL LOAD LIMIT 24,000 LBS																						
		D	R1-1	24	24		STOP																						
NB	6.384	D	R1-1	30	30			6.25																X					
NB	6.700	A	W1-2L	30	30		LEFT CURVE																						
		A	W13-1	18	18		35 MPH PLAQUE																						
NB	6.770	A	W1-2L	30	30			6.25																		INSTALL 350'+/- NORTH OF ORIGINAL LOCATION			
		A	W13-1	18	18			2.25																X					
NB	6.820	A	W1-8L	12	18			5.00																		NEW 24X30			
		B	W1-8R	12	18			5.00																		NEW 24X30			
		A	W1-8L	12	18			1.50																X		WRONG SIZE PLAN ERROR			
		B	W1-8R	12	18			1.50																X					
NB	6.840	A	W1-8L	12	18																								
<b>SIGN SUMMARY SHEET</b>							SHEET TOTALS	37.75 <del>27.75</del>	0.00	0	0	0	9 <del>8</del>	0	0	5	75						PROJECT NAME: <b>East Montpelier-Hartford VT14</b>						
VERMONT AGENCY OF TRANSPORTATION							TOWN TOTALS	973.5	0.0	62.0	9.0	9.0	190	0.0	0.0	152	2280.0						PROJECT NUMBER: <b>STPG SIGN(21)</b>						
								SF	SF	EA	EA	EA	EA	EA	EA	EA	FT						FILE NAME: <b>Royalton.xls</b>						
																						PROJECT MANAGER: <b>N. Avery</b>							
																						DESIGNED BY: <b>D. Crossley</b>							
																						PLOT DATE: <b>6/10/2009</b>							
																						DRAWN BY: <b>T. Guazzoni</b>							
																						CHECKED BY: <b>S. Menard</b>							
																						SHEET <b>43</b>	OF <b>162</b>						