

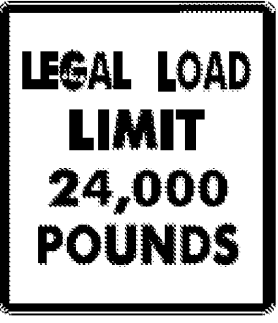


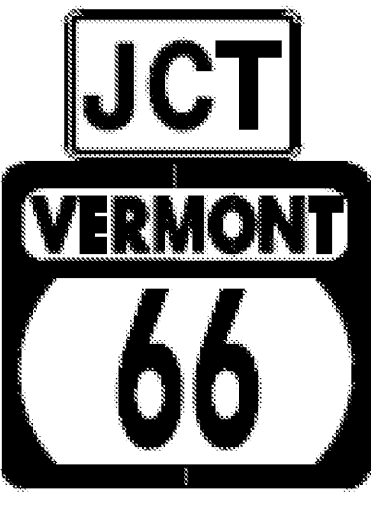


DIRECTION	MILEPOINT	LOCATION CODE (SHEET 2)	SIGN CODE	WIDTH (IN)	HEIGHT (IN)	SHEETING REMARKS	SIGN LEGEND	NEW SIGNS		EXISTING SIGNS				EXIST POST		NUMBER OF NEW POSTS	SQUARE STEEL (IN)			TUBULAR STEEL Ø (IN)				SIGN FRAME REQUIRED	REMARKS	SIGN DETAIL			
								"A"	"B"	RETAIN	SALVAGE FROM	SALVAGE TO	REMOVE	RETAIN	REMOVE		1.75	2.00	2.50	FOUNDATION	3.00	3.50	4.00			5.00	DETAIL IN SHS	DETAIL ON SHEET NUMBER	DETAIL ON STD SHEET NUMBER
																	(LB / FT)				(LB / FT)								
RANDOLPH VT 14							FY-FLUORESCENT YELLOW FYG-FLUORESCENT YELLOW GREEN															"SHS"-STANDARD HIGHWAY SIGNS							
NB	4.573	A	D1-1A	72	12			6.00								2	X									5			
		A	D1-1A	72	12			6.00																		5			
NB	4.666	C	VR-017	24	24							1			X														
		C	VR-017	24	30			5.00								1	X									E-141			
NB	4.674	D	R1-1	24	24							1			X														
		D	R1-1	30	30			6.25								1	X							X					
NB	4.690	A	M3-1	24	12							1			X														
		A	M3-1	24	24							1																	
		A	M3-1	24	12			2.00								1	X												
		A	M3-1	24	24			4.00																					
NB	4.750	A	R2-1	24	30		SPEED LIMIT 35			1					X														
NB	4.820	A	M2-1	21	15			2.19								1	X												
		A	M1-5	24	24			4.00																			E-136B		
NB	4.860	A	M2-1	21	15		JCT					1			X														
		A	M1-5	24	24		VERMONT 66					1																	
SIGN SUMMARY SHEET							SHEET TOTALS	35.44	0.00	1	0	0	6	0	0	6	90						PROJECT NAME: Hartford-East Montpelier VT14						
								SF	SF	EA	EA	EA	EA	EA	EA	EA	FT						PROJECT NUMBER: STPG SIGN(25)						
VERMONT AGENCY OF TRANSPORTATION							TOWN TOTALS	771.4	0.0	19.0	5.0	5.0	155	0.0	0.0	130	1950.0						FILE NAME: Randolph.xls	PLOT DATE: 6/18/2009					
																						PROJECT MANAGER: N. Avery	DRAWN BY: I. Shea						
																					DESIGNED BY: D. Crosslev	CHECKED BY: S. Menard							
																					RANDOLPH SHEET 7	SHEET 70 OF 162							