
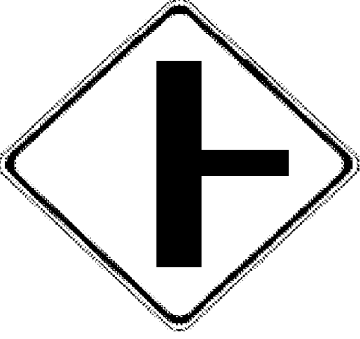


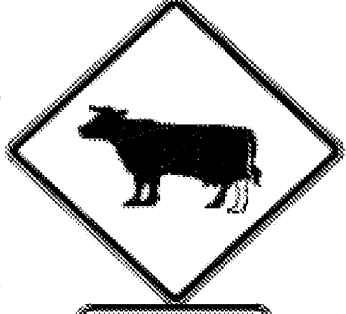

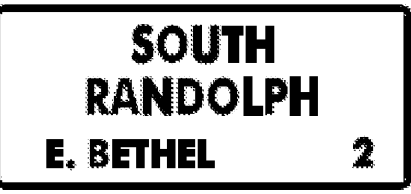



DIRECTION	MILEPOINT	LOCATION CODE (SHEET 2)	SIGN CODE	WIDTH (IN)	HEIGHT (IN)	SHEETING REMARKS	SIGN LEGEND FOR ALL POST LENGTHS AND INSTALLATION DATES SEE ORIGINAL RECORD PLANS	NEW SIGNS		EXISTING SIGNS				EXIST POST		NUMBER OF NEW POSTS	SQUARE STEEL (IN) (LB / FT)			TUBULAR STEEL Ø (IN) (LB / FT)				SIGN FRAME REQUIRED	REMARKS	SIGN DETAIL			
								"A"	"B"	RETAIN	SALVAGE FROM	SALVAGE TO	REMOVE	RETAIN	REMOVE		FOUNDATION	1.75	2.00	2.50	3.00	3.50	4.00			5.00	DETAIL IN SHS	DETAIL ON SHEET NUMBER	DETAIL ON STD SHEET NUMBER
																		1.88	2.42	3.35	7.60	9.00	10.80			14.60			
RANDOLPH VT 14							FY-FLUORESCENT YELLOW FYG-FLUORESCENT YELLOW GREEN															"SHS"-STANDARD HIGHWAY SIGNS							
SB	2.691	F	OM-3R	12	36			3.00							1	X								END OF STONE RET. WALL					
SB	2.137	F	W11-4	30	30		CATTLE SYMBOL 																						
		F	W16-2	24	18		700 FEET																						
		F	W2-2MaR	30	30			6.25							1	X									6				
SB	2.081	G	VR-017	24	24																			DAVIS RD TH-72					
		G	VR-017	24	30			5.00							1	X											E-141		
SB	2.077	H	R1-1	24	24																			DAVIS RD TH-72					
		H	R1-1	30	30			6.25							1	X									X				
	2.070	F	W11-4	30	30			6.25							1	X								INSTALL 100'+/- SOUTH OF DAVIS RD	X				
		F	W16-2	24	18			3.00																	X				
SB	1.620	F	W1-2R	30	30		RIGHT CURVE																						
		F	W13-1	18	18		35 MPH PLAQUE																						
SB	1.580	F	VW-054R	30	30		HIDDEN DRIVE RIGHT																						
		F	VD-018	30	18			3.75							1	X											E-128B		
SB	1.550	F	VD-018	30	18		SOUTH RANDOLPH E. BETHEL 2																						
		F	VW-054R	30	30			6.25							1	X											E-154		
SIGN SUMMARY SHEET							SHEET TOTALS	39.75 36.75	0.00	0	0	0	6 8	0	0	7 6	90						PROJECT NAME: Hartford-East Montpelier VT14 PROJECT NUMBER: STPG SIGN(25)						
VERMONT AGENCY OF TRANSPORTATION							TOWN TOTALS	771.4	0.0	19.0	5.0	5.0	155	0.0	0.0	130	1950.0						FILE NAME: Randolph.xls PROJECT MANAGER: N. Avery DESIGNED BY: D. Crosslev RANDOLPH SHEET 22	PLOT DATE: 6/18/2009 DRAWN BY: I. Shea CHECKED BY: S. Menard SHEET 85 OF 162					