
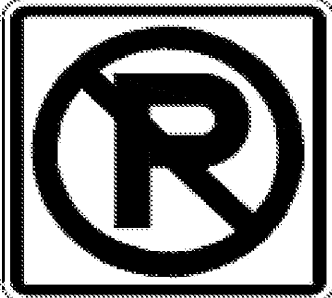

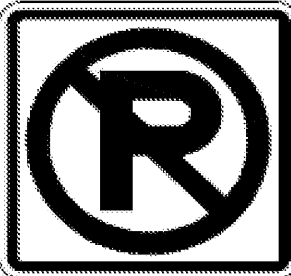




DIRECTION	MILEPOINT	LOCATION CODE (SHEET 2)	SIGN CODE	WIDTH (IN)	HEIGHT (IN)	SHEETING REMARKS	SIGN LEGEND	NEW SIGNS		EXISTING SIGNS				EXIST POST		NUMBER OF NEW POSTS	SQUARE STEEL (IN)			TUBULAR STEEL Ø (IN)				SIGN FRAME REQUIRED	REMARKS	SIGN DETAIL			
								"A"	"B"	RETAIN	SALVAGE FROM	SALVAGE TO	REMOVE	RETAIN	REMOVE		1.75	2.00	2.50	FOUNDATION	3.00	3.50	4.00			5.00	DETAIL IN SHS	DETAIL ON SHEET NUMBER	DETAIL ON STD SHEET NUMBER
																	(LB / FT)				(LB / FT)								
WILLIAMSTOWN VT 14							FY-FLUORESCENT YELLOW FYG-FLUORESCENT YELLOW GREEN															"SHS"-STANDARD HIGHWAY SIGNS							
			F M1-5	24	24							1																	
			F M3-3	24	12			2.00											X						X				
			F M1-5	24	24			4.00																		E-136B			
SB	4.430	G	VR-017	24	30		LEGAL LOAD LIMIT 24000 LBS			1			X												TH-73, GARDEN ST				
SB	4.420	H	R1-1	30	30		STOP			1			X												TH-73, GARDEN ST				
SB	4.420	F	R8-3A	24	24		 					1		X															
			F VR-644P	24	12																								
			F R8-3A	24	24			4.00											X						X				
			F VR-644P	24	12			2.00																		RED ON WHITE SHEETING 6			
SB	4.400	F	R8-3A	24	24		 					1		X															
			F M4-6	24	12																								
			F R8-3A	24	24			4.00											X						X				
			F M4-6	24	12			2.00																	X	RED ON WHITE SHEETING			
SB	4.360	F	R2-1	24	30							1		X															
			F R2-1	24	30			5.00											X						X				
SIGN SUMMARY SHEET							SHEET TOTALS	23.00	0.00	2	0	0	6	0	0	4	60							PROJECT NAME: Hartford-East Montpelier VT14					
							SF SF			EA	EA	EA	EA	EA	EA	EA	FT							PROJECT NUMBER: SIGN STPG(21)					
VERMONT AGENCY OF TRANSPORTATION							TOWN TOTALS	501.1	0.0	67.0	0.0	0.0	94	0.0	0.0	109	1635.0							FILE NAME: Williamstown.xls					
																								PLOT DATE: 6/18/2009					
																									DRAWN BY: T. Guazzoni				
																									DESIGNED BY: A. Gamble				
																									CHECKED BY: S. Menard				
																									SHEET 109 OF 162				