

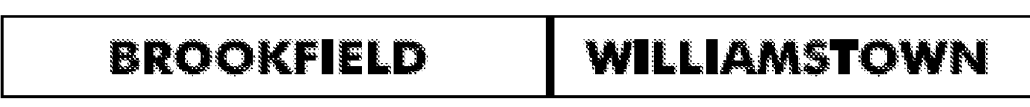
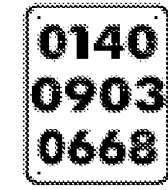
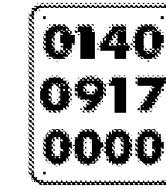


DIRECTION	MILEPOINT	LOCATION CODE (SHEET 2)	SIGN CODE	WIDTH (IN)	HEIGHT (IN)	SHEETING REMARKS	SIGN LEGEND FOR ALL POST LENGTHS AND INSTALLATION DATES SEE ORIGINAL RECORD PLANS	NEW SIGNS		EXISTING SIGNS				EXIST POST		NUMBER OF NEW POSTS	SQUARE STEEL (IN)			TUBULAR STEEL Ø (IN)				SIGN FRAME REQUIRED	REMARKS	SIGN DETAIL			
								"A"	"B"	RETAIN	SALVAGE FROM	SALVAGE TO	REMOVE	RETAIN	REMOVE		1.75	2.00	2.50	FOUNDATION	3.00	3.50	4.00			5.00	DETAIL IN SHS	DETAIL ON SHEET NUMBER	DETAIL ON STD SHEET NUMBER
																	(LB / FT)				(LB / FT)								
<b>WILLIAMSTOWN VT 14</b>							FY-FLUORESCENT YELLOW FYG-FLUORESCENT YELLOW GREEN															"SHS"-STANDARD HIGHWAY SIGNS							
			E	W1-8	24	30	FY		5.00																	INSTALL ON SEPARATE POST 5 FT SOUTH OF SB FACING SIGN	X		
SB	0.345		F	VW-347	30	30								1												HINGED - INSTALL IN CLOSED POSITION			6
SB	0.000		G	VD-024	60	7.5																			REMOVED MM PLAQUES				
			G	VD-024	72	10			5.00																			4	
			G	VD-700	6	10			0.42																BROOKFIELD MILE MARKER ~ INSTALL ON LEFT POST			E-138	
			G	VD-700	6	10			0.42																WILLIAMSTOWN MILE MARKER ~ INSTALL ON RIGHT POST			E-138	
<b>SIGN SUMMARY SHEET</b>							SHEET TOTALS	17.09	0.00	0	0	0	4	0	0	4	60	PROJECT NAME: <b>Hartford-East Montpelier VT14</b> PROJECT NUMBER: <b>SIGN STPG(21)</b>											
VERMONT AGENCY OF TRANSPORTATION							TOWN TOTALS	501.1	0.0	67.0	0.0	0.0	94	0.0	0.0	109	1635.0	FILE NAME: <b>Williamstown.xls</b> PLOT DATE: <b>6/18/2009</b> PROJECT MANAGER: <b>N. Avery</b> DRAWN BY: <b>T. Guazzoni</b> DESIGNED BY: <b>A. Gamble</b> CHECKED BY: <b>S. Menard</b> WILLIAMSTOWN SHEET 18 SHEET <b>114</b> OF <b>162</b>											