


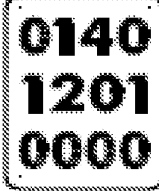
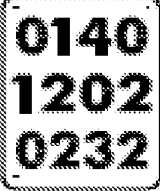
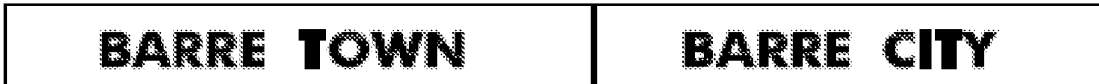
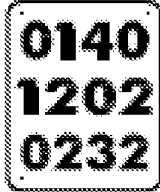
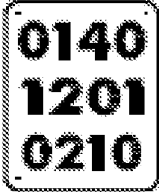




DIRECTION	MILEPOINT	LOCATION CODE (SHEET 2)	SIGN CODE	WIDTH (IN)	HEIGHT (IN)	SHEETING REMARKS	SIGN LEGEND FOR ALL POST LENGTHS AND INSTALLATION DATES SEE ORIGINAL RECORD PLANS	NEW SIGNS		EXISTING SIGNS				EXIST POST		NUMBER OF NEW POSTS	SQUARE STEEL (IN) (LB / FT)			TUBULAR STEEL Ø (IN) (LB / FT)				SIGN FRAME REQUIRED	REMARKS	SIGN DETAIL			
								"A"	"B"	RETAIN	SALVAGE FROM	SALVAGE TO	REMOVE	RETAIN	REMOVE		1.75	2.00	2.50	FOUNDATION	3.00	3.50	4.00			5.00	DETAIL IN SHS	DETAIL ON SHEET NUMBER	DETAIL ON STD SHEET NUMBER
																	1.88	2.42	3.35		7.60	9.00	10.80			14.60			
BARRE TOWN VT 14							FY-FLUORESCENT YELLOW FYG-FLUORESCENT YELLOW GREEN															"SHS"-STANDARD HIGHWAY SIGNS							
		A	VR-038	24	18			3.00							1		X											E-141	
		A	R2-1	30	36			7.50																			6		
		A	N/A				UNLESS OTHERWISE POSTED IN CITY LIMITS					1																	
NB	2.319	C	VD-025	60	7.5							1				X													
		C	VD-025	72	10			5.00							2		X										4		
		C	VD-700	6	10			0.42																				E-138	
		C	VD-700	6	10			0.42				1																E-138	
		X																											
NB	2.321	C	VD-024	60	7.5							1				X													
		C	VD-025	72	10			5.00							2		X										4		
		C	VD-700	6	10			0.42																				E-138	
		C	VD-700	6	10			0.42																				E-138	
NB	2.325	A	VR-039	24	18							1				X													
		A	R2-1	24	30							1																	
		A	VR-039	24	18			3.00							1		X											E-141	
SIGN SUMMARY SHEET							SHEET TOTALS	25.60 25.18	0.00	0	0	1	5 4	0	0	6	90												
VERMONT AGENCY OF TRANSPORTATION							TOWN TOTALS	583.8	0.0	48.0	9.0	9.0	115	0.0	0.0	89	1335.0												
							PROJECT NAME:	Hartford-East Montpelier VT14																					
							PROJECT NUMBER:	STPG SIGN(21)																					
							FILE NAME:	Barre Town.xls											PLOT DATE:	6/18/2009									
							PROJECT MANAGER:	N. Avery											DRAWN BY:	T. Guazzoni									
							DESIGNED BY:	A. Gamble											CHECKED BY:	S. Menard									
							BARRE TOWN SHEET	10											SHEET	124 OF 162									