

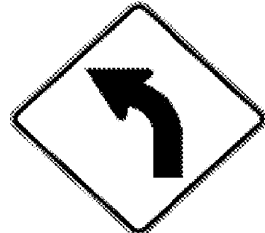
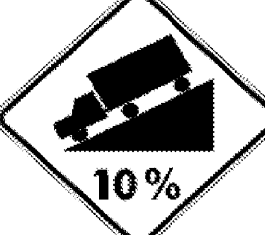

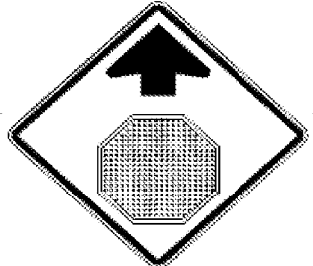


DIRECTION	MILEPOINT	LOCATION CODE (SHEET 2)	SIGN CODE	WIDTH (IN)	HEIGHT (IN)	SHEETING REMARKS	SIGN LEGEND FOR ALL POST LENGTHS AND INSTALLATION DATES SEE ORIGINAL RECORD PLANS	NEW SIGNS		EXISTING SIGNS				EXIST POST		NUMBER OF NEW POSTS	SQUARE STEEL (IN) (LB / FT)			TUBULAR STEEL Ø (IN) (LB / FT)				SIGN FRAME REQUIRED	REMARKS	SIGN DETAIL			
								"A"	"B"	RETAIN	SALVAGE FROM	SALVAGE TO	REMOVE	RETAIN	REMOVE		1.75	2.00	2.50	FOUNDATION	3.00	3.50	4.00			5.00	DETAIL IN SHS	DETAIL ON SHEET NUMBER	DETAIL ON STD SHEET NUMBER
E MONTPELIER VT 14							FY-FLUORESCENT YELLOW FYG-FLUORESCENT YELLOW GREEN															"SHS"-STANDARD HIGHWAY SIGNS							
NB	2.150	A	R2-1	24	30		SPEED LIMIT 35			1													SIGN TO BE SALVAGED TO LOCATION ACROSS THE ROAD AT SB MP 2.01						
NB	2.180	C	VR-017	24	30																								
		C	VR-017	24	30			5.00 6.25							1			X					TH-7, PAULS SQ			E-141			
NB	2.160	D	R1-1	30	30																								
		D	R1-1	30	30			6.25							1			X					TH-7, PAULS SQ	X					
NB	2.200	A	W7-1	30	30		HILL SYMBOL 																						
		A	W1-2L	30	30			6.25							1			X						X					
		A	W7-1B	30	30			6.25																X					
NB	2.260	A	VD-062A	72	16		BUSINESS SIGN			1																			
NB	2.265 TO 2.275	A		6	8		4 WHITE DELINEATORS	1.33							2			X					INSTALL BACK TO BACK EVENLY SPACED BETWEEN BUSINESS SIGN AND GUARDRAIL END			5			
NB	2.300	A	VD-018	30	18																								
		A	VD-018	30	18			3.75							1			X								E-128A			
NB	2.330	A	W3-1	30	30																								
		A	W3-1	36	36			9.00							2			X						X					
NB	2.390	A	M2-1	21	15																								
SIGN SUMMARY SHEET							SHEET TOTALS	37.83 39.08	0.00	1	1	0	6	0	0	8	120						PROJECT NAME: Hartford-East Montpelier VT14 PROJECT NUMBER: STPG SIGN(21)						
VERMONT AGENCY OF TRANSPORTATION							TOWN TOTALS	803.2	0.0	27.0	3.0	3.0	149	0.0	0.0	132	1980.0						FILE NAME: East Montpelier.xls PROJECT MANAGER: N. Avery DESIGNED BY: M. Miller EAST MONTPELIER SHEET 5						
																						PLOT DATE: 6/18/2009 DRAWN BY: T. Guazzoni CHECKED BY: S. Menard SHEET 140 OF 162							