


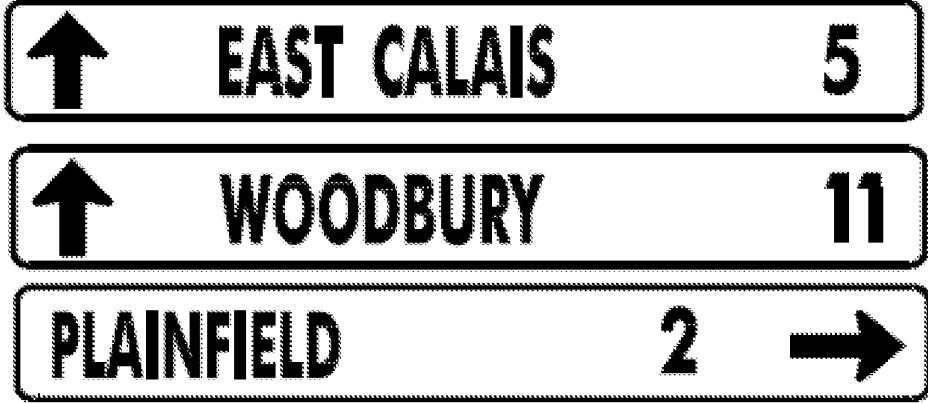


DIRECTION	MILEPOINT	LOCATION CODE (SHEET 2)	SIGN CODE	WIDTH (IN)	HEIGHT (IN)	SHEETING REMARKS	SIGN LEGEND FOR ALL POST LENGTHS AND INSTALLATION DATES SEE ORIGINAL RECORD PLANS	NEW SIGNS		EXISTING SIGNS				EXIST POST		NUMBER OF NEW POSTS	SQUARE STEEL (IN) (LB / FT)			TUBULAR STEEL Ø (IN) (LB / FT)				SIGN FRAME REQUIRED	REMARKS	SIGN DETAIL			
								"A"	"B"	RETAIN	SALVAGE FROM	SALVAGE TO	REMOVE	RETAIN	REMOVE		1.75	2.00	2.50	FOUNDATION	3.00	3.50	4.00			5.00	DETAIL IN SHS	DETAIL ON SHEET NUMBER	DETAIL ON STD SHEET NUMBER
																	1.88	2.42	3.35		7.60	9.00	10.80			14.60			
<b>E MONTPELIER VT 14</b>							FY-FLUORESCENT YELLOW FYG-FLUORESCENT YELLOW GREEN															"SHS"-STANDARD HIGHWAY SIGNS							
		A	R2-1	24	30			5.00							1	X								X					
NB	5.360	A	M2-1	21	15							1		X															
		A	M1-5	30	24							1																	
		A	M2-1	21	15			2.19							1	X								X					
		A	M1-5	30	24			5.00																	E-136B				
NB	5.395	A	W11-2	30	30							1		X															
		A	W11-2	30	30	FYG		6.25							1	X							X						
NB	5.430	A	D1-1A	72	12							2		X											REMOVED EXISTING MM PLAQUE				
		A	D1-1A	72	12							1																	
		A	D1-1A	72	12							1																	
		A	D1-1A	72	12			6.00							2	X										5			
		A	D1-1A	72	12			6.00																	5				
		A	D1-1A	72	12			6.00																	5				
NB	5.485	A	M3-1	24	12							1		X															
		A	M1-5	24	24							1																	
<b>SIGN SUMMARY SHEET</b>							SHEET TOTALS	36.44	0.00	0	0	0	0	0	0	5	75												
VERMONT AGENCY OF TRANSPORTATION								SF	SF	EA	EA	EA	EA	EA	EA	EA	EA	EA	EA	EA	EA	EA	EA	EA	EA	EA			
							TOWN TOTALS	803.2	0.0	27.0	3.0	3.0	149	0.0	0.0	132	1980.0												
															PROJECT NAME:	Hartford-East Montpelier VT14													
															PROJECT NUMBER:	STPG SIGN(21)													
															FILE NAME:	East Montpelier.xls					PLOT DATE:	6/18/2009							
															PROJECT MANAGER:	N. Avery					DRAWN BY:	T. Guazzoni							
															DESIGNED BY:	M. Miller					CHECKED BY:	S. Menard							
															EAST MONTPELIER SHEET 11					SHEET 146 OF 162									