




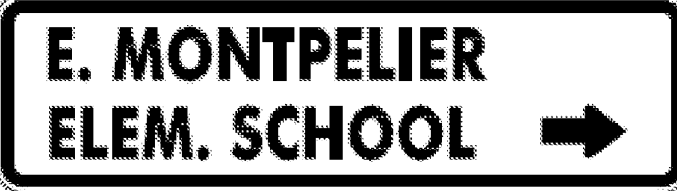


DIRECTION	MILEPOINT	LOCATION CODE (SHEET 2)	SIGN CODE	WIDTH (IN)	HEIGHT (IN)	SHEETING REMARKS	SIGN LEGEND FOR ALL POST LENGTHS AND INSTALLATION DATES SEE ORIGINAL RECORD PLANS	NEW SIGNS		EXISTING SIGNS				EXIST POST		NUMBER OF NEW POSTS	SQUARE STEEL (IN) (LB / FT)			TUBULAR STEEL Ø (IN) (LB / FT)				SIGN FRAME REQUIRED	REMARKS	SIGN DETAIL					
								"A"	"B"	RETAIN	SALVAGE FROM	SALVAGE TO	REMOVE	RETAIN	REMOVE		FOUNDATION	3.00	3.50	4.00	5.00	DETAIL IN SHS	DETAIL ON SHEET NUMBER			DETAIL ON STD SHEET NUMBER					
																											1.75	2.00	2.50	7.60	9.00
E MONTPELIER VT 14							FY-FLUORESCENT YELLOW FYG-FLUORESCENT YELLOW GREEN															"SHS"-STANDARD HIGHWAY SIGNS									
		F	D1-2R	72	20			10.00							2	X									5						
SB	2.490	G	VR-017	24	30								1		X																
		G	VR-017	24	30			5.00							1	X										TH-25, QUAKER RD		E-141			
SB	2.480	H	R1-1	30	30						1				X																
		H	R1-1	30	30			6.25					1		X												TH-25, QUAKER RD	X			
																													VT 14 FOLLOWS US 2 FOR 0.2 MILES		
SB	2.455	E	R1-1	30	30								1		X														THIS STOP SIGN IS AT THE SOUTHERN INTERSECTION OF VT 14/US 2		
		E	R1-1	36	36			9.00							2	X													X		
SB	2.450	F	OM-3R	12	36																										
		F	OM-3R	12	36			3.00							1	X													X		
SB	2.420	E	OM-3L	12	36		LEFT OBJECT MARKER				1				X																
SB	2.415	F	R2-1	24	30																										
		F	R2-1	24	30			5.00							1	X													X		
SB	2.395	F	M3-3	24	12								1																CROSS VT TRAIL (SALV.)		
		F	M1-5	24	24																										
SIGN SUMMARY SHEET							SHEET TOTALS	38.25	0.00	1	2	1	7	0	0	8	120														
VERMONT AGENCY OF TRANSPORTATION								SF	SF	EA	EA	EA	EA	EA	EA	EA	FT														
							TOWN TOTALS	803.2	0.0	27.0	3.0	3.0	149	0.0	0.0	132	1980.0														
PROJECT NAME: Hartford-East Montpelier VT14																					PROJECT NUMBER: STPG SIGN(21)										
FILE NAME: East Montpelier.xls															PLOT DATE: 6/18/2009																
PROJECT MANAGER: N. Avery															DRAWN BY: T. Guazzoni																
DESIGNED BY: M. Miller															CHECKED BY: S. Menard																
EAST MONTPELIER SHEET 21																					SHEET 156 OF 162										