

STATE OF VERMONT AGENCY OF TRANSPORTATION




PROPOSED IMPROVEMENT TOWNS OF ROYALTON - BARRE TOWN COUNTIES WINDSOR, ORANGE, AND WASHINGTON VERMONT ROUTE 110


BEGINNING AT THE INTERSECTION OF US ROUTE 110 AND VT ROUTE 14 IN THE TOWN OF ROYALTON AT MILE MARKER 0.000 AND EXTENDING NORTHERLY ALONG VT ROUTE 110 FOR A DISTANCE OF 27.153 MILES TO THE INTERSECTION OF VT ROUTE 110 AND US ROUTE 302 AT MILE MARKER 1.124 IN THE TOWN OF BARRE.

LENGTH OF ROADWAY = 27.153 MILES
LENGTH OF PROJECT = 27.153 MILES

WORK TO BE PERFORMED UNDER THIS PROJECT INCLUDES THE REMOVAL OF EXISTING SIGNS AND POSTS AND THE INSTALLATION OF NEW SIGNS AND SIGN POSTS AND INCIDENTAL ITEMS.

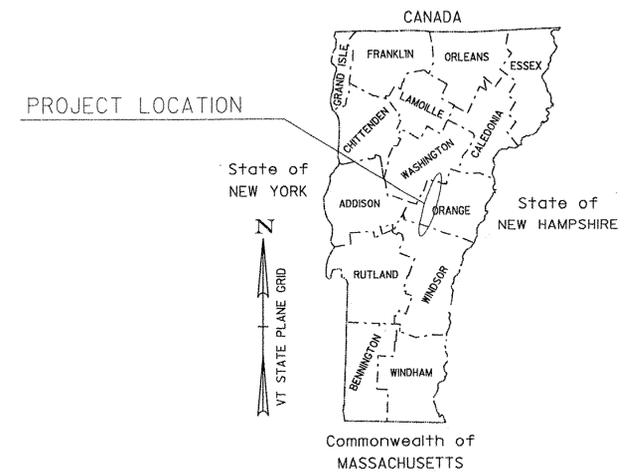

INDEX OF SHEETS
SEE SHEET 2

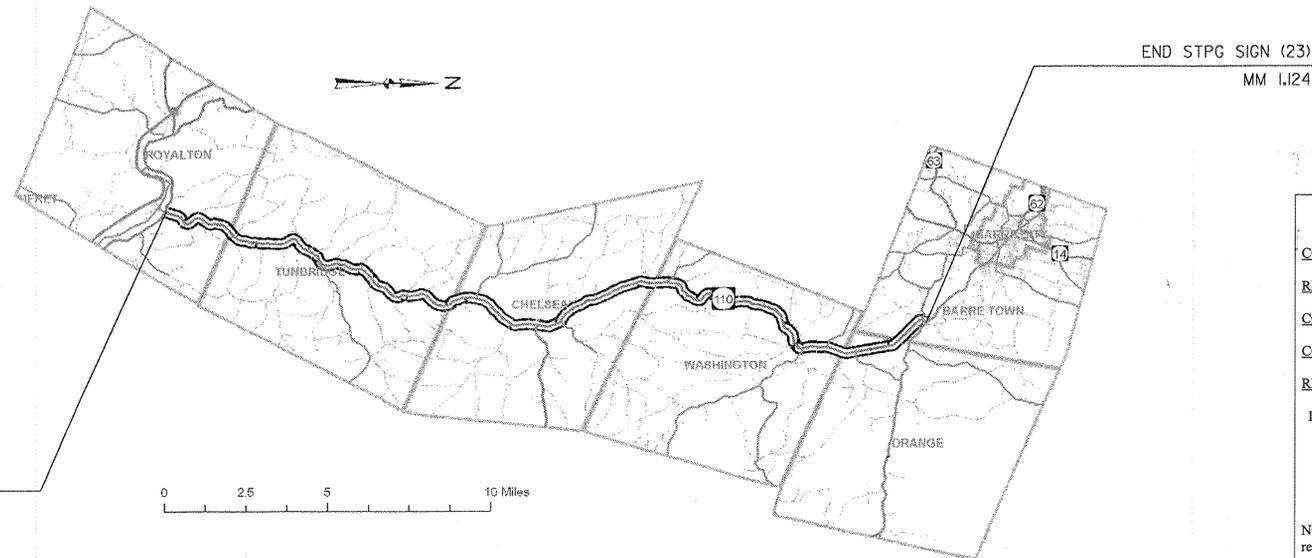

CONVENTIONAL SYMBOLS	
COUNTY LINE	
TOWN LINE	
LIMITS OF ACCESS	
POINT OF ACCESS	
FENCE LINE	
STONE WALL	
TRAVELED WAY	
GUARD RAIL	
RAILROAD	
SURVEY LINE	
CULVERT	
POWER POLE	
TELEPHONE POLE	
TREES	
CONTROL OF ACCESS	
PROPERTY LINE	
R.O.W. TAKING LINE	
SLOPE RIGHTS	
TOP OF CUT	
TOE OF SLOPE	

SURVEYED BY : NMAA
SURVEYED DATE : NMAA
DATUM
VERTICAL NMAA
HORIZONTAL NMAA

RECORD PLANS	
CONTRACTOR:	F.R. LAFAYETTE, INC.- ESSEX JUNCTION, VT.
RESIDENT ENGINEER:	CHARLIE HARDING
CONSTRUCTION BEGAN:	NOVEMBER 2, 2009
CONSTRUCTION COMPLETE:	JUNE 10, 2011
RECORD PLANS BY:	CHARLIE HARDING & AMOS KEMPTON
I HEREBY CERTIFY THAT ALL THE CONSTRUCTION REQUIRED BY THIS SET OF DRAWINGS HAS BEEN ACCOMPLISHED AS INDICATED HEREIN.	
BY	RESIDENT ENGINEER
DATE <u>July 21, 2011</u>	
NOTE: Any further information concerning final quantities, amounts or other details relative to this project may be found at Central Files in the electronic archives.	

THESE PLANS ARE SUBJECT TO SUCH ENGINEERING CHANGES AS MAY BE REQUIRED BY THE FEDERAL HIGHWAY ADMINISTRATION OR THE DIRECTOR OF PROGRAM DEVELOPMENT.
CONSTRUCTION IS TO BE CARRIED ON IN ACCORDANCE WITH THESE PLANS AND THE STANDARD SPECIFICATIONS FOR CONSTRUCTION DATED 2006, AS APPROVED BY THE FEDERAL HIGHWAY ADMINISTRATION ON JUNE 15, 2006 FOR USE ON THIS PROJECT, INCLUDING ALL SUBSEQUENT REVISIONS AND SUCH REVISED SPECIFICATIONS AND SPECIAL PROVISIONS AS ARE INCORPORATED IN THESE PLANS.

DIRECTOR OF PROGRAM DEVELOPMENT	
APPROVED	DATE <u>6-3-09</u>
PROJECT MANAGER :	AMY GAMBLE
PROJECT NAME :	ROYALTON - BARRE TOWN
PROJECT NUMBER :	STPG SIGN (23)
SHEET 1 OF 80	SHEETS