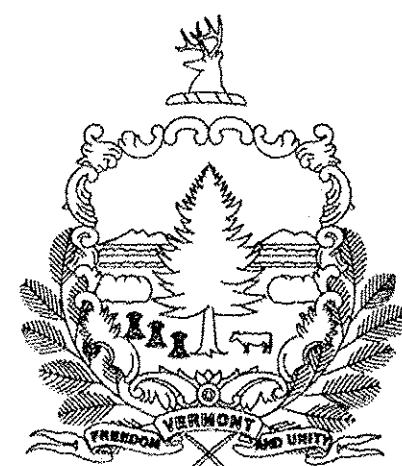


STATE OF VERMONT
AGENCY OF TRANSPORTATION

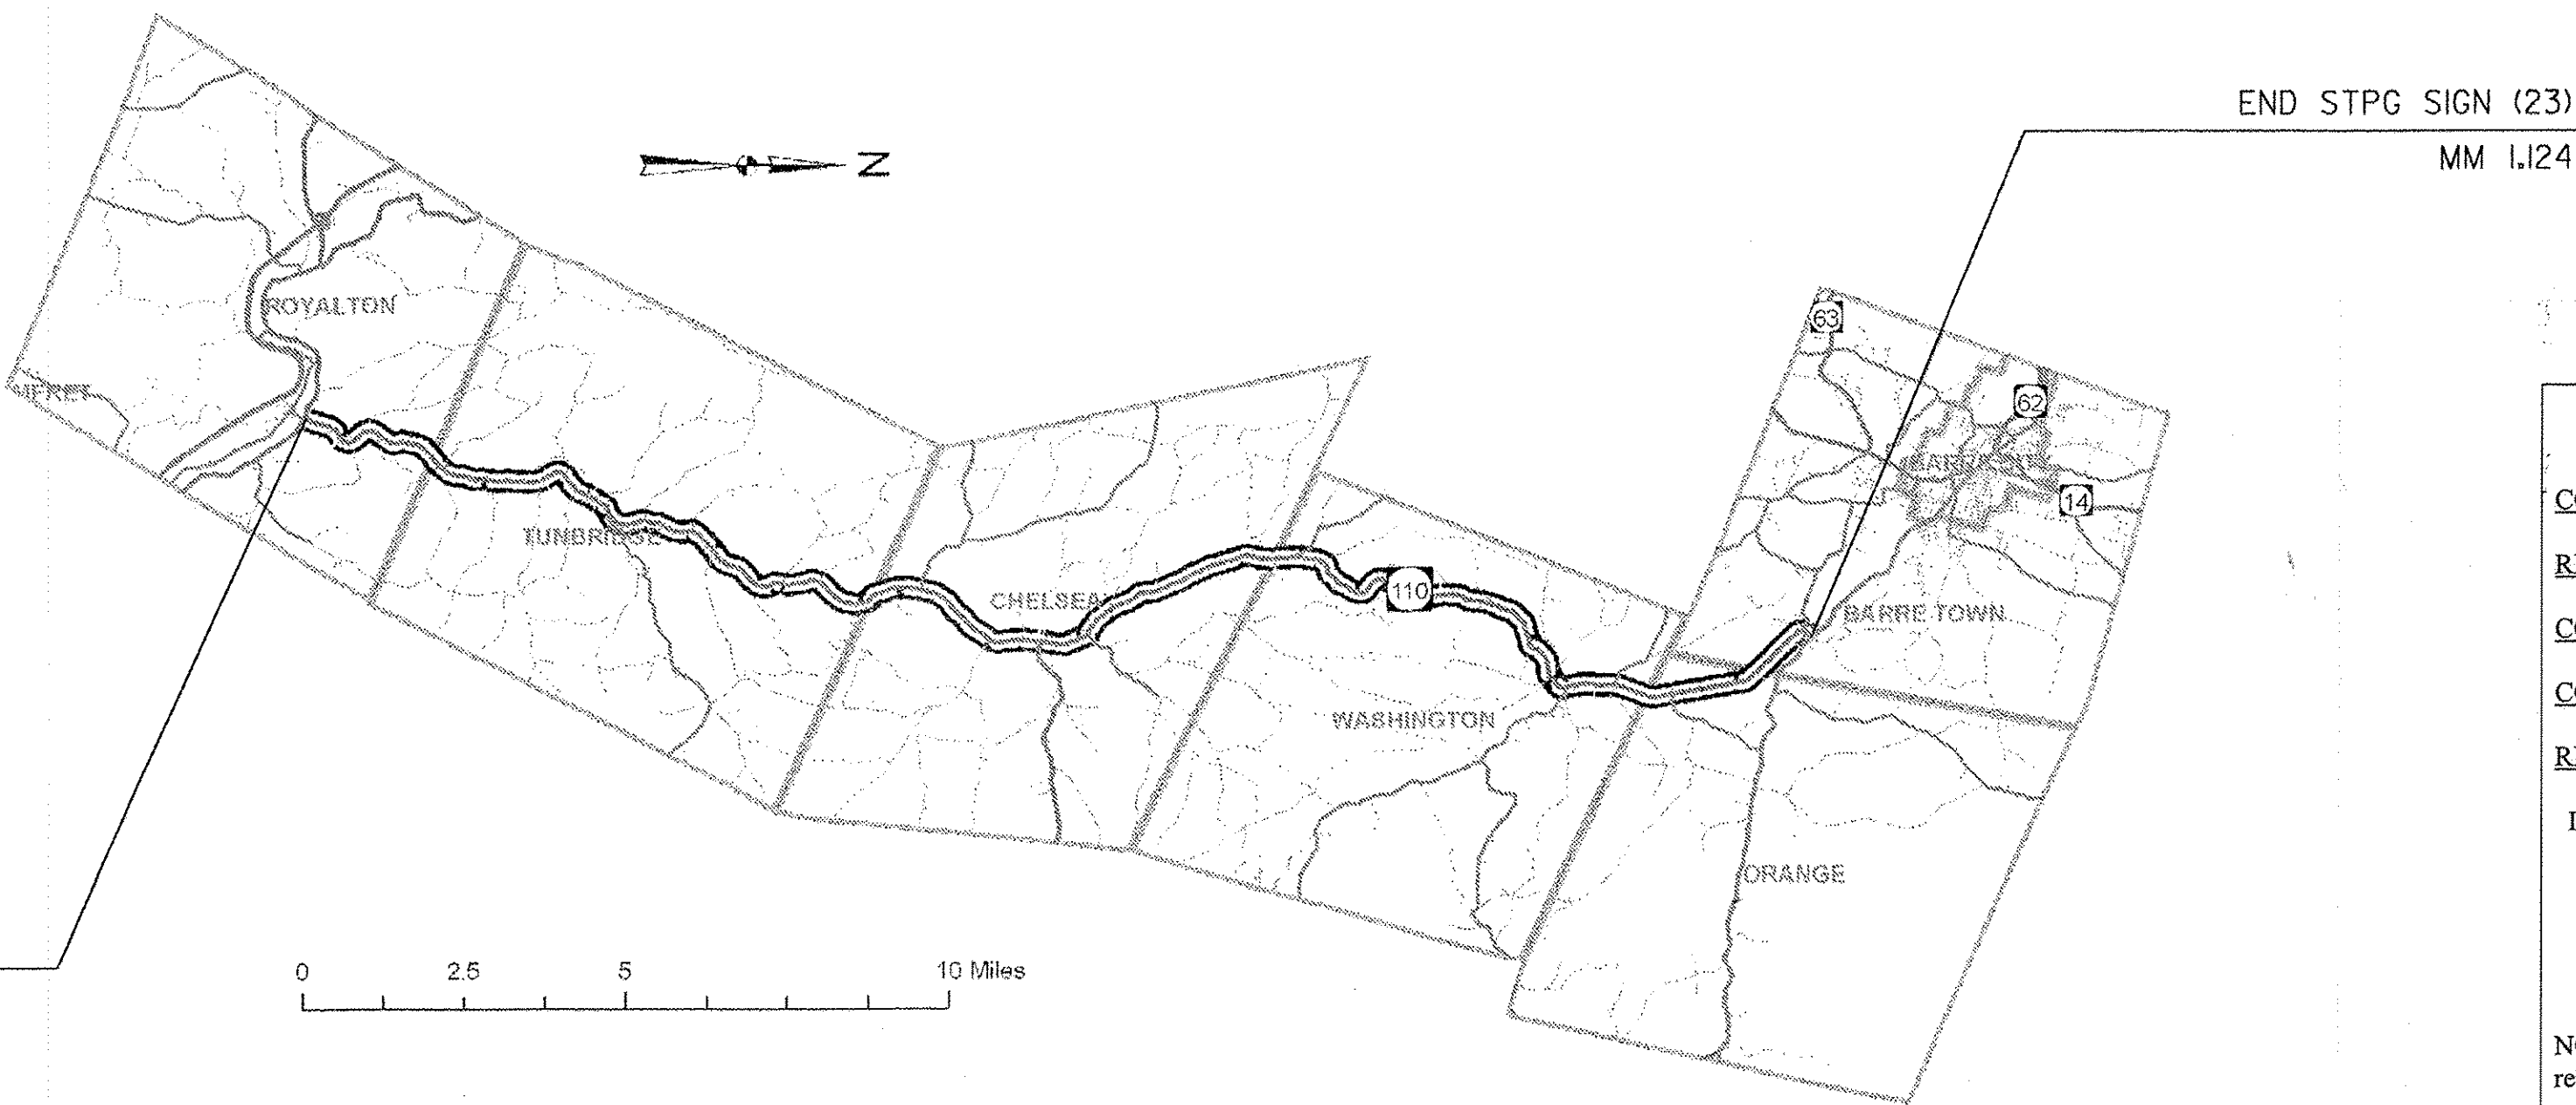
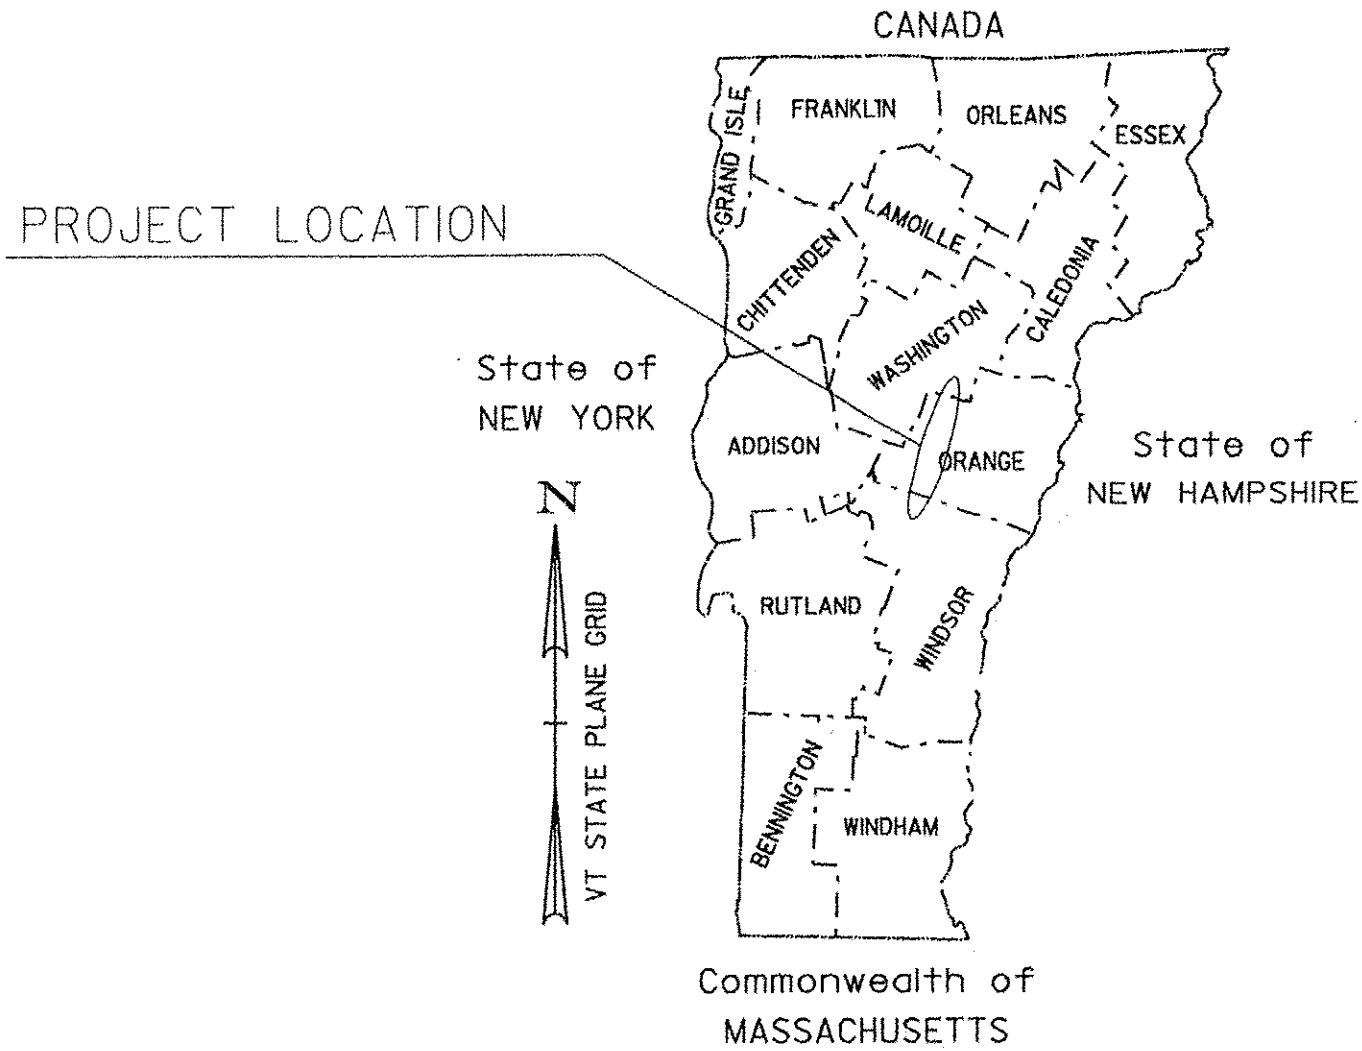


PROPOSED IMPROVEMENT
TOWNS OF ROYALTON - BARRE TOWN
COUNTIES WINDSOR, ORANGE, AND WASHINGTON
VERMONT ROUTE 110

BEGINNING AT THE INTERSECTION OF US ROUTE 110 AND VT ROUTE 14 IN THE TOWN OF ROYALTON AT MILE MARKER 0.000 AND EXTENDING NORTHERLY ALONG VT ROUTE 110 FOR A DISTANCE OF 27.153 MILES TO THE INTERSECTION OF VT ROUTE 110 AND US ROUTE 302 AT MILE MARKER 1.124 IN THE TOWN OF BARRE.

LENGTH OF ROADWAY = 27.153 MILES
LENGTH OF PROJECT = 27.153 MILES

WORK TO BE PERFORMED UNDER THIS PROJECT INCLUDES THE REMOVAL OF EXISTING SIGNS AND POSTS AND THE INSTALLATION OF NEW SIGNS AND SIGN POSTS AND INCIDENTAL ITEMS.



RECORD PLANS

CONTRACTOR: F.R. LAFAYETTE, INC. ESSEX JUNCTION, VT.

RESIDENT ENGINEER: CHARLIE HARDING

CONSTRUCTION BEGAN: NOVEMBER 2, 2009

CONSTRUCTION COMPLETE: JUNE 10, 2011

RECORD PLANS BY: CHARLIE HARDING & AMOS KEMPTON

I HEREBY CERTIFY THAT ALL THE CONSTRUCTION REQUIRED BY THIS SET OF DRAWINGS HAS BEEN ACCOMPLISHED AS INDICATED HEREIN.

BY *Charlie Harding* RESIDENT ENGINEER

DATE *July 21, 2011*

NOTE: Any further information concerning final quantities, amounts or other details relative to this project may be found at Central Files in the electronic archives.

CONVENTIONAL SYMBOLS	
COUNTY LINE	
TOWN LINE	
LIMITS OF ACCESS	
POINT OF ACCESS	
FENCE LINE	
STONE WALL	
TRAVELED WAY	
GUARD RAIL	
RAILROAD	
SURVEY LINE	
CULVERT	
POWER POLE	
TELEPHONE POLE	
TREES	
CONTROL OF ACCESS	
PROPERTY LINE	
R.O.W. TAKING LINE	
SLOPE RIGHTS	
TOP OF CUT	
TOE OF SLOPE	

SURVEYED BY : NMAA

SURVEYED DATE : NMAA

DATUM

VERTICAL NMAA

HORIZONTAL NMAA

THESE PLANS ARE SUBJECT TO SUCH ENGINEERING CHANGES AS MAY BE REQUIRED BY THE FEDERAL HIGHWAY ADMINISTRATION OR THE DIRECTOR OF PROGRAM DEVELOPMENT.

CONSTRUCTION IS TO BE CARRIED ON IN ACCORDANCE WITH THESE PLANS AND THE STANDARD SPECIFICATIONS FOR CONSTRUCTION DATED 2006, AS APPROVED BY THE FEDERAL HIGHWAY ADMINISTRATION ON JUNE 15, 2006 FOR USE ON THIS PROJECT, INCLUDING ALL SUBSEQUENT REVISIONS AND SUCH REVISED SPECIFICATIONS AND SPECIAL PROVISIONS AS ARE INCORPORATED IN THESE PLANS.

DIRECTOR OF PROGRAM DEVELOPMENT

APPROVED *[Signature]* DATE *6-3-09*

PROJECT MANAGER : AMY GAMBLE

PROJECT NAME : ROYALTON - BARRE TOWN

PROJECT NUMBER : STPG SIGN (23)

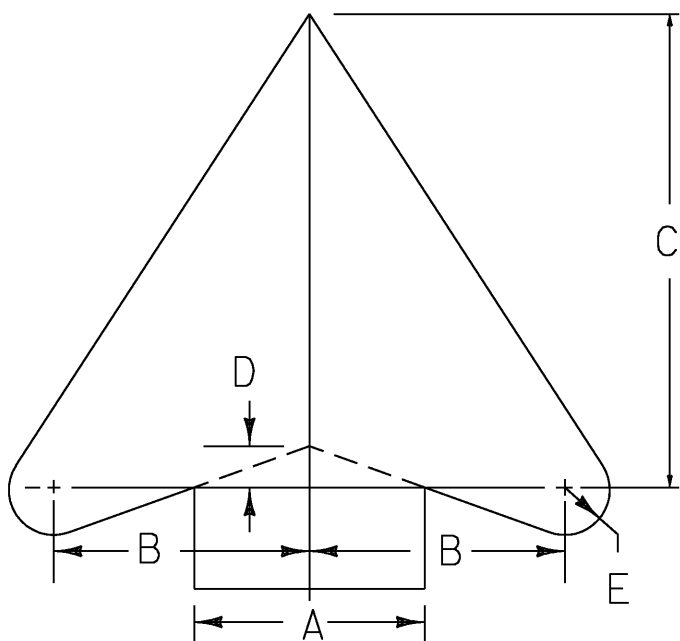
SHEET 1 OF 80 SHEETS

INDEX OF SHEETS	
1	TITLE SHEET
2	GENERAL NOTES
3	QUANTITY SHEET
4	COUNTY/ TOWN LINE DESIGN
5-6	SIGN DETAILS
7	GUIDE SIGN ASSEMBLY
8-13	ROYALTON TRAFFIC SIGN SUMMARY SHEETS I-6
14-34	TUNBRIDGE TRAFFIC SIGN SUMMARY SHEETS I-21
35-53	CHELSEA TRAFFIC SIGN SUMMARY SHEETS I-19
54-65	WASHINGTON TRAFFIC SIGN SUMMARY SHEETS I-12
66-67	ORANGE TRAFFIC SIGN SUMMARY SHEETS I-2
68-77	BARRE TOWN TRAFFIC SIGN SUMMARY SHEETS I-10
78	TOWN TOTAL SIGN SUMMARY SHEET
79-80	TRAFFIC CONTROL SHEETS

STANDARDS		
E-120	STANDARD SIGN PLACEMENT EXPRESSWAY AND FREEWAY	08/08/1995
E-121	STANDARD SIGN PLACEMENT CONVENTIONAL ROAD	08/08/1995
E-123	GUIDE SIGN PLACEMENT	03/16/2004
E-127	ROUTE MARKINGS AT RURAL INTERSECTIONS	08/08/1995
E-128A	VILLAGE SIGNS A-M	08/08/1995
E-128B	VILLAGE SIGNS N-W	08/08/1995
E-136B	STATE ROUTE MARKER SIGN DETAILS	08/08/1995
E-136C	STATE NUMBER TOWN HIGHWAY SIGN DETAILS	08/08/1995
E-138	MILEMARKER DETAILS STATE AND TOWN HIGHWAYS	05/30/2003
E-141	REGULATORY SIGN DETAILS	09/20/1995
E-145A	REGULATORY SIGN DETAILS LANE USE CONTROL SIGNS	12/23/1994
E-145B	REGULATORY SIGN DETAILS LANE USE CONTROL SIGNS	12/23/1994
E-153	WARNING SIGN DETAILS	05/01/2004
E-154	WARNING SIGN DETAILS	05/01/2004
E-164	SQUARE STEEL POSTS	06/08/2009

- GENERAL NOTES
- ALL NEW SIGNS SHALL BE IN ACCORDANCE WITH THESE PLANS, THE LATEST EDITION OF THE 2003 MANUAL ON UNIFORM TRAFFIC CONTROL DEVICES, THE STANDARD HIGHWAY SIGN BOOK (SHS) PUBLISHED BY THE FEDERAL HIGHWAY ADMINISTRATION (FHWA), AND APPLICABLE VTRANS E-SERIES STANDARDS OR AS DIRECTED BY THE ENGINEER. SIGN LOCATIONS AS SHOWN ON THE PLANS ARE APPROXIMATE. EXACT LOCATIONS TO BE DETERMINED BY THE ENGINEER IN THE FIELD.
 - ALL SIGNS WITHIN THE PROJECT LIMITS ARE TO BE REPLACED UNLESS OTHERWISE NOTED OR AS DIRECTED BY THE RESIDENT ENGINEER.
 - THE CONTRACTOR SHALL BE RESPONSIBLE FOR REPAIRING ANY DAMAGE TO PRIVATE OR PUBLIC PROPERTY CAUSED BY THE CONTRACTOR, AT THEIR EXPENSE.
 - ALL EXISTING MILE MARKER PLAQUES ATTACHED TO A DELINEATOR POST OR ATTACHED TO A RETAINED STAND ALONE SIGN POST ASSEMBLY SHALL BE RETAINED. IF AN EXISTING MILE MARKER PLAQUE IS ATTACHED TO A SIGN POST THAT IS TO BE REMOVED AND REPLACED IN THE SAME LOCATION, THE MILE MARKER PLAQUE SHALL BE REMOVED, SALVAGED AND INSTALLED TO THE NEW SIGN POST. IF AN EXISTING MILE MARKER PLAQUE IS ATTACHED TO A SIGN POST THAT IS TO BE RELOCATED TO A DIFFERENT LOCATION, THE MILE MARKER PLAQUE SHALL BE REMOVED, UNLESS OTHERWISE DIRECTED BY THE ENGINEER. PAYMENT FOR ANY OF THIS WORK SHALL BE INCIDENTAL TO ITEM 675.341 SQUARE TUBE POST AND ANCHOR. PAYMENT FOR NEW MILE MARKERS AS SHOWN ON THESE PLANS SHALL BE PAID FOR AS ITEM 675.20 TRAFFIC SIGN, TYPE A.
 - SALVAGED SIGN TOTALS HAS BEEN ADDED TO THE TOTAL SIGN REMOVAL COLUMN ON THE TOWN TOTAL SIGN SUMMARY SHEET.
 - EXISTING STREET NAME SIGNS ATTACHED TO SIGN POSTS THAT ARE TO BE REPLACED, SHALL BE REMOVED AND INSTALLED ONTO NEW POST. ALL WORK AND MATERIALS NECESSARY TO REMOVE AND INSTALL THE STREET NAME PLAQUE SHALL BE PAID FOR UNDER ITEM 675.60 ERECTING SALVAGED SIGNS. AN ESTIMATED QUANTITY HAS BEEN ADDED TO ITEM 675.60 TO PAY FOR THIS WORK.
 - ALL EXISTING STREET NAME PLAQUES INSTALLED ON STAND ALONE SIGN POSTS SHALL BE RETAINED WITHIN THE PROJECT LIMITS.
 - ALL SIGN PLACEMENT SHALL BE IN CONFORMANCE WITH STATE STANDARD E-120 STANDARD SIGN PLACEMENT CONVENTIONAL ROADS AND E-121 STANDARD SIGN PLACEMENT EXPRESSWAY AND FREEWAY.
 - ALL SIGN LETTERING, DIGITS, ARROWS, AND DESIGN OF SYMBOLS FOR SIGNS DETAILED REFERENCED IN THESE PLANS SHALL CONFORM WITH THE *STANDARD ALPHABET FOR HIGHWAY SIGNS AND PAVEMENT MARKING* AS ADOPTED BY THE U.S. DEPARTMENT OF TRANSPORTATION AND THE FEDERAL HIGHWAY ADMINISTRATION (FHWA), UNLESS DETAILED WITHIN THESE PLANS.
 - ALL COLORS SHALL CONFORM WITH THE STANDARD COLORS ADOPTED BY THE AMERICAN ASSOCIATION OF STATE HIGHWAY AND TRANSPORTATION OFFICIALS (AASHTO) AND APPROVED BY FHWA, UNLESS OTHERWISE NOTED.
 - WITHIN THE TRAFFIC SIGN SUMMARY SHEETS FY= FLUORESCENT YELLOW SHEETING (ASTM VII, VIII, OR IX) AND FYG = FLUORESCENT YELLOW-GREEN SHEETING (ASTM TYPE VII, VIII, OR IX).
 - SALVAGED SIGNS CALCULATED IN THE TRAFFIC SIGN SUMMARY SHEET HAVE BEEN INCLUDED INTO THE TOTAL FOR REMOVING SIGNS.
 - UNLESS OTHERWISE DETAILED ON THE PLANS, ALL SIGN BASE MATERIAL SHALL BE FLAT SHEET ALUMINUM WITH THE FOLLOWING MINIMUM THICKNESSES:

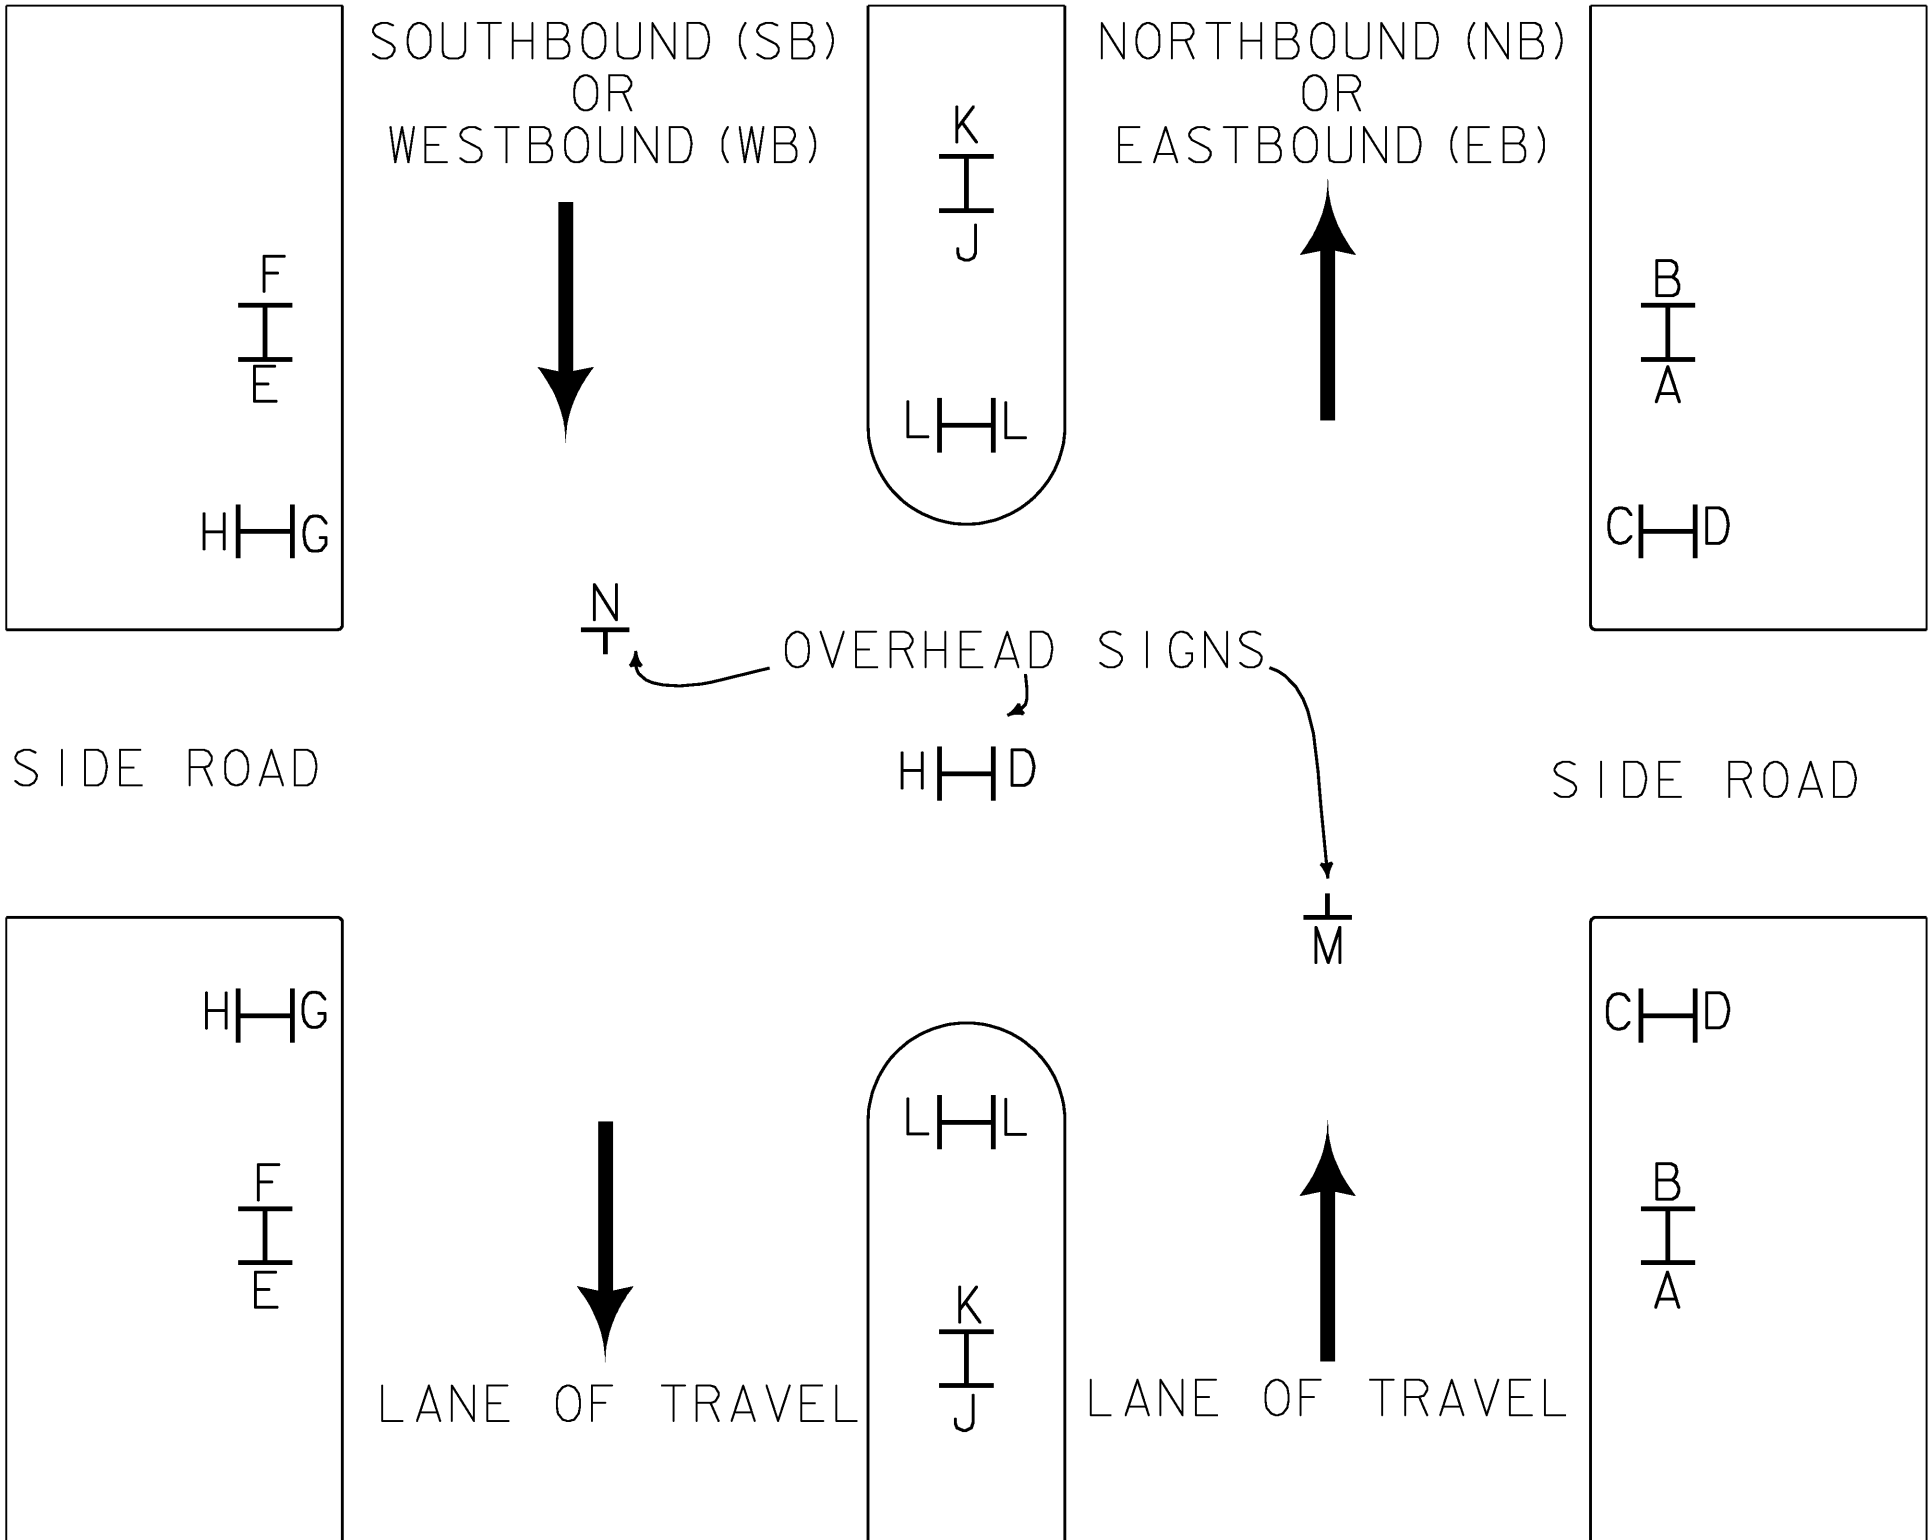
SIZES		24" X 10"		
		24" X 12"	36" X 12"	
		24" X 18"	36" X 15"	
		24" X 24"	36" X 18"	48" X 18"
		24" X 30"	36" X 24"	48" X 24"
	9" X 12"	30" X 15"	30" X 42"	48" X 30"
	12" X 12"	30" X 18"	36" X 36"	48" X 42"
	18" X 18"	30" X 30"	36" X 48"	48" X 48"
	21" X 15"	30" X 42"	36" X 54"	48" X 60"
THICKNESS		0.080"	0.100"	0.125"



ARROW NOTES :

ARROW DIMENSIONS ARE BASED ON "A" DIMENSION. SEE BASE SIGN DETAIL FOR MORE INFORMATION. BASE SIGN DETAILS CAN BE FOUND ON SHEET 6 AND 7 OF THESE PROJECT PLANS.

DIMENSIONS (INCHES)				
A	B	C	D	E
2 ⁵ / ₈	3	5 ¹ / ₄	3 ⁷ / ₈	1 ¹ / ₂
3	3 ¹ / ₂	6 ¹ / ₈	7 ¹ / ₁₆	9 ¹ / ₁₆
3 ¹ / ₈	1 ⁵ / ₈	6 ³ / ₈	1 ¹ / ₂	5 ⁵ / ₈
3 ¹ / ₄	3 ³ / ₄	6 ⁵ / ₈	1 ¹ / ₂	5 ⁵ / ₈
3 ⁵ / ₁₆	13 ³ / ₁₆	6 ¹¹ / ₁₆	1 ¹ / ₂	11 ¹ / ₁₆
3 ¹ / ₂	4	7 ¹ / ₈	9 ¹ / ₁₆	11 ¹ / ₁₆
3 ³ / ₄	4 ⁵ / ₁₆	7 ⁵ / ₈	9 ¹ / ₁₆	3 ³ / ₄
4	4 ⁵ / ₈	8 ¹ / ₈	5 ⁵ / ₈	13 ¹ / ₁₆
4 ³ / ₈	5	8 ⁷ / ₈	11 ¹ / ₁₆	7 ⁷ / ₈
4 ¹ / ₂	5 ³ / ₁₆	9 ¹ / ₈	11 ¹ / ₁₆	7 ⁷ / ₈
4 ³ / ₄	5 ⁷ / ₁₆	9 ⁵ / ₈	3 ³ / ₄	1
5	5 ³ / ₄	10 ¹ / ₈	3 ³ / ₄	1
5 ¹ / ₄	6	10 ⁵ / ₈	13 ¹ / ₁₆	1 ¹ / ₁₆
6	6 ⁷ / ₈	12 ³ / ₁₆	15 ¹ / ₁₆	13 ¹ / ₁₆
6 ¹ / ₂	7 ¹ / ₂	13 ³ / ₁₆	1	15 ¹ / ₁₆
7	8	14 ³ / ₁₆	1 ¹ / ₁₆	13 ⁵ / ₈
8	9 ³ / ₁₆	16 ¹ / ₄	1 ¹ / ₄	15 ⁵ / ₈



THE TRAFFIC SIGN LOCATION CODES ARE TO BE USED INCONJUNCTION WITH THE SIGN SUMMARY SHEETS TO ESTABLISH PROPER SIGN INSTALLATION IN THE FILED.

TRAFFIC SIGN LOCATION CODES

NOT TO SCALE

PROJECT NAME: ROYALTON - BARRE TOWN

PROJECT NUMBER: STPG SIGN (23)

FILE NAME: 09c028_TS.DGN
PROJECT LEADER: N. AVERY
DESIGNED BY: N. AVERY
GENERAL NOTES

PLOT DATE: 23-JUL-2009
DRAWN BY: N. AVERY
CHECKED BY: A. GAMBLE
SHEET 2 OF 80

**STATE OF VERMONT
AGENCY OF TRANSPORTATION**

QUANTITY SHEET

[illegible]

PROJECT NAME: ROYALTON - BARRE TOWN

PROJECT NUMBER: STPG SIGN (23)

FILE NAME: 09c028_TS.DGN

PROJECT LEADER: N. AVERY

DESIGNED BY: N. AVERY

QUNATITY SHEET

PLOT DATE: 16-JUN-2009

DRAWN BY: N. AVERY

CHECKED BY: A. GAMBLE

SHEET 3 OF 80

TEXT	SERIES	DIMENSIONS
ADDISON	C	28.27
ALBANY	C	25.88
ALBURGH	C	29.99
ANDOVER	C	30.05
ARLINGTON	B	29.35
ATHENS	C	24.49
AVERILL	C	26.44
BAKERSFIELD	B	32.50
BARNARD	C	30.49
BARNET	C	24.83
BARRE CITY	B	32.50
BARRE TOWN	B	32.50
BARTON	C	25.38
BELVIDERE	C	32.50
BENNINGTON	B	32.50
BENSON	C	25.41
BERKSHIRE	B	29.04
BERLIN	C	22.50
BETHEL	C	23.80
BLOOMFIELD	B	31.13
BOLTON	C	24.39
BRADFORD	C	32.50
BRAINTREE	C	32.50
BRANDON	C	30.46
BRATTLEBORO	B	32.50
BRIDGEWATER	B	32.50
BRIDPORT	C	32.06
BRIGHTON	C	32.06
BRISTOL	C	27.24
BROOKFIELD	B	31.91
BROWNINGTON	B	31.22
BRUNSWICK	B	30.60
BURKE	C	20.93
BUELS GORE	B	32.50
BURLINGTON	B	32.50
CABOT	C	20.50
CALAIS	C	22.22
CAMBRIDGE	B	29.74
CANAAN	C	25.15
CASTLETON	B	29.32
CAVENDISH	C	32.50
CHARLESTON	B	32.50
CHARLOTTE	B	29.32
CHELSEA	C	28.84
CHESTER	C	28.46
CHITTENDEN	B	30.56
CLARENDON	B	30.32
COLCHESTER	B	32.50
CONCORD	B	30.42
CORINTH	C	27.27
CORNWALL	C	32.50
COVENTRY	C	32.50
CRAFTSBURY	B	32.50
DANBY	C	21.65
DANVILLE	C	31.16
DERBY	C	21.15
DORSET	C	24.55
DOVER	C	20.74
DUMMERSTON	B	32.50
DUXBURY	C	30.75
EDEN	C	15.85
ENOSBURG	C	32.50
EAST HAVEN	B	32.50
E. MONTPELIER	B (5'')	32.50
ELMORE	C	25.46
ESSEX	C	20.38
FAIRFAX	C	27.05
FAIRFIELD	C	32.50
FAIR HAVEN	B	32.50
FAIRLEE	C	26.12
FAYSTON	C	28.85
FERDINAND	B	29.17
FERRISBURGH	B	32.50
FLETCHER	C	31.85
FRANKLIN	C	31.31

TEXT	SERIES	DIMENSIONS
GEORGIA	C	27.74
GLOVER	C	25.00
GOSHEN	C	25.16
GLASTENBURY	B (5'')	31.32
GRAFTON	C	29.31
GRAND ISLE	B	32.50
GRANVILLE	C	32.50
GREENSBORO	B	32.50
GROTON	C	25.35
GUILDHALL	C	32.50
GUILFORD	C	31.78
HALIFAX	C	27.14
HANCOCK	C	29.96
HARDWICK	C	32.50
HARTFORD	C	32.50
HARTLAND	C	32.50
HIGHGATE	C	31.14
HINESBURG	B	29.23
HOLLAND	C	29.22
HUBBARDTON	B	31.42
HYDE PARK	B	32.50
IRA	C	10.15
IRASBURG	C	32.37
ISLE LA MOTTE	B (5'')	32.50
JAMAICA	C	28.26
JAY	C	11.85
JERICHO	C	27.24
JOHNSON	C	30.39
KILLINGTON	B	30.16
KIRBY	C	18.99
LANDGROVE	B	30.33
LEICESTER	C	32.50
LEMINGTON	C	28.79
LONDONDERRY	B (5'')	32.18
LOWELL	C	25.04
LUDLOW	C	26.10
LUNENBERG	B	30.01
LYNDON	C	24.96
MAIDSTONE	B	29.51
MANCHESTER	B	32.50
MARLBORO	C	32.50
MARSHFIELD	B	32.47
MENDON	C	26.02
MIDDLEBURY	B	32.50
MIDDLESEX	B	29.06
MIDDLETOWN SPR	B (5'')	32.50
MILTON	C	22.63
MONTGOMERY	B	32.50
MONTPELIER	B	31.94
MORETOWN	C	32.50
MORGAN	C	26.52
MORRISTOWN	B	32.50
MOUNT HOLLY	B (5'')	31.97
MOUNT TABOR	B	32.02
NEWARK	C	25.65
NEWBURY	C	30.87
NEWFANE	C	29.73
NEW HAVEN	B	32.50
NEWPORT CITY	B (5'')	32.50
NEWPORT TOWN	B (5'')	32.50
NORTH HERO	B	32.50
NORTHFIELD	B	31.57
NORTON	C	25.60
NORWICH	C	28.77
ORANGE	C	25.88
ORWELL	C	25.57
PANTON	C	25.38
PAWLET	C	24.59
PEACHAM	C	30.23
PERU	C	16.38
PITTSFIELD	C	32.50
PITTSFORD	C	32.50
PLAINFIELD	B	29.65
PLYMOUTH	C	32.50
POMFRET	C	29.42

TEXT	SERIES	DIMENSIONS
POULTNEY	C	32.50
POWNAI	C	26.35
PROCTOR	C	29.31
PUTNEY	C	24.83
RANDOLPH	C	32.50
READING	C	27.47
READSBORO	B	31.09
RICHFORD	C	32.06
RICHMOND	C	32.50
RIPTON	C	22.97
ROCHESTER	B	29.54
ROCKINGHAM	B	32.50
ROXBURY	C	30.44
ROYALTON	C	32.50
RUPERT	C	24.94
RUTLAND CITY	B (5'')	32.50
RUTLAND TOWN	B (5'')	32.50
RYEGATE	C	28.47
ST. ALBANS CITY	B (5'')	32.50
ST. ALBANS TOWN	B (5'')	32.50
ST. GEORGE	B	32.50
ST. JOHNSBURY	B (5'')	32.50
SALISBURY	C	32.50
SEARSBURG	B	30.93
SHAFTSBURY	B	32.50
SHARON	C	25.91
SHEFFIELD	C	32.50
SHELDON	C	29.42
SHOREHAM	C	32.50
SHREWSBURY	B	32.50
S. BURLINGTON	B (5'')	32.50
SOUTH HERO	B	32.50
SPRINGFIELD	B	32.50
STAMFORD	C	32.50
STARKSBORO	C	32.50
STOCKBRIDGE	B	32.50
STOWE	C	21.30
STRAFFORD	B	30.42
STRATTON	C	32.06
SUDBURY	C	30.77
SUNDERLAND	B	32.50
SUTTON	C	24.21
SWANTON	C	30.22
THETFORD	C	32.50
TINMOUTH	C	32.14
TOPSHAM	C	30.53
TOWNSHEND	B	31.70
TROY	C	16.54
TUNBRIDGE	C	32.50
UNDERHILL	C	32.50
VERGENNES	B	30.03
VERNON	C	25.79
VERSHIRE	C	31.72
WAITSFIELD	B	30.44
WALDEN	C	25.46
WALLINGFORD	B	32.50
WALTHAM	C	29.91
WARDSBORO	B	32.29
WARREN	C	25.99
WARRENS GORE	B (5'')	32.50
WASHINGTON	B	32.50
WATERBURY	B	31.40
WATERFORD	B	30.65
WATERVILLE	B	31.35
WEATHERSFIELD	B (5'')	32.50
WELLS	C	20.83
WEST FAIRLEE	B (5'')	32.50
WESTFIELD	C	32.50
WEST HAVEN	B	32.50
WESTFORD	C	32.50
WESTMINISTER	B	32.50
WESTMORE	C	32.50
WESTON	C	25.85

TEXT	SERIES	DIMENSIONS
WEST RUTLAND	B (5'')	32.50
WEST WINDSOR	B (5'')	32.50
WEYBRIDGE	C	32.50
WHEELLOCK	C	32.50
WHITING	C	25.86
WHITINGHAM	B	32.50
WILLIAMSTOWN	B (5'')	32.50
WILLISTON	C	32.50
WILMINGTON	B	32.16
WINDHAM	C	29.66
WINDSOR	C	28.77
WINHALL	C	28.24
WINOOSKI	C	30.81
WOLCOTT	C	29.38
WOODBURY	C	32.50
WOODFORD	C	32.50
WOODSTOCK	B	31.79
WORCESTER	B	30.76

NOTES:

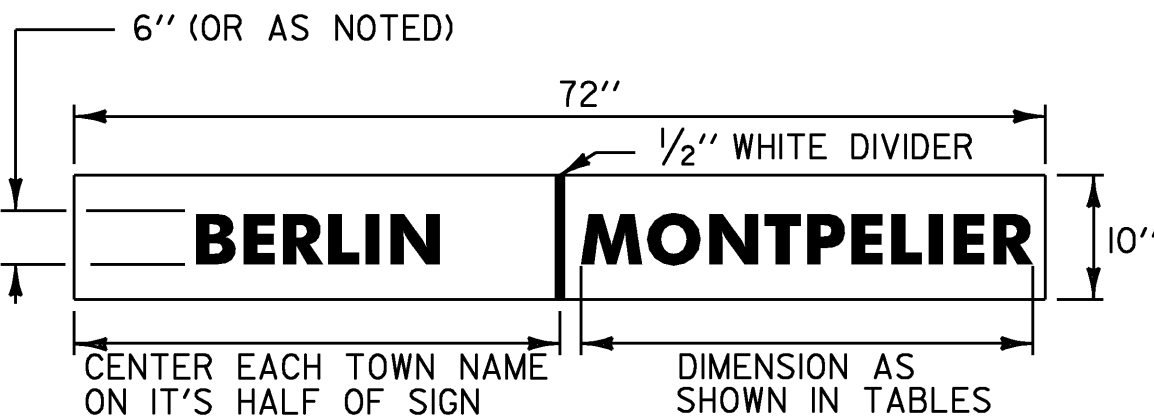
1.

WORD TO WORD SPACING FOR MULTIPLE TEXT TOWN NAMES IS ADJUSTABLE TO ACCOMMODATE DIMENSION REQUIREMENTS.
2.

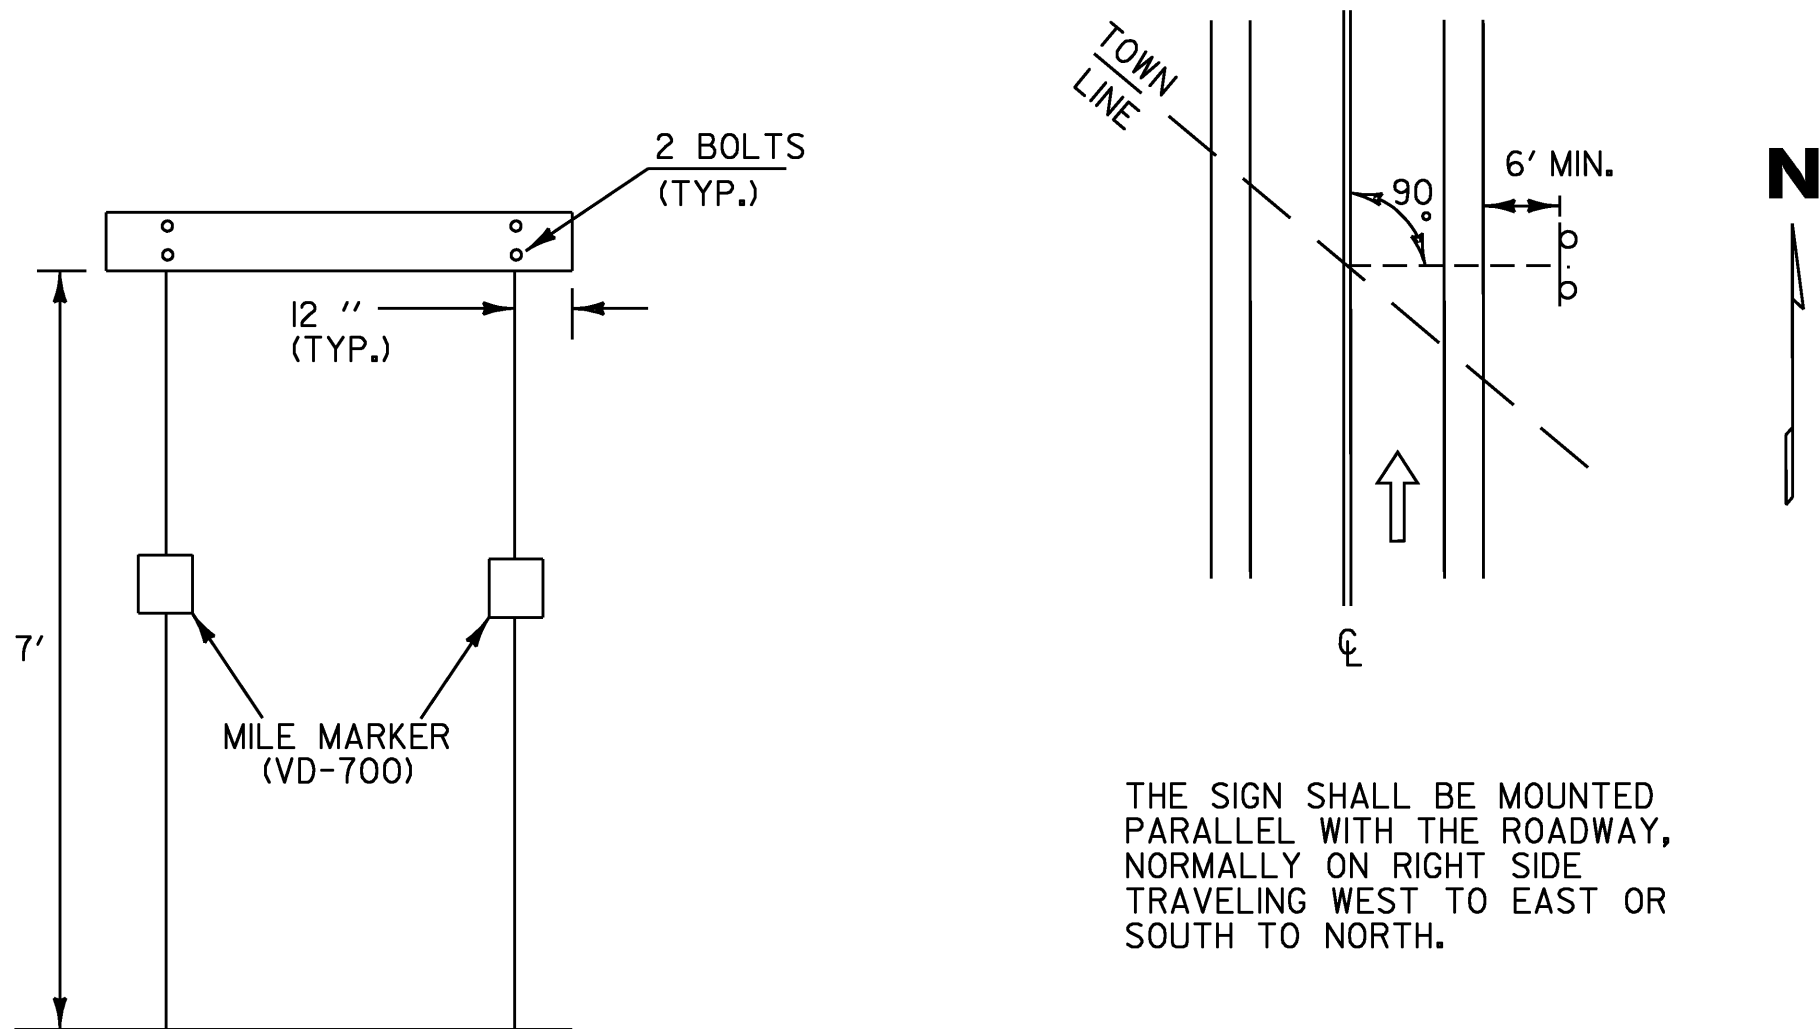
DIMENSIONS SHOWN ARE APPROXIMATE AND MAY BE ADJUSTED SLIGHTLY TO ACCOMMODATE VARIOUS MANUFACTURER'S LETTER WIDTHS.
3.

ALL DIMENSIONS ARE IN INCHESUNLESS OTHERWISE NOTED.

WHEN CROSSING COUNTY BOUNDARIES AN ADDITIONAL COUNTY LINE SIGN SHALL BE MOUNTED BELOW THE TOWN LINE SIGN MAINTAINING AN SEVEN FOOT CLEARANCE.



VD-024
VD-025 SIMILIAR



THE SIGN SHALL BE MOUNTED PARALLEL WITH THE ROADWAY, NORMALLY ON RIGHT SIDE TRAVELING WEST TO EAST OR SOUTH TO NORTH.

COUNTY NAMES

TEXT	SERIES	DIMENSIONS
ADDISON CO.	B	32.50
BENNINGTON CO.	B (5'')	32.50
CALEDONIA CO.	B (5'')	32.50
CHITTENDEN CO.	B (5'')	32.50
ESSEX CO.	C	32.50
FRANKLIN CO.	B (5'')	32.50
GRAND ISLE CO.	B (5'')	32.50
LAMOILLE CO.	B (5'')	32.50
ORANGE CO.	B	32.50
ORLEANS CO.	B	32.50
RUTLAND CO.	B	32.50
WASHINGTON CO.	B (5'')	32.50
WINDHAM CO.	B	32.50
WINDSOR CO.	B	32.50

VD-025

TOWN/COUNTY LINE SIGN NOTES:

1.

THE SIGN BASE MATERIAL SHALL BE HIGH DENSITY OVERLAID PLYWOOD 5/8 INCH THICK OR ALUMINUM SHEETING 0.125' MINIMUM THICKNESS. THE RETROREFLECTIVE MATERIAL SHALL BE SHEETING APPLIED TO THE ENTIRE BACKGROUND OF THE SIGN. THE LEGEND SHALL BE CUT-OUT RETROREFLECTIVE LEGEND. ALL RETROREFLECTIVE MATERIAL SHALL BE EQUAL TO OR EXCEEDING THE "THE AMERICAN SOCIETY OF TESTING AND MATERIALS" (ASTM) TYPE III.
2.

SIGNS SHALL HAVE MINIMUM ASTM TYPE IIISHEETING WITH A WHITE LEGEND ON A GREEN BACKGROUND.
3.

LEGEND SHALL CONFORM WITH THE STANDARD ALPHABETS FOR HIGHWAY SIGNS APPROVED BY THE NATIONAL JOINT COMMITTEE ON UNIFORM TRAFFIC CONTROL DEVICES.
4.

ALL SIGNS SHALL BE IN ACCORDANCE WITH "THE MANUAL ON UNIFORM TRAFFIC CONTROL DEVICES" (2003 MUTCD) AND THE "STANDARD HIGHWAY SIGNS" BOOK (SHS) PUBLISHED BY THE FEDERAL HIGHWAY ADMINISTRATION (FHWA).

PROJECT NAME: ROYALTON - BARRE TOWN

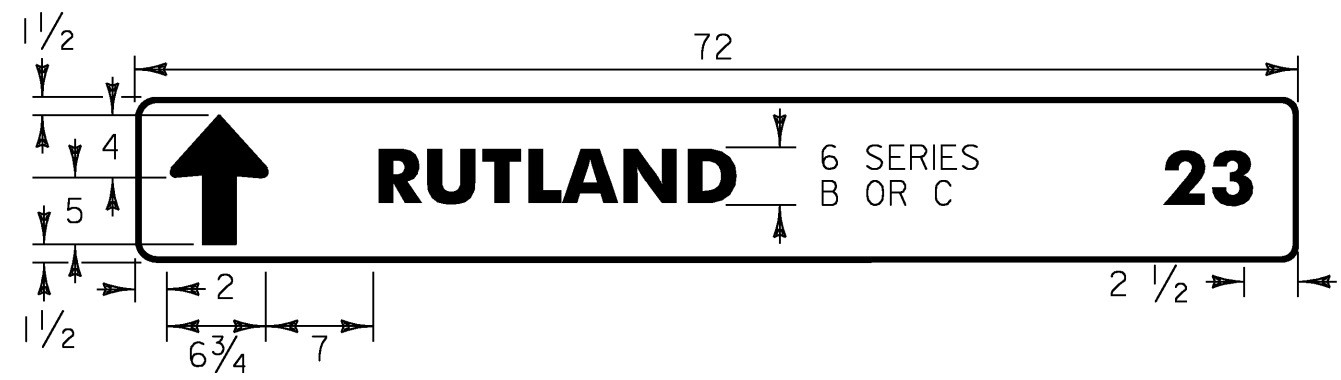
PROJECT NUMBER: STPG SIGN (23)

FILE NAME: 09c028_TS.DGN
PROJECT LEADER: N. AVERY
DESIGNED BY: N. AVERY
COUNTY/ TOWNLIN DESIGN

PLOT DATE: 16-JUN-2009
DRAWN BY: N. AVERY
CHECKED BY: A. GAMBLE
SHEET 4 OF 80



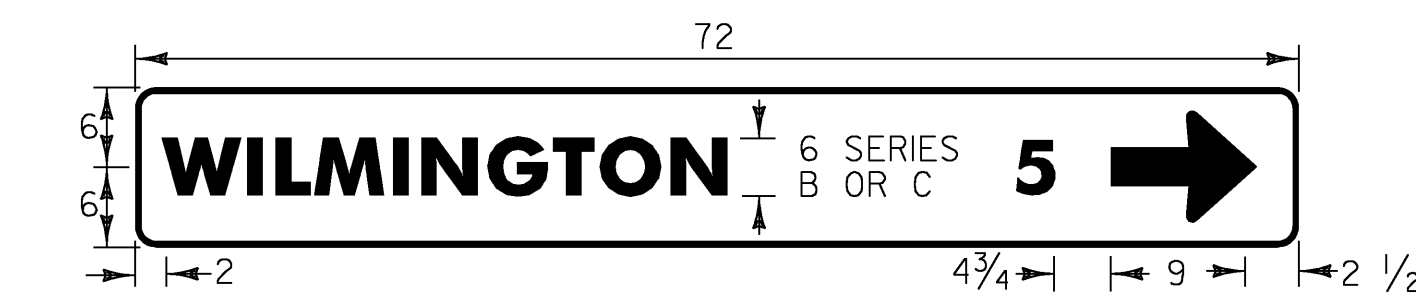
D1-1



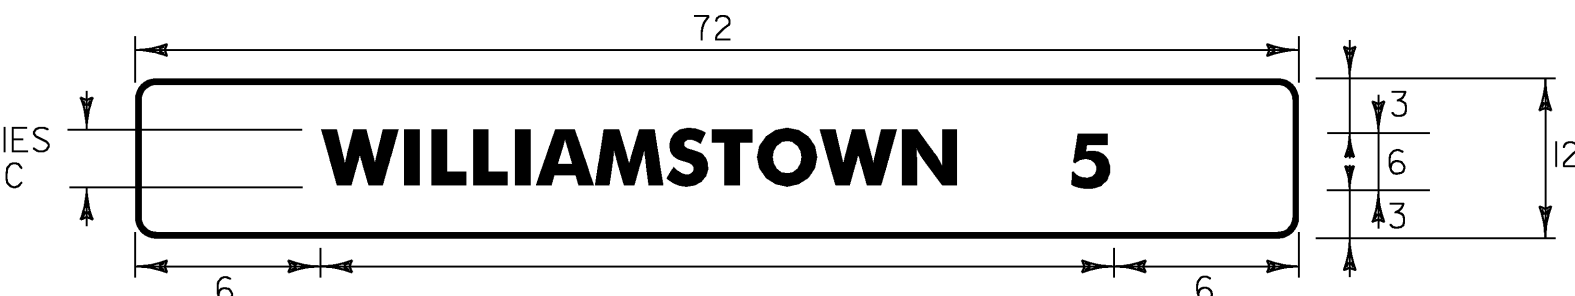
D1-1A



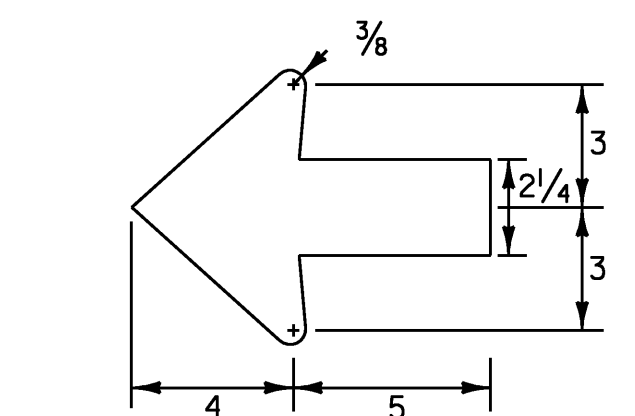
D1-1A



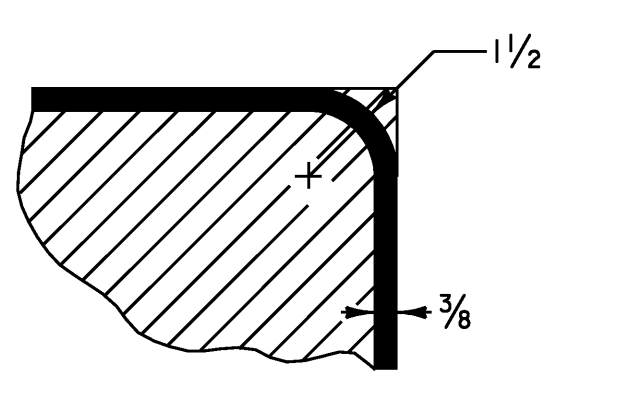
D1-1A



D2-1



STANDARD ARROW

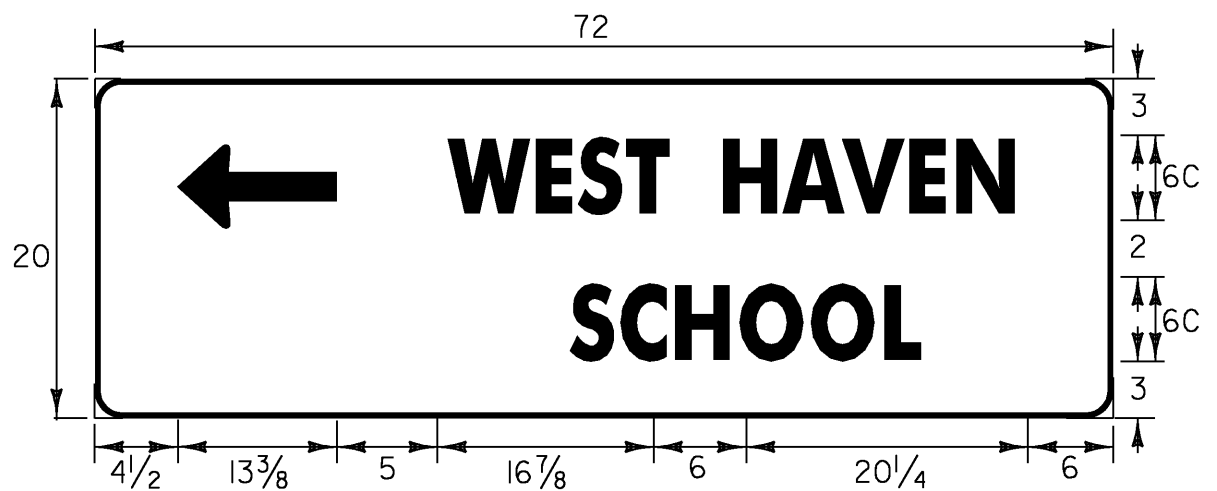


BORDER DETAIL

STANDARD DESTINATION SIGN NOTES

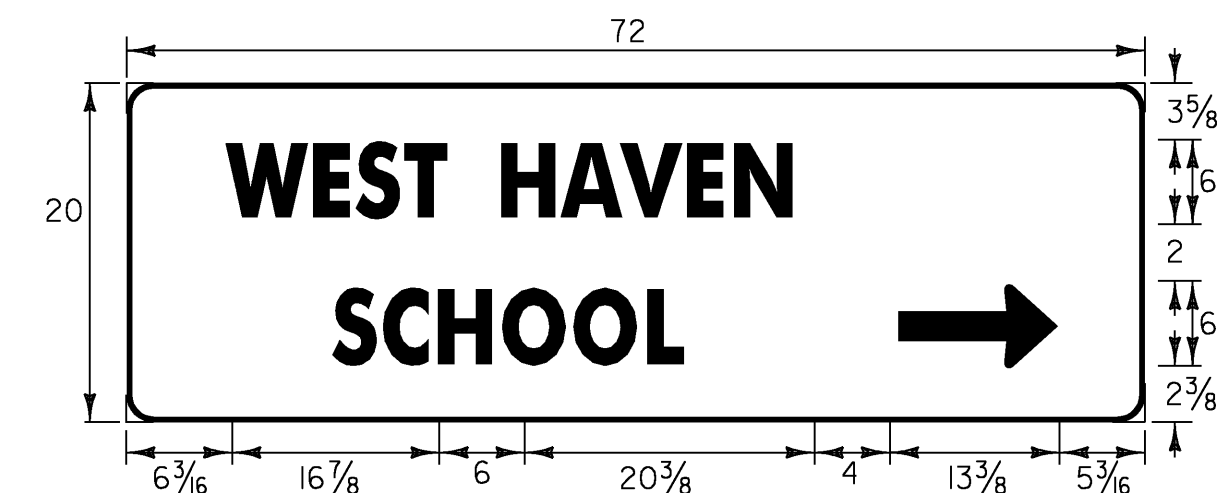
D1-1, D1-1A, D1-2, D2-1

- ALL SIGNS SHALL BE IN ACCORDANCE WITH THE MUTCD AND THE "STANDARD HIGHWAY SIGNS" BOOK (SHS) PUBLISHED BY THE FEDERAL HIGHWAY ADMINISTRATION (FHWA).
- THE SIGN BASE MATERIAL FOR STANDARD DESTINATION SIGNS SHALL BE HIGH DENSITY OVERLAYED PLYWOOD 3/8 INCH THICK OR FLAT SHEET ALUMINUM 1/8 INCH THICK.
- THE DESTINATION SIGNS SHOWN ON THIS SHEET SHALL HAVE WHITE RETROREFLECTIVE ASTM TYPE III TEXT, ARROWS AND BORDERS ON A GREEN RETROREFLECTIVE ASTM TYPE III BACKGROUND. THE COLORS SHALL CONFORM WITH THE COLORS ADOPTED BY AASHTO AND APPROVED BY THE FHWA.
- MULTIPLE ASSEMBLIES SHALL USE THE SAME SIZE THROUGHOUT. DO NOT MIX AND MATCH OLDER SIGN SIZES WITH NEW SIGN HEIGHTS AND WIDTHS.
- ALL DIMENSIONS SHOWN IN INCHES, UNLESS OTHERWISE NOTED.



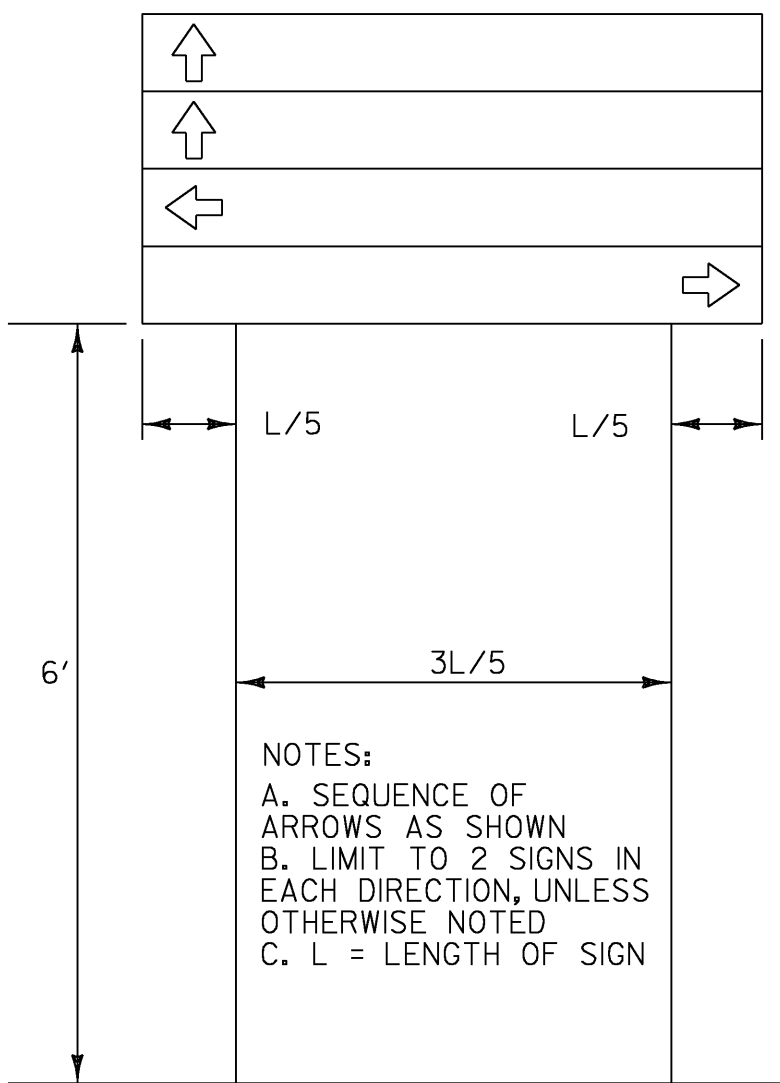
D1-2 (L)

LATERAL SPACING OF "SCHOOL" TEXT SHALL BE CENTERED TO TOP LINE TEXT.



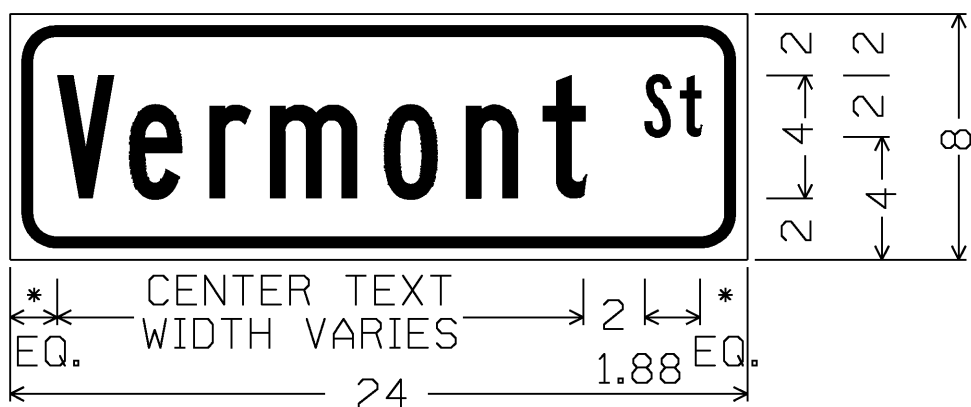
D1-2 (R)

LATERAL SPACING OF "SCHOOL" TEXT SHALL BE CENTERED TO TOP LINE TEXT.



DESTINATION ASSEMBLY

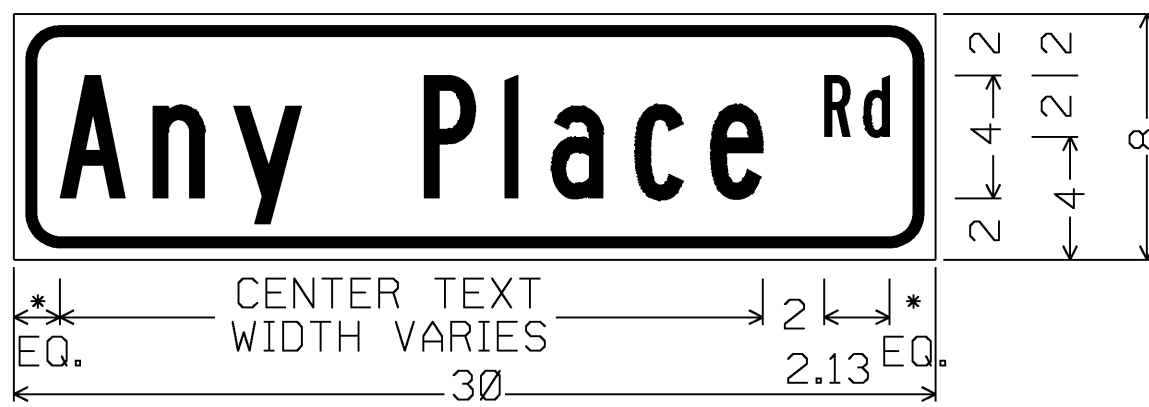
NOTES:
A. SEQUENCE OF ARROWS AS SHOWN
B. LIMIT TO 2 SIGNS IN EACH DIRECTION, UNLESS OTHERWISE NOTED
C. L = LENGTH OF SIGN



1.5" RADIUS, 0.375" BORDER, 0.375" INDENT
COLORS: LEGEND - BLACK
BACKGROUND - YELLOW
TEXT STYLE: B

* LATERAL SPACING TO OUTSIDE OF PANEL SHALL BE A MINIMUM OF 1.5"

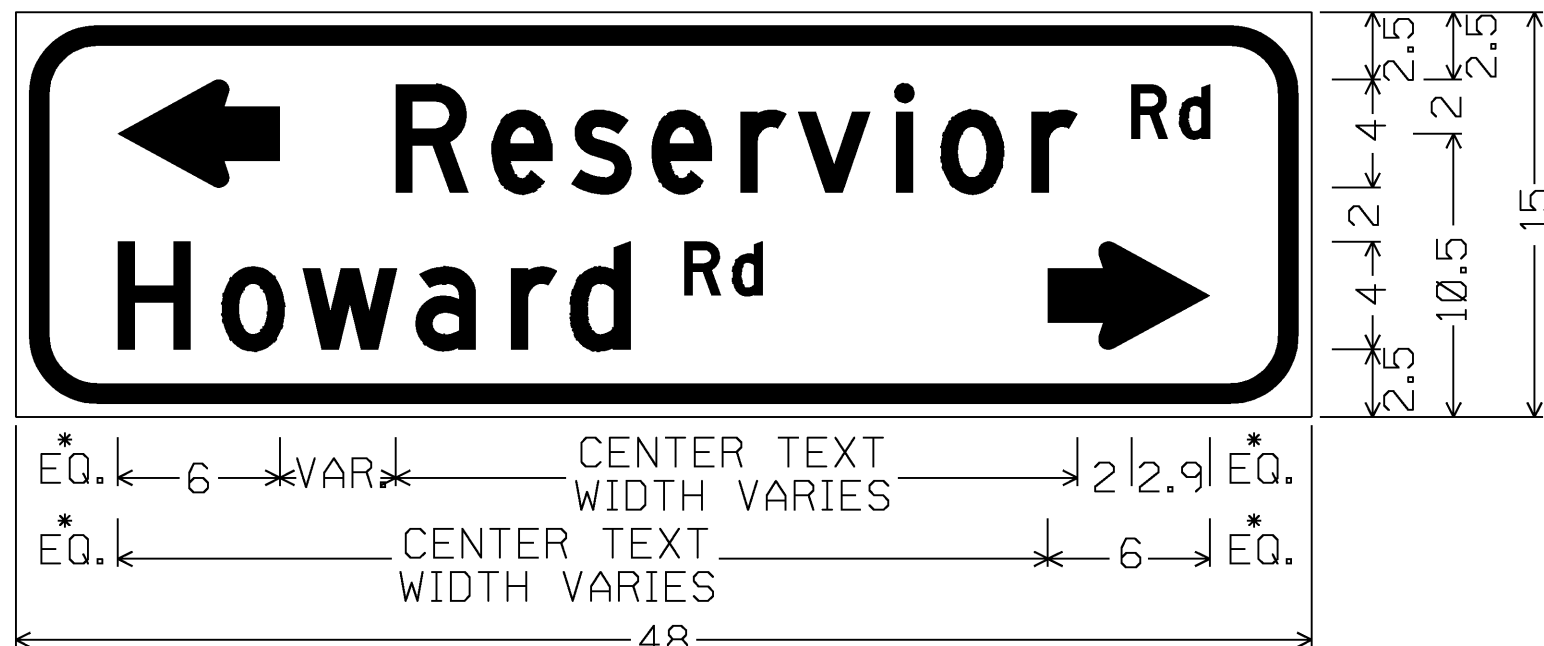
W16-8



1.5" RADIUS, 0.375" BORDER, 0.375" INDENT
COLORS: LEGEND - BLACK
BACKGROUND - YELLOW
TEXT STYLE: B

* LATERAL SPACING TO OUTSIDE OF PANEL SHALL BE A MINIMUM OF 1.5"

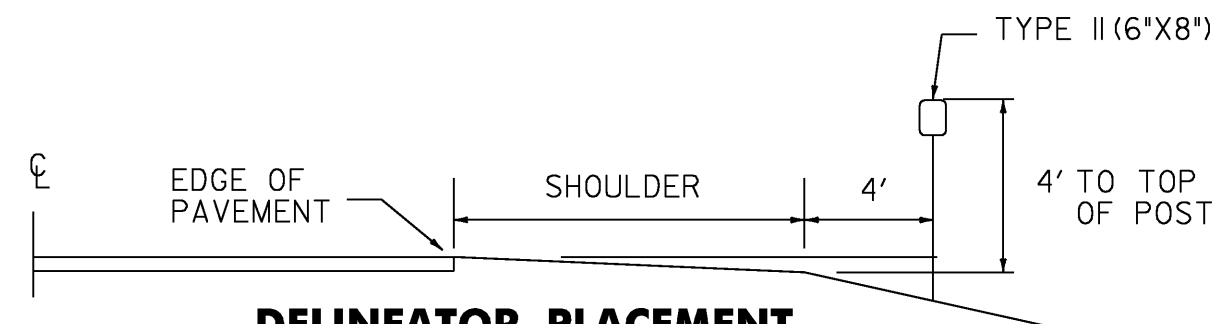
W16-8



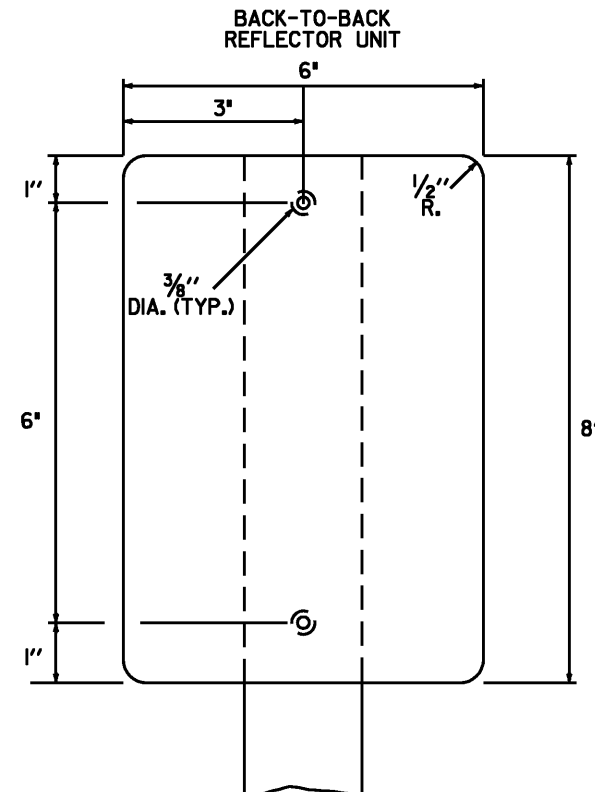
3" RADIUS, 0.75" BORDER, 0.50" INDENT
COLORS: LEGEND - BLACK
BACKGROUND - YELLOW
TEXT STYLE: D; STANDARD ARROW CUSTOM 6" WIDE X 4" HIGH

* LATERAL SPACING TO OUTSIDE OF PANEL SHALL BE A MINIMUM OF 3"

W16-8a



DELINEATOR PLACEMENT



TYPE II (6"X8")

DELINEATORS WITH REFLECTIVE SHEETING

MATERIAL FOR RETROREFLECTIVE SHEETING FOR DELINEATORS SHALL BE A 0.063" ALUMINUM BACKING WITH A WHITE ASTM TYPE III OR TYPE IV.



1.5" RADIUS, 0.375" BORDER, 0.375" INDENT
COLORS: LEGEND - BLACK
BACKGROUND - YELLOW
TEXT STYLE: B

* LATERAL SPACING TO OUTSIDE OF PANEL SHALL BE A MINIMUM OF 1.5"

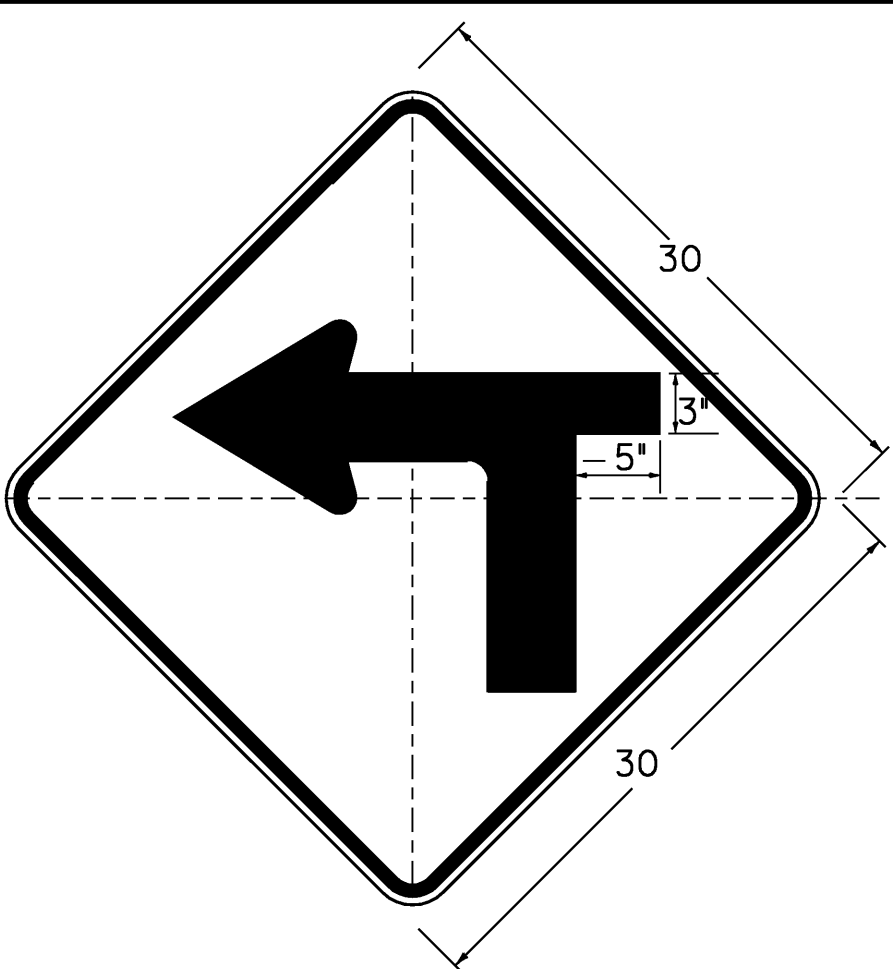
W16-8

PROJECT NAME: ROYALTON - BARRE TOWN

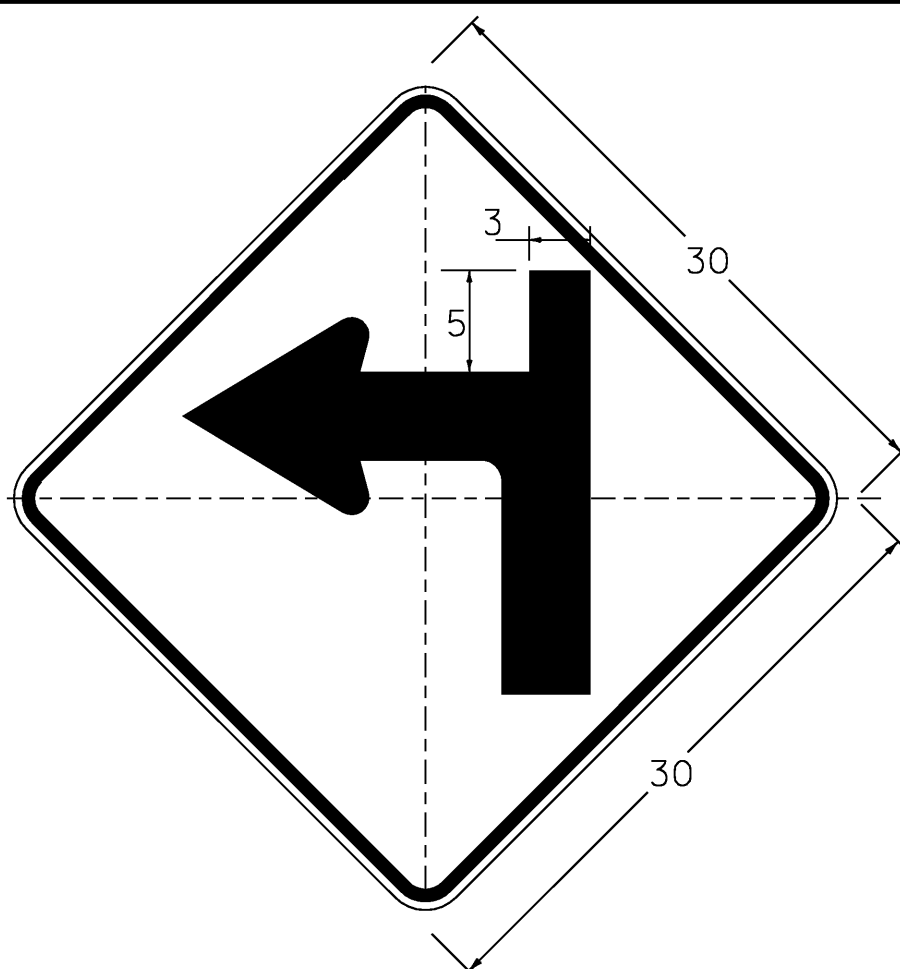
PROJECT NUMBER: STPG SIGN (23)

FILE NAME: 09c028_TS.DGN
PROJECT LEADER: N. AVERY
DESIGNED BY: N. AVERY
SIGN DETAILS I

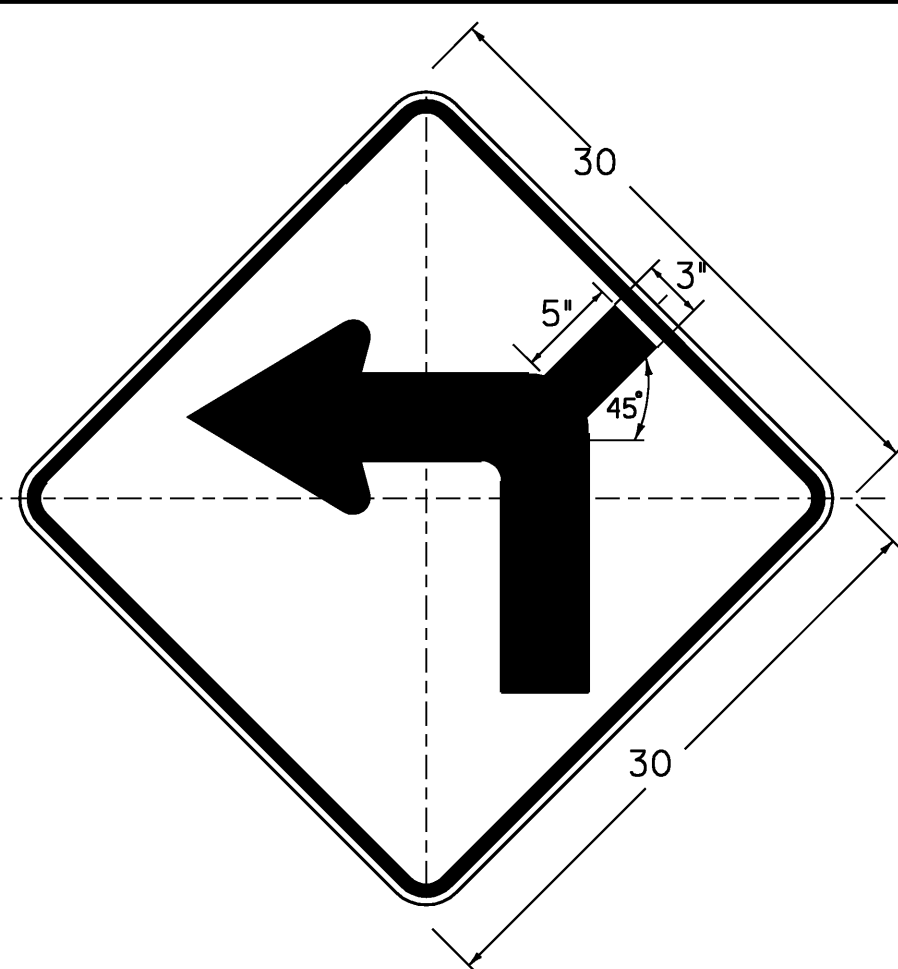
PLOT DATE: 30-JUN-2009
DRAWN BY: N. AVERY
CHECKED BY: A. GAMBLE
SHEET 5 OF 80



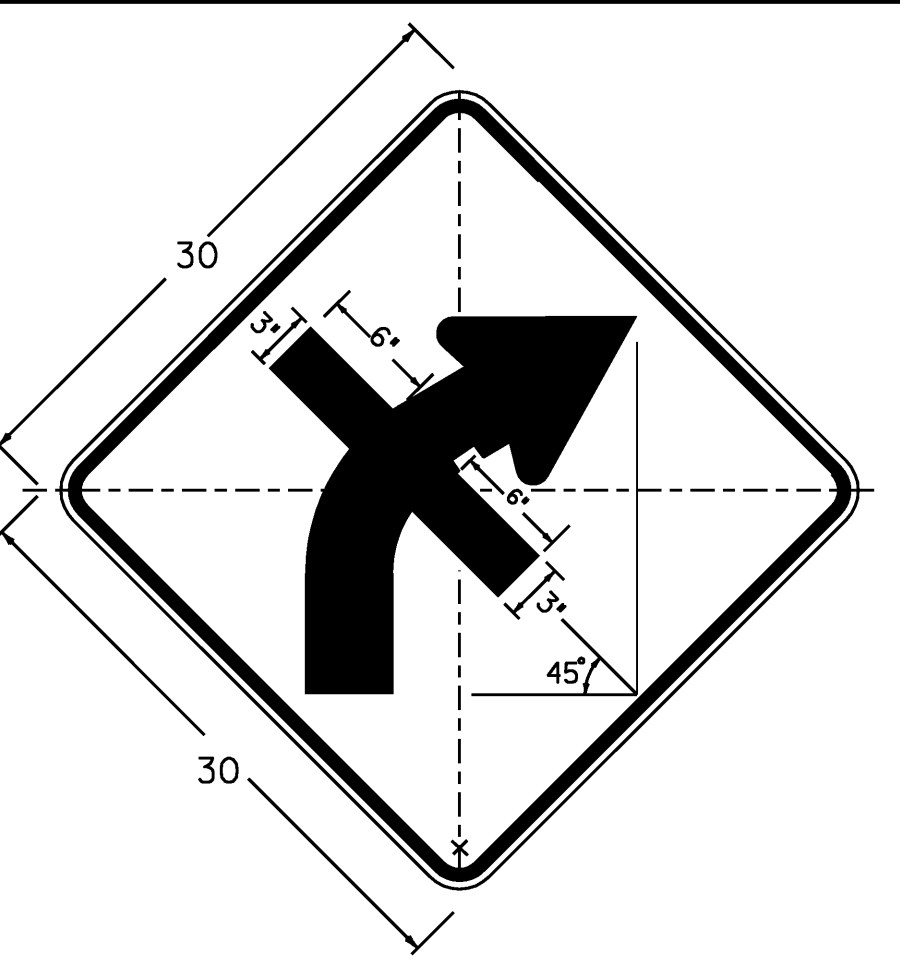
W1-1Ma L(R)
DIMENSIONS NOT SHOWN
FOR THIS DETAIL SHALL CONFORM
TO THE LATEST EDITION OF THE 2003 MUTCD
FOR SIGN DETAIL W1-1.
UNLESS OTHERWISE NOTED FOR THIS DETAIL



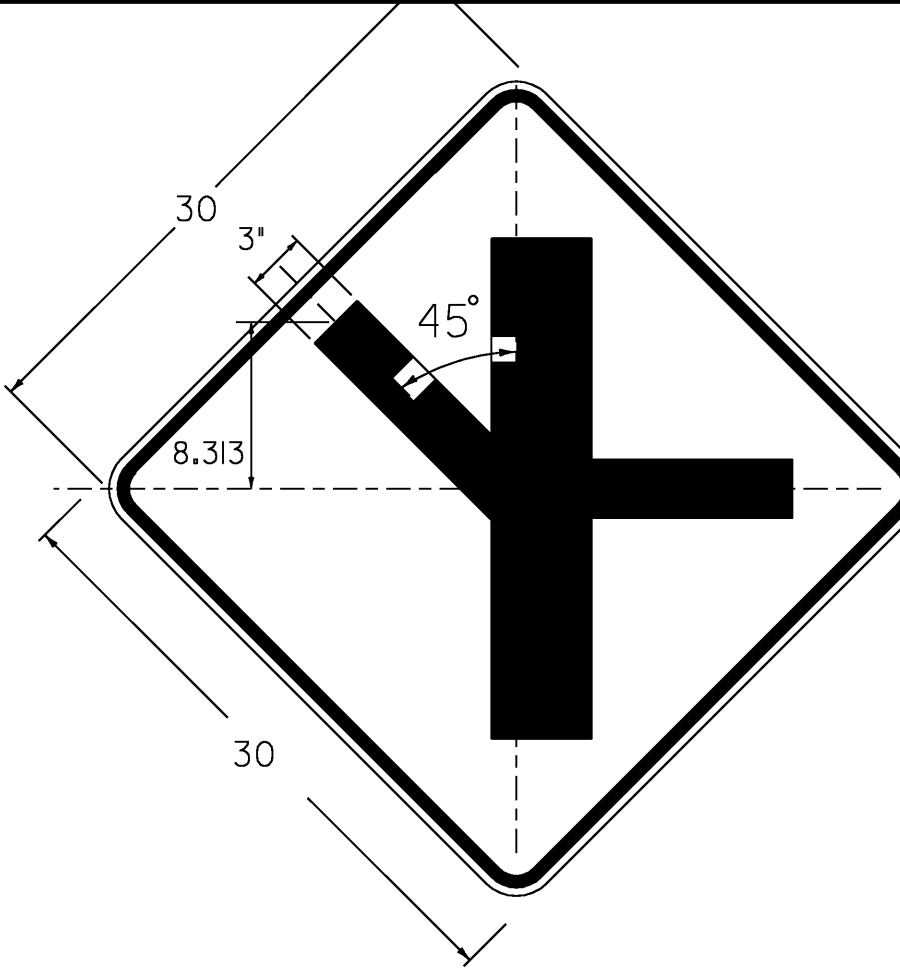
W1-1Mb L(R)
DIMENSIONS NOT SHOWN
FOR THIS DETAIL SHALL CONFORM
TO THE LATEST EDITION OF THE 2003 MUTCD
FOR SIGN DETAIL W1-1.
UNLESS OTHERWISE NOTED FOR THIS DETAIL



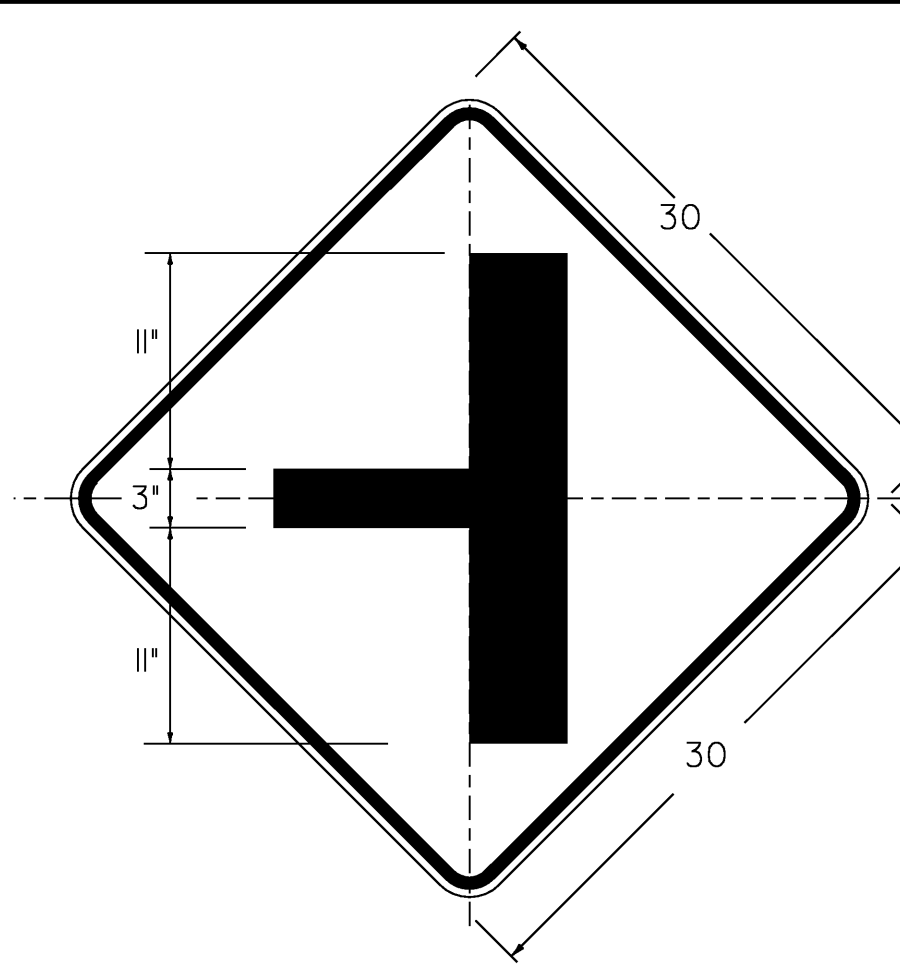
W1-1Md L(R)
DIMENSIONS NOT SHOWN
FOR THIS DETAIL SHALL CONFORM
TO THE LATEST EDITION OF THE 2003 MUTCD
FOR SIGN DETAIL W1-1.
UNLESS OTHERWISE NOTED FOR THIS DETAIL



W1-2Ma R(L)
DIMENSIONS NOT SHOWN
FOR THIS DETAIL SHALL CONFORM
TO THE LATEST EDITION OF THE 2003 MUTCD
FOR SIGN DETAIL W1-2.
UNLESS OTHERWISE NOTED FOR THIS DETAIL



W2-1MJ L(R)
DIMENSIONS NOT SHOWN
FOR THIS DETAIL SHALL CONFORM
TO THE LATEST EDITION OF THE 2003 MUTCD
FOR SIGN DETAIL W1-1.
UNLESS OTHERWISE NOTED FOR THIS DETAIL



W2-2Ma L(R)
DIMENSIONS NOT SHOWN
FOR THIS DETAIL SHALL CONFORM
TO THE LATEST EDITION OF THE 2003 MUTCD
FOR SIGN DETAIL W2-2.
UNLESS OTHERWISE NOTED FOR THIS DETAIL



R2-1
1.5" RADIUS, 0.625" BORDER, 0.375" INDENT
COLORS: LEGEND - BLACK
BACKGROUND - WHITE
TEXT STYLE: "SPEED" E; "LIMIT" E; "40" E



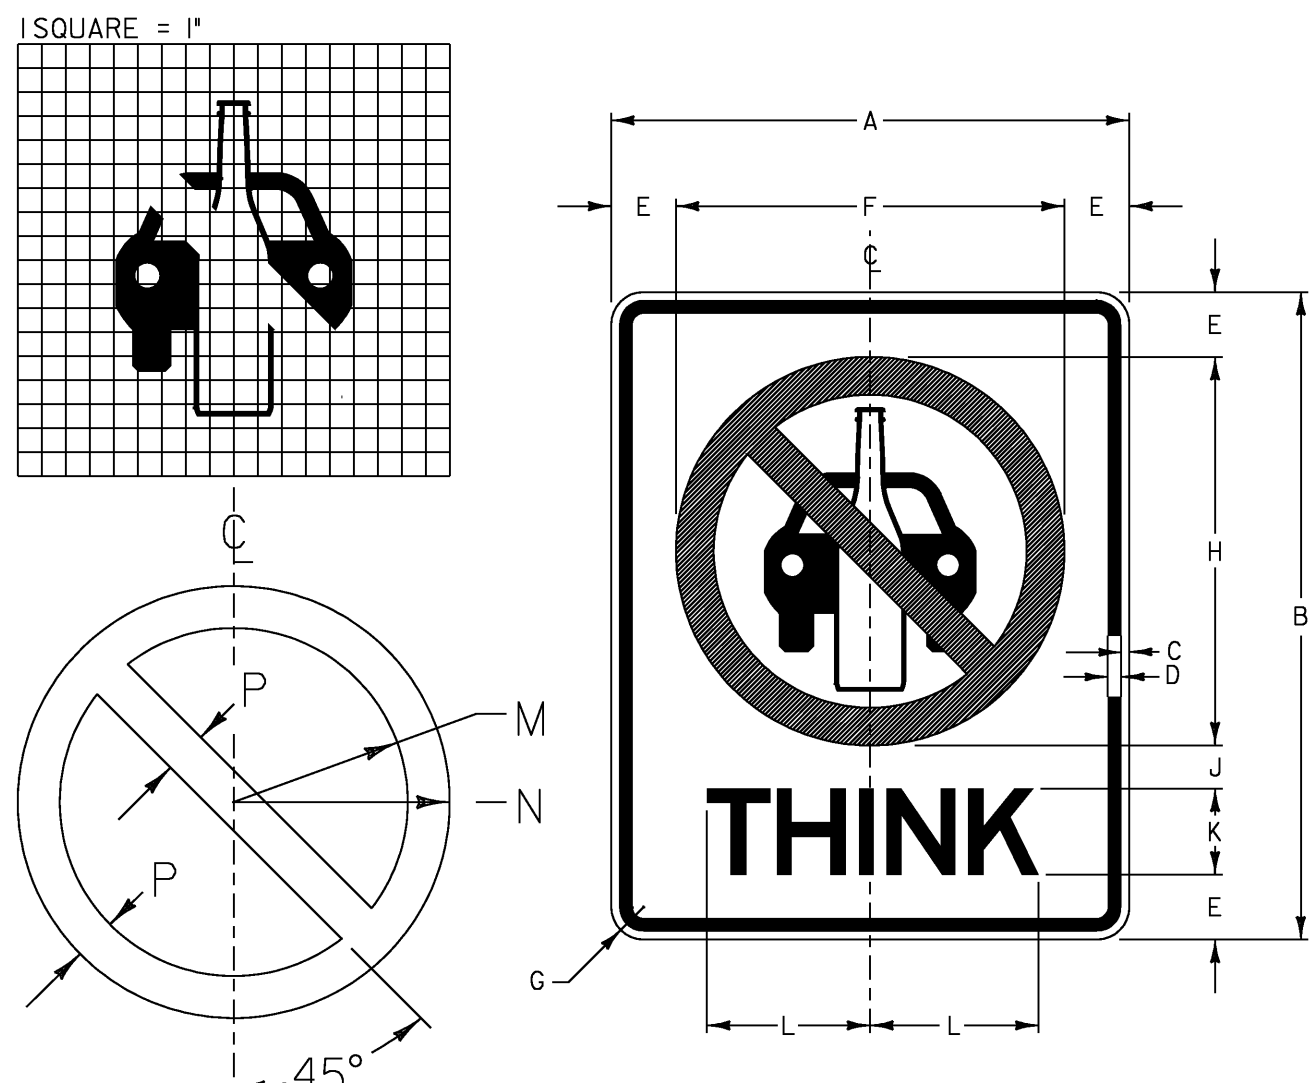
VR-644p
1.5" RADIUS, 0.625" BORDER, 0.375" INDENT
COLORS: LEGEND - RED
BACKGROUND - WHITE
TEXT STYLE: "BEGIN" C



VR - 020
COLORS: LEGEND - RED
BACKGROUND - WHITE



VR-023b
* REDUCE SPACING 40%
** REDUCE SPACING 60%
COLORS: LEGEND - BLACK
BACKGROUND - WHITE



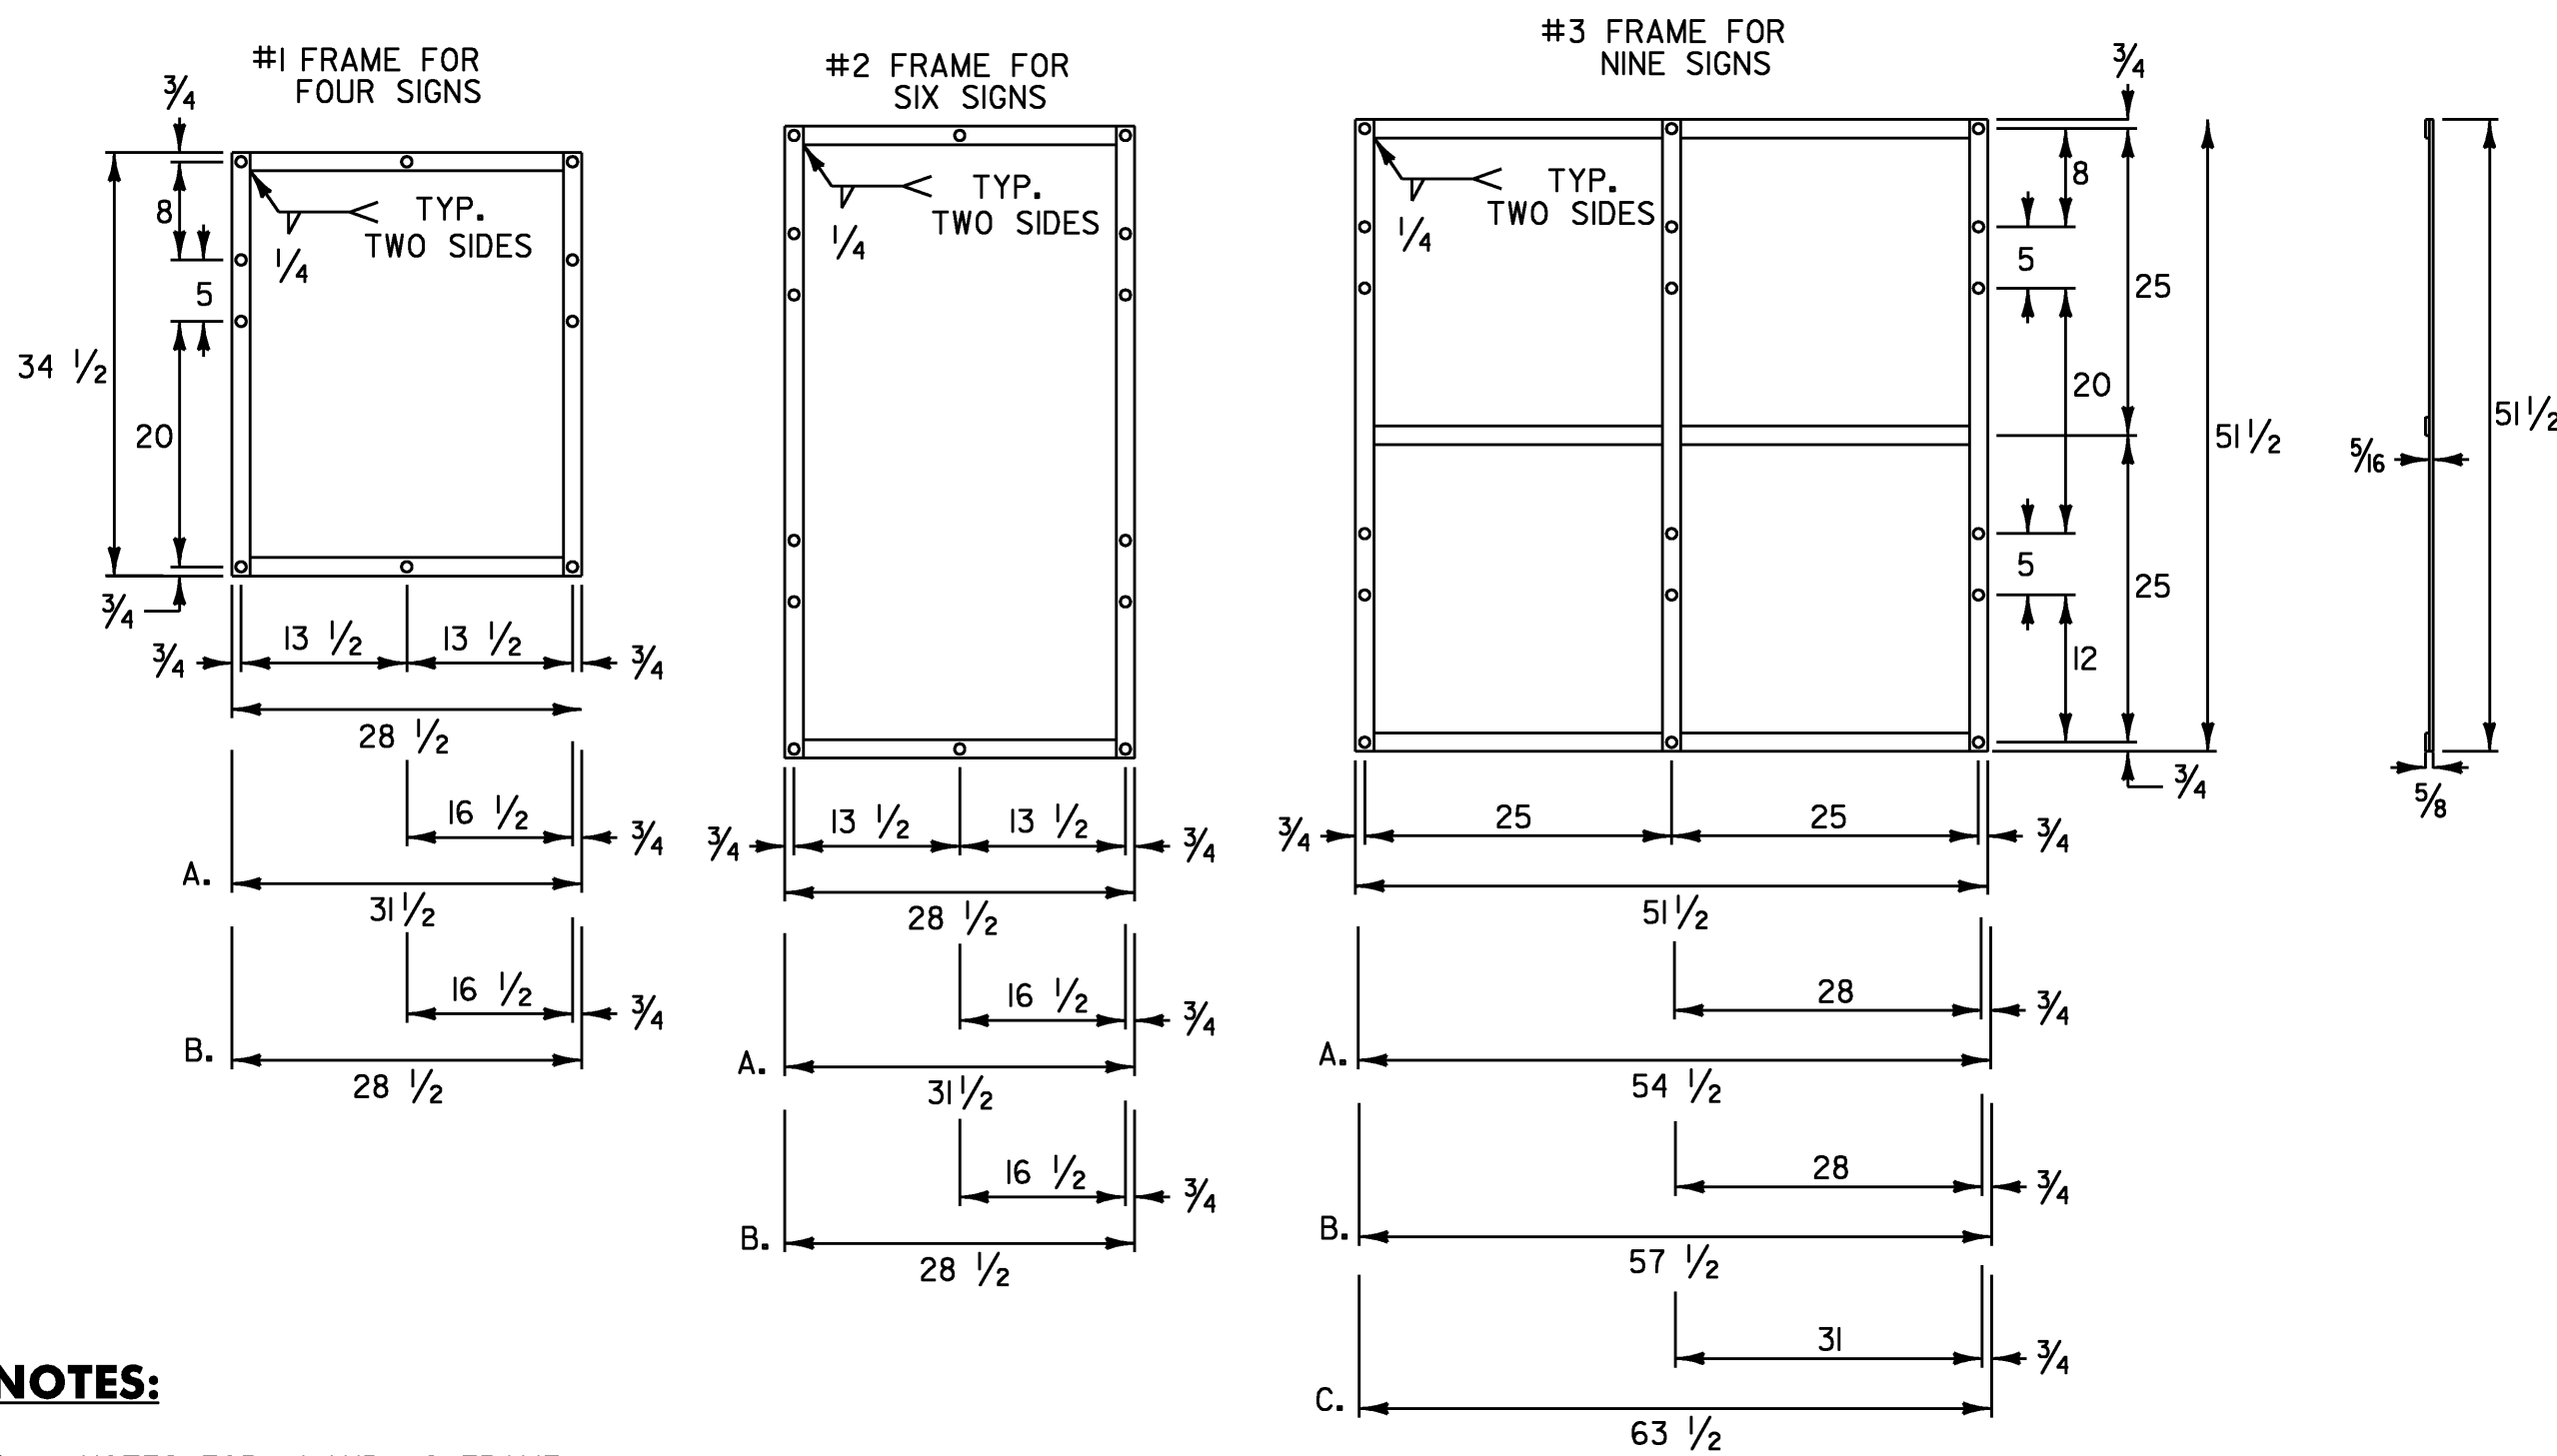
SIGN	DIMENSIONS (INCHES)												
	A	B	C	D	E	F	G	H	J	K	L	M	N
STD.	24	30	3/8	5/8	3	18	1/2	18	2	4E	7 1/8	7 1/4	9

COLORS
TEXT - BLACK (NON-REFL.)
CAR & BOTTLE SYMBOL - BLACK (NON-REFL.)
PROHIBITED SYMBOL - RED (NON-REFL.)
BACKGROUND - WHITE (REFL.)

VR-072

PROJECT NAME:	ROYALTON - BARRE TOWN
PROJECT NUMBER:	STPG SIGN (23)
FILE NAME:	09c028_TS.DGN
PROJECT LEADER:	N. AVERY
DESIGNED BY:	N. AVERY
SIGN DETAILS	2
PLOT DATE:	16-JUN-2009
DRAWN BY:	N. AVERY
CHECKED BY:	A. GAMBLE
SHEET	6
OF	80

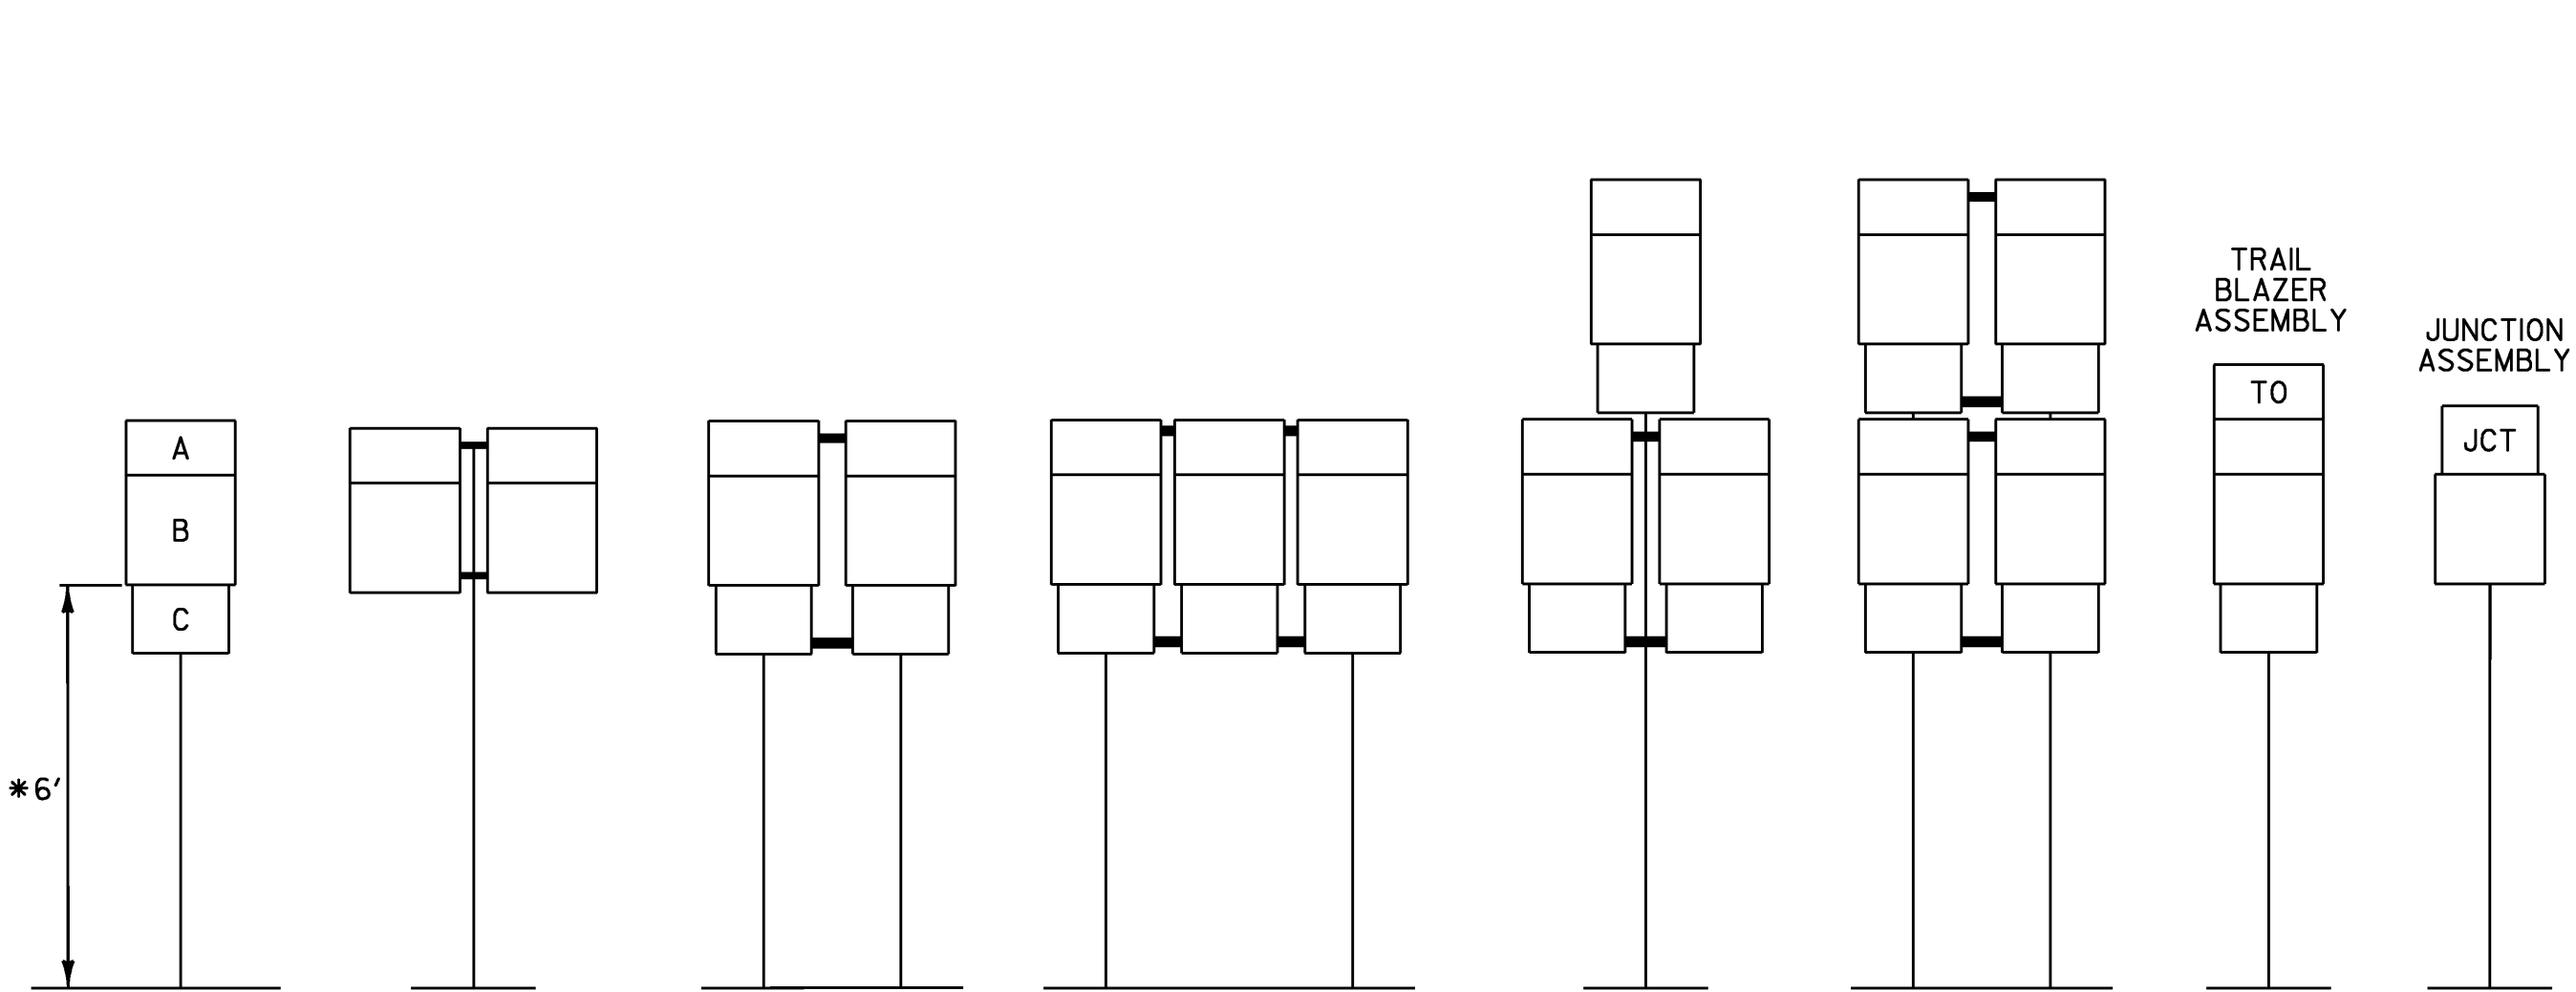
ROUTE MARKER ASSEMBLY FRAMES



NOTES:

- NOTES FOR #1 AND #2 FRAME:
A. WITH ONE 30 INCH THREE DIGIT SIGN
B. WITH TWO 30 INCH THREE DIGIT SIGNS
- NOTES FOR #3 FRAME:
A. WITH ONE 30 INCH THREE DIGIT SIGN
IN AN OUTSIDE POSITION.
B. WITH ONE 30 INCH THREE DIGIT SIGN
IN THE CENTER POSITION OR TWO
SUCH SIGNS IN THE OUTSIDE POSITIONS.
C. WITH THREE 30 INCH THREE DIGIT SIGNS.
- ALL HOLES SHALL BE $\frac{7}{16}$ INCH DIAMETER. FOR OTHER SIGN COMBINATIONS,
THAN ABOVE, THE FRAME DIMENSIONS AND HOLE SPACING SHALL BE
MODIFIED AS NECESSARY. THE FRAME SHALL BE PAINTED WITH ONE COAT
OF PRIMER AND A SECOND COAT OF BLACK PAINT. THE PAINT SHALL BE
OF THE TYPE USED ON EXTERIOR METAL SURFACES TO PREVENT METAL
CORROSION.
- STANDARD FRAMES SHALL BE $\frac{5}{16}$ INCH $\times$ $1\frac{1}{2}$ INCH WELDED A-36 STEEL.
- ALL DIMENSIONS SHOWN IN INCHES, UNLESS OTHERWISE NOTED.

STANDARD MOUNTING OF ROUTE MARKER ASSEMBLIES



- A - CARDINAL DIRECTION MARKER
B - ROUTE NUMBER
C - ADVANCE TURN ARROW OR
DIRECTIONAL ARROW

* WHERE PARKING OR PEDESTRIAN TRAFFIC WILL OCCUR IN THE
IMMEDIATE VICINITY OF THESE SIGNS MINIMUM VERTICAL
CLEARANCE SHALL BE INCREASED TO SEVEN FEET

INSTALLATION SEQUENCE:

IN MULTIPLE HORIZONTAL MOUNTINGS PLACE A
ROUTE MARKER ASSEMBLY INDICATING A LEFT
TURN ON THE LEFT SIDE OF THE ASSEMBLY;
RIGHT TURN ON THE RIGHT SIDE. FOR VERTICALLY
STACKED MOUNTINGS PLACE THE STRAIGHT
THROUGH MOVE INDICATION ON TOP, THE LEFT
OR RIGHT TURNS AS APPROPRIATE BENEATH.

NOTES:

- ALL DIMENSIONS SHOWN IN INCHES, UNLESS OTHERWISE NOTED.
- VERTICAL FRAME MEMBERS SHALL LINE UP WITH SIGN POST
ON WHICH THEY ARE MOUNTED.

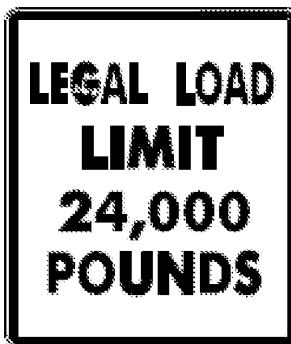
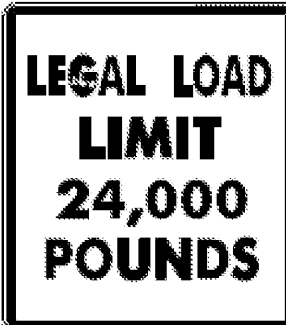
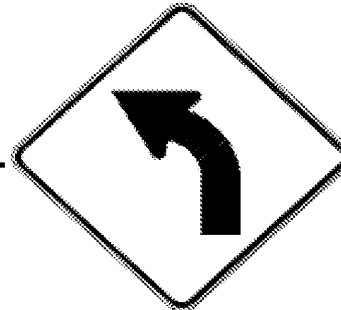
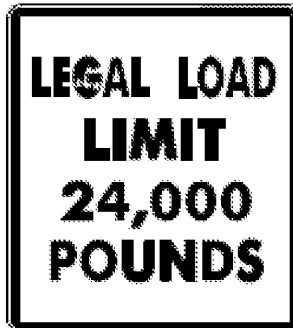
PROJECT NAME: ROYALTON - BARRE TOWN

PROJECT NUMBER: STPG SIGN (23)

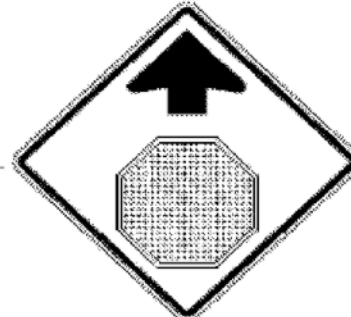
FILE NAME: 09c028_TS.DGN
PROJECT LEADER: N. AVERY
DESIGNED BY: N. AVERY
GUIDE SIGN ASSEMBLY

PLOT DATE: 16-JUN-2009
DRAWN BY: N. AVERY
CHECKED BY: A. GAMBLE
SHEET 7 OF 80

DIRECTION	MILEPOINT	LOCATION CODE (SHEET 2)	SIGN CODE	WIDTH (IN)	HEIGHT (IN)	SHEETING REMARKS	SIGN LEGEND	NEW SIGNS		EXISTING SIGNS				EXIST POST		NUMBER OF NEW POSTS	SQUARE STEEL (IN)			TUBULAR STEEL Ø (IN)				SIGN FRAME REQUIRED	REMARKS	SIGN DETAIL																																																																																																																																																																																																																																																																																																																																																																																																																																																																																																																												
								"A"	"B"	RETAIN	SALVAGE FROM	SALVAGE TO	REMOVE	RETAIN	REMOVE		1.75	2.00	2.50	FOUNDATION	3.00	3.50	4.00			5.00	DETAIL IN SHS	DETAIL ON SHEET NUMBER	DETAIL ON STD SHEET NUMBER																																																																																																																																																																																																																																																																																																																																																																																																																																																																																																																									
																	(LB / FT)				(LB / FT)																																																																																																																																																																																																																																																																																																																																																																																																																																																																																																																																	
																	1.88	2.42	3.35		7.60	9.00	10.80			14.60																																																																																																																																																																																																																																																																																																																																																																																																																																																																																																																												
ROYALTON VT 110							FY-FLUORESCENT YELLOW FYG-FLUORESCENT YELLOW GREEN															"SHS"-STANDARD HIGHWAY SIGNS																																																																																																																																																																																																																																																																																																																																																																																																																																																																																																																																
NB	0.010	A	R2-1	24	30			5.00					1	X																																																																																																																																																																																																																																																																																																																																																																																																																																																																																																																																								

DIRECTION	MILEPOINT	LOCATION CODE (SHEET 2)	SIGN CODE	WIDTH (IN)	HEIGHT (IN)	SHEETING REMARKS	SIGN LEGEND	NEW SIGNS		EXISTING SIGNS				EXIST POST		NUMBER OF NEW POSTS	SQUARE STEEL (IN)			TUBULAR STEEL Ø (IN)					SIGN FRAME REQUIRED	REMARKS	SIGN DETAIL			
								"A"	"B"	RETAIN	SALVAGE FROM	SALVAGE TO	REMOVE	RETAIN	REMOVE		1.75	2.00	2.50	FOUNDATION	3.00	3.50	4.00	5.00			DETAIL IN SHS	DETAIL ON SHEET NUMBER	DETAIL ON STD SHEET NUMBER	
																	(LB / FT)				(LB / FT)									
																	1.88	2.42	3.35		7.60	9.00	10.80	14.60						
ROYALTON VT 110							FY-FLUORESCENT YELLOW FYG-FLUORESCENT YELLOW GREEN															"SHS"-STANDARD HIGHWAY SIGNS								
NB	0.760	C	VR-017	24	30								1		X								DUCKER RD TH-17							
		C	VR-017	24	30			5.00							1		X								E-141					
NB	0.768	D	R1-1	30	30								1		X								DUCKER RD TH-17							
		D	R1-1	30	30			6.25							1		X						X							
NB	1.175	C	VR-017	24	30										1		X								E-141					
NB	1.183	D	R1-1	30	30								1		X								LOVERS LANE RD TH-16							
		D	R1-1	30	30			6.25							1		X						X							
NB	1.360	A	W11-6H	30	30	SNOWMOBILE							1		X															
		A	W11-6H	30	30			6.25							1		X						X		E-153					
NB	1.400	A	W1-2L	30	30	LEFT CURVE							1		X															
NB	1.510	A	W1-2L	30	30			6.25							1		X						INSTALL 500'+/- NORTH OF ORIGINAL SIGN LOCATION	X						
SB	1.950	G	VR-017	24	30								1		X								DODGE RD TH-93							
		G	VR-017	24	30			5.00							1		X								E-141					
SB	1.750	F	W1-2R	30	30	RIGHT CURVE							1		X															
SB	1.680	F	W11-6H	30	30	HINGED SNOWMOBILE							1		X															
SIGN SUMMARY SHEET							SHEET TOTALS	40.00	0.00	0	0	0	8	0	0	7	105								PROJECT NAME: Royalton-Barre Town VT110					
								SF	SF	EA	EA	EA	EA	EA	EA	EA	FT						PROJECT NUMBER: STPG SIGN(23)							
																											FILE NAME: Royalton.xls			
																											PLOT DATE: 6/15/2009			
VERMONT AGENCY OF TRANSPORTATION							TOWN TOTALS	189.8	0.0	4.0	4.0	4.0	36	0.0	0.0	30	450.0								DRAWN BY: T. Guazzoni					
																											CHECKED BY: S. Menard			
																						ROYALTON SHEET 2								
																						SHEET 9 OF 80								

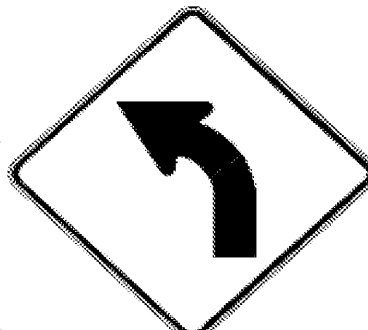
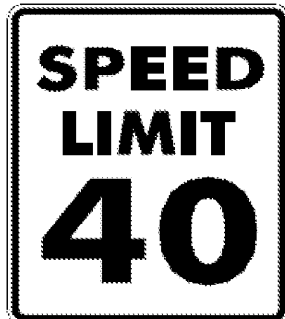
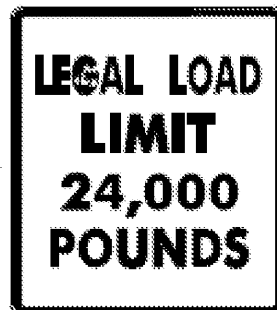
DIRECTION	MILEPOINT	LOCATION CODE (SHEET 2)	SIGN CODE	WIDTH (IN)	HEIGHT (IN)	SHEETING REMARKS	SIGN LEGEND	NEW SIGNS		EXISTING SIGNS				EXIST POST		NUMBER OF NEW POSTS	SQUARE STEEL (IN)			TUBULAR STEEL Ø (IN)				SIGN FRAME REQUIRED	REMARKS	SIGN DETAIL			
								"A"	"B"	RETAIN	SALVAGE FROM	SALVAGE TO	REMOVE	RETAIN	REMOVE		1.75	2.00	2.50	FOUNDATION	3.00	3.50	4.00			5.00	DETAIL IN SHS	DETAIL ON SHEET NUMBER	DETAIL ON STD SHEET NUMBER
																	(LB / FT)				(LB / FT)								
																	1.88	2.42	3.35		7.60	9.00	10.80			14.60			
ROYALTON VT 110							FY-FLUORESCENT YELLOW FYG-FLUORESCENT YELLOW GREEN															"SHS"-STANDARD HIGHWAY SIGNS							
		F	W1-2R	30	30		 	6.25							1		X							X					
SB	1.630	F	W11-6H	30	30			6.25					1			X							INSTALL 250'+/- SOUTH OF ORIGINAL SIGN LOCATION			E-153			
SB	1.540	G	VR-017	24	30								1		X								VEZINA RD TH-92			E-141			
		G	VR-017	24	30			5.00								1		X											
SB	0.640	G	VR-017	24	30								1		X								MILL RD TH-72 (NORTH)						
		G	VR-017	24	30			5.00								1		X								E-141			
SB	0.640	H	R1-1	30	30								1		X								MILL RD TH-72 (NORTH)						
		H	R1-1	30	30			6.25								1		X						X					
SB	0.510	F	VR-072	24	30								1		X								INSTALL BACK TO BACK		6				
		E	VR-072	24	30			5.00								1		X											
		F	VR-072	24	30			5.00															INSTALL BACK TO BACK		6				
SB	0.380	F	R2-5A	24	30								1		X														
		F	W3-5	36	36			9.00								2		X						X					
SB	0.370	G	VR-017	24	30								1		X								MILL RD TH-12 (SOUTH)						
		G	VR-017	24	30			5.00								1		X								E-141			
SIGN SUMMARY SHEET							SHEET TOTALS	52.75	0.00	0	0	0	6	0	0	9	135							PROJECT NAME: Royalton-Barre Town VT110					
								SF	SF	EA	EA	EA	EA	EA	EA	EA		FT						PROJECT NUMBER: STPG SIGN(23)					
																									FILE NAME: Royalton.xls				
VERMONT AGENCY OF TRANSPORTATION							TOWN TOTALS	189.8	0.0	4.0	4.0	4.0	7	0.0	0.0	30	450.0							PLOT DATE: 6/15/2009					
																								PROJECT MANAGER: N. Avery					
																									DRAWN BY: T. Guazzoni				
																							DESIGNED BY: D. Crosslev						
																								CHECKED BY: S. Menard					
																								ROYALTON SHEET 3					
																							SHEET 10 OF 80						

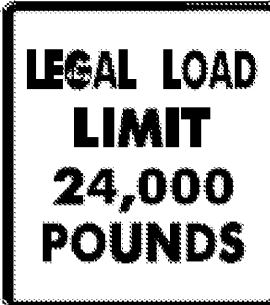
DIRECTION	MILEPOINT	LOCATION CODE (SHEET 2)	SIGN CODE	WIDTH (IN)	HEIGHT (IN)	SHEETING REMARKS	SIGN LEGEND	NEW SIGNS		EXISTING SIGNS				EXIST POST		NUMBER OF NEW POSTS	SQUARE STEEL (IN)			TUBULAR STEEL Ø (IN)				SIGN FRAME REQUIRED	REMARKS	SIGN DETAIL			
								"A"	"B"	RETAIN	SALVAGE FROM	SALVAGE TO	REMOVE	RETAIN	REMOVE		1.75	2.00	2.50	FOUNDATION	3.00	3.50	4.00			5.00	DETAIL IN SHS	DETAIL ON SHEET NUMBER	DETAIL ON STD SHEET NUMBER
																	(LB / FT)				(LB / FT)								
																	1.88	2.42	3.35		7.60	9.00	10.80			14.60			
ROYALTON VT 110							FY-FLUORESCENT YELLOW FYG-FLUORESCENT YELLOW GREEN															"SHS"-STANDARD HIGHWAY SIGNS							
SB	0.370	H	R1-1	30	30								1		X								MILL RD TH-12 (SOUTH)						
		H	R1-1	30	30			6.25								1		X						X					
SB	0.290	F	R2-1	24	30								1		X														
		F	R2-1	30	36			7.50								1		X						X					
SB	0.220	F	VD-062B	72	16		BUSINESS SIGN			1				X															
		F	VD-062B	72	16		BUSINESS SIGN			1				X															
SB	0.150	F	W3-1	30	30								1		X														
		F	W3-1	30	30			6.25								1		X						X					
SB	0.120	F	M2-1S	24	15		JCT				1	1			X	1		X				1A	RE-INSTALL ON NEW POST						
		F	M1-5	30	24		VERMONT 110				1	1																	
		F	M4-6	24	12		END				1	1																	
		F	M1-5	24	24		VERMONT 14				1	1																	
SB	0.060	F	D1-1	54	7.5								1		X														
		F	D1-1A	54	7.5								1																
		F	D1-1A	54	7.5								1																
SIGN SUMMARY SHEET							SHEET TOTALS	20.00	0.00	2	4	4	6	0	0	4	60							PROJECT NAME: Royalton-Barre Town VT110					
								SF	SF	EA	EA	EA	EA	EA	EA	EA		FT					PROJECT NUMBER: STPG SIGN(23)						
							VERMONT AGENCY OF TRANSPORTATION	TOWN TOTALS	189.8	0.0	4.0	4.0	4.0	36	0.0	0.0	30	450.0							FILE NAME: Royalton.xls PROJECT MANAGER: N. Avery DESIGNED BY: D. Crosslev ROYALTON SHEET 4			PLOT DATE: 6/15/2009 DRAWN BY: T. Guazzoni CHECKED BY: S. Menard SHEET 11 OF 80	

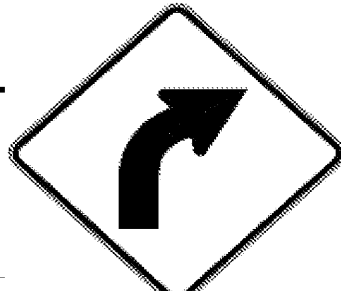
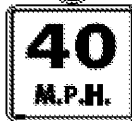
DIRECTION	MILEPOINT	LOCATION CODE (SHEET 2)	SIGN CODE	WIDTH (IN)	HEIGHT (IN)	SHEETING REMARKS	SIGN LEGEND	NEW SIGNS		EXISTING SIGNS				EXIST POST		NUMBER OF NEW POSTS	SQUARE STEEL (IN)			TUBULAR STEEL Ø (IN)				SIGN FRAME REQUIRED	REMARKS	SIGN DETAIL			
								"A"	"B"	RETAIN	SALVAGE FROM	SALVAGE TO	REMOVE	RETAIN	REMOVE		(LB / FT)			FOUNDATION	(LB / FT)					DETAIL IN SHS	DETAIL ON SHEET NUMBER	DETAIL ON STD SHEET NUMBER	
																	1.75	2.00	2.50		3.00	3.50	4.00						5.00
ROYALTON VT 110							FY-FLUORESCENT YELLOW FYG-FLUORESCENT YELLOW GREEN															"SHS"-STANDARD HIGHWAY SIGNS							
			F	D1-1	72	12		6.00								2		X								5			
			F	D1-1A	72	12		6.00																		5			
			F	D1-1A	72	12		6.00																		5			
SB	0.015	J	OM1-1	18	18								1		X														
		K	OM1-1	18	18								1																
		K	R4-7	24	30								1																
		J	OM1-1	18	18		2.25									1		X						X					
		K	OM1-1	18	18		2.25																	X					
		K	R4-7	24	30		5.00																	X					
SB	0.010	J	R1-1	30	30								1		X														
		J	OM1-1	18	18								1																
		K	R4-7	24	30								1																
		K	OM1-1	18	18								1																
		J	R1-1	30	30		6.25									1		X						X					
		J	OM1-1	18	18		2.25																	X					
SIGN SUMMARY SHEET							SHEET TOTALS	36.00	0.00	0	0	0	7	0	0	4	60							PROJECT NAME: Royalton-Barre Town VT110					
								SF	SF	EA	EA	EA	EA	EA	EA	EA		FT					PROJECT NUMBER: STPG SIGN(23)						
VERMONT AGENCY OF TRANSPORTATION							TOWN TOTALS	189.8	0.0	4.0	4.0	4.0	36	0.0	0.0	30	450.0							FILE NAME: Royalton.xls PROJECT MANAGER: N. Avery DESIGNED BY: D. Crosslev ROYALTON SHEET 5					
																							PLOT DATE: 6/15/2009 DRAWN BY: T. Guazzoni CHECKED BY: S. Menard SHEET 12 OF 80						

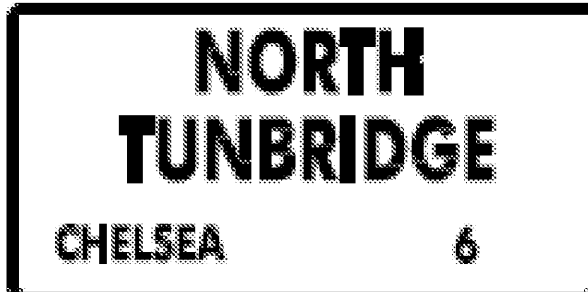
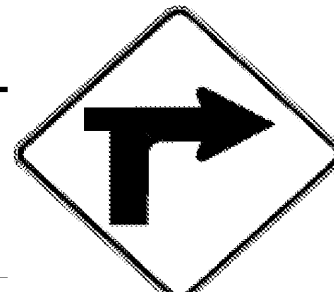
DIRECTION	MILEPOINT	LOCATION CODE (SHEET 2)	SIGN CODE	WIDTH (IN)	HEIGHT (IN)	SHEETING REMARKS	SIGN LEGEND	NEW SIGNS		EXISTING SIGNS				EXIST POST		NUMBER OF NEW POSTS	SQUARE STEEL (IN)			TUBULAR STEEL Ø (IN)				SIGN FRAME REQUIRED	REMARKS	SIGN DETAIL				
								"A"	"B"	RETAIN	SALVAGE FROM	SALVAGE TO	REMOVE	RETAIN	REMOVE		1.75	2.00	2.50	FOUNDATION	3.00	3.50	4.00			5.00	DETAIL IN SHS	DETAIL ON SHEET NUMBER	DETAIL ON STD SHEET NUMBER	
																	(LB / FT)				(LB / FT)									
																	1.88	2.42	3.35		7.60	9.00	10.80			14.60				
TUNBRIDGE VT 110							FY-FLUORESCENT YELLOW FYG-FLUORESCENT YELLOW GREEN															"SHS"-STANDARD HIGHWAY SIGNS								
NB	0.000	C	VD-024	60	7.5								1		X															
		C	VD-025	60	7.5								1																	
		C	VD-024	72	10		TUNBRIDGE ROYALTON	5.00					1			2		X									4			
		C	VD-025	72	10		ORANGE CO WINDSOR CO	5.00																			4			
		C	VD-700	6	10		1100 0913 0000 1100 1416 0232	0.42																						
		C	VD-700	6	10			0.42																						
NB	0.081	C	VR-017	24	24		LEGAL LOAD LIMIT 24,000 POUNDS						1		X										BUTTON HILL RD TH-14					
		C	VR-017	24	30			5.00								1		X									E-141			
NB	0.089	D	R1-1	30	30		STOP						1		X										BUTTON HILL RD TH-14					
		D	R1-1	30	30			6.25								1		X							X					
NB	0.490	A	W1-4L	30	30		LEFT REVERSE CURVE						1		X															
		A	W13-1	24	24		35 MPH PLAQUE						1																	
NB	0.575	A	W1-2 L	30	30		35 M.P.H.	6.25								1		X									INSTALL 400' +/- NORTH OF ORIGINAL W1-4 SIGN LOCATION. 100' SOUTH OF GUARDRAIL BEG.	X		
		A	W13-1	24	24			4.00																		X				
NB	0.763	A	W1-4L	30	30		LEFT REVERSE CURVE								X										INSTALL SALVAGED SIGNS ON NEW POST					
SIGN SUMMARY SHEET							SHEET TOTALS	32.34	0.00	0	+	+	6	0	0	5	75							PROJECT NAME: Royalton-Barre Town VT110						
								SF	SF	EA	EA	EA	EA	EA	EA	EA		FT					PROJECT NUMBER: STPG SIGN(23)							
							TOWN TOTALS	743.6	0.0	47.0	7.0	7.0	122	0.0	0.0	133	1995.0							FILE NAME: Tunbridge.xls PROJECT MANAGER: N. Avery DESIGNED BY: D. Crosslev TUNBRIDGE SHEET 1			PLOT DATE: 6/16/2009 DRAWN BY: T. Guazzoni CHECKED BY: S. Menard SHEET 14 OF 80			

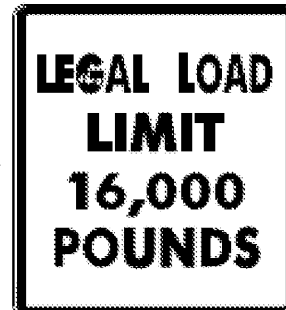
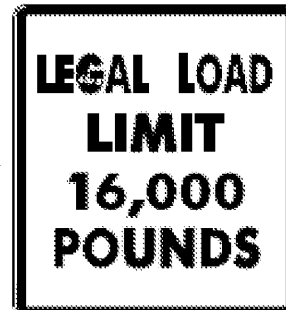
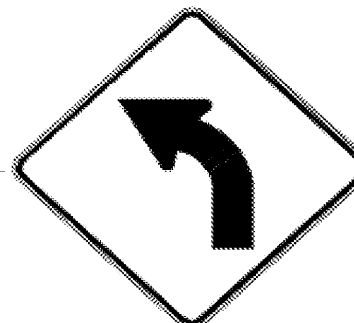
DIRECTION	MILEPOINT	LOCATION CODE (SHEET 2)	SIGN CODE	WIDTH (IN)	HEIGHT (IN)	SHEETING REMARKS	SIGN LEGEND	NEW SIGNS		EXISTING SIGNS				EXIST POST		NUMBER OF NEW POSTS	SQUARE STEEL (IN)			TUBULAR STEEL Ø (IN)				SIGN FRAME REQUIRED	REMARKS	SIGN DETAIL			
								"A"	"B"	RETAIN	SALVAGE FROM	SALVAGE TO	REMOVE	RETAIN	REMOVE		1.75	2.00	2.50	FOUNDATION	3.00	3.50	4.00			5.00	DETAIL IN SHS	DETAIL ON SHEET NUMBER	DETAIL ON STD SHEET NUMBER
																	(LB / FT)				(LB / FT)								
																	1.88	2.42	3.35		7.60	9.00	10.80			14.60			
TUNBRIDGE VT 110							FY-FLUORESCENT YELLOW FYG-FLUORESCENT YELLOW GREEN															"SHS"-STANDARD HIGHWAY SIGNS							
		A	W13-1	24	24		35 MPH PLAQUE				+	+			+		X												
NB	0.988	C	W12-2	36	36		10'-0"			1				X															
		C	VR-017	24	30								1		X									BELKNAP BROOK RD TH-60			E-141		
		C	VR-017	24	30			5.00							1		X												
NB	0.996	D	R1-1	30	30								1		X									BELKNAP BROOK RD TH-60					
		D	R1-1	30	30			6.25								1		X							X				
NB	1.083	A	W1-2L	30	30		LEFT CURVE			1				X															
NB	1.837	C	VR-017	24	24								1		X										TOWN FARM RD TH-?				
		C	VR-017	24	30			5.00								1		X									E-141		
NB	1.845	D	R1-1	30	30								1		X										TOWN FARM RD TH-?				
		D	R1-1	30	30			6.25								1		X							X				
NB	1.960	A	W1-10R	30	30		MODIFIED RIGHT CURVE			1				X															
		A	W13-1	24	24		40 MPH PLAQUE			1																			
NB	2.319	A	W3-5	36	36		SPEED REDUCTION 40			1				X															
NB	2.380	A	VD-018	30	18								1		X														
SIGN SUMMARY SHEET							SHEET TOTALS	22.50	0.00	5	+	+	5	0	0	5	75							PROJECT NAME: Royalton-Barre Town VT110					
								SF	SF	EA	EA	EA	EA	EA	EA	EA		FT							PROJECT NUMBER: STPG SIGN(23)				
							VERMONT AGENCY OF TRANSPORTATION				0	0														FILE NAME: Tunbridæ.xls			
							TOWN TOTALS	743.6	0.0	47.0	7.0	7.0	122	0.0	0.0	133	1995.0							PROJECT MANAGER: N. Avery			PLOT DATE: 6/16/2009		
																							DESIGNED BY: D. Crossley			DRAWN BY: T. Guazzoni			
																							TUNBRIDGE SHEET 2			CHECKED BY: S. Menard			
																										SHEET 15 OF 80			

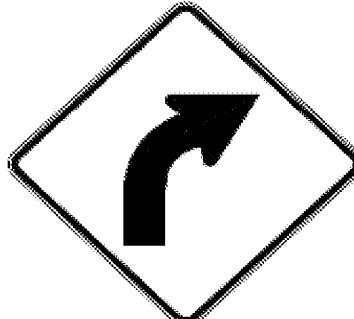
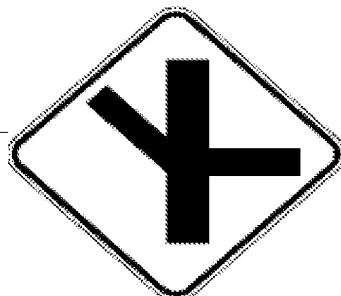
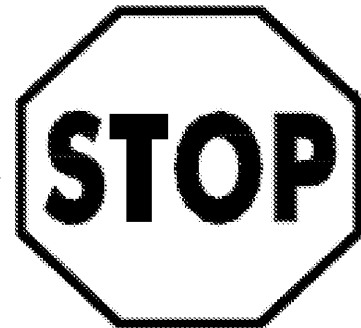
DIRECTION	MILEPOINT	LOCATION CODE (SHEET 2)	SIGN CODE	WIDTH (IN)	HEIGHT (IN)	SHEETING REMARKS	SIGN LEGEND	NEW SIGNS		EXISTING SIGNS				EXIST POST		NUMBER OF NEW POSTS	SQUARE STEEL (IN)			TUBULAR STEEL Ø (IN)				SIGN FRAME REQUIRED	REMARKS	SIGN DETAIL			
								"A"	"B"	RETAIN	SALVAGE FROM	SALVAGE TO	REMOVE	RETAIN	REMOVE		1.75	2.00	2.50	FOUNDATION	3.00	3.50	4.00			5.00	DETAIL IN SHS	DETAIL ON SHEET NUMBER	DETAIL ON STD SHEET NUMBER
																	(LB / FT)				(LB / FT)								
																	1.88	2.42	3.35		7.60	9.00	10.80			14.60			
TUNBRIDGE VT 110							FY-FLUORESCENT YELLOW FYG-FLUORESCENT YELLOW GREEN															"SHS"-STANDARD HIGHWAY SIGNS							
			A	VD-018	30	18		3.75								1		X								E-128B			
NB	2.420		A	W1-2L	30	30							1		X														
			A	W13-1	24	24							1																
			A	W1-2L	30	30		6.25								1		X						X					
			A	W13-1	24	24		4.00																X					
NB	2.450		A	R2-1	24	30							1		X														
			A	R2-1	30	36		7.50								1		X								6			
NB	2.510		A	VD-062AL	72	16	BUSINESS SIGN			1				X															
NB	2.670		A	R2-1	24	30							1		X														
			A	R2-1	30	36		7.50								1		X								6			
NB	2.703		A	W11-2YG	30	30	PEDESTRIAN			1				X															
			A	W7-3A	24	18	NEXT 1/4 MILE			1																			
NB	2.744		C	VR-017	24	30							1		X									POTASH HILL RD TH-14					
			C	VR-017	24	30		5.00								1		X								E-141			
NB	2.752		D	R1-1	30	30							1		X									POTASH HILL RD TH-14					
SIGN SUMMARY SHEET							SHEET TOTALS	34.00	0.00	3	0	0	6	0	0	5	75							PROJECT NAME: Royalton-Barre Town VT110					
								SF	SF	EA	EA	EA	EA	EA	EA	EA		FT					PROJECT NUMBER: STPG SIGN(23)						
																										FILE NAME: Tunbridge.xls			
																											PLOT DATE: 6/16/2009		
VERMONT AGENCY OF TRANSPORTATION																							DRAWN BY: T. Guazzoni						
																										CHECKED BY: S. Menard			
																										TUNBRIDGE SHEET 3			
TOWN TOTALS							743.6	0.0	47.0	7.0	7.0	122	0.0	0.0	133	1995.0							SHEET 16 OF 80						

DIRECTION	MILEPOINT	LOCATION CODE (SHEET 2)	SIGN CODE	WIDTH (IN)	HEIGHT (IN)	SHEETING REMARKS	SIGN LEGEND	NEW SIGNS		EXISTING SIGNS				EXIST POST		NUMBER OF NEW POSTS	SQUARE STEEL (IN)			TUBULAR STEEL Ø (IN)					SIGN FRAME REQUIRED	REMARKS	SIGN DETAIL			
								"A"	"B"	RETAIN	SALVAGE FROM	SALVAGE TO	REMOVE	RETAIN	REMOVE		1.75	2.00	2.50	FOUNDATION	3.00	3.50	4.00	5.00			DETAIL IN SHS	DETAIL ON SHEET NUMBER	DETAIL ON STD SHEET NUMBER	
																	(LB / FT)				(LB / FT)									
																	1.88	2.42	3.35		7.60	9.00	10.80	14.60						
TUNBRIDGE VT 110							FY-FLUORESCENT YELLOW FYG-FLUORESCENT YELLOW GREEN															"SHS"-STANDARD HIGHWAY SIGNS								
			D R1-1	30	30			6.25							1		X							X						
NB	2.764	A	R2-1	24	30		SPEED LIMIT 35			1				X																
NB	2.876	A	W1-4R	30	30		RIGHT REVERSE CURVE				1				X															
NB	2.950	A	VW-054R	30	30		HIDDEN DRIVE RIGHT						1		X															
		A	VW-730	24	18		500' AT STONE WALL						1																	
NB	2.960	A	W1-4R	30	30		RIGHT REVERSE CURVE					1				1		X						INSTALL 50' NORTH OF EXISTING HIDDEN DRIVE RIGHT SIGN . AT STONE POST.						
NB	3.020	A	S3-1	30	30		SCHOOL BUS STOP AHEAD				1	1			X	2		X												
		A	VW-054R	30	30			6.25																INSTALL BELOW SCHOOL BUS STOP AHEAD SIGN			E-154			
NB	3.140	C	VR-017	24	24								1		X									STRAFORD RD TH-1						
		C	VR-017	24	30			5.00								1		X								E-141				
NB	3.140	D	R1-1	30	30		STOP			1				X										STRAFORD RD TH-1						
NB	3.180	A	M3-1	24	12		NORTH				1				X															
		A	M1-5A	24	24		ROUTE 110				1																			
NB	3.195	A	VW-133	30	30		HIDDEN DRIVE LEFT			1				X																
NB	3.210	A	R2-1	24	30		SPEED LIMIT 35				1				X															
SIGN SUMMARY SHEET							SHEET TOTALS	17.50	0.00	6	2	2	3	0	0	5	75								PROJECT NAME: Royalton-Barre Town VT110					
								SF	SF	EA	EA	EA	EA	EA	EA	EA		FT						PROJECT NUMBER: STPG SIGN(23)						
																												FILE NAME: Tunbridge.xls		
																												PLOT DATE: 6/16/2009		
VERMONT AGENCY OF TRANSPORTATION																								DRAWN BY: T. Guazzoni						
																											CHECKED BY: S. Menard			
							TOWN TOTALS	743.6	0.0	47.0	7.0	7.0	122	0.0	0.0	133	1995.0								DESIGNED BY: D. Crosslev					
																								TUNBRIDGE SHEET 4						
																							SHEET 17 OF 80							

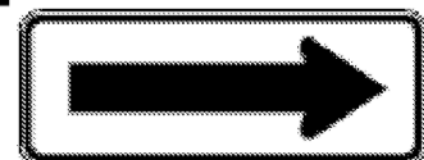
DIRECTION	MILEPOINT	LOCATION CODE (SHEET 2)	SIGN CODE	WIDTH (IN)	HEIGHT (IN)	SHEETING REMARKS	SIGN LEGEND	NEW SIGNS		EXISTING SIGNS				EXIST POST		NUMBER OF NEW POSTS	SQUARE STEEL (IN)			TUBULAR STEEL Ø (IN)				SIGN FRAME REQUIRED	REMARKS	SIGN DETAIL			
								"A"	"B"	RETAIN	SALVAGE FROM	SALVAGE TO	REMOVE	RETAIN	REMOVE		1.75	2.00	2.50	FOUNDATION	3.00	3.50	4.00			5.00	DETAIL IN SHS	DETAIL ON SHEET NUMBER	DETAIL ON STD SHEET NUMBER
																	(LB / FT)				(LB / FT)								
																	1.88	2.42	3.35		7.60	9.00	10.80			14.60			
TUNBRIDGE VT 110							FY-FLUORESCENT YELLOW FYG-FLUORESCENT YELLOW GREEN															"SHS"-STANDARD HIGHWAY SIGNS							
NB	3.230	A	W11-1	30	30		BICYCLE SYMBOL			1				X															
		A	W16-1	18	24		SHARE THE ROAD			1																			
NB	3.240	A	W1-6	48	24		LEFT LARGE ARROW			1				X															
NB	3.241	B	W1-6	48	24			8.00								2		X							X				
NB	3.337	A	R2-1	24	30								1		X														
		A	R2-1	24	30			5.00								1		X							X				
NB	3.350	B	W1-4R	30	30		RIGHT REVERSE CURVE						1		X														
		B	W13-1	18	18		35 MPH PLAQUE						1																
NB	3.630	A	R2-1	24	30								1		X														
		A	R2-1	24	30			5.00								1		X							X				
NB	3.960	A	W1-2 R	30	30		CURVE RIGHT						1		X														
		A	W13-1	18	18		40 MPH PLAQUE						1																
NB	4.000	A	W1-2 R	30	30			6.25								1		X						INSTALL 200'+/- NORTH OF ORIGINAL SIGN LOCATION	X				
		A	W13-1	24	24			4.00																	X				
NB	4.370	A	R2-5A	24	30								1		X														
SIGN SUMMARY SHEET							SHEET TOTALS		28.25	0.00	3	0	0	7	0	0	5	75						PROJECT NAME: Royalton-Barre Town VT110					
									SF	SF	EA	EA	EA	EA	EA	EA	EA		FT					PROJECT NUMBER: STPG SIGN(23)					
																										FILE NAME: Tunbridge.xls			
																										PLOT DATE: 6/16/2009			
VERMONT AGENCY OF TRANSPORTATION																							DRAWN BY: T. Guazzoni						
																									CHECKED BY: S. Menard				
																									TUNBRIDGE SHEET 5				
TOWN TOTALS							743.6	0.0	47.0	7.0	7.0	122	0.0	0.0	133	1995.0						SHEET 18 OF 80							

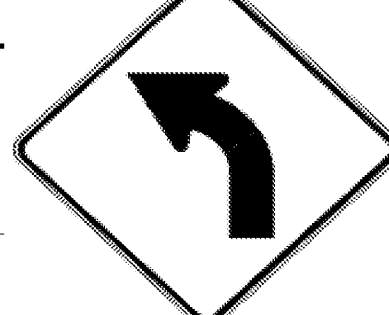
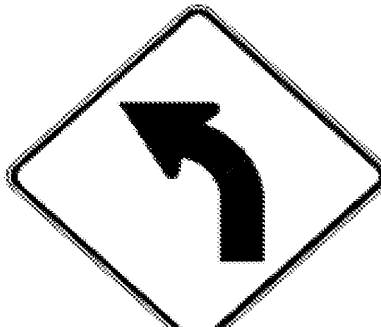
DIRECTION	MILEPOINT	LOCATION CODE (SHEET 2)	SIGN CODE	WIDTH (IN)	HEIGHT (IN)	SHEETING REMARKS	SIGN LEGEND	NEW SIGNS		EXISTING SIGNS				EXIST POST		NUMBER OF NEW POSTS	SQUARE STEEL (IN)			TUBULAR STEEL Ø (IN)					SIGN FRAME REQUIRED	REMARKS	SIGN DETAIL		
								"A"	"B"	RETAIN	SALVAGE FROM	SALVAGE TO	REMOVE	RETAIN	REMOVE		1.75	2.00	2.50	FOUNDATION	3.00	3.50	4.00	5.00			DETAIL IN SHS	DETAIL ON SHEET NUMBER	DETAIL ON STD SHEET NUMBER
																	(LB / FT)				(LB / FT)								
																	1.88	2.42	3.35		7.60	9.00	10.80	14.60					
TUNBRIDGE VT 110							FY-FLUORESCENT YELLOW FYG-FLUORESCENT YELLOW GREEN															"SHS"-STANDARD HIGHWAY SIGNS							
			A	W3-5	36	36		9.00								2		X							X				
NB	4.450		A	VD-018	30	18																							
			A	VD-018	30	18		3.75								1		X									E-128B		
NB	4.480		A	W1-1Ma R	30	30	RIGHT TURN W/ MINOR SIDE ROAD																						
				W13-1	18	18	30 MPH PLAQUE																						
NB	4.500		A	W1-1Ma R	30	30		6.25																INSTALL 100' +/- NORTH OF ORIGINAL LOCATION			6		
				W13-1	24	24		4.00								1		X											
NB	4.530		A	R2-1	24	30																							
			A	R2-1	30	36		7.50								1		X							X				
NB	4.540		A	W5-2	30	30		6.25																INSTALL 100'+/- NORTH OF SPEED LIMIT 35 SIGN. AT BEGINNING OF GUARDRAIL	X				
NB	4.568		A	OM-3 R	18	36																							
				OM-3 R	12	36		3.00								1		X							X				
NB	4.572		B	OM -3 L	18	36																							
				OM-3 L	12	36		3.00								1		X							X				
NB	4.800		A	R2-1	24	30		5.00										X						INSTALL AT M M 4.80	X				
SIGN SUMMARY SHEET							SHEET TOTALS	47.75	0.00	0	0	0	6	0	0	9	135								PROJECT NAME: Royalton-Barre Town VT110				
								SF	SF	EA	EA	EA	EA	EA	EA	EA		FT						PROJECT NUMBER: STPG SIGN(23)					
																											FILE NAME: Tunbridge.xls		
																												PLOT DATE: 6/16/2009	
VERMONT AGENCY OF TRANSPORTATION																								DRAWN BY: T. Guazzoni					
																											PROJECT MANAGER: N. Avery		
																											DESIGNED BY: D. Crosslev		
TOWN TOTALS							743.6	0.0	47.0	7.0	7.0	122	0.0	0.0	133	1995.0								CHECKED BY: S. Menard					
																							TUNBRIDGE SHEET 6						
																							SHEET 19 OF 80						

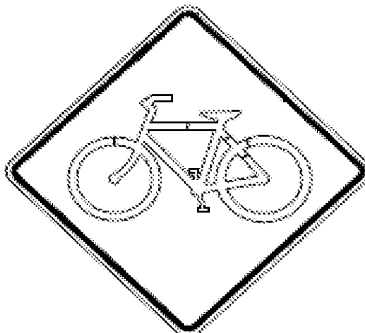
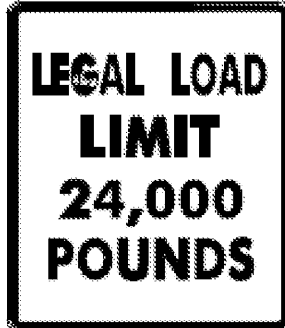
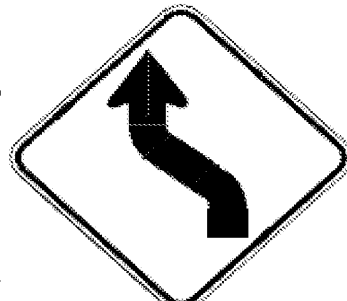
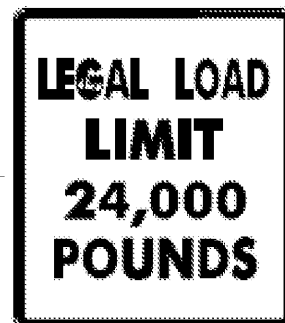
DIRECTION	MILEPOINT	LOCATION CODE (SHEET 2)	SIGN CODE	WIDTH (IN)	HEIGHT (IN)	SHEETING REMARKS	SIGN LEGEND	NEW SIGNS		EXISTING SIGNS				EXIST POST		NUMBER OF NEW POSTS	SQUARE STEEL (IN)			TUBULAR STEEL Ø (IN)					SIGN FRAME REQUIRED	REMARKS	SIGN DETAIL				
								"A"	"B"	RETAIN	SALVAGE FROM	SALVAGE TO	REMOVE	RETAIN	REMOVE		1.75	2.00	2.50	FOUNDATION	3.00	3.50	4.00	5.00			DETAIL IN SHS	DETAIL ON SHEET NUMBER	DETAIL ON STD SHEET NUMBER		
																	(LB / FT)				(LB / FT)										
																	1.88	2.42	3.35		7.60	9.00	10.80	14.60							
TUNBRIDGE VT 110							FY-FLUORESCENT YELLOW FYG-FLUORESCENT YELLOW GREEN															"SHS"-STANDARD HIGHWAY SIGNS									
NB	4.960	C	VR-017	24	24								1		X									FOUNDRY RD TH-25							
		C	VR-017	24	30			5.00							1		X									E-141					
NB	4.960	D	R1-1	24	24								1		X									FOUNDRY RD TH-25							
		D	R1-1	30	30			6.25							1		X								X						
NB	5.050	A	R2-1	24	30								1		X																
		A	R2-1	24	30			5.00							1		X								X						
NB	5.070	C	VR-017	24	30								1		X										CARON RD TH-79			E-141			
		C	VR-017	24	30			5.00							1		X														
NB	5.080	D	R1-1	30	30								1		X										CARON RD TH-79						
		D	R1-1	30	30			6.25							1		X								X						
NB	5.087	A	S1-1YG	30	30		SCHOOL			1				X																	
		A	W16-9YG	24	12		AHEAD			1																					
NB	5.130	A	W1-2L	30	30								1		X																
		A	W1-2L	30	30			6.25							1		X								INSTALL 260'+/- NORTH OF ORIGINAL SIGN LOCATION	X					
NB	5.370	A	R2-1	24	30								1		X																
SIGN SUMMARY SHEET							SHEET TOTALS		33.75	0.00	2	0	0	7	0	0	6	90								PROJECT NAME: Royalton-Barre Town VT110					
									SF	SF	EA	EA	EA	EA	EA	EA	EA		FT						PROJECT NUMBER: STPG SIGN(23)						
																													FILE NAME: Tunbridge.xls		
							VERMONT AGENCY OF TRANSPORTATION																						PLOT DATE: 6/16/2009		
							TOWN TOTALS		743.6	0.0	47.0	7.0	7.0	122	0.0	0.0	133	1995.0								DRAWN BY: T. Guazzoni					
																								CHECKED BY: S. Menard							
																								SHEET 20 OF 80							
																								TUNBRIDGE SHEET 7							

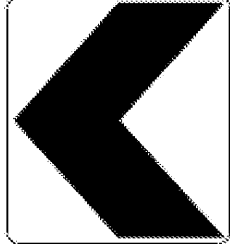
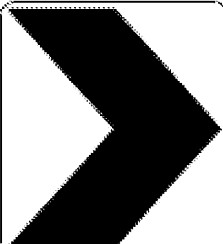
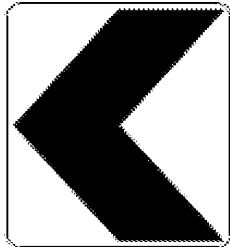
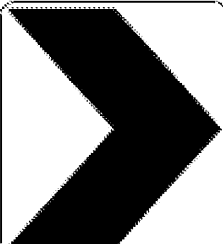
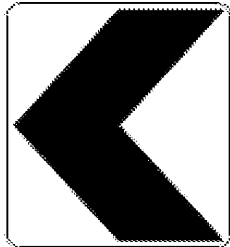
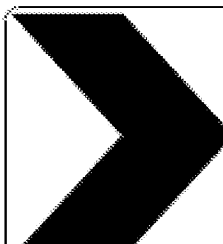
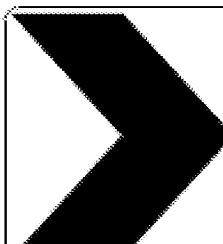
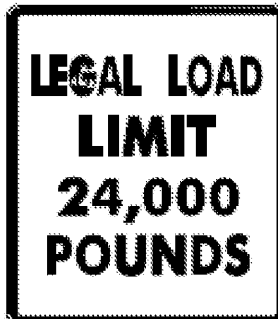
DIRECTION	MILEPOINT	LOCATION CODE (SHEET 2)	SIGN CODE	WIDTH (IN)	HEIGHT (IN)	SHEETING REMARKS	SIGN LEGEND	NEW SIGNS		EXISTING SIGNS				EXIST POST		NUMBER OF NEW POSTS	SQUARE STEEL (IN)			TUBULAR STEEL Ø (IN)				SIGN FRAME REQUIRED	REMARKS	SIGN DETAIL			
								"A"	"B"	RETAIN	SALVAGE FROM	SALVAGE TO	REMOVE	RETAIN	REMOVE		1.75	2.00	2.50	FOUNDATION	3.00	3.50	4.00			5.00	DETAIL IN SHS	DETAIL ON SHEET NUMBER	DETAIL ON STD SHEET NUMBER
																	(LB / FT)				(LB / FT)								
																	1.88	2.42	3.35		7.60	9.00	10.80			14.60			
TUNBRIDGE VT 110							FY-FLUORESCENT YELLOW FYG-FLUORESCENT YELLOW GREEN															"SHS"-STANDARD HIGHWAY SIGNS							
			A R2-1	24	30			5.00								1		X											
NB	5.440		A W1-2 R	30	30		CURVE RIGHT						1		X														
			A W13-1	18	18		35 MPH PLAQUE						1																
NB	5.480		A W1-2 R	30	30			6.25															INSTALL 200'+/- NORTH OF ORIGINAL SIGN LOCATION	X					
			A W13-1	24	24			4.00								1		X						X					
NB	5.570		A R2-1	24	30								1		X														
			A R2-1	24	30			5.00								1		X						X					
NB	5.700		A W2-1Mj L	30	30								1		X														
			A W2-1Mj L	30	30			6.25								1		X							6				
NB	5.836		C VR-017	24	30								1		X									LARKIN RD TH-13					
			C VR-017	24	30			5.00								1		X								E-141			
NB	5.844		D R1-1	30	30								1		X									LARKIN RD TH-13					
			D R1-1	30	30			6.25								1		X						X					
NB	5.850		A W5-1	30	30		NARROW ROAD						1		X														
NB	5.870		A W1-4L	30	30		LEFT REVERSE CURVE						1		X														
SIGN SUMMARY SHEET							SHEET TOTALS	37.75	0.00	0	0	0	8	0	0	6	90							PROJECT NAME: Royalton-Barre Town VT110					
								SF	SF	EA	EA	EA	EA	EA	EA	EA		FT					PROJECT NUMBER: STPG SIGN(23)						
																											FILE NAME: Tunbridge.xls		
																											PLOT DATE: 6/16/2009		
VERMONT AGENCY OF TRANSPORTATION							TOWN TOTALS	743.6	0.0	47.0	7.0	7.0	122	0.0	0.0	133	1995.0							DRAWN BY: T. Guazzoni					
																										DESIGNED BY: D. Crosslev			
																										CHECKED BY: S. Menard			
																							SHEET 21 OF 80						

DIRECTION	MILEPOINT	LOCATION CODE (SHEET 2)	SIGN CODE	WIDTH (IN)	HEIGHT (IN)	SHEETING REMARKS	SIGN LEGEND	NEW SIGNS		EXISTING SIGNS				EXIST POST		NUMBER OF NEW POSTS	SQUARE STEEL (IN)			TUBULAR STEEL Ø (IN)				SIGN FRAME REQUIRED	REMARKS	SIGN DETAIL			
								"A"	"B"	RETAIN	SALVAGE FROM	SALVAGE TO	REMOVE	RETAIN	REMOVE		1.75	2.00	2.50	FOUNDATION	3.00	3.50	4.00			5.00	DETAIL IN SHS	DETAIL ON SHEET NUMBER	DETAIL ON STD SHEET NUMBER
																	(LB / FT)				(LB / FT)								
																	1.88	2.42	3.35		7.60	9.00	10.80			14.60			
TUNBRIDGE VT 110							FY-FLUORESCENT YELLOW FYG-FLUORESCENT YELLOW GREEN															"SHS"-STANDARD HIGHWAY SIGNS							
NB	7.130	A	W11-6	30	30		SNOWMOBILE SYMBOL 					1		X															
		A	W11-1	30	30			6.25							1		X								X				
NB	7.200	A	W11-1	30	30		BIKE SYMBOL 					1		X															
		A	W11-6 H	30	30		 REMOVE PER REQUEST	6.25				1		X												E-153			
NB	7.240	A	W5-1	30	30		ROAD NARROWS					1		X															
NB	7.370	A	VW-054R	30	30		HIDDEN DRIVE RIGHT 					1		X															
NB	7.400	A	VW-054R	30	30			6.25							1		X						INSTALL 150'+/- NORTH OF ORIGINAL SIGN LOCATION			E-154			
NB	7.520	A	W1-2L	30	30							1		X															
NB	7.570	A	W1-2L	30	30			6.25							1		X						INSTALL 250'+/- NORTH OF ORIGINAL SIGN LOCATION	X					
NB	7.770	A	W1-4L	30	30							1		X															
		A	W13-1	18	18							1																	
NB	7.740	A	VD-217	54	8		JUSTIN MORGAN HORSE BURIAL SITE 			1			X										INSTALL TO THE LEFT OF THE EXISTING HORSE SIGN	X					
		A	W1-4L	30	30			6.25							1		X												
		A	W13-1	24	24			4.00																X					
NB	7.830	C	VR-017	24	24							1		X									BICKNELL HILL RD TH-6						
SIGN SUMMARY SHEET							SHEET TOTALS		35.25	0.00	1	0	0	8 ⁹	0	0	5	75							PROJECT NAME: Royalton-Barre Town VT110				
									SF	SF	EA	EA	EA	EA	EA	EA	EA	FT							PROJECT NUMBER: STPG SIGN(23)				
							TOWN TOTALS		743.6	0.0	47.0	7.0	7.0	122	0.0	0.0	133	1995.0							FILE NAME: Tunbridge.xls PROJECT MANAGER: N. Avery DESIGNED BY: D. Crosslev TUNBRIDGE SHEET 10			PLOT DATE: 6/16/2009 DRAWN BY: T. Guazzoni CHECKED BY: S. Menard SHEET 23 OF 80	

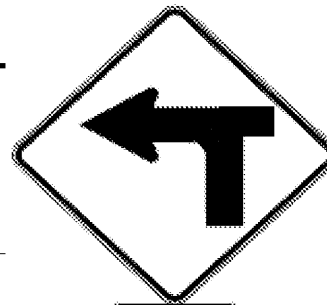
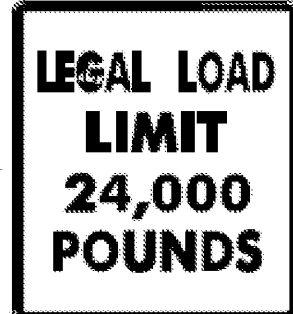
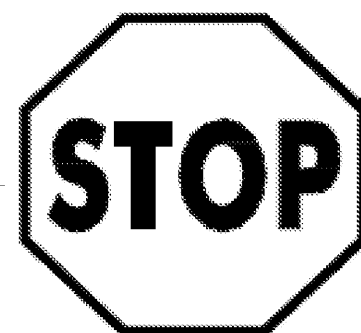
DIRECTION	MILEPOINT	LOCATION CODE (SHEET 2)	SIGN CODE	WIDTH (IN)	HEIGHT (IN)	SHEETING REMARKS	SIGN LEGEND	NEW SIGNS		EXISTING SIGNS				EXIST POST		NUMBER OF NEW POSTS	SQUARE STEEL (IN)			TUBULAR STEEL Ø (IN)				SIGN FRAME REQUIRED	REMARKS	SIGN DETAIL			
								"A"	"B"	RETAIN	SALVAGE FROM	SALVAGE TO	REMOVE	RETAIN	REMOVE		1.75	2.00	2.50	FOUNDATION	3.00	3.50	4.00			5.00	DETAIL IN SHS	DETAIL ON SHEET NUMBER	DETAIL ON STD SHEET NUMBER
																	(LB / FT)				(LB / FT)								
																	1.88	2.42	3.35		7.60	9.00	10.80			14.60			
TUNBRIDGE VT 110							FY-FLUORESCENT YELLOW FYG-FLUORESCENT YELLOW GREEN															"SHS"-STANDARD HIGHWAY SIGNS							
		C	VR-017	24	30			5.00							1		X									E-141			
NB	7.838	D	R1-1	30	30								1		X									BICKNELL HILL RD TH-6					
		D	R1-1	30	30			6.25							1		X							X					
NB	7.850	A	W1-6	48	24								1		X														
		A	W1-6	48	24			8.00							2		X							X					
NB	7.851	B	W1-6	48	24								1		X														
		B	W1-6	48	24			8.00							2		X							X					
SB	7.920	E	W1-6	48	24			8.00					1			2		X						INSTALL 50' SOUTH OF LEFT ARROW THAT IS IN "F" POSITION FOR NB TRAFFIC	X				
SB	7.810	F	VD-217	54	8		JUSTIN MORGAN HORSE BURIAL SITE			1				X															
SB	7.700	F	W5-1	30	30		NARROW ROAD						1		X														
SB	7.750	F	W1-2R	30	30		RIGHT CURVE						1		X									X					
SB	7.680	F	VW-054L	30	30		HIDDEN DRIVE LEFT						1		X														
		F	W1-2R	30	30			6.25							1		X							X					
SB	7.650	F	VW-054L	30	30			6.25							1		X							INSTALL 150' SOUTH OF ORIGINAL SIGN LOCATION			E-154		
SB	7.080	F	W1-2L	30	30		LEFT CURVE						1		X														
SIGN SUMMARY SHEET							SHEET TOTALS	47.75	0.00	1	0	0	7	0	0	10	150							PROJECT NAME: Royalton-Barre Town VT110					
								SF	SF	EA	EA	EA	EA	EA	EA	EA		FT					PROJECT NUMBER: STPG SIGN(23)						
													8												FILE NAME: Tunbridae.xls				
VERMONT AGENCY OF TRANSPORTATION							TOWN TOTALS	743.6	0.0	47.0	7.0	7.0	122	0.0	0.0	133	1995.0							PLOT DATE: 6/16/2009					
																								DRAWN BY: T. Guazzoni					
																							DESIGNED BY: D. Crosslev						
																							CHECKED BY: S. Menard						
																							TUNBRIDGE SHEET 11						
																							SHEET 24 OF 80						

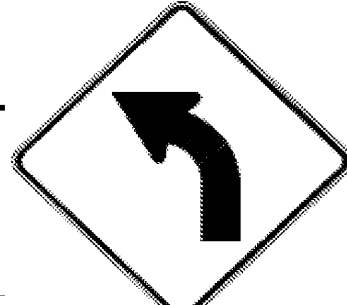
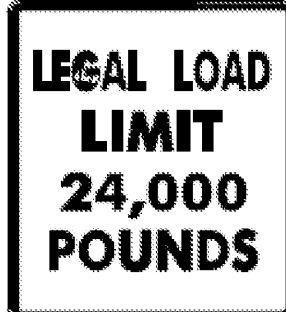
DIRECTION	MILEPOINT	LOCATION CODE (SHEET 2)	SIGN CODE	WIDTH (IN)	HEIGHT (IN)	SHEETING REMARKS	SIGN LEGEND	NEW SIGNS		EXISTING SIGNS				EXIST POST		NUMBER OF NEW POSTS	SQUARE STEEL (IN)			TUBULAR STEEL Ø (IN)				SIGN FRAME REQUIRED	REMARKS	SIGN DETAIL			
								"A"	"B"	RETAIN	SALVAGE FROM	SALVAGE TO	REMOVE	RETAIN	REMOVE		1.75	2.00	2.50	FOUNDATION	3.00	3.50	4.00			5.00	DETAIL IN SHS	DETAIL ON SHEET NUMBER	DETAIL ON STD SHEET NUMBER
																	(LB / FT)				(LB / FT)								
																	1.88	2.42	3.35		7.60	9.00	10.80			14.60			
TUNBRIDGE VT 110							FY-FLUORESCENT YELLOW FYG-FLUORESCENT YELLOW GREEN														"SHS"-STANDARD HIGHWAY SIGNS								
		F	W13-1	18	18		40 MPH PLAQUE						1																
SB	7.050	F	W1-2L	30	30			6.25							1		X						INSTALL 150' SOUTH OF ORIGINAL SIGN LOCATION	X					
		F	W13-1	24	24			4.00															X						
SB	7.000	F	W5-1	30	30			6.25							1		X						INSTALL AT MM 0700	X					
SB	6.975	F	OM-3 R	18	36			4.50							1		X						INSTALL AT BEGINNING OF WALL	X					
SB	6.950	F	OM-3 L	18	36			4.50							1		X						INSTALL AT END OF WALL	X					
SB	6.932	G	VR-017	24	30							1		X									HANSON RD TH-11						
		G	VR-017	24	30			5.00							1		X								E-141				
SB	6.926	H	R1-1	30	30							1		X									HANSON RD TH-11 ISLAND						
		H	R1-1	30	30			6.25							1		X						X						
SB	6.920	H	R1-1	30	30							1		X									HANSON RD TH-11						
		H	R1-1	30	30			6.25							1		X						X						
SB	6.890	F	W1-2L	30	30		LEFT CURVE						1		X														
		F	W13-1	18	18								1																
SB	6.850	F	W1-2L	30	30			6.25							1		X						INSTALL 200'+/- SOUTH OF ORIGINAL SIGN LOCATION	X					
SIGN SUMMARY SHEET							SHEET TOTALS	49.25	0.00	0	0	0	6	0	0	8	120						PROJECT NAME: Royalton-Barre Town VT110						
								SF	SF	EA	EA	EA	EA	EA	EA	EA	FT							PROJECT NUMBER: STPG SIGN(23)					
							VERMONT AGENCY OF TRANSPORTATION																		FILE NAME: Tunbridæ.xls	PLOT DATE: 6/16/2009			
							TOWN TOTALS							743.6	0.0	47.0	7.0	7.0	122	0.0	0.0	133	1995.0				DESIGNED BY: D. Crossley	DRAWN BY: T. Guazzoni	
																						CHECKED BY: S. Menard							
																							TUNBRIDGE SHEET 12	SHEET 25	OF 80				

DIRECTION	MILEPOINT	LOCATION CODE (SHEET 2)	SIGN CODE	WIDTH (IN)	HEIGHT (IN)	SHEETING REMARKS	SIGN LEGEND	NEW SIGNS		EXISTING SIGNS				EXIST POST		NUMBER OF NEW POSTS	SQUARE STEEL (IN)			TUBULAR STEEL Ø (IN)					SIGN FRAME REQUIRED	REMARKS	SIGN DETAIL		
								"A"	"B"	RETAIN	SALVAGE FROM	SALVAGE TO	REMOVE	RETAIN	REMOVE		1.75	2.00	2.50	FOUNDATION	3.00	3.50	4.00	5.00			DETAIL IN SHS	DETAIL ON SHEET NUMBER	DETAIL ON STD SHEET NUMBER
																	(LB / FT)				(LB / FT)								
																	1.88	2.42	3.35		7.60	9.00	10.80	14.60					
TUNBRIDGE VT 110							FY-FLUORESCENT YELLOW FYG-FLUORESCENT YELLOW GREEN															"SHS"-STANDARD HIGHWAY SIGNS							
			F W13-1	24	24			4.00																X					
SB	6.380		F W11-1	30	30								1		X														
			F W11-1	30	30			6.25								1		X						X					
SB	6.335		G VR-017	24	24								1		X									DICKERMAN HILL RD TH-7					
			G VR-017	24	24			5.00								1		X								E-141			
SB	6.327		H R1-1	24	24								1		X									DICKERMAN HILL RD TH-7					
			H R1-1	24	24			6.25								1		X						X					
SB	6.320		F W1-4L	30	30		LEFT REVERSE CURVE						1		X														
			F W13-1	18	18		35 MPH PLAQUE						1																
SB	6.290		F W5-1	30	30		NARROW ROAD						1		X														
SB	6.280		F W1-4L	30	30			6.25								1		X						INSTALL 50' +/- SOUTH OF NARROW ROAD SIGN (REMOVED)	X				
			F W13-1	24	24			4.00																X					
SB	6.240		G VR-017	24	30								1		X									DURKEE RD TH-23 (NORTH)					
			G VR-017	24	30			5.00								1		X								E-141			
SB	6.240		H R1-1	30	30								1		X									DURKEE RD TH-23 (NORTH)					
SIGN SUMMARY SHEET							SHEET TOTALS	36.75	0.00	0	0	0	8	0	0	5	75								PROJECT NAME: Royalton-Barre Town VT110				
								SF	SF	EA	EA	EA	EA	EA	EA	EA		FT						PROJECT NUMBER: STPG SIGN(23)					
																											FILE NAME: Tunbridge.xls		
																											PLOT DATE: 6/16/2009		
VERMONT AGENCY OF TRANSPORTATION																							PROJECT MANAGER: N. Avery						
																										DRAWN BY: T. Guazzoni			
																										DESIGNED BY: D. Crosslev			
TOWN TOTALS							743.6	0.0	47.0	7.0	7.0	122	0.0	0.0	133	1995.0								CHECKED BY: S. Menard					
																							SHEET 26 OF 80						

DIRECTION	MILEPOINT	LOCATION CODE (SHEET 2)	SIGN CODE	WIDTH (IN)	HEIGHT (IN)	SHEETING REMARKS	SIGN LEGEND	NEW SIGNS		EXISTING SIGNS				EXIST POST		NUMBER OF NEW POSTS	SQUARE STEEL (IN)			TUBULAR STEEL Ø (IN)					SIGN FRAME REQUIRED	REMARKS	SIGN DETAIL				
								"A"	"B"	RETAIN	SALVAGE FROM	SALVAGE TO	REMOVE	RETAIN	REMOVE		1.75	2.00	2.50	FOUNDATION	3.00	3.50	4.00	5.00			DETAIL IN SHS	DETAIL ON SHEET NUMBER	DETAIL ON STD SHEET NUMBER		
																	(LB / FT)				(LB / FT)										
																	1.88	2.42	3.35		7.60	9.00	10.80	14.60							
TUNBRIDGE VT 110							FY-FLUORESCENT YELLOW FYG-FLUORESCENT YELLOW GREEN															"SHS"-STANDARD HIGHWAY SIGNS									
			H R1-1	30	30			6.25							1		X							X							
SB	6.230	F	W1-8 L	18	24		  	3.00							1		X							INSTALL 50' +/- SOUTH OF STOP SIGN	X						
SB	6.229	E	W1-8R	18	24		 	3.00							1		X							INSTALL 50' +/- SOUTH OF STOP SIGN	X						
SB	6.200	F	W1-8 L	18	24		 	3.00							1		X							INSTALL 150' +/- SOUTH OF CHEVRONS AT MM 0620	X						
SB	6.190	E	W1-8R	18	24			3.00							1		X							INSTALL 150' +/- SOUTH OF CHEVRONS AT MM 0620	X						
SB	5.990	F	W2-1Mj R	30	30		MODIFIED CROSS ROAD 						1		X																
SB	5.910	F	W2-1Mj R	30	30			6.25							1		X							INSTALL AT NORTH CORNER OF CEMETERY		6					
SB	5.850	G	VR-017	24	30								1		X									DURKEE RD TH-23 (SOUTH)							
		G	VR-017	24	30			5.00							1		X									E-141					
SB	5.850	H	R1-1	30	30								1		X									DURKEE RD TH-23 (SOUTH)							
		H	R1-1	30	30			6.25							1		X							X							
SB	5.720	F	R2-5A	24	30								1		X																
		F	W3-5	36	36			9.00							2		X							X							
SB	5.690	F	W1-2L	30	30		LEFT CURVE						1		X																
		F	W13-1	18	18		35 MPH PLAQUE						1																		
SIGN SUMMARY SHEET							SHEET TOTALS	44.75	0.00	0	0	0	6	0	0	10	150								PROJECT NAME: Royalton-Barre Town VT110						
								SF	SF	EA	EA	EA	EA	EA	EA	EA		FT						PROJECT NUMBER: STPG SIGN(23)							
																												FILE NAME: Tunbridge.xls			
																												PLOT DATE: 6/16/2009			
VERMONT AGENCY OF TRANSPORTATION																								DRAWN BY: T. Guazzoni							
																											CHECKED BY: S. Menard				
																											TUNBRIDGE SHEET 14				
							TOWN TOTALS	743.6	0.0	47.0	7.0	7.0	122	0.0	0.0	133	1995.0								SHEET 27 OF 80						

DIRECTION	MILEPOINT	LOCATION CODE (SHEET 2)	SIGN CODE	WIDTH (IN)	HEIGHT (IN)	SHEETING REMARKS	SIGN LEGEND	NEW SIGNS		EXISTING SIGNS				EXIST POST		NUMBER OF NEW POSTS	SQUARE STEEL (IN)			TUBULAR STEEL Ø (IN)				SIGN FRAME REQUIRED	REMARKS	SIGN DETAIL			
								"A"	"B"	RETAIN	SALVAGE FROM	SALVAGE TO	REMOVE	RETAIN	REMOVE		1.75	2.00	2.50	FOUNDATION	3.00	3.50	4.00			5.00	DETAIL IN SHS	DETAIL ON SHEET NUMBER	DETAIL ON STD SHEET NUMBER
																	(LB / FT)				(LB / FT)								
																	1.88	2.42	3.35		7.60	9.00	10.80			14.60			
TUNBRIDGE VT 110							FY-FLUORESCENT YELLOW FYG-FLUORESCENT YELLOW GREEN															"SHS"-STANDARD HIGHWAY SIGNS							
SB	5.640	F	VD-018	30	18							1		X															
		F	VD-018	30	18			3.75							1		X									E-128B			
SB	5.610	F	W1-2L	30	30			6.25							1		X						INSTALL 150' +/- SOUTH OF NORTH TUNBRIDGE SIGN	X					
		F	W13-1	24	24			4.00																X					
SB	5.550	F	R2-1	24	30	 						1		X															
		F	R2-1	30	36			7.50								1		X							X				
SB	5.440	F	W1-2R	30	30		CURVE RIGHT					1		X															
SB	5.370	F	R2-1	24	30	 						1		X		X													
		F	R2-1	30	36			7.50								1		X							6				
SB	5.350	F	W1-2R	30	30			6.25							1	X	X						INSTALL 75' +/- SOUTH OF UTILITY POLES, AND 80' +/- NORTH OF BEGINNING OF CURVE	X					
SB	5.262	F	W16-9YG	24	12		SCHOOL			1				X									W/FLASHING BEACON						
		F	S1-1YG	30	30		AHEAD			1																			
SB	5.230	F	VW-054R	30	30							1		X															
		F	VW-054R	30	30			6.25								1		X									E-154		
SB	5.180	H	R1-1	24	24		STOP			1				X															
SIGN SUMMARY SHEET							SHEET TOTALS	41.50	0.00	3	0	0	5	0	0	6	90							PROJECT NAME: Royalton-Barre Town VT110					
								SF	SF	EA	EA	EA	EA	EA	EA	EA		FT							PROJECT NUMBER: STPG SIGN(23)				
																										FILE NAME: Tunbridge.xls			
VERMONT AGENCY OF TRANSPORTATION							TOWN TOTALS	743.6	0.0	47.0	7.0	7.0	122	0.0	0.0	133	1995.0							PLOT DATE: 6/16/2009					
																										DRAWN BY: T. Guazzoni			
																						DESIGNED BY: D. Crossley							
																						CHECKED BY: S. Menard							
																						TUNBRIDGE SHEET 15							
																						SHEET 28 OF 80							

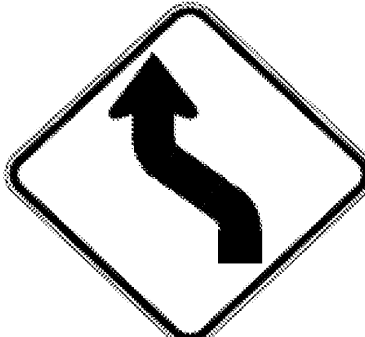
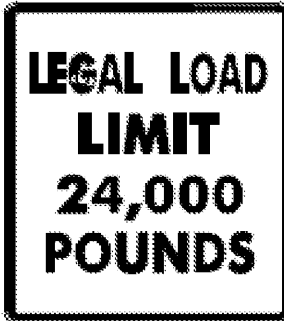
DIRECTION	MILEPOINT	LOCATION CODE (SHEET 2)	SIGN CODE	WIDTH (IN)	HEIGHT (IN)	SHEETING REMARKS	SIGN LEGEND	NEW SIGNS		EXISTING SIGNS				EXIST POST		NUMBER OF NEW POSTS	SQUARE STEEL (IN)			TUBULAR STEEL Ø (IN)					SIGN FRAME REQUIRED	REMARKS	SIGN DETAIL			
								"A"	"B"	RETAIN	SALVAGE FROM	SALVAGE TO	REMOVE	RETAIN	REMOVE		1.75	2.00	2.50	FOUNDATION	3.00	3.50	4.00	5.00			DETAIL IN SHS	DETAIL ON SHEET NUMBER	DETAIL ON STD SHEET NUMBER	
																	(LB / FT)				(LB / FT)									
																	1.88	2.42	3.35		7.60	9.00	10.80	14.60						
TUNBRIDGE VT 110							FY-FLUORESCENT YELLOW FYG-FLUORESCENT YELLOW GREEN															"SHS"-STANDARD HIGHWAY SIGNS								
SB	5.130	F	R2-1	24	30			5.00								1		X						INSTALL AND SOUTH END OF SCHOOL PROPERTY	X					
SB	4.820	F	R2-1	24	30			5.00								1		X						INSTALL AT FENCELINE NEAR TIRE ON STUMP	X					
SB	4.665	F	W1-1MbL	30	30		LEFT TURN WITH SIDE ROAD						1		X															
		F	W13-1	18	18		30 MPH PLAQUE						1																	
SB	4.610	F	W1-1MaL	30	30			6.25								1		X						INSTALL 300' +/- SOUTH OF ORIGINAL SIGN LOCATION AT SPLIT RAIL FENCE CORNER		6				
		F	W13-1	24	24			4.00																	X					
SB	4.582	G	VR-017	24	30								1		X									WHITNEY HILL RD TH-6						
		G	VR-017	24	30			5.00								1		X								E-141				
SB	4.574	H	R1-1	30	30								1		X									WHITNEY HILL RD TH-6						
		H	R1-1	30	30			6.25								1		X							X					
SB	4.572	F	OM -3 R	18	36								1		X															
		F	OM-3 R	13	36			3.00								1		X							X					
SB	4.568	E	OM-3 L	18	36								1		X															
		E	OM-3 L	12	36			3.00								1		X							X					
SB	4.530	F	R2-1	24	30								1		X															
SIGN SUMMARY SHEET							SHEET TOTALS	37.50	0.00	0	0	0	7	0	0	7	105								PROJECT NAME: Royalton-Barre Town VT110					
								SF	SF	EA	EA	EA	EA	EA	EA	EA		FT						PROJECT NUMBER: STPG SIGN(23)						
																											FILE NAME: Tunbridge.xls			
																											PLOT DATE: 6/16/2009			
VERMONT AGENCY OF TRANSPORTATION																							DRAWN BY: T. Guazzoni							
																										CHECKED BY: S. Menard				
																										SHEET 29 OF 80				
TOWN TOTALS							743.6	0.0	47.0	7.0	7.0	122	0.0	0.0	133	1995.0								TUNBRIDGE SHEET 16						

DIRECTION	MILEPOINT	LOCATION CODE (SHEET 2)	SIGN CODE	WIDTH (IN)	HEIGHT (IN)	SHEETING REMARKS	SIGN LEGEND	NEW SIGNS		EXISTING SIGNS				EXIST POST		NUMBER OF NEW POSTS	SQUARE STEEL (IN)			TUBULAR STEEL Ø (IN)					SIGN FRAME REQUIRED	REMARKS	SIGN DETAIL		
								"A"	"B"	RETAIN	SALVAGE FROM	SALVAGE TO	REMOVE	RETAIN	REMOVE		1.75	2.00	2.50	FOUNDATION	3.00	3.50	4.00	5.00			DETAIL IN SHS	DETAIL ON SHEET NUMBER	DETAIL ON STD SHEET NUMBER
																	(LB / FT)				(LB / FT)								
																	1.88	2.42	3.35		7.60	9.00	10.80	14.60					
TUNBRIDGE VT 110							FY-FLUORESCENT YELLOW FYG-FLUORESCENT YELLOW GREEN															"SHS"-STANDARD HIGHWAY SIGNS							
			F R2-1	24	30			5.00								1		X						X					
SB	4.140		F W1-2L	30	30		CURVE LEFT						1		X														
			F W13-1	18	18		35 MPH PLAQUE						1																
SB	4.080		F W1-2L	30	30			6.25															INSTALL 300' +/- SOUTH OF ORIGINAL SIGN LOCATION. AT POLE BEFORE DRIVE	X					
			F W13-1	18	18			4.00								1		X						X					
SB	3.795		G VR-017	24	30								1		X									MONARCH HILL RD TH-4					
			G VR-017	24	30			5.00								1		X								E-141			
SB	3.787		H R1-1	24	24								1		X														
			H R1-1	24	24			6.25								1		X						X					
SB	3.710		F R2-5A	24	30								1		X														
			F W3-5	36	36			9.00								2		X						X					
SB	3.630		F R2-1	24	30								1		X														
			F R2-1	30	36			7.50								1		X						X					
SB	3.430		F VD-062AL	72	16		BUSINESS SIGN			1				X															
SB	3.360		F W1-5	30	30		WINDING ROAD RIGHT				1			X															
SIGN SUMMARY SHEET							SHEET TOTALS	43.00	0.00	2	0	0	6	0	0	7	105								PROJECT NAME: Royalton-Barre Town VT110				
								SF	SF	EA	EA	EA	EA	EA	EA	EA		FT						PROJECT NUMBER: STPG SIGN(23)					
																											FILE NAME: Tunbridge.xls		
																											PLOT DATE: 6/16/2009		
VERMONT AGENCY OF TRANSPORTATION																							DRAWN BY: T. Guazzoni						
																										CHECKED BY: S. Menard			
																										TUNBRIDGE SHEET 17			
TOWN TOTALS							743.6	0.0	47.0	7.0	7.0	122	0.0	0.0	133	1995.0								SHEET 30 OF 80					

DIRECTION	MILEPOINT	LOCATION CODE (SHEET 2)	SIGN CODE	WIDTH (IN)	HEIGHT (IN)	SHEETING REMARKS	SIGN LEGEND	NEW SIGNS		EXISTING SIGNS				EXIST POST		NUMBER OF NEW POSTS	SQUARE STEEL (IN)			TUBULAR STEEL Ø (IN)				SIGN FRAME REQUIRED	REMARKS	SIGN DETAIL			
								"A"	"B"	RETAIN	SALVAGE FROM	SALVAGE TO	REMOVE	RETAIN	REMOVE		1.75	2.00	2.50	FOUNDATION	3.00	3.50	4.00			5.00	DETAIL IN SHS	DETAIL ON SHEET NUMBER	DETAIL ON STD SHEET NUMBER
																	(LB / FT)				(LB / FT)								
																	1.88	2.42	3.35		7.60	9.00	10.80			14.60			
TUNBRIDGE VT 110							FY-FLUORESCENT YELLOW FYG-FLUORESCENT YELLOW GREEN															"SHS"-STANDARD HIGHWAY SIGNS							
			F	W13-1	18	18	35 MPH PLAQUE			1																			
SB	3.340	F	R2-1	24	30								1		X														
		F	R2-1	30	36			7.50								1		X							6				
SB	3.300	F	VW-205	30	30		WATCH FOR TURNING VEHICLES			1					X														
SB	3.250	F	VD-018	30	18								1		X														
		F	VD-018	30	18			3.75								1		X								E-128B			
SB	3.180	F	R2-1	24	30		SPEED LIMIT 35			1				X															
SB	3.175	G	VR-017	24	30		LEGAL LOAD LIMIT 24,000 LBS			1				X									MILL RD TH-75						
SB	3.165	H	R1-1	30	30		STOP			1				X															
SB	3.120	F	M3-3	24	12		SOUTH			1				X															
		F	M1-5A	24	24		ROUTE 110			1																			
SB	3.100	F	VW-133	30	30		HIDDEN DRIVE LEFT			1				X															
SB	3.090	F	R2-1	24	30		SPEED LIMIT 35			1				X															
SB	3.050	H	R1-1	24	24					1			1		X								SPRING RD TH-2 (NORTH)						
		H	R1-1	30	30			6.25								1		X					REMOVE MIRROR	X					
SIGN SUMMARY SHEET							SHEET TOTALS	17.50	0.00	10	0	0	2	0	0	3	45							PROJECT NAME: Royalton-Barre Town VT110					
								SF	SF	EA	EA	EA	EA	EA	EA	EA	FT							PROJECT NUMBER: STPG SIGN(23)					
							TOWN TOTALS	743.6	0.0	47.0	7.0	7.0	122	0.0	0.0	133	1995.0							FILE NAME: Tunbridæ.xls PROJECT MANAGER: N. Avery DESIGNED BY: D. Crosslev TUNBRIDGE SHEET 18			PLOT DATE: 6/16/2009 DRAWN BY: T. Guazzoni CHECKED BY: S. Menard SHEET 31 OF 80		

DIRECTION	MILEPOINT	LOCATION CODE (SHEET 2)	SIGN CODE	WIDTH (IN)	HEIGHT (IN)	SHEETING REMARKS	SIGN LEGEND	NEW SIGNS		EXISTING SIGNS				EXIST POST		NUMBER OF NEW POSTS	SQUARE STEEL (IN)			TUBULAR STEEL Ø (IN)				SIGN FRAME REQUIRED	REMARKS	SIGN DETAIL			
								"A"	"B"	RETAIN	SALVAGE FROM	SALVAGE TO	REMOVE	RETAIN	REMOVE		1.75	2.00	2.50	FOUNDATION	3.00	3.50	4.00			5.00	DETAIL IN SHS	DETAIL ON SHEET NUMBER	DETAIL ON STD SHEET NUMBER
																	(LB / FT)				(LB / FT)								
																	1.88	2.42	3.35		7.60	9.00	10.80			14.60			
TUNBRIDGE VT 110							FY-FLUORESCENT YELLOW FYG-FLUORESCENT YELLOW GREEN															"SHS"-STANDARD HIGHWAY SIGNS							
SB	3.030	H	R1-1	24	24										X								SPRING RD TH-2 (SOUTH)						
		H	R1-1	30	30			6.25						1		X								X					
SB	3.000	F	R2-1	24	30							1		X															
		F	R2-1	24	30			5.00						1		X								X					
SB	2.960	F	W11-2YG	30	30		PEDESTRIAN			1				X															
		F	W7-3A	24	18		NEXT 1/4 MILE			1																			
SB	2.755	F	VW-205	30	30		WATCH FOR TURNING VEHICLES			1			X																
SB	2.660	H	R1-1	30	30		STOP			1			X										FAIRGROUND RD - PVT						
SB	2.650	F	R2-1	24	30							1		X															
		F	R2-1	24	30			5.00						1		X								X					
SB	2.513	F	M3-3S	24	12		SOUTH			1			X																
		F	M1-5	30	24		VERMONT 110			1																			
SB	2.450	F	R2-1	24	30							1		X															
		F	R2-1	24	30			5.00						1		X								X					
SB	2.317	F	W1-2L	30	30		LEFT CURVE				1			X															
SIGN SUMMARY SHEET							SHEET TOTALS	21.25	0.00	6	1	0	4	0	0	4	60							PROJECT NAME: Royalton-Barre Town VT110					
								SF	SF	EA	EA	EA	EA	EA	EA	EA		FT							PROJECT NUMBER: STPG SIGN(23)				
							VERMONT AGENCY OF TRANSPORTATION						3													FILE NAME: Tunbridge.xls			
							TOWN TOTALS	743.6	0.0	47.0	7.0	7.0	122	0.0	0.0	133	1995.0							PLOT DATE: 6/16/2009					
																							DRAWN BY: T. Guazzoni						
																							CHECKED BY: S. Menard						
																							SHEET 32 OF 80						

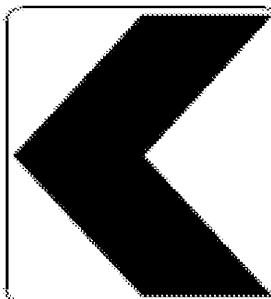
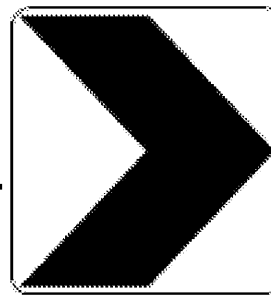
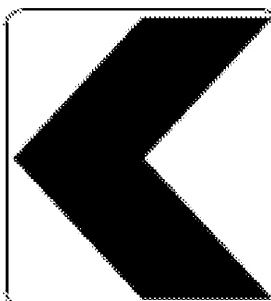
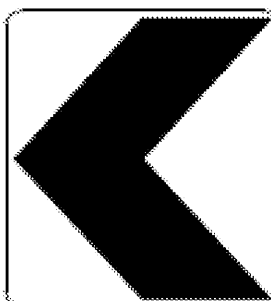
DIRECTION	MILEPOINT	LOCATION CODE (SHEET 2)	SIGN CODE	WIDTH (IN)	HEIGHT (IN)	SHEETING REMARKS	SIGN LEGEND	NEW SIGNS		EXISTING SIGNS				EXIST POST		NUMBER OF NEW POSTS	SQUARE STEEL (IN)			TUBULAR STEEL Ø (IN)				SIGN FRAME REQUIRED	REMARKS	SIGN DETAIL			
								"A"	"B"	RETAIN	SALVAGE FROM	SALVAGE TO	REMOVE	RETAIN	REMOVE		1.75	2.00	2.50	FOUNDATION	3.00	3.50	4.00			5.00	DETAIL IN SHS	DETAIL ON SHEET NUMBER	DETAIL ON STD SHEET NUMBER
																	(LB / FT)				(LB / FT)								
																	1.88	2.42	3.35		7.60	9.00	10.80			14.60			
TUNBRIDGE VT 110							FY-FLUORESCENT YELLOW FYG-FLUORESCENT YELLOW GREEN															"SHS"-STANDARD HIGHWAY SIGNS							
			F W13-1	24	24		40 MPH PLAQUE				1																		
SB	2.229		G VR-017	24	30								1		X										HOWE LANE TH-45				
			G VR-017	24	30			5.00						1		X												E-141	
SB	2.221		H R1-1	30	30								1		X										HOWE LANE TH-45				
			H R1-1	30	30			6.25						1		X									X				
SB	2.219		F W1-2L	30	30		CURVE LEFT					1				X									FROM MP 2.317				
			F W13-1	24	24		40 MPH PLAQUE					1																	
SB	2.180		F W1-8L	24	18			3.00								1		X							INSTALL 200' +/- SOUTH OF SALVAGED CURVE SIGN. MIDDLE OF LEDGE AREA	IN	X		
SB	2.179		E W1-8R	24	18			3.00								1		X							INSTALL 200' +/- SOUTH OF SALVAGED CURVE SIGN. MIDDLE OF LEDGE AREA	IN	X		
SB	1.450		G VR-017	24	30								1		X										HOWE LANE TH-53				
			G VR-017	24	30			5.00						1		X												E-141	
SB	1.450		H R1-1	30	30								1		X										HOWE LANE TH-53				
			H R1-1	30	30			6.25						1		X									X				
SB	1.240		F W1-2R	30	30		RIGHT CURVE				1	1			X	1		X							INSTALL SALVAGED SIGN ON NEW POST				
SB	0.920		F W1-4L	30	30								1		X														
SIGN SUMMARY SHEET							SHEET TOTALS	28.50	0.00	0	12	3	5	0	0	8	120							PROJECT NAME: Royalton-Barre Town VT110					
								SF	SF	EA	EA	EA	EA	EA	EA	EA		FT							PROJECT NUMBER: STPG SIGN(23)				
							VERMONT AGENCY OF TRANSPORTATION																				FILE NAME: Tunbridge.xls		
							TOWN TOTALS	743.6	0.0	47.0	7.0	7.0	122	0.0	0.0	133	1995.0							PROJECT MANAGER: N. Avery			DRAWN BY: T. Guazzoni		
																							DESIGNED BY: D. Crosslev			CHECKED BY: S. Menard			
																							TUNBRIDGE SHEET 20			SHEET 33 OF 80			

DIRECTION	MILEPOINT	LOCATION CODE (SHEET 2)	SIGN CODE	WIDTH (IN)	HEIGHT (IN)	SHEETING REMARKS	SIGN LEGEND	NEW SIGNS		EXISTING SIGNS				EXIST POST		NUMBER OF NEW POSTS	SQUARE STEEL (IN)			TUBULAR STEEL Ø (IN)				SIGN FRAME REQUIRED	REMARKS	SIGN DETAIL			
								"A"	"B"	RETAIN	SALVAGE FROM	SALVAGE TO	REMOVE	RETAIN	REMOVE		1.75	2.00	2.50	FOUNDATION	3.00	3.50	4.00			5.00	DETAIL IN SHS	DETAIL ON SHEET NUMBER	DETAIL ON STD SHEET NUMBER
																	(LB / FT)				(LB / FT)								
																	1.88	2.42	3.35		7.60	9.00	10.80			14.60			
TUNBRIDGE VT 110							FY-FLUORESCENT YELLOW FYG-FLUORESCENT YELLOW GREEN															"SHS"-STANDARD HIGHWAY SIGNS							
			F W13-1	24	24							1																	
			F W1-4L	30	30			6.25							1		X												
			F W13-1	24	24			4.00																					
SB	0.667		F W1-4L	30	30		LEFT REVERSE CURVE			1				X															
			F W13-1	24	24		35 MPH PLAQUE			1																			
SB	0.602		F W1-6	48	24		LARGE ARROW - LEFT			1				X															
SB	0.600		E W1-6	48	24		LARGE ARROW - RIGHT			1				X															
SB	0.350		F S3-1	30	30		SCHOOL BUS STOP AHEAD						1		X														
SB	0.315		F W2-2Ma R	30	30			6.25								2		X						INSTALL 175' +/- SOUTH OF ORIGINAL SCHOOL BUS STOP AHEAD SIGN		6			
			F S3-1	30	30			6.25																INSTALL BELOW INTERSECTION WARNING SIGN	X				
SB	0.240		G VR-017	24	24							1		X										RUSSELL RD TH-52					
			G VR-017	24	30			5.00								1		X								E-141			
SB	0.240		H R1-1	24	24							1		X										RUSSELL RD TH-52					
			H R1-1	30	30			6.25								1		X							X				
SB	0.020		G VR-023B	24	30		\$500 FINE FOR TRASH			1				X												6			
SIGN SUMMARY SHEET							SHEET TOTALS	34.00	0.00	5	0	0	4	0	0	5	75							PROJECT NAME: Royalton-Barre Town VT110					
								SF	SF	EA	EA	EA	EA	EA	EA	EA		FT					PROJECT NUMBER: STPG SIGN(23)						
																										FILE NAME: Tunbridge.xls			
																										PROJECT MANAGER: N. Avery			
VERMONT AGENCY OF TRANSPORTATION																						DESIGNED BY: D. Crosslev							
																									CHECKED BY: S. Menard				
							TOWN TOTALS	743.6	0.0	47.0	7.0	7.0	122	0.0	0.0	133	1995.0							PLOT DATE: 6/16/2009					
																							DRAWN BY: T. Guazzoni						
																						SHEET 34 OF 80							
																						TUNBRIDGE SHEET 21							

DIRECTION	MILEPOINT	LOCATION CODE (SHEET 2)	SIGN CODE	WIDTH (IN)	HEIGHT (IN)	SHEETING REMARKS	SIGN LEGEND	NEW SIGNS		EXISTING SIGNS				EXIST POST		NUMBER OF NEW POSTS	SQUARE STEEL (IN)			TUBULAR STEEL Ø (IN)				SIGN FRAME REQUIRED	REMARKS	SIGN DETAIL			
								"A"	"B"	RETAIN	SALVAGE FROM	SALVAGE TO	REMOVE	RETAIN	REMOVE		1.75	2.00	2.50	FOUNDATION	3.00	3.50	4.00			5.00	DETAIL IN SHS	DETAIL ON SHEET NUMBER	DETAIL ON STD SHEET NUMBER
																	(LB / FT)				(LB / FT)								
																	1.88	2.42	3.35		7.60	9.00	10.80			14.60			
CHELSEA VT 110						FY-FLUORESCENT YELLOW FYG-FLUORESCENT YELLOW GREEN																"SHS"-STANDARD HIGHWAY SIGNS							
NB	0.000	C	VD-024	60	7.5									X															
		C	VD-024	72	10		CHELSEA TUNBRIDGE	5.00								2		X									4		
		C	VD-700	6	10		1100 0904 0000 1100 0913 0793	0.42																					
		C	VD-700	6	10			0.42																					
NB	0.507	A	W2-2MR	30	30		RIGHT SIDE ROAD			1				X															
		A	W16-8A	30	8		MOXLEY RD			1																			
NB	0.516	C	VR-017	24	24		LEGAL LOAD LIMIT 16,000 POUNDS						1		X										MOXLEY RD TH-68				
		C	VR-017	24	24			5.00							1		X										E-141		
NB	0.524	D	R1-1	24	24		STOP						1		X										MOXLEY RD TH-68				
		D	R1-1	24	24			6.25								1		X							X				
NB	0.630	F	OM-3 R	12	36								1		X														
		F	OM-3 R	12	36			3.00								1		X							X				
NB	0.640	F	OM-3 L	12	36								1		X														
		E	OM-3 L	12	36			3.00								1		X							X				
NB	0.770	A	D1-1	54	7.5								1		X														
SIGN SUMMARY SHEET						SHEET TOTALS		23.09	0.00	2	0			0	0	6	90							PROJECT NAME: Royalton-Barre Town VT110					
								SF	SF	EA	EA	EA	EA	EA	EA	EA		FT						PROJECT NUMBER: STPG SIGN(23)					
												1	8												FILE NAME: Chelsea.xls				
VERMONT AGENCY OF TRANSPORTATION						TOWN TOTALS		539.5	0.0	59.0	5.0	5.0	107	0.0	0.0	96	1440.0							PLOT DATE: 6/15/2009					
																				DRAWN BY: T. Guazzoni									
																						CHECKED BY: S. Menard							
																						SHEET 35 OF 80							

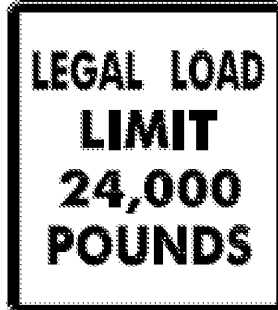
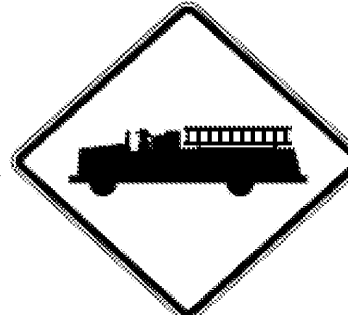
DIRECTION	MILEPOINT	LOCATION CODE (SHEET 2)	SIGN CODE	WIDTH (IN)	HEIGHT (IN)	SHEETING REMARKS	SIGN LEGEND	NEW SIGNS		EXISTING SIGNS				EXIST POST		NUMBER OF NEW POSTS	SQUARE STEEL (IN)			TUBULAR STEEL Ø (IN)				SIGN FRAME REQUIRED	REMARKS	SIGN DETAIL			
								"A"	"B"	RETAIN	SALVAGE FROM	SALVAGE TO	REMOVE	RETAIN	REMOVE		1.75	2.00	2.50	FOUNDATION	3.00	3.50	4.00			5.00	DETAIL IN SHS	DETAIL ON SHEET NUMBER	DETAIL ON STD SHEET NUMBER
																	(LB / FT)				(LB / FT)								
																	1.88	2.42	3.35		7.60	9.00	10.80			14.60			
CHELSEA VT 110						FY-FLUORESCENT YELLOW FYG-FLUORESCENT YELLOW GREEN																"SHS"-STANDARD HIGHWAY SIGNS							
		A	D1-1A	72	12			6.00							2		X								5				
NB	0.810	A	M3-1	24	12								1		X														
		A	M1-5	30	24								1																
		A	M3-1	24	12			2.00							1		X						GREEN ON WHITE SHEETING	X					
		A	M1-5	30	24			5.00																		E-136B			
NB	0.890	A	R2-1	24	30								1		X														
		A	R2-1	24	30			5.00							1		X							X					
NB	0.960	A	W1-2R	30	30		RIGHT CURVE						1		X														
		A	W13-1	18	18		35 MPH PLAQUE						1																
NB	1.020	A	W1-2R	30	30			6.25							1		X						INSTALL 300'+/- NORTH OF ORIGINAL SIGN LOCATION. AT END OF PULL OFF	X					
		A	W13-1	24	24			4.00																X					
NB	1.110	A	W1-2R	30	30		RIGHT CURVE						1		X														
NB	1.180	A	W1-2R	30	30			6.25							1		X						INSTALL 400' NORTH OF ORIGINAL SIGN LOCATION	X					
NB	1.690	A	W1-2 L	30	30		LEFT CURVE						1		X														
		A	W13-1	18	18		35 MPH PLAQUE						1																
SIGN SUMMARY SHEET						SHEET TOTALS	34.50	0.00	0	0	0	8	0	0	6	90							PROJECT NAME: Royalton-Barre Town VT110						
							SF	SF	EA	EA	EA	EA	EA	EA	EA		FT					PROJECT NUMBER: STPG SIGN(23)							
																									FILE NAME: Chelsea.xls				
																									PLOT DATE: 6/15/2009				
VERMONT AGENCY OF TRANSPORTATION																						DRAWN BY: T. Guazzoni							
																								DESIGNED BY: D. Crosslev					
						TOWN TOTALS	539.5	0.0	59.0	5.0	5.0	107	0.0	0.0	96	1440.0							CHECKED BY: S. Menard						
																							SHEET 36	OF	80				

DIRECTION	MILEPOINT	LOCATION CODE (SHEET 2)	SIGN CODE	WIDTH (IN)	HEIGHT (IN)	SHEETING REMARKS	SIGN LEGEND	NEW SIGNS		EXISTING SIGNS				EXIST POST		NUMBER OF NEW POSTS	SQUARE STEEL (IN)			TUBULAR STEEL Ø (IN)				SIGN FRAME REQUIRED	REMARKS	SIGN DETAIL			
								"A"	"B"	RETAIN	SALVAGE FROM	SALVAGE TO	REMOVE	RETAIN	REMOVE		1.75	2.00	2.50	FOUNDATION	3.00	3.50	4.00			5.00	DETAIL IN SHS	DETAIL ON SHEET NUMBER	DETAIL ON STD SHEET NUMBER
																	(LB / FT)				(LB / FT)								
																	1.88	2.42	3.35		7.60	9.00	10.80			14.60			
CHELSEA VT 110						FY-FLUORESCENT YELLOW FYG-FLUORESCENT YELLOW GREEN																"SHS"-STANDARD HIGHWAY SIGNS							
NB	1.770	A	W1-2 L	30	30			6.25							1		X						INSTALL 400' NORTH OF ORIGINAL SIGN LOCATION	X					
		A	W13-1	24	24			4.00							1									X					
NB	1.840	A	R2-5A	24	30		REDUCED SPEED AHEAD 						1		X														
		A	W3-5	36	36			9.00							2		X							X					
NB	1.913	A	VD-062B	72	16		BUSINESS SIGN			1				X															
NB	1.990	A	R2-1	24	30								1		X											6			
		A	R2-1	30	36			7.50							1		X												
NB	2.050	A	S3-1	30	30		SCHOOL BUS STOP AHEAD						1		X														
NB	2.087	A	W1-10L	30	30		MODIFIED LEFT CURVE						1		X														
NB	2.188	C	VR-017	24	24								1		X								JENKINS BROOK RD TH-3						
		C	VR-017	24	30			5.00							1		X									E-141			
NB	2.196	D	R1-1	24	24						1	1	1		X								JENKINS BROOK RD TH-3						
		D	R1-1	30	30			6.25							1		X						X						
NB	2.223	A	R2-1	30	30		SPEED LIMIT 40			1				X															
NB	2.254	A	W1-8	18	24								1		X														
SIGN SUMMARY SHEET						SHEET TOTALS		38.00	0.00	2	0	0	7	0	0	7	105						PROJECT NAME: Royalton-Barre Town VT110						
								SF	SF	EA	EA	EA	EA	EA	EA	EA		FT					PROJECT NUMBER: STPG SIGN(23)						
						TOWN TOTALS		539.5	0.0	59.0	5.0	5.0	107	0.0	0.0	96	1440.0						FILE NAME: Chelsea.xls PROJECT MANAGER: N. Avery DESIGNED BY: D. Crossley CHELSEA SHEET 3			PLOT DATE: 6/15/2009 DRAWN BY: T. Guazzoni CHECKED BY: S. Menard SHEET 37 OF 80			

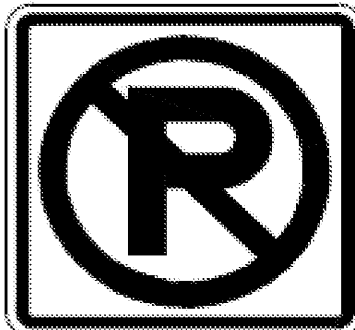
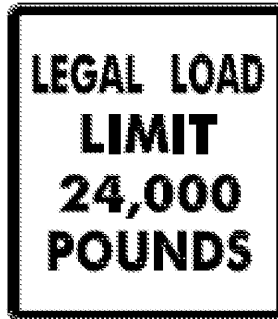
DIRECTION	MILEPOINT	LOCATION CODE (SHEET 2)	SIGN CODE	WIDTH (IN)	HEIGHT (IN)	SHEETING REMARKS	SIGN LEGEND	NEW SIGNS		EXISTING SIGNS				EXIST POST		NUMBER OF NEW POSTS	SQUARE STEEL (IN)			TUBULAR STEEL Ø (IN)				SIGN FRAME REQUIRED	REMARKS	SIGN DETAIL			
								"A"	"B"	RETAIN	SALVAGE FROM	SALVAGE TO	REMOVE	RETAIN	REMOVE		1.75	2.00	2.50	FOUNDATION	3.00	3.50	4.00			5.00	DETAIL IN SHS	DETAIL ON SHEET NUMBER	DETAIL ON STD SHEET NUMBER
																	(LB / FT)				(LB / FT)								
																	1.88	2.42	3.35		7.60	9.00	10.80			14.60			
CHELSEA VT 110						FY-FLUORESCENT YELLOW FYG-FLUORESCENT YELLOW GREEN																"SHS"-STANDARD HIGHWAY SIGNS							
			A	W1-8	18	24		3.00								1		X						X					
NB	2.255		B	W1-8	18	24						1		X															
			B	W1-8	18	24		3.00								1		X						X					
NB	2.264		B	W1-8	18	24							1		X														
			B	W1-8	18	24		3.00								1		X						X					
NB	2.274		A	W1-8	18	24							1		X														
			A	W1-8	18	24		3.00								1		X						X					
NB	2.275		B	W1-8	18	24							1		X														
			B	W1-8	18	24		3.00								1		X						X					
NB	2.294		A	W11-2YG	30	30	PEDESTRIAN			1				X															
			A	W16-9YG	24	10	AHEAD			1																			
NB	2.414		A	R2-5A	24	30	REDUCED SPEED AHEAD 						1		X														
			A	W3-5	36	36		9.00								2		X						X					
NB	2.460		A	VD-018	30	18							1		X														
			A	VD-018	30	18		3.75								1		X								E-128B			
SIGN SUMMARY SHEET						SHEET TOTALS	27.75	0.00	2	0	0	6	0	0	8	120							PROJECT NAME: Royalton-Barre Town VT110						
							SF	SF	EA	EA	EA	EA	EA	EA	EA	FT							PROJECT NUMBER: STPG SIGN(23)						
																									FILE NAME: Chelsea.xls				
																									PLOT DATE: 6/15/2009				
VERMONT AGENCY OF TRANSPORTATION																						DRAWN BY: T. Guazzoni							
																								CHECKED BY: S. Menard					
																								SHEET 38 OF 80					
TOWN TOTALS						539.5	0.0	59.0	5.0	5.0	107	0.0	0.0	96	1440.0							CHELSEA SHEET 4							

DIRECTION	MILEPOINT	LOCATION CODE (SHEET 2)	SIGN CODE	WIDTH (IN)	HEIGHT (IN)	SHEETING REMARKS	SIGN LEGEND	NEW SIGNS		EXISTING SIGNS				EXIST POST		NUMBER OF NEW POSTS	SQUARE STEEL (IN)			TUBULAR STEEL Ø (IN)				SIGN FRAME REQUIRED	REMARKS	SIGN DETAIL			
								"A"	"B"	RETAIN	SALVAGE FROM	SALVAGE TO	REMOVE	RETAIN	REMOVE		1.75	2.00	2.50	FOUNDATION	3.00	3.50	4.00			5.00	DETAIL IN SHS	DETAIL ON SHEET NUMBER	DETAIL ON STD SHEET NUMBER
																	(LB / FT)				(LB / FT)								
																	1.88	2.42	3.35		7.60	9.00	10.80			14.60			
CHELSEA VT 110							FY-FLUORESCENT YELLOW FYG-FLUORESCENT YELLOW GREEN															"SHS"-STANDARD HIGHWAY SIGNS							
NB	2.506	A	W11-2YG	30	30		PEDESTRIAN			1				X															
		A	W16-7YG	24	12		DOWN ARROW			1																			
NB	2.543	A	R2-1	24	30							1		X															
		A	R2-1	30	36			7.50					1		X										6				
NB	2.660	A	S1-1YG	30	30		SCHOOL			1				X															
		A	W16-9YG	24	10		AHEAD			1																			
NB	2.773	C	VR-017	24	30							1		X															
		C	VR-017	24	30			5.00					1		X											E-141			
NB	2.781	D	R1-1	24	24					1	1	1		X															
		D	R1-1	30	30			6.25					1		X									X					
NB	2.821	A	R2-1	24	30		SPEED LIMIT 30			1				X															
NB	2.860	A	M2-1	21	15							1		X															
		A	M1-5	30	24							1																	
		A	M2-1	21	15			2.19					1		X											E-136B			
		A	M1-5	30	24			5.00																X					
SIGN SUMMARY SHEET							SHEET TOTALS	25.94	0.00	5	0	0	5	0	0	4	60							PROJECT NAME: Royalton-Barre Town VT110					
								SF	SF	EA	EA	EA	EA	EA	EA	EA		FT					PROJECT NUMBER: STPG SIGN(23)						
							TOWN TOTALS	539.5	0.0	59.0	5.0	5.0	107	0.0	0.0	96	1440.0							FILE NAME: Chelsea.xls PROJECT MANAGER: N. Avery DESIGNED BY: D. Crosslev CHELSEA SHEET 5			PLOT DATE: 6/15/2009 DRAWN BY: T. Guazzoni CHECKED BY: S. Menard SHEET 39 OF 80		

DIRECTION	MILEPOINT	LOCATION CODE (SHEET 2)	SIGN CODE	WIDTH (IN)	HEIGHT (IN)	SHEETING REMARKS	SIGN LEGEND	NEW SIGNS		EXISTING SIGNS				EXIST POST		NUMBER OF NEW POSTS	SQUARE STEEL (IN)			TUBULAR STEEL Ø (IN)				SIGN FRAME REQUIRED	REMARKS	SIGN DETAIL			
								"A"	"B"	RETAIN	SALVAGE FROM	SALVAGE TO	REMOVE	RETAIN	REMOVE		1.75	2.00	2.50	FOUNDATION	3.00	3.50	4.00			5.00	DETAIL IN SHS	DETAIL ON SHEET NUMBER	DETAIL ON STD SHEET NUMBER
																	(LB / FT)				(LB / FT)								
																	1.88	2.42	3.35		7.60	9.00	10.80			14.60			
CHELSEA VT 110							FY-FLUORESCENT YELLOW FYG-FLUORESCENT YELLOW GREEN															"SHS"-STANDARD HIGHWAY SIGNS							
NB	2.907	A	D1-1A	72	10		↑ WASHINGTON 9 ↑ EAST BARRE 14 VERSHIRE 7 ↗ THETFORD 21 ↗						1		X														
		A	D1-1A	72	10								1																
		A	D1-1A	72	10								1																
		A	D1-1A	72	10								1																
		A	D1-1A	72	12			6.00								2			X							5			
		A	D1-1A	72	12			6.00																		5			
		A	D1-1A	72	12		6.00																		5				
		A	D1-1A	72	12		6.00																		5				
NB	2.917	D	R1-1	24	24		STOP								X									COURT ST TH-30					
		D	R1-1	30	30			6.25								1			X						X				
NB	2.908	A	S1-1YG	30	30		SCHOOL			1				X															
		A	W16-7YG	24	12		DOWN ARROW			1																			
NB	2.950	A	M3-1S	24	12		NORTH			1				X															
		A	M1-5	30	24		VERMONT 110			1																			
		A	M6-3S	21	15		^UP ARROW			1																			
SIGN SUMMARY SHEET							SHEET TOTALS	30.25	0.00	5	0	0	5	0	0	3	45							PROJECT NAME: Royalton-Barre Town VT110					
								SF	SF	EA	EA	EA	EA	EA	EA	EA		FT					PROJECT NUMBER: STPG SIGN(23)						
							VERMONT AGENCY OF TRANSPORTATION				2	2														FILE NAME: Chelsea.xls	PLOT DATE: 6/15/2009		
							TOWN TOTALS	539.5	0.0	59.0	5.0	5.0	107	0.0	0.0	96	1440.0							PROJECT MANAGER: N. Avery	DRAWN BY: T. Guazzoni				
																							DESIGNED BY: D. Crossley	CHECKED BY: S. Menard					
																							CHELSEA SHEET 6	SHEET 40 OF 80					

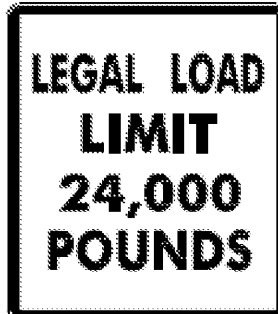
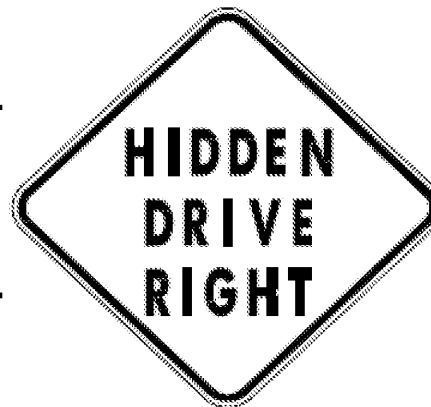
DIRECTION	MILEPOINT	LOCATION CODE (SHEET 2)	SIGN CODE	WIDTH (IN)	HEIGHT (IN)	SHEETING REMARKS	SIGN LEGEND	NEW SIGNS		EXISTING SIGNS				EXIST POST		NUMBER OF NEW POSTS	SQUARE STEEL (IN)			TUBULAR STEEL Ø (IN)					SIGN FRAME REQUIRED	REMARKS	SIGN DETAIL		
								"A"	"B"	RETAIN	SALVAGE FROM	SALVAGE TO	REMOVE	RETAIN	REMOVE		1.75	2.00	2.50	FOUNDATION	3.00	3.50	4.00	5.00			DETAIL IN SHS	DETAIL ON SHEET NUMBER	DETAIL ON STD SHEET NUMBER
																	(LB / FT)				(LB / FT)								
																	1.88	2.42	3.35		7.60	9.00	10.80	14.60					
CHELSEA VT 110							FY-FLUORESCENT YELLOW FYG-FLUORESCENT YELLOW GREEN															"SHS"-STANDARD HIGHWAY SIGNS							
			A M3-2S	24	12		EAST			1																			
			A M1-5	30	24		VERMONT 113			1																			
			A M6-1S	21	15		RIGHT --->			1																			
			B M3-3S	24	12		SOUTH			1																			
			B M1-5	30	24		VERMONT 110			1																			
			B M6-3S	21	15		^UP ARROW			1																			
			B M3-2S	24	12		EAST			1																			
			B M1-5	30	24		VERMONT 113			1																			
			B M6-1S	21	15		<--- LEFT			1																			
NB	2.966	C	VR-017	24	24							1		X										CHURCH ST TH-76					
		C	VR-017	24	30			5.00							1	X										E-141			
NB	2.974	D	R1-1	24	24							1		X										CHURCH ST TH-76					
		D	R1-1	30	30			6.25							1	X								X					
NB	3.040	A	W11-8	30	30							1		X															
		A	W11-8	30	30			6.25							1	X								X					
SIGN SUMMARY SHEET							SHEET TOTALS	17.50	0.00	9	0	0	3	0	0	3	45							PROJECT NAME: Royalton-Barre Town VT110					
								SF	SF	EA	EA	EA	EA	EA	EA	EA	FT										PROJECT NUMBER: STPG SIGN(23)		
																											FILE NAME: Chelsea.xls		
VERMONT AGENCY OF TRANSPORTATION																							PLOT DATE: 6/15/2009						
																										DRAWN BY: T. Guazzoni			
							TOWN TOTALS	539.5	0.0	59.0	5.0	5.0	107	0.0	0.0	96	1440.0									DESIGNED BY: D. Crosslev			
																						CHECKED BY: S. Menard							
																							SHEET 41 OF 80						

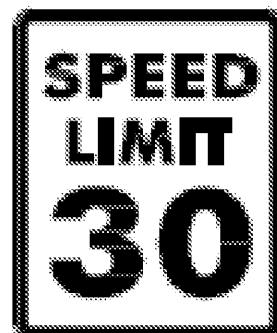
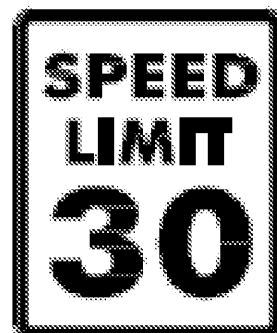
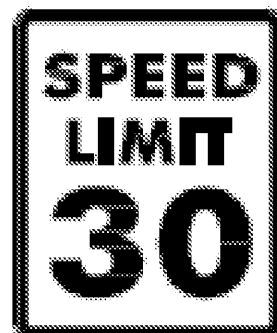
DIRECTION	MILEPOINT	LOCATION CODE (SHEET 2)		SIGN CODE	WIDTH (IN)	HEIGHT (IN)	SHEETING REMARKS	SIGN LEGEND	NEW SIGNS		EXISTING SIGNS				EXIST POST		NUMBER OF NEW POSTS	SQUARE STEEL (IN)			TUBULAR STEEL Ø (IN)				SIGN FRAME REQUIRED	REMARKS	SIGN DETAIL			
									"A"	"B"	RETAIN	SALVAGE FROM	SALVAGE TO	REMOVE	RETAIN	REMOVE		1.75	2.00	2.50	FOUNDATION	3.00	3.50	4.00			5.00	DETAIL IN SHS	DETAIL ON SHEET NUMBER	DETAIL ON STD SHEET NUMBER
																		(LB / FT)				(LB / FT)								
																		1.88	2.42	3.35		7.60	9.00	10.80			14.60			
CHELSEA VT 110								FY-FLUORESCENT YELLOW FYG-FLUORESCENT YELLOW GREEN															"SHS"-STANDARD HIGHWAY SIGNS							
NB	3.074	A	R2-1	24	30								1	X		1														
		A	R2-1	24	30			6.25																INSTALL NEW SIGN ON RETAINED POST	X					
NB	3.185	A	S1-1YG	30	30								1		X															
		A	W16-9YG	24	10								1																	
		A	S1-1YG	30	30	FYG		6.25								1		X								X				
		A	W16-9YG	24	12	FYG		2.00																		X				
NB	3.317	A	D2-1	72	10		  						1		X															
		A	D2-1	72	10								1																	
		A	M3-1	24	12								1																	
		A	M1-6	30	24								1																	
		A	D2-1	72	12			6.00									2		X								5			
		A	D2-1	72	12			6.00																			5			
		A	M3-1	24	12			2.00																GREEN ON WHITE SHEETING	X					
		A	M1-6	30	24			5.00																			E-128B			
NB	3.366	A	R2-1	24	30		SPEED LIMIT 30				1	1			X															
SIGN SUMMARY SHEET								SHEET TOTALS				33.50	0.00	0	1	1	7	0	0	3	45			PROJECT NAME: Royalton-Barre Town VT110						
												SF	SF	EA	EA	EA	EA	EA	EA	EA		FT					PROJECT NUMBER: STPG SIGN(23)			
																539.5	0.0	59.0	5.0	5.0	107	0.0	0.0	96	1440.0			FILE NAME: Chelsea.xls PROJECT MANAGER: N. Avery DESIGNED BY: D. Crossley CHELSEA SHEET 8		
VERMONT AGENCY OF TRANSPORTATION								TOWN TOTALS				539.5	0.0	59.0	5.0	5.0	107	0.0	0.0	96	1440.0			PLOT DATE: 6/15/2009 DRAWN BY: T. Guazzoni CHECKED BY: S. Menard SHEET 42 OF 80						

DIRECTION	MILEPOINT	LOCATION CODE (SHEET 2)	SIGN CODE	WIDTH (IN)	HEIGHT (IN)	SHEETING REMARKS	SIGN LEGEND	NEW SIGNS		EXISTING SIGNS				EXIST POST		NUMBER OF NEW POSTS	SQUARE STEEL (IN)			TUBULAR STEEL Ø (IN)				SIGN FRAME REQUIRED	REMARKS	SIGN DETAIL			
								"A"	"B"	RETAIN	SALVAGE FROM	SALVAGE TO	REMOVE	RETAIN	REMOVE		1.75	2.00	2.50	FOUNDATION	3.00	3.50	4.00			5.00	DETAIL IN SHS	DETAIL ON SHEET NUMBER	DETAIL ON STD SHEET NUMBER
																	(LB / FT)				(LB / FT)								
																	1.88	2.42	3.35		7.60	9.00	10.80			14.60			
CHELSEA VT 110						FY-FLUORESCENT YELLOW FYG-FLUORESCENT YELLOW GREEN																"SHS"-STANDARD HIGHWAY SIGNS							
			A R8-3A	24	24		 					1																	
			A VR-644	24	12								1																
			A R8-3A	24	24			4.00						1	X								X						
			A VR-644	24	12			2.00															RED ON WHITE SHEETING		6				
NB	3.410		A R8-3A	24	30		 					1	X																
			A M4-6	24	12								1																
			A R8-3A	24	24			4.00						1	X								X						
			A M4-6	24	12			2.00															RED ON WHITE SHEETING	X					
NB	3.595		A S3-1	30	30		SCHOOL BUS STOP AHEAD			1			X																
NB	3.631		A W1-1L	30	30		RIGHT TURN			1			X																
			A W13-1	18	18							1																	
			A W13-1	24	24			4.00															INSTALL LARGER PLAQUE UNDER EXISTING SIGN	X					
NB	3.670		C VR-017	24	24							1	X																
			C VR-017	24	30			5.00						1	X										E-141				
NB	3.676		D R1-1	24	24							1	X																
SIGN SUMMARY SHEET						SHEET TOTALS	21.00	0.00	2	0	0	7	0	0	3	45							PROJECT NAME: Royalton-Barre Town VT110						
							SF	SF	EA	EA	EA	EA	EA	EA	EA		FT					PROJECT NUMBER: STPG SIGN(23)							
																								FILE NAME: Chelsea.xls					
																								PLOT DATE: 6/15/2009					
VERMONT AGENCY OF TRANSPORTATION						TOWN TOTALS	539.5	0.0	59.0	5.0	5.0	107	0.0	0.0	96	1440.0							PROJECT MANAGER: N. Avery						
																							DRAWN BY: T. Guazzoni						
																							DESIGNED BY: D. Crosslev						
																						CHECKED BY: S. Menard							
																							SHEET 43 OF 80						

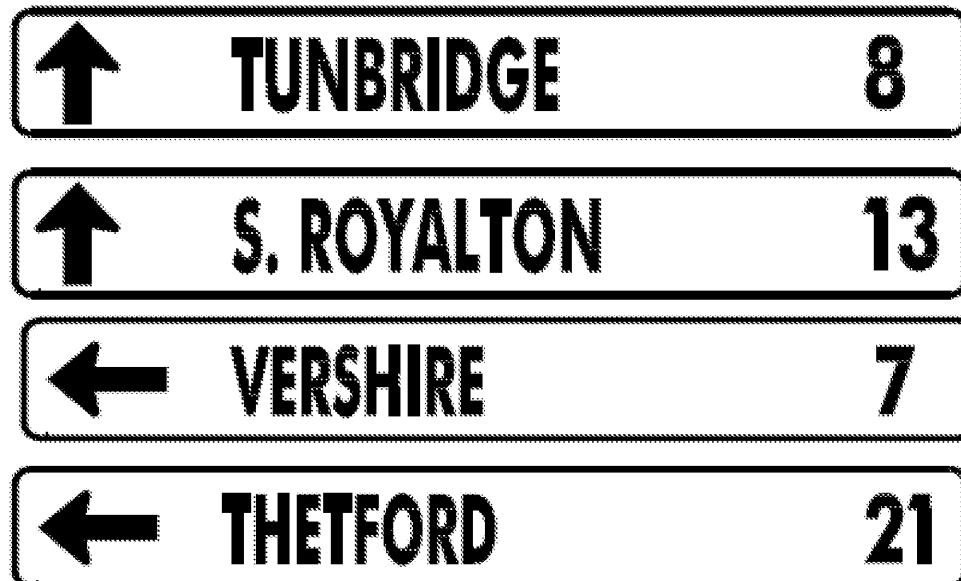
DIRECTION	MILEPOINT	LOCATION CODE (SHEET 2)	SIGN CODE	WIDTH (IN)	HEIGHT (IN)	SHEETING REMARKS	SIGN LEGEND	NEW SIGNS		EXISTING SIGNS				EXIST POST		NUMBER OF NEW POSTS	SQUARE STEEL (IN)			TUBULAR STEEL Ø (IN)				SIGN FRAME REQUIRED	REMARKS	SIGN DETAIL			
								"A"	"B"	RETAIN	SALVAGE FROM	SALVAGE TO	REMOVE	RETAIN	REMOVE		1.75	2.00	2.50	FOUNDATION	3.00	3.50	4.00			5.00	DETAIL IN SHS	DETAIL ON SHEET NUMBER	DETAIL ON STD SHEET NUMBER
																	(LB / FT)				(LB / FT)								
																	1.88	2.42	3.35		7.60	9.00	10.80			14.60			
CHELSEA VT 110						FY-FLUORESCENT YELLOW FYG-FLUORESCENT YELLOW GREEN																"SHS"-STANDARD HIGHWAY SIGNS							
			D R1-1	30	30			6.25								1		X						X					
NB	3.686		A W1-6	48	24								1		X														
			A W1-6	48	24			8.00								2		X						X					
NB	3.690		B W1-6	48	24								1		X														
			B W1-6	48	24			8.00								2		X						X					
NB	3.691		C R1-1	24	24		STOP			1				X										UPPER VILLAGE RD FORK TH-2					
NB	3.700		D R1-1	24	24								1		X									UPPER VILLAGE RD FORK TH-2					
			D R1-1	30	30			6.25								1		X						X					
NB	3.728		A M3-1S	24	12		NORTH			1				X															
			A M1-5	30	24		VERMONT 110			1																			
NB	3.797		A R2-1	24	30		SPEED LIMIT 40			1				X															
NB	3.938		A W5-2	30	30		NARROW BRIDGE 				1				X														
NB	3.990		A W5-2	30	30							1				1		X						INSTALL 250' +/- NORTH OF ORIGINAL SIGN LOCATION	X				
NB	4.042		A OM-3R	12	36							1		X															
			A OM-3R	12	36			3.00								1		X						X					
SIGN SUMMARY SHEET						SHEET TOTALS	31.50	0.00	4	1	1	4	0	0	8	120							PROJECT NAME: Royalton-Barre Town VT110						
							SF	SF	EA	EA	EA	EA	EA	EA	EA		FT					PROJECT NUMBER: STPG SIGN(23)							
																								FILE NAME: Chelsea.xls					
VERMONT AGENCY OF TRANSPORTATION						TOWN TOTALS	539.5	0.0	59.0	5.0	5.0	107	0.0	0.0	96	1440.0							PLOT DATE: 6/15/2009						
																							DRAWN BY: T. Guazzoni						
																							DESIGNED BY: D. Crosslev						
																						CHECKED BY: S. Menard							
																						SHEET 44 OF 80							

DIRECTION	MILEPOINT	LOCATION CODE (SHEET 2)	SIGN CODE	WIDTH (IN)	HEIGHT (IN)	SHEETING REMARKS	SIGN LEGEND	NEW SIGNS		EXISTING SIGNS				EXIST POST		NUMBER OF NEW POSTS	SQUARE STEEL (IN)			TUBULAR STEEL Ø (IN)				SIGN FRAME REQUIRED	REMARKS	SIGN DETAIL			
								"A"	"B"	RETAIN	SALVAGE FROM	SALVAGE TO	REMOVE	RETAIN	REMOVE		1.75	2.00	2.50	FOUNDATION	3.00	3.50	4.00			5.00	DETAIL IN SHS	DETAIL ON SHEET NUMBER	DETAIL ON STD SHEET NUMBER
																	(LB / FT)				(LB / FT)								
																	1.88	2.42	3.35		7.60	9.00	10.80			14.60			
CHELSEA VT 110						FY-FLUORESCENT YELLOW FYG-FLUORESCENT YELLOW GREEN																"SHS"-STANDARD HIGHWAY SIGNS							
NB	4.050	B	OM-3L	12	36								1		X														
		B	OM-3L	12	36		3.00							1		X								X					
NB	4.104	A	R2-1	24	30		SPEED LIMIT 50			1				X															
NB	4.385	A	W1-5L	30	30		LEFT WINDING CURVES						1		X														
		A	W13-1	18	18		35 MPH PLAQUE						1										DO NOT REINSTALL ARROW						
		A	W1-5L	30	30			6.25								1		X					INSTALL 475' +/- NORTH OF ORIGINAL SIGN LOCATION						
		A	W13-1	24	24	4.00																		X					
NB	6.670	A	OM-3R	12	36								1		X														
		A	OM-3R	12	36		3.00									1		X							X				
NB	6.680	B	OM-3L	12	36								1		X														
		B	OM-3L	12	36		3.00									1		X							X				
SB	6.690	F	OM-3R	12	36								1		X														
		F	OM-3R	12	36		3.00									1		X											
SB	6.690	E	OM-3L	12	36								1		X														
		E	OM-3L	12	36		3.00									1		X											
SIGN SUMMARY SHEET						SHEET TOTALS	25.25	0.00	1	0	0	7	0	0	6	90							PROJECT NAME: Royalton-Barre Town VT110						
							SF	SF	EA	EA	EA	EA	EA	EA	EA	FT							PROJECT NUMBER: STPG SIGN(23)						
																									FILE NAME: Chelsea.xls				
						VERMONT AGENCY OF TRANSPORTATION	TOWN TOTALS	539.5	0.0	59.0	5.0	5.0	107	0.0	0.0	96	1440.0							PLOT DATE: 6/15/2009					
																						DRAWN BY: T. Guazzoni							
																						CHECKED BY: S. Menard							
																						SHEET 45 OF 80							

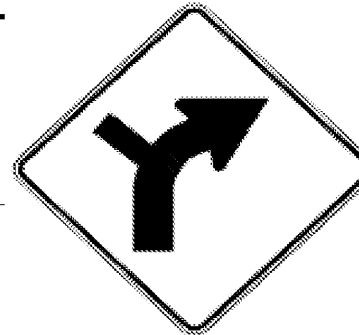
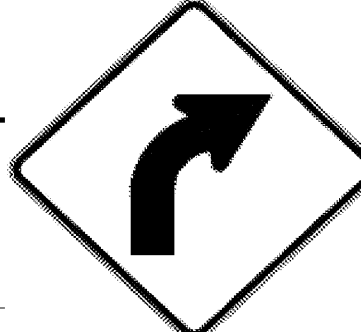
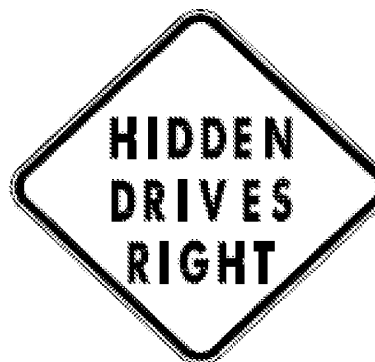
DIRECTION	MILEPOINT	LOCATION CODE (SHEET 2)	SIGN CODE	WIDTH (IN)	HEIGHT (IN)	SHEETING REMARKS	SIGN LEGEND	NEW SIGNS		EXISTING SIGNS				EXIST POST		NUMBER OF NEW POSTS	SQUARE STEEL (IN)			TUBULAR STEEL Ø (IN)					SIGN FRAME REQUIRED	REMARKS	SIGN DETAIL		
								"A"	"B"	RETAIN	SALVAGE FROM	SALVAGE TO	REMOVE	RETAIN	REMOVE		1.75	2.00	2.50	FOUNDATION	3.00	3.50	4.00	5.00			DETAIL IN SHS	DETAIL ON SHEET NUMBER	DETAIL ON STD SHEET NUMBER
																	(LB / FT)				(LB / FT)								
																	1.88	2.42	3.35		7.60	9.00	10.80	14.60					
CHELSEA VT 110						FY-FLUORESCENT YELLOW FYG-FLUORESCENT YELLOW GREEN																"SHS"-STANDARD HIGHWAY SIGNS							
SB	6.493	G	VR-017	24	24								1		X								EDWARDS RD TH-8						
		G	VR-017	24	30		5.00									1	X									E-141			
SB	6.485	H	R1-1	24	24								1		X								EDWARDS RD TH-8						
		H	R1-1	30	30		6.25									1	X						X						
SB	5.030	F	VW-054R	30	30	HIDDEN DRIVE RIGHT 							1		X														
SB	4.980	F	VW-054R	30	30		6.25									1	X						INSTALL 250' +/- SOUTH OF ORIGINAL SIGN LOCATION			E-154			
SB	4.845	F	W1-5L	30	30	WINDING ROAD LEFT				1					X														
		F	W13-1	18	18	35 MPH PLAQUE				1																			
SB	4.790	F	W1-5L	30	30	WINDING ROAD LEFT						1				1	X						INSTALL 250' +/- SOUTH OF ORIGINAL SIGN LOCATION						
		F	W13-1	18	18	35 MPH PLAQUE						1																	
SB	4.231	F	R2-5A	24	30								1		X														
		F	W3-5	36	36		9.00									2	X						X						
SB	4.186	F	VD-018	30	18	CHELSEA TUNBRIDGE 8				1				X															
SB	4.142	F	W5-2	30	30	NARROW BRIDGE					1				X														
SB	4.104	F	R2-1	24	30	SPEED LIMIT 40				1				X										X					
SIGN SUMMARY SHEET							SHEET TOTALS		26.50	0.00	2	3	2	4	0	0	6	90								PROJECT NAME: Royalton-Barre Town VT110			
									SF	SF	EA	EA	EA	EA	EA	EA	EA	FT								PROJECT NUMBER: STPG SIGN(23)			
																										FILE NAME: Chelsea.xls			
																										PROJECT MANAGER: N. Avery			
VERMONT AGENCY OF TRANSPORTATION							TOWN TOTALS		539.5	0.0	59.0	5.0	5.0	107	0.0	0.0	96	1440.0								PLOT DATE: 6/15/2009			
																										DESIGNED BY: D. Crosslev			
																										CHECKED BY: S. Menard			
																										SHEET 46 OF 80			

DIRECTION	MILEPOINT	LOCATION CODE (SHEET 2)	SIGN CODE	WIDTH (IN)	HEIGHT (IN)	SHEETING REMARKS	SIGN LEGEND	NEW SIGNS		EXISTING SIGNS				EXIST POST		NUMBER OF NEW POSTS	SQUARE STEEL (IN)			TUBULAR STEEL Ø (IN)					SIGN FRAME REQUIRED	REMARKS	SIGN DETAIL		
								"A"	"B"	RETAIN	SALVAGE FROM	SALVAGE TO	REMOVE	RETAIN	REMOVE		1.75	2.00	2.50	FOUNDATION	3.00	3.50	4.00	5.00			DETAIL IN SHS	DETAIL ON SHEET NUMBER	DETAIL ON STD SHEET NUMBER
																	(LB / FT)				(LB / FT)								
																	1.88	2.42	3.35		7.60	9.00	10.80	14.60					
CHELSEA VT 110						FY-FLUORESCENT YELLOW FYG-FLUORESCENT YELLOW GREEN																"SHS"-STANDARD HIGHWAY SIGNS							
SB	4.080	F	W5-2	30	30		NARROW BRIDGE					1				1		X						INSTALL 300'+/- SOUTH OF ORIGINAL SIGN LOCATION	X				
SB	4.050	F	OM-3R	12	36		RIGHT OBJECT MARKER			1				X															
SB	4.042	E	OM-3L	12	36		 					1		X															
		E	OM-3L	12	36			3.00								1		X							X				
SB	3.931	F	R2-5A	24	30		 					1		X															
		F	W3-5	36	36			9.00								2		X							X				
SB	3.893	F	W11-6H	30	30		HINGED SNOWMOBILE			1				X															
SB	3.797	F	R2-1	24	30							1		X															
		F	R2-1	30	36			7.50								1		X							X				
SB	3.762	F	W1-1MR	30	30		MODIFIED RIGHT TURN			1				X															
		F	W13-1	18	18		25 MPH PLAQUE			1																			
SB	3.630	F	R2-1	24	30		SPEED LIMIT 30			1				X															
SB	3.574	G	VR-017	24	24							1		X											BOBBIN SHOP RD TH-4				
		G	VR-017	24	30			5.00								1		X									E-141		
SB	3.566	H	R1-1	24	24								1	X										BOBBIN SHOP RD TH-4					
SIGN SUMMARY SHEET							SHEET TOTALS	24.50	0.00	5	0	1	5	0	0	6	90								PROJECT NAME: Royalton-Barre Town VT110				
								SF	SF	EA	EA	EA	EA	EA	EA	EA		FT						PROJECT NUMBER: STPG SIGN(23)					
																											FILE NAME: Chelsea.xls		
							VERMONT AGENCY OF TRANSPORTATION																					PROJECT MANAGER: N. Avery	
							TOWN TOTALS	539.5	0.0	59.0	5.0	5.0	107	0.0	0.0	96	1440.0								DESIGNED BY: D. Crosslev				
																							CHELSEA SHEET 13						
																						PLOT DATE: 6/15/2009							
																						DRAWN BY: T. Guazzoni							
																						CHECKED BY: S. Menard							
																						SHEET 47 OF 80							

DIRECTION	MILEPOINT	LOCATION CODE (SHEET 2)	SIGN CODE	WIDTH (IN)	HEIGHT (IN)	SHEETING REMARKS	SIGN LEGEND	NEW SIGNS		EXISTING SIGNS				EXIST POST		NUMBER OF NEW POSTS	SQUARE STEEL (IN)			TUBULAR STEEL Ø (IN)				SIGN FRAME REQUIRED	REMARKS	SIGN DETAIL			
								"A"	"B"	RETAIN	SALVAGE FROM	SALVAGE TO	REMOVE	RETAIN	REMOVE		1.75	2.00	2.50	FOUNDATION	3.00	3.50	4.00			5.00	DETAIL IN SHS	DETAIL ON SHEET NUMBER	DETAIL ON STD SHEET NUMBER
																	(LB / FT)				(LB / FT)								
																	1.88	2.42	3.35		7.60	9.00	10.80			14.60			
CHELSEA VT 110						FY-FLUORESCENT YELLOW FYG-FLUORESCENT YELLOW GREEN																"SHS"-STANDARD HIGHWAY SIGNS							
			H R1-1	30	30		6.25								1		X							X					
SB	3.410	F	R8-3A	24	24							1		X															
		F	VR-644	24	12							1																	
		F	R8-3A	24	24		4.00							1		X								X					
		F	VR-644	24	12		2.00																	BLACK ON WHITE SHEETING		6			
SB	3.391	F	S1-1YG	30	30					1				X															
		F	W16-9YG	24	10					1																			
SB	3.366	F	R8-3A	24	24					1				X															
		F	M4-6	24	12					1																			
		F	R2-1	24	30					1																			
SB	3.163	F	R2-1	24	30					1				X															
SB	3.110	F	M2-1	21	15							1		X															
		F	M1-5	30	24							1																	
		F	M2-1	21	15		2.19									1		X						GREEN ON WHITE SHEETING	X				
		F	M1-5	30	24		5.00																		E-136B				
SIGN SUMMARY SHEET						SHEET TOTALS	19.44	0.00	6	0	0	4	0	0	3	45							PROJECT NAME: Royalton-Barre Town VT110						
							SF	SF	EA	EA	EA	EA	EA	EA	EA		FT					PROJECT NUMBER: STPG SIGN(23)							
																							FILE NAME: Chelsea.xls						
VERMONT AGENCY OF TRANSPORTATION																						PLOT DATE: 6/15/2009							
																						DRAWN BY: T. Guazzoni							
						TOWN TOTALS	539.5	0.0	59.0	5.0	5.0	107	0.0	0.0	96	1440.0							DESIGNED BY: D. Crosslev						
																						CHECKED BY: S. Menard							
																						SHEET 48 OF 80							
																						CHELSEA SHEET 14							

DIRECTION	MILEPOINT	LOCATION CODE (SHEET 2)	SIGN CODE	WIDTH (IN)	HEIGHT (IN)	SHEETING REMARKS	SIGN LEGEND	NEW SIGNS		EXISTING SIGNS				EXIST POST		NUMBER OF NEW POSTS	SQUARE STEEL (IN)			TUBULAR STEEL Ø (IN)				SIGN FRAME REQUIRED	REMARKS	SIGN DETAIL			
								"A"	"B"	RETAIN	SALVAGE FROM	SALVAGE TO	REMOVE	RETAIN	REMOVE		1.75	2.00	2.50	FOUNDATION	3.00	3.50	4.00			5.00	DETAIL IN SHS	DETAIL ON SHEET NUMBER	DETAIL ON STD SHEET NUMBER
																	(LB / FT)				(LB / FT)								
																	1.88	2.42	3.35		7.60	9.00	10.80			14.60			
CHELSEA VT 110						FY-FLUORESCENT YELLOW FYG-FLUORESCENT YELLOW GREEN															"SHS"-STANDARD HIGHWAY SIGNS								
SB	3.076	F	S1-1YG	30	30		SCHOOL			1				X															
		F	W16-9	24	10		AHEAD			1																			
SB	3.045	F	D1-1A	72	10							1		X															
		F	D1-1A	72	10								1																
		F	D1-1A	72	10								1																
		F	D1-1A	72	10								1																
		F	D1-1A	72	12											2			X						5				
		F	D1-1A	72	12																				5				
		F	D1-1A	72	12																				5				
		F	D1-1A	72	12																				5				
SB	2.910	F	S1-1YG	36	36		SCHOOL			1				X															
		F	W16-7YG	24	12		DIAGONAL ARROW			1																			
SB	2.870	F	M3-3	24	12							1		X															
		F	M1-5	30	24								1																
		F	M3-3	24	12			2.00								1		X						GREEN ON WHITE SHEETING	X				
SIGN SUMMARY SHEET						SHEET TOTALS		26.00	0.00	4	0	0	6	0	0	3	45						PROJECT NAME: Royalton-Barre Town VT110						
								SF	SF	EA	EA	EA	EA	EA	EA	EA	EA	EA	EA	EA	FT					PROJECT NUMBER: STPG SIGN(23)			
																									FILE NAME: Chelsea.xls				
																									PLOT DATE: 6/15/2009				
VERMONT AGENCY OF TRANSPORTATION						TOWN TOTALS		539.5	0.0	59.0	5.0	5.0	107	0.0	0.0	96	1440.0						DRAWN BY: T. Guazzoni						
																								CHECKED BY: S. Menard					
																						SHEET 49 OF 80							

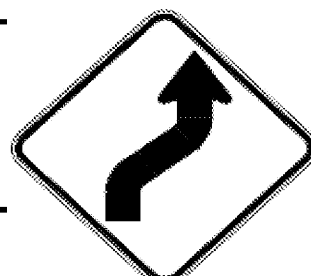
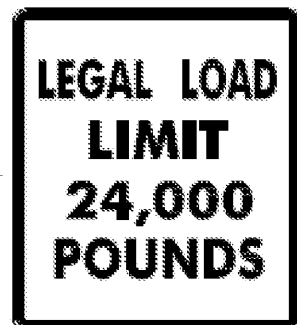
DIRECTION	MILEPOINT	LOCATION CODE (SHEET 2)	SIGN CODE	WIDTH (IN)	HEIGHT (IN)	SHEETING REMARKS	SIGN LEGEND	NEW SIGNS		EXISTING SIGNS				EXIST POST		NUMBER OF NEW POSTS	SQUARE STEEL (IN)			TUBULAR STEEL Ø (IN)					SIGN FRAME REQUIRED	REMARKS	SIGN DETAIL			
								"A"	"B"	RETAIN	SALVAGE FROM	SALVAGE TO	REMOVE	RETAIN	REMOVE		1.75	2.00	2.50	FOUNDATION	3.00	3.50	4.00	5.00			DETAIL IN SHS	DETAIL ON SHEET NUMBER	DETAIL ON STD SHEET NUMBER	
																	(LB / FT)				(LB / FT)									
																	1.88	2.42	3.35		7.60	9.00	10.80	14.60						
CHELSEA VT 110						FY-FLUORESCENT YELLOW FYG-FLUORESCENT YELLOW GREEN																"SHS"-STANDARD HIGHWAY SIGNS								
			F M1-5	30	24			5.00																		E-136B				
SB	2.780		F R2-1	24	30		SPEED LIMIT 30			1				X																
SB	2.740		F D2-1	72	10		TUNBRIDGE8 S. ROYALTON13					1		X																
			F D2-1	72	10							1														5				
			F D2-1	72	12			6.00								2	X													
			F D2-1	72	12			6.00																			5			
SB	2.673		G VR-017	24	24		LEGAL LOAD LIMIT 24,000 POUNDS					1		X										BEACON HILL RD TH-43						
			G VR-017	24	30			5.00								1	X										E-141			
SB	2.665		H R1-1	24	24		STOP					1		X										BEACON HILL RD TH-43						
			H R1-1	30	30			6.25								1	X							X						
SB	2.626		F W11-2YG	30	30		PEDESTRIAN			1				X																
			F W16-9YG	24	10		AHEAD			1																				
SB	2.538		F R2-1	24	30		SPEED LIMIT 40			1				X																
SB	2.508		F W11-2YG	30	30		PEDESTRIAN			1				X																
			F W16-7YG	24	12		DOWN ARROW			1																				
SIGN SUMMARY SHEET							SHEET TOTALS	28.25	0.00	6	0	0	4	0	0	4	60								PROJECT NAME: Royalton-Barre Town VT110					
								SF	SF	EA	EA	EA	EA	EA	EA	EA		FT						PROJECT NUMBER: STPG SIGN(23)						
																												FILE NAME: Chelsea.xls		
							VERMONT AGENCY OF TRANSPORTATION																					PLOT DATE: 6/15/2009		
							TOWN TOTALS	539.5	0.0	59.0	5.0	5.0	107	0.0	0.0	96	1440.0								DESIGNED BY: D. Crosslev					
																								DRAWN BY: T. Guazzoni						
																							CHECKED BY: S. Menard							
																							SHEET 50 OF 80							

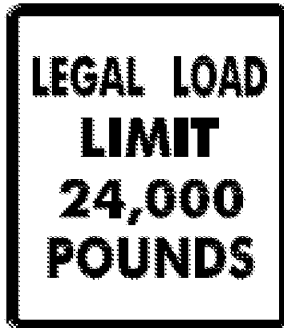
DIRECTION	MILEPOINT	LOCATION CODE (SHEET 2)	SIGN CODE	WIDTH (IN)	HEIGHT (IN)	SHEETING REMARKS	SIGN LEGEND	NEW SIGNS		EXISTING SIGNS				EXIST POST		NUMBER OF NEW POSTS	SQUARE STEEL (IN)			TUBULAR STEEL Ø (IN)					SIGN FRAME REQUIRED	REMARKS	SIGN DETAIL			
								"A"	"B"	RETAIN	SALVAGE FROM	SALVAGE TO	REMOVE	RETAIN	REMOVE		1.75	2.00	2.50	FOUNDATION	3.00	3.50	4.00	5.00			DETAIL IN SHS	DETAIL ON SHEET NUMBER	DETAIL ON STD SHEET NUMBER	
																	(LB / FT)				(LB / FT)									
																	1.88	2.42	3.35		7.60	9.00	10.80	14.60						
CHELSEA VT 110						FY-FLUORESCENT YELLOW FYG-FLUORESCENT YELLOW GREEN																"SHS"-STANDARD HIGHWAY SIGNS								
SB	2.480	F	W11-1	30	30							1		X																
			W11-1	30	30		6.25							1		X								X						
SB	2.420	F	VD-062B	72	16		BUSINESS SIGN			1				X																
SB	2.356	F	W1-2R	30	30		MODIFIED RIGHT CURVE						1		X															
SB	2.320	F	S3-1	30	30								1		X															
		F	W1-2R	30	30		6.25							1		X								X						
SB	2.280	F	S3-1	30	30			6.25								1		X						INSTALL 200' +/- SOUTH OF ORIGINAL SIGN LOCATION	X					
SB	1.990	F	R2-1	24	30		SPEED LIMIT 50			1				X																
SB	1.910	F	W1-2 R	30	30		CURVE RIGHT						1		X															
		F	W13-1	24	24		40 MPH PLAQUE						1																	
SB	1.870	F	W1- 2R	30	30	 		6.25								1		X						INSTALL 200' +/- SOUTH OF ORIGINAL SIGN LOCATION	X					
		F	W13-1	24	24		4.00																	X						
SB	1.493	F	VW-133R	30	30		HIDDEN DRIVES RIGHT						1		X															
SB	1.460	F	VW-054A	30	30			6.25								1		X						INSTALL 150' +/- SOUTH OF ORIGINAL SIGN LOCATION			E-153			
SB	1.320	F	W1-2L	30	30			CURVE LEFT						1		X														
SIGN SUMMARY SHEET						SHEET TOTALS		35.25	0.00	2	0	0	7	0	0	5	75								PROJECT NAME: Royalton-Barre Town VT110					
								SF	SF	EA	EA	EA	EA	EA	EA	EA	FT								PROJECT NUMBER: STPG SIGN(23)					
																											FILE NAME: Chelsea.xls			
																											PLOT DATE: 6/15/2009			
VERMONT AGENCY OF TRANSPORTATION																							DRAWN BY: T. Guazzoni							
																										CHECKED BY: S. Menard				
																										SHEET 51 OF 80				
TOWN TOTALS						539.5	0.0	59.0	5.0	5.0	107	0.0	0.0	96	1440.0															

DIRECTION	MILEPOINT	LOCATION CODE (SHEET 2)	SIGN CODE	WIDTH (IN)	HEIGHT (IN)	SHEETING REMARKS	SIGN LEGEND	NEW SIGNS		EXISTING SIGNS				EXIST POST		NUMBER OF NEW POSTS	SQUARE STEEL (IN)			TUBULAR STEEL Ø (IN)				SIGN FRAME REQUIRED	REMARKS	SIGN DETAIL			
								"A"	"B"	RETAIN	SALVAGE FROM	SALVAGE TO	REMOVE	RETAIN	REMOVE		1.75	2.00	2.50	FOUNDATION	3.00	3.50	4.00			5.00	DETAIL IN SHS	DETAIL ON SHEET NUMBER	DETAIL ON STD SHEET NUMBER
																	(LB / FT)				(LB / FT)								
																	1.88	2.42	3.35		7.60	9.00	10.80			14.60			
CHELSEA VT 110						FY-FLUORESCENT YELLOW FYG-FLUORESCENT YELLOW GREEN																"SHS"-STANDARD HIGHWAY SIGNS							
SB	1.260	F	W1-2L	30	30			6.25								1		X						INSTALL 300'+/- SOUTH OF ORIGINAL SIGN LOCATION	X				
		F	W13-1	24	24			4.00																	X				
SB	0.830	F	D1-1A	72	10		 					1		X															
		F	D1-1A	72	12			6.00								2		X								5			
SB	0.784	G	VR-017	24	24		LEGAL LOAD LIMIT 24,000 LBS 					1		X										EAST RANDOLPH RD TH-1					
SB	0.770	G	VR-017	24	30			5.00								1		X								E-141			
SB	0.776	H	R1-1	24	24							1		X										EAST RANDOLPH RD TH-1					
		H	R1-1	30	30			6.25								1		X						ISLAND	X				
SB	0.776	G	R1-2	30	30		YIELD			1				X										ISLAND					
SB	0.768	H	R1-1	24	24							1		X										EAST RANDOLPH RD TH-1					
		H	R1-1	30	30			6.25								1		X							X				
SB	0.740	F	M3-3	24	12							1		X															
		F	M1-5	30	24								0																
		F	M3-3	24	12			2.00								1		X							GREEN ON WHITE SHEETING	X			
		F	M1-5	30	24			5.00																			E-136B		
SIGN SUMMARY SHEET						SHEET TOTALS		40.75	0.00	1	0	0	6	0	0	7	105							PROJECT NAME: Royalton-Barre Town VT110					
								SF	SF	EA	EA	EA	EA	EA	EA	EA		FT						PROJECT NUMBER: STPG SIGN(23)					
						TOWN TOTALS		539.5	0.0	59.0	5.0	5.0	107	0.0	0.0	96	1440.0							FILE NAME: Chelsea.xls PROJECT MANAGER: N. Avery DESIGNED BY: D. Crossley CHELSEA SHEET 18					
VERMONT AGENCY OF TRANSPORTATION												5											PLOT DATE: 6/15/2009 DRAWN BY: T. Guazzoni CHECKED BY: S. Menard SHEET 52 OF 80						

DIRECTION	MILEPOINT	LOCATION CODE (SHEET 2)	SIGN CODE	WIDTH (IN)	HEIGHT (IN)	SHEETING REMARKS	SIGN LEGEND	NEW SIGNS		EXISTING SIGNS				EXIST POST		NUMBER OF NEW POSTS	SQUARE STEEL (IN)			TUBULAR STEEL Ø (IN)				SIGN FRAME REQUIRED	REMARKS	SIGN DETAIL			
								"A"	"B"	RETAIN	SALVAGE FROM	SALVAGE TO	REMOVE	RETAIN	REMOVE		1.75	2.00	2.50	FOUNDATION	3.00	3.50	4.00			5.00	DETAIL IN SHS	DETAIL ON SHEET NUMBER	DETAIL ON STD SHEET NUMBER
																	(LB / FT)				(LB / FT)								
																	1.88	2.42	3.35		7.60	9.00	10.80			14.60			
CHELSEA VT 110						FY-FLUORESCENT YELLOW FYG-FLUORESCENT YELLOW GREEN																"SHS"-STANDARD HIGHWAY SIGNS							
SB	0.660	F	W11-6	30	30							1		X															
		F	W11-6 H	30	30		6.25							1	X									X					
SB	0.640	F	OM-3 R	18	36							1		X															
		E	OM-3 R	12	36		3.00							1	X									X					
SB	0.630	F	OM-3 L	18	36							1		X															
		E	OM-3 L	12	36		3.00							1	X									X					
SB	0.600	F	R2-1	24	30	SPEED LIMIT 50			1				X																
SB	0.110	F	W1-3 L	30	30	REVERSE CURVE LEFT						1		X															
		F	W13-1	18	18	35 MPH PLAQUE						1																	
SB	0.050	F	W1-3 L	30	30		6.25								1	X							INSTALL 300' +/- SOUTH OF ORIGINAL SIGN LOCATION	X					
		F	W13-1	24	24		4.00																	X					
SB	0.005	F	W1-6	48	24							1		X															
		F	W1-6	48	24		8.00								1	X								X					
SIGN SUMMARY SHEET						SHEET TOTALS	30.50	0.00	1	0	0	6	0	0	5	75						PROJECT NAME: Royalton-Barre Town VT110							
							SF	SF	EA	EA	EA	EA	EA	EA	EA	FT					PROJECT NUMBER: STPG SIGN(23)								
																					FILE NAME: Chelsea.xls								
																					PLOT DATE: 6/15/2009								
VERMONT AGENCY OF TRANSPORTATION						TOWN TOTALS	539.5	0.0	59.0	5.0	5.0	107	0.0	0.0	96	1440.0						DRAWN BY: T. Guazzoni							
																				DESIGNED BY: D. Crosslev									
																				CHECKED BY: S. Menard									
																				SHEET 53 OF 80									

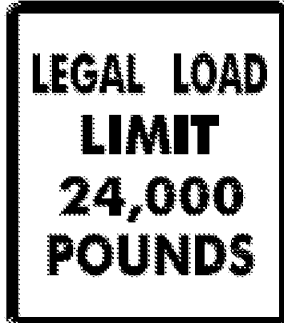
DIRECTION	MILEPOINT	LOCATION CODE (SHEET 2)	SIGN CODE	WIDTH (IN)	HEIGHT (IN)	SHEETING REMARKS	SIGN LEGEND	NEW SIGNS		EXISTING SIGNS				EXIST POST		NUMBER OF NEW POSTS	SQUARE STEEL (IN)			TUBULAR STEEL Ø (IN)				SIGN FRAME REQUIRED	REMARKS	SIGN DETAIL			
								"A"	"B"	RETAIN	SALVAGE FROM	SALVAGE TO	REMOVE	RETAIN	REMOVE		1.75	2.00	2.50	FOUNDATION	3.00	3.50	4.00			5.00	DETAIL IN SHS	DETAIL ON SHEET NUMBER	DETAIL ON STD SHEET NUMBER
																	(LB / FT)				(LB / FT)								
																	1.88	2.42	3.35		7.60	9.00	10.80			14.60			
WASHINGTON VT 110							FY-FLUORESCENT YELLOW FYG-FLUORESCENT YELLOW GREEN															"SHS"-STANDARD HIGHWAY SIGNS							
NB	0.000	C	VD-024	60	7.5		WASHINGTON CHESEA 1100 0915 0000 1100 0904 0696					1		X															
		C	VD-024	72	10			5.00								2		X									4		
		C	VD-700	6	10			0.42																					
		C	VD-700	6	10			0.42																					
NB	0.210	A	W2-2 L	30	30		SIDE ROAD LEFT						1		X														
NB	0.270	A	W2-2 L	30	30			6.25								1		X						INSTALL 300'+/- NORTH OF ORIGINAL SIGN LOCATION	X				
NB	0.310	A	D1-1A	54	7.5		WILLIAMSTOWN 7					1		X															
		A	D1-1A	72	12			6.00								2		X								5			
NB	0.350	A	VW-054R	30	30		HIDDEN DRIVE RIGHT						1		X														
NB	0.500	A	VW-054R	30	30		HIDDEN DRIVE RIGHT	6.25								1		X						INSTALL 200'+/- NORTH OF ORIGINAL SIGN LOCATION			E-154		
NB	0.680	A	W1-5R	30	30		35 M.P.H. NEXT 3 MILES	6.25								2		X						INSTALL 200'+/- SOUTH OF STOP SIGN FOR POOR FARM RD.	X				
			W13-1	24	24			4.00																X					
			W7-3A	24	18			3.00																X					
NB	0.730	A	W1-4R	30	30		RIGHT REVERSE CURVE						1		X														
		A	W13-1	18	18		35 MPH PLAQUE						1																
SIGN SUMMARY SHEET							SHEET TOTALS	37.59	0.00	0	0	0	6	0	0	8	120							PROJECT NAME: Royalton-Barre Town VT110					
								SF	SF	EA	EA	EA	EA	EA	EA	EA		FT					PROJECT NUMBER: STPG SIGN(23)						
																										FILE NAME: Washington.xls			
VERMONT AGENCY OF TRANSPORTATION							TOWN TOTALS	320.1	0.0	42.0	3.0	3.0	66	2.0	0.0	73	1095.0							PLOT DATE: 6/15/2009					
																										DRAWN BY: T. Guazzoni			
																						CHECKED BY: S. Menard							
																							WASHINGTON SHEET 1						
																							SHEET 54 OF 80						

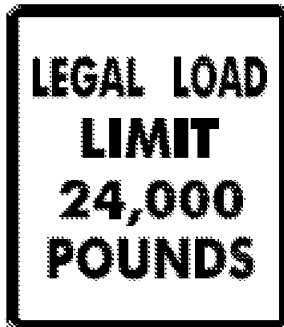
DIRECTION	MILEPOINT	LOCATION CODE (SHEET 2)	SIGN CODE	WIDTH (IN)	HEIGHT (IN)	SHEETING REMARKS	SIGN LEGEND	NEW SIGNS		EXISTING SIGNS				EXIST POST		NUMBER OF NEW POSTS	SQUARE STEEL (IN)			TUBULAR STEEL Ø (IN)					SIGN FRAME REQUIRED	REMARKS	SIGN DETAIL		
								"A"	"B"	RETAIN	SALVAGE FROM	SALVAGE TO	REMOVE	RETAIN	REMOVE		1.75	2.00	2.50	FOUNDATION	3.00	3.50	4.00	5.00			DETAIL IN SHS	DETAIL ON SHEET NUMBER	DETAIL ON STD SHEET NUMBER
																	(LB / FT)				(LB / FT)								
																	1.88	2.42	3.35		7.60	9.00	10.80	14.60					
WASHINGTON VT 110							FY-FLUORESCENT YELLOW FYG-FLUORESCENT YELLOW GREEN															"SHS"-STANDARD HIGHWAY SIGNS							
NB	1.110	A	W1-4R	30	30		RIGHT REVERSE CURVE								X														
		A	W13-1	24	24		35 MPH PLAQUE																						
NB	1.130	A	W1-4R	30	30			6.25								1		X						INSTALL 100'+/- NORTH OF ORIGINAL SIGN LOCATION	X				
NB	1.395	A	OM-3R	12	36		VERTICAL OBJECT MARKER								X														
NB	1.405	B	OM-3L	12	36		VERTICAL OBJECT MARKER								X														
NB	1.661	C	VR-017	24	30										X									SKY ACRES RD TH-29					
		C	VR-017	24	30			5.00								1		X								E-141			
NB	1.669	D	R1-1	30	30										X									SKY ACRES RD TH-29					
		D	R1-1	30	30			6.25								1		X							X				
NB	1.782	A	OM-3R	12	36										X														
		A	OM-3R	12	36			3.00								1		X							X				
NB	1.790	B	OM-3L	12	36										X														
		B	OM-3L	12	36			3.00								1		X							X				
NB	2.347	A	OM-3R	12	36		VERTICAL OBJECT MARKER								X														
NB	2.353	B	OM-3L	12	36		VERTICAL OBJECT MARKER								X														
SIGN SUMMARY SHEET							SHEET TOTALS	23.50	0.00	0	0	0	10	0	0	5	75								PROJECT NAME: Royalton-Barre Town VT110				
								SF	SF	EA	EA	EA	EA	EA	EA	EA	FT								PROJECT NUMBER: STPG SIGN(23)				
																									FILE NAME: Washington.xls				
																									PLOT DATE: 6/15/2009				
VERMONT AGENCY OF TRANSPORTATION							TOWN TOTALS	320.1	0.0	42.0	3.0	3.0	66	2.0	0.0	73	1095.0								PROJECT MANAGER: N. Avery				
																								DRAWN BY: T. Guazzoni					
																								DESIGNED BY: D. Crosslev					
																								CHECKED BY: S. Menard					
																								WASHINGTON SHEET 2					
																								SHEET 55 OF 80					

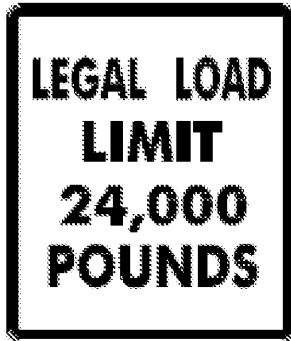
DIRECTION	MILEPOINT	LOCATION CODE (SHEET 2)	SIGN CODE	WIDTH (IN)	HEIGHT (IN)	SHEETING REMARKS	SIGN LEGEND	NEW SIGNS		EXISTING SIGNS				EXIST POST		NUMBER OF NEW POSTS	SQUARE STEEL (IN)			TUBULAR STEEL Ø (IN)					SIGN FRAME REQUIRED	REMARKS	SIGN DETAIL			
								"A"	"B"	RETAIN	SALVAGE FROM	SALVAGE TO	REMOVE	RETAIN	REMOVE		1.75	2.00	2.50	FOUNDATION	3.00	3.50	4.00	5.00			DETAIL IN SHS	DETAIL ON SHEET NUMBER	DETAIL ON STD SHEET NUMBER	
																	(LB / FT)				(LB / FT)									
																	1.88	2.42	3.35		7.60	9.00	10.80	14.60						
WASHINGTON VT 110							FY-FLUORESCENT YELLOW FYG-FLUORESCENT YELLOW GREEN															"SHS"-STANDARD HIGHWAY SIGNS								
NB	3.884	C	VR-017	24	24		LEGAL LOAD LIMIT 24000 LBS			1				X																
NB	3.892	D	R1-1	24	24		STOP			1				X																
NB	4.524	A	W1-4R	30	30		REVERSE CURVE RIGHT			1				X																
NB	4.762	C	VR-017	24	24							1		X										CHENEY RD TH-30						
		C	VR-017	24	30			5.00								1		X									E-141			
NB	4.770	D	R1-1	24	24							1		X										CHENEY RD TH-30						
		D	R1-1	30	30			6.25								1		X							X					
NB	4.775	A	W1-6	48	24		<=== LEFT LARGE ARROW			1				X																
NB	4.792	B	W1-6	48	24		RIGHT ===> LARGE ARROW			1				X																
NB	5.020	A	W1-5R	30	30		RIGHT WINDING CURVES			1				X																
		A	W7-3A	24	18		NEXT 1/2 MILE			1																				
NB	5.235	A	W3-5	36	36		SPEED REDUCTION SPEED LIMIT 40			1				X																
NB	5.270	A	VW-202	30	30		TRUCKS ENTERING			1				X																
NB	5.320	A	R2-1	24	30							1		X																
		A	R2-1	30	36			7.50								1		X									6			
SIGN SUMMARY SHEET							SHEET TOTALS	18.75	0.00	9	0	0	3	0	0	3	45								PROJECT NAME: Royalton-Barre Town VT110					
								SF	SF	EA	EA	EA	EA	EA	EA	EA		FT						PROJECT NUMBER: STPG SIGN(23)						
																												FILE NAME: Washington.xls		
							VERMONT AGENCY OF TRANSPORTATION																					PLOT DATE: 6/15/2009		
							TOWN TOTALS	320.1	0.0	42.0	3.0	3.0	66	2.0	0.0	73	1095.0								DESIGNED BY: D. Crosslev					
																								DRAWN BY: T. Guazzoni						
																								CHECKED BY: S. Menard						
																								WASHINGTON SHEET 3						
																								SHEET 56 OF 80						

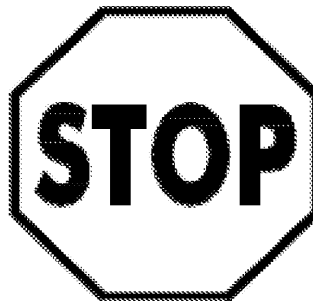
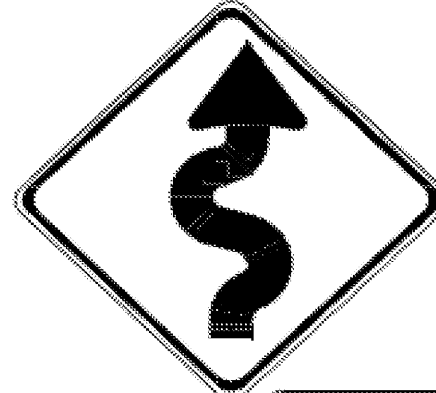
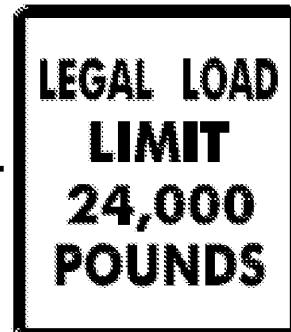
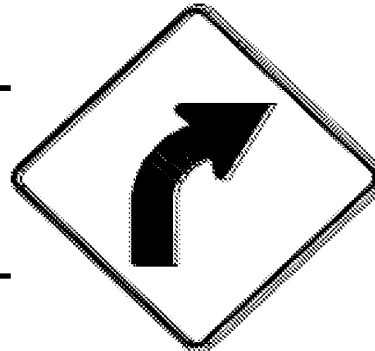
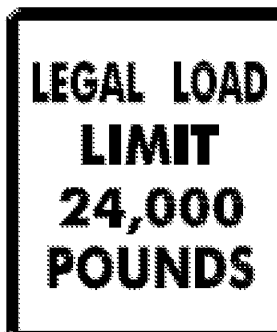
DIRECTION	MILEPOINT	LOCATION CODE (SHEET 2)	SIGN CODE	WIDTH (IN)	HEIGHT (IN)	SHEETING REMARKS	SIGN LEGEND	NEW SIGNS		EXISTING SIGNS				EXIST POST		NUMBER OF NEW POSTS	SQUARE STEEL (IN)			TUBULAR STEEL Ø (IN)				SIGN FRAME REQUIRED	REMARKS	SIGN DETAIL			
								"A"	"B"	RETAIN	SALVAGE FROM	SALVAGE TO	REMOVE	RETAIN	REMOVE		1.75	2.00	2.50	FOUNDATION	3.00	3.50	4.00			5.00	DETAIL IN SHS	DETAIL ON SHEET NUMBER	DETAIL ON STD SHEET NUMBER
																	(LB / FT)				(LB / FT)								
																	1.88	2.42	3.35		7.60	9.00	10.80			14.60			
WASHINGTON VT 110							FY-FLUORESCENT YELLOW FYG-FLUORESCENT YELLOW GREEN															"SHS"-STANDARD HIGHWAY SIGNS							
NB	5.360	A	W11-6H	30	30		SNOWMOBILE HINGED			1				X															
NB	5.370	B	W1-6	48	24		LARGE ARROW RIGHT			1				X															
NB	5.379	C	VR-017	24	30			5.00				1		X	1	X							TURNPIKE RD TH-29			E-141			
		C	VR-017	24	30																								
NB	5.387	D	R1-1	30	30			06.25					06.25		X								TURNPIKE RD TH-29						
		D	R1-1	30	30																								
NB	5.530	A	VD-018	30	18		WASHINGTON EAST BARRE 4			1				X															
NB	5.610	A	S3-1	30	30		SCHOOL BUS STOP AHEAD			1				X															
NB	5.650	A	R2-1	24	30			7.50				1		X	1	X									6				
		A	R2-1	30	36																								
NB	5.690	A	D1-1A	72	12		WEST CORINTH 7 ---->			1				X															
NB	5.720	C	VR-017	24	30			5.00				1		X	1	X							WEST CORINTH RD TH-1			E-141			
		C	VR-017	24	30																								
NB	5.728	D	R1-1	30	30			6.25					1		X								WEST CORINTH RD TH-1						
		D	R1-1	30	30																								
SIGN SUMMARY SHEET							SHEET TOTALS				30.00	0.00	5	0	0	5	0	0	5	75			PROJECT NAME: Royalton-Barre Town VT110						
											SF	SF	EA	EA	EA	EA	EA	EA	EA		FT	PROJECT NUMBER: STPG SIGN(23)							
											23.75					4								FILE NAME: Washington.xls					
VERMONT AGENCY OF TRANSPORTATION							TOWN TOTALS				320.1	0.0	42.0	3.0	3.0	66	2.0	0.0	73	1095.0			PLOT DATE: 6/15/2009						
																										DRAWN BY: T. Guazzoni			
																										CHECKED BY: S. Menard			
																										WASHINGTON SHEET 4			
																										SHEET 57 OF 80			

DIRECTION	MILEPOINT	LOCATION CODE (SHEET 2)	SIGN CODE	WIDTH (IN)	HEIGHT (IN)	SHEETING REMARKS	SIGN LEGEND	NEW SIGNS		EXISTING SIGNS				EXIST POST		NUMBER OF NEW POSTS	SQUARE STEEL (IN)			TUBULAR STEEL Ø (IN)					SIGN FRAME REQUIRED	REMARKS	SIGN DETAIL			
								"A"	"B"	RETAIN	SALVAGE FROM	SALVAGE TO	REMOVE	RETAIN	REMOVE		1.75	2.00	2.50	FOUNDATION	3.00	3.50	4.00	5.00			DETAIL IN SHS	DETAIL ON SHEET NUMBER	DETAIL ON STD SHEET NUMBER	
																	(LB / FT)				(LB / FT)									
																	1.88	2.42	3.35		7.60	9.00	10.80	14.60						
WASHINGTON VT 110							FY-FLUORESCENT YELLOW FYG-FLUORESCENT YELLOW GREEN															"SHS"-STANDARD HIGHWAY SIGNS								
NB	5.770	A	S1-1YG	30	30		SCHOOL			1				X																
		A	W16-9YG	24	12		AHEAD			1																				
NB	5.820	A	D1-1E	72	20		WASHINGTON ---> VILLAGE SCHOOL			1				X																
NB	5.852	A	VR-345	24	30		NO PARKING HERE TO CORNER			1				1																
		B	VR-345	24	30		NO PARKING HERE TO CORNER			1																				
NB	5.858	A	S1-1YG	30	30		SCHOOL			1				1																
		A	W16-7YG	24	12		DIAGONAL ARROW			1																				
NB	5.858	C	VR-017	24	30		LEGAL LOAD LIMIT 24,000 POUNDS						1		X									SCHOOL LANE TH-71						
		C	VR-017	24	30			5.00								1		X									E-141			
NB	5.866	D	R1-1	30	30		STOP						1		X									SCHOOL LANE TH-71						
		D	R1-1	30	30			6.25								1		X						X						
NB	6.210	A	R2-1	24	30		SPEED LIMIT 40 SPEED LIMIT 40						1	X																
		A	R2-1	24	30			5.00								1		X								6				
NB	6.504	C	VR-017	24	24		LEGAL LOAD LIMIT 24,000 POUNDS						1		X									CREAMERY RD TH-7						
		C	VR-017	24	30			5.00								1		X									E-141			
SIGN SUMMARY SHEET							SHEET TOTALS	21.25	0.00	7	0	0	4	2	0	4	60								PROJECT NAME: Royalton-Barre Town VT110					
								SF	SF	EA	EA	EA	EA	EA	EA	EA		FT						PROJECT NUMBER: STPG SIGN(23)						
																												FILE NAME: Washington.xls		
																												PLOT DATE: 6/15/2009		
VERMONT AGENCY OF TRANSPORTATION							TOWN TOTALS	320.1	0.0	42.0	3.0	3.0	66	2.0	0.0	73	1095.0								DRAWN BY: T. Guazzoni					
																												CHECKED BY: S. Menard		
																							DESIGNED BY: D. Crosslev							
																								WASHINGTON SHEET 5						
																								SHEET 58 OF 80						

DIRECTION	MILEPOINT	LOCATION CODE (SHEET 2)	SIGN CODE	WIDTH (IN)	HEIGHT (IN)	SHEETING REMARKS	SIGN LEGEND	NEW SIGNS		EXISTING SIGNS				EXIST POST		NUMBER OF NEW POSTS	SQUARE STEEL (IN)			TUBULAR STEEL Ø (IN)				SIGN FRAME REQUIRED	REMARKS	SIGN DETAIL			
								"A"	"B"	RETAIN	SALVAGE FROM	SALVAGE TO	REMOVE	RETAIN	REMOVE		1.75	2.00	2.50	FOUNDATION	3.00	3.50	4.00			5.00	DETAIL IN SHS	DETAIL ON SHEET NUMBER	DETAIL ON STD SHEET NUMBER
																	(LB / FT)				(LB / FT)								
																	1.88	2.42	3.35		7.60	9.00	10.80			14.60			
WASHINGTON VT 110							FY-FLUORESCENT YELLOW FYG-FLUORESCENT YELLOW GREEN															"SHS"-STANDARD HIGHWAY SIGNS							
NB	6.512	D	R1-1	30	30										X								CREAMERY RD TH-7						
		D	R1-1	30	30			6.25									1		X						X				
NB	6.530	A	R2-1	24	30		SPEED LIMIT 40			1				X															
NB	6.610	A	R2-1	24	30		SPEED LIMIT 50			1				X															
NB	6.790	A	S3-1	30	30										X														
		A	S3-1	30	30			6.25									1		X						X				
SB	6.700	F	W3-5	36	36		SPEED REDUCTION SPEED LIMIT 40			1				X															
SB	6.610	F	R2-1	24	30										X														
		F	R2-1	30	36			7.50									1		X							6			
SB	6.475	G	VR-017	24	24										X									LOWERY RD TH-4					
		G	VR-017	24	30			5.00									1		X							E-141			
SB	6.467	H	R1-1	24	24										X									LOWERY RD TH-4					
		H	R1-1	30	30			6.25									1		X						X				
SB	6.450	F	R2-1	24	30		SPEED LIMIT 40			1				X															
SB	6.310	F	VD-018	30	18		WASHINGTON CHELSEA 9								X														
SIGN SUMMARY SHEET							SHEET TOTALS	31.25	0.00	5	0	0	5	0	0	5	75							PROJECT NAME: Royalton-Barre Town VT110					
								SF	SF	EA	EA	EA	EA	EA	EA	EA		FT					PROJECT NUMBER: STPG SIGN(23)						
																										FILE NAME: Washington.xls			
																										PLOT DATE: 6/15/2009			
VERMONT AGENCY OF TRANSPORTATION							TOWN TOTALS	320.1	0.0	42.0	3.0	3.0	66	2.0	0.0	73	1095.0							DRAWN BY: T. Guazzoni					
																									CHECKED BY: S. Menard				
																									WASHINGTON SHEET 6				
																									SHEET 59 OF 80				

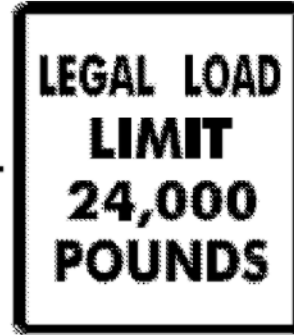
DIRECTION	MILEPOINT	LOCATION CODE (SHEET 2)	SIGN CODE	WIDTH (IN)	HEIGHT (IN)	SHEETING REMARKS	SIGN LEGEND	NEW SIGNS		EXISTING SIGNS				EXIST POST		NUMBER OF NEW POSTS	SQUARE STEEL (IN)			TUBULAR STEEL Ø (IN)					SIGN FRAME REQUIRED	REMARKS	SIGN DETAIL					
								"A"	"B"	RETAIN	SALVAGE FROM	SALVAGE TO	REMOVE	RETAIN	REMOVE		1.75	2.00	2.50	FOUNDATION	3.00	3.50	4.00	5.00			DETAIL IN SHS	DETAIL ON SHEET NUMBER	DETAIL ON STD SHEET NUMBER			
																	(LB / FT)				(LB / FT)											
																	1.88	2.42	3.35		7.60	9.00	10.80	14.60								
WASHINGTON VT 110							FY-FLUORESCENT YELLOW FYG-FLUORESCENT YELLOW GREEN															"SHS"-STANDARD HIGHWAY SIGNS										
SB	6.210	F	R2-1	24	30								1		X																	
		F	R2-1	30	36			7.50									1		X							6						
SB	5.930	F	S1-1YG	30	30		SCHOOL			1				X																		
		F	W16-9YG	24	12		AHEAD			1																						
SB	5.900	F	D1-1E	72	20		<--- WASHINGTON VILLAGE SCHOOL			1				X																		
SB	5.874	G	VR-017	24	30								1		X											FIREHOUSE RD TH-67						
		G	VR-017	24	30			5.00									1		X								E-141					
SB	5.866	H	R1-1	30	30								1		X											FIREHOUSE RD TH-67						
		H	R1-1	30	30			6.25									1		X						X							
SB	5.860	F	S1-1YG	30	30		SCHOOL			1				X																		
		F	W16-7YG	24	12		DIAGONAL ARROW			1																						
SB	5.740	F	D1-1A	72	12		<--- WEST CORINTH 7			1				X																		
SB	5.650	F	R2-1	24	30		SPEED LIMIT 40			1				X																		
SB	5.575	F	W1-5R	30	30		RIGHT WINDING CURVES				1	1			X	1		X							INSTALL EXISTING SIGNS ON NEW POST							
		F	W7-3A	24	18		NEXT 1/2 MILE				1	1																				
SIGN SUMMARY SHEET							SHEET TOTALS	18.75	0.00	7	2	2	3	0	0	4	60								PROJECT NAME: Royalton-Barre Town VT110							
								SF	SF	EA	EA	EA	EA	EA	EA	EA		FT						PROJECT NUMBER: STPG SIGN(23)								
																														FILE NAME: Washington.xls	PLOT DATE: 6/15/2009	
							VERMONT AGENCY OF TRANSPORTATION																								DESIGNED BY: D. Crosslev	DRAWN BY: T. Guazzoni
							TOWN TOTALS	320.1	0.0	42.0	3.0	3.0	66	2.0	0.0	73	1095.0								CHECKED BY: S. Menard							
																										WASHINGTON SHEET 7	SHEET 60 OF 80					

DIRECTION	MILEPOINT	LOCATION CODE (SHEET 2)	SIGN CODE	WIDTH (IN)	HEIGHT (IN)	SHEETING REMARKS	SIGN LEGEND	NEW SIGNS		EXISTING SIGNS				EXIST POST		NUMBER OF NEW POSTS	SQUARE STEEL (IN)			TUBULAR STEEL Ø (IN)					SIGN FRAME REQUIRED	REMARKS	SIGN DETAIL			
								"A"	"B"	RETAIN	SALVAGE FROM	SALVAGE TO	REMOVE	RETAIN	REMOVE		1.75	2.00	2.50	FOUNDATION	3.00	3.50	4.00	5.00			DETAIL IN SHS	DETAIL ON SHEET NUMBER	DETAIL ON STD SHEET NUMBER	
																	(LB / FT)				(LB / FT)									
																	1.88	2.42	3.35		7.60	9.00	10.80	14.60						
WASHINGTON VT 110							FY-FLUORESCENT YELLOW FYG-FLUORESCENT YELLOW GREEN															"SHS"-STANDARD HIGHWAY SIGNS								
SB	5.530	F	W11-6H	30	30		HINGED SNOWMOBILE			1				X											E-153					
SB	5.468	G	VR-017	24	24								1		X									CARRIER RD TH-14						
		G	VR-017	24	30			5.00								1	X									E-141				
SB	5.463	H	R1-1	30	30								1		X									CARRIER RD TH-14 ISLAND						
		H	R1-1	30	30			6.25								1	X							X						
SB	5.458	H	R1-1	30	30								1		X									CARRIER RD TH-14						
		H	R1-1	30	30			6.26								1	X							X						
SB	5.320	F	R2-1	24	30		SPEED LIMIT 50			1				X																
SB	5.180	F	W1-8	18	24		CHEVRON			1				X																
SB	5.160	F	W1-8	18	24		CHEVRON			1				X																
SB	5.160	E	W1-8	18	24		CHEVRON			1				X																
SB	5.150	F	W1-8	18	24		CHEVRON			1				X																
SB	5.150	E	W1-8	18	24		CHEVRON			1				X																
SB	5.130	E	W1-8	18	24		CHEVRON			1				X																
SB	4.890	F	W1-4R	30	30		RIGHT REVERSE CURVE				1	1			X	1	X							INSTALL EXISTING SIGN ON NEW POST						
SIGN SUMMARY SHEET							SHEET TOTALS	17.51	0.00	8	1	1	3	0	0	4	60								PROJECT NAME: Royalton-Barre Town VT110					
								SF	SF	EA	EA	EA	EA	EA	EA	EA		FT						PROJECT NUMBER: STPG SIGN(23)						
																												FILE NAME: Washington.xls		
																													PLOT DATE: 6/15/2009	
VERMONT AGENCY OF TRANSPORTATION							TOWN TOTALS	320.1	0.0	42.0	3.0	3.0	66	2.0	0.0	73	1095.0								DRAWN BY: T. Guazzoni					
																												DESIGNED BY: D. Crosslev		
																												CHECKED BY: S. Menard		
																							WASHINGTON SHEET 8							
																							SHEET 61 OF 80							

DIRECTION	MILEPOINT	LOCATION CODE (SHEET 2)	SIGN CODE	WIDTH (IN)	HEIGHT (IN)	SHEETING REMARKS	SIGN LEGEND	NEW SIGNS		EXISTING SIGNS				EXIST POST		NUMBER OF NEW POSTS	SQUARE STEEL (IN)			TUBULAR STEEL Ø (IN)					SIGN FRAME REQUIRED	REMARKS	SIGN DETAIL		
								"A"	"B"	RETAIN	SALVAGE FROM	SALVAGE TO	REMOVE	RETAIN	REMOVE		1.75	2.00	2.50	FOUNDATION	3.00	3.50	4.00	5.00			DETAIL IN SHS	DETAIL ON SHEET NUMBER	DETAIL ON STD SHEET NUMBER
																	(LB / FT)				(LB / FT)								
																	1.88	2.42	3.35		7.60	9.00	10.80	14.60					
WASHINGTON VT 110							FY-FLUORESCENT YELLOW FYG-FLUORESCENT YELLOW GREEN															"SHS"-STANDARD HIGHWAY SIGNS							
SB	4.460	F	W1-2L	30	30		LEFT CURVE			1				X															
SB	3.895	G	VR-017	24	30		    					1		X											RICHARDSON RD TH-38				
		G	VR-017	24	30			5.00								1		X									E-141		
SB	3.903	H	R1-1	24	24								1		X												RICHARDSON RD TH-38		
		H	R1-1	30	30			6.25							1		X								X				
SB	3.550	F	W1-5R	30	30			6.25							2		X								INSTALL 1275' +/- SOUTH OF TH-38	X			
		F	W13-1	24	24			4.00																	INSTALL ON LEFT POST	X			
		F	W7-3A	24	18			3.00																	INSTALL ON RIGHT POST	X			
SB	2.740	F	W1-2R	30	30		CURVE RIGHT					1		X															
SB	2.700	F	W1-2R	30	30			6.25							1		X								INSTALL 200' +/- SOUTH OF ORIGINAL SIGN LOCATION	X			
SB	2.347	E	OM-3L	12	36		VERTICAL OBJECT MARKER					1		X															
SB	2.010	F	S3-1	30	30		SCHOOL BUS STOP AHEAD					1		X															
SB	1.988	G	VR-017	24	30							1		X											TILTON RD TH-43				
		G	VR-017	24	30			5.00							1		X										E-141		
SB	1.980	H	R1-1	30	30							1		X											TILTON RD TH-43				
SIGN SUMMARY SHEET							SHEET TOTALS		35.75	0.00	1	0	0	7	0	0	6	90								PROJECT NAME: Royalton-Barre Town VT110			
									SF	SF	EA	EA	EA	EA	EA	EA	EA	FT								PROJECT NUMBER: STPG SIGN(23)			
																								FILE NAME: Washington.xls			PLOT DATE: 6/15/2009		
																								PROJECT MANAGER: N. Avery			DRAWN BY: T. Guazzoni		
VERMONT AGENCY OF TRANSPORTATION							TOWN TOTALS		320.1	0.0	42.0	3.0	3.0	66	2.0	0.0	73	1095.0								DESIGNED BY: D. Crosslev			
																								WASHINGTON SHEET 9			CHECKED BY: S. Menard		
																								SHEET 62 OF 80					

DIRECTION	MILEPOINT	LOCATION CODE (SHEET 2)	SIGN CODE	WIDTH (IN)	HEIGHT (IN)	SHEETING REMARKS	SIGN LEGEND	NEW SIGNS		EXISTING SIGNS				EXIST POST		NUMBER OF NEW POSTS	SQUARE STEEL (IN)			TUBULAR STEEL Ø (IN)				SIGN FRAME REQUIRED	REMARKS	SIGN DETAIL			
								"A"	"B"	RETAIN	SALVAGE FROM	SALVAGE TO	REMOVE	RETAIN	REMOVE		1.75	2.00	2.50	FOUNDATION	3.00	3.50	4.00			5.00	DETAIL IN SHS	DETAIL ON SHEET NUMBER	DETAIL ON STD SHEET NUMBER
																	(LB / FT)				(LB / FT)								
																	1.88	2.42	3.35		7.60	9.00	10.80			14.60			
WASHINGTON VT 110							FY-FLUORESCENT YELLOW FYG-FLUORESCENT YELLOW GREEN															"SHS"-STANDARD HIGHWAY SIGNS							
		H	R1-1	30	30			6.25							1		X							X					
SB	1.790	F	OM-3R	12	36								1		X														
		F	OM-3R	12	36			3.00							1		X							X					
SB	1.782	E	OM-3L	12	36								1		X														
		E	OM-3L	12	36			3.00							1		X							X					
SB	1.770	F	W1-2R	30	30								1		X														
		F	W1-2R	30	30			6.25							1		X							X					
SB	1.669	G	VR-017	24	30								1		X														
		G	VR-017	24	30			5.00							1		X								E-141				
SB	1.661	H	R1-1	30	30						1	1	1		X														
		H	R1-1	30	30			6.25							1		X						X						
SB	1.406	G	VR-017	24	30								1		X														
		G	VR-017	24	30			5.00							1		X								E-141				
SB	1.398	H	R1-1	24	24								1		X														
		H	R1-1	30	30			6.25							1		X						X						
SIGN SUMMARY SHEET							SHEET TOTALS	41.00	0.00	0	0	0	7	0	0	8	120						PROJECT NAME: Royalton-Barre Town VT110						
								SF	SF	EA	EA	EA	EA	EA	EA	EA		FT					PROJECT NUMBER: STPG SIGN(23)						
							TOWN TOTALS	320.1	0.0	42.0	3.0	3.0	66	2.0	0.0	73	1095.0						FILE NAME: Washington.xls						
VERMONT AGENCY OF TRANSPORTATION											1	1											PLOT DATE: 6/15/2009						
																										DRAWN BY: T. Guazzoni			
																							CHECKED BY: S. Menard						
																										SHEET 63 OF 80			
																						WASHINGTON SHEET 10							

DIRECTION	MILEPOINT	LOCATION CODE (SHEET 2)	SIGN CODE	WIDTH (IN)	HEIGHT (IN)	SHEETING REMARKS	SIGN LEGEND	NEW SIGNS		EXISTING SIGNS				EXIST POST		NUMBER OF NEW POSTS	SQUARE STEEL (IN)			TUBULAR STEEL Ø (IN)				SIGN FRAME REQUIRED	REMARKS	SIGN DETAIL			
								"A"	"B"	RETAIN	SALVAGE FROM	SALVAGE TO	REMOVE	RETAIN	REMOVE		1.75	2.00	2.50	FOUNDATION	3.00	3.50	4.00			5.00	DETAIL IN SHS	DETAIL ON SHEET NUMBER	DETAIL ON STD SHEET NUMBER
																	(LB / FT)				(LB / FT)								
																	1.88	2.42	3.35		7.60	9.00	10.80			14.60			
WASHINGTON VT 110							FY-FLUORESCENT YELLOW FYG-FLUORESCENT YELLOW GREEN															"SHS"-STANDARD HIGHWAY SIGNS							
SB	1.405	F	OM-3R	12	36								1		X														
		F	OM-3R	12	36			3.00								1	X								X				
SB	1.395	E	OM-3L	12	36								1		X														
		E	OM-3L	12	36			3.00								1	X								X				
SB	1.140-1.04	F	N/A	6	8		6 WHITE DELINEATORS	2.01					6 +			6	X							REMOVE EXISTING DELINEATOR POSTS INSTALL 6 POSTS AT 100' SPACING		5			
SB	0.820	F	S3-1	30	30								1		X														
		F	S3-1	30	30			6.25								1	X								X				
SB	0.740	G	VR-017	24	24								1		X									POOR FARM RD TH-28					
SB	0.740	G	VR-017	24	30			5.00								1	X									E-141			
SB	0.739	E	M1-6	24	24		ROUTE 110						1	X															
		E	M6-1	21	15		--->RIGHT						1																
SB	0.725	H	R1-1	24	24								1		X									POOR FARM RD TH-28					
		H	R1-1	30	30			6.25								1	X								X				
SB	0.520	F	W2-2	30	30		SIDE ROAD RIGHT						1		X														
SB	0.405	F	D1-1A	72	10								1		X														
SIGN SUMMARY SHEET							SHEET TOTALS	25.51	0.00	0	0	0	10	0	0	11	165						PROJECT NAME: Royalton-Barre Town VT110						
								SF	SF	EA	EA	EA	EA	EA	EA	EA		FT							PROJECT NUMBER: STPG SIGN(23)				
							TOWN TOTALS	320.1	0.0	42.0	3.0	3.0	66	2.0	0.0	73	1095.0						FILE NAME: Washington.xls	PLOT DATE: 6/15/2009					
VERMONT AGENCY OF TRANSPORTATION													15										PROJECT MANAGER: N. Avery	DRAWN BY: T. Guazzoni					
																							DESIGNED BY: D. Crossley	CHECKED BY: S. Menard					
																							WASHINGTON SHEET 11	SHEET 64 OF 80					

DIRECTION	MILEPOINT	LOCATION CODE (SHEET 2)	SIGN CODE	WIDTH (IN)	HEIGHT (IN)	SHEETING REMARKS	SIGN LEGEND	NEW SIGNS		EXISTING SIGNS				EXIST POST		NUMBER OF NEW POSTS	SQUARE STEEL (IN)			TUBULAR STEEL Ø (IN)				SIGN FRAME REQUIRED	REMARKS	SIGN DETAIL			
								"A"	"B"	RETAIN	SALVAGE FROM	SALVAGE TO	REMOVE	RETAIN	REMOVE		1.75	2.00	2.50	FOUNDATION	3.00	3.50	4.00			5.00	DETAIL IN SHS	DETAIL ON SHEET NUMBER	DETAIL ON STD SHEET NUMBER
																	(LB / FT)				(LB / FT)								
																	1.88	2.42	3.35		7.60	9.00	10.80			14.60			
WASHINGTON VT 110							FY-FLUORESCENT YELLOW FYG-FLUORESCENT YELLOW GREEN															"SHS"-STANDARD HIGHWAY SIGNS							
		F	D1-1A	72	12			6.00								2	X								5				
SB	0.343	G	VR-017	24	30		 					1		X										WILLIAMSTOWN RD TH-3					
		G	VR-017	24	30			5.00							1	X										E-141			
SB	0.335	H	R1-1	30	30								1		X									WILLIAMSTOWN RD TH-3					
		H	R1-1	30	30			6.25							1	X								X					
SB	0.13-0.25	F	N/A	6	8		6 WHITE DELINEATORS	2.01					6 +			6	X							REMOVE EXISTING DELINEATOR POSTS INSTALL 6 POSTS AT 100' SPACING		5			
SIGN SUMMARY SHEET							SHEET TOTALS	19.26	0.00	0	0	0	3	0	0	10	150						PROJECT NAME: Royalton-Barre Town VT110						
								SF	SF	EA	EA	EA	EA	EA	EA	EA		FT					PROJECT NUMBER: STPG SIGN(23)						
VERMONT AGENCY OF TRANSPORTATION							TOWN TOTALS	320.1	0.0	42.0	3.0	3.0	66	2.0	0.0	73	1095.0						FILE NAME: Washington.xls PROJECT MANAGER: N. Avery DESIGNED BY: D. Crosslev WASHINGTON SHEET 12			PLOT DATE: 6/15/2009 DRAWN BY: T. Guazzoni CHECKED BY: S. Menard SHEET 65 OF 80			

DIRECTION	MILEPOINT	LOCATION CODE (SHEET 2)	SIGN CODE	WIDTH (IN)	HEIGHT (IN)	SHEETING REMARKS	SIGN LEGEND	NEW SIGNS		EXISTING SIGNS				EXIST POST		NUMBER OF NEW POSTS	SQUARE STEEL (IN)			TUBULAR STEEL Ø (IN)				SIGN FRAME REQUIRED	REMARKS	SIGN DETAIL			
								"A"	"B"	RETAIN	SALVAGE FROM	SALVAGE TO	REMOVE	RETAIN	REMOVE		1.75	2.00	2.50	FOUNDATION	3.00	3.50	4.00			5.00	DETAIL IN SHS	DETAIL ON SHEET NUMBER	DETAIL ON STD SHEET NUMBER
																	(LB / FT)				(LB / FT)								
																	1.88	2.42	3.35		7.60	9.00	10.80			14.60			
ORANGE VT110						FY-FLUORESCENT YELLOW FYG-FLUORESCENT YELLOW GREEN																"SHS"-STANDARD HIGHWAY SIGNS							
NB	0.000	C	VD-024	60	7.5																								
		C	VD-025	72	10		ORANGE WASHINGTON	5.00								2		X									4		
		C	VD-700	6	10		1100 0908 0000 1100 0915 0703	0.42																ORANGE MILE MARKER ~ INSTALL ON LEFT POST			E-138		
		C	VD-700	6	10			0.42															WASHINGTON MILE MARKER ~ INSTALL ON RIGHT POST			E-138			
NB	0.075	A	W11-6H	30	30									1		X													
		A	W11-6H	30	30			6.25								1		X						INSTALL IN CLOSED POSITION			E-153		
NB	0.305	A	W2-2	30	30		SIDE RD WARNING							1		X													
NB	0.340	A	W2-2MaR	30	30		 Tucker Rd	6.25								1		X						INSTALL 175 FT +/- NORTH OF EXISTING, IN FRONT OF NEXT UTILITY POLE			6		
		A	W16-8	24	8			1.33																	4				
NB	0.405	C	VR-017	24	24									1		X													
		C	VR-017	24	30			5.00								1		X						TH-2, TUCKER RD			E-141		
NB	0.415	D	R1-1	30	30									1		X													
		D	R1-1	30	30			6.25								1		X						TH-2, TUCKER RD	X				
NB	1.460	A	W1-2L	30	30									1		X													
		A	W1-2L	30	30			6.25								1		X								X			
SIGN SUMMARY SHEET						SHEET TOTALS		37.17	0.00	0	0	0	6	0	0	7	105							PROJECT NAME: Royalton-Barre Town VT110					
								SF	SF	EA	EA	EA	EA	EA	EA	EA	FT						PROJECT NUMBER: STPG SIGN(23)						
						TOWN TOTALS		56.7	0.0	3.0	1.0	1.0	9	0.0	0.0	11	165.0							FILE NAME: Orange.xls PROJECT MANAGER: N. Avery DESIGNED BY: A. Gamble ORANGE SHEET 1			PLOT DATE: 6/15/2009 DRAWN BY: T. Guazzoni CHECKED BY: S. Menard SHEET 66 OF 80		

DIRECTION	MILEPOINT	LOCATION CODE (SHEET 2)	SIGN CODE	WIDTH (IN)	HEIGHT (IN)	SHEETING REMARKS	SIGN LEGEND	NEW SIGNS		EXISTING SIGNS				EXIST POST		NUMBER OF NEW POSTS	SQUARE STEEL (IN)			TUBULAR STEEL Ø (IN)				SIGN FRAME REQUIRED	REMARKS	SIGN DETAIL			
								"A"	"B"	RETAIN	SALVAGE FROM	SALVAGE TO	REMOVE	RETAIN	REMOVE		1.75	2.00	2.50	FOUNDATION	3.00	3.50	4.00			5.00	DETAIL IN SHS	DETAIL ON SHEET NUMBER	DETAIL ON STD SHEET NUMBER
																	(LB / FT)				(LB / FT)								
																	1.88	2.42	3.35		7.60	9.00	10.80			14.60			
ORANGE VT110						FY-FLUORESCENT YELLOW FYG-FLUORESCENT YELLOW GREEN																"SHS"-STANDARD HIGHWAY SIGNS							
NB	1.510	A	VW-054L	30	30		HIDDEN DRIVE LEFT			1				X															
SB	1.750	F	VW-054R	30	30		HIDDEN DRIVE RIGHT			1				X															
SB	1.670	F	W1-2R	30	30		RIGHT CURVE				1	1			X	1	X							INSTALL EXISTING SIGN ON NEW POST					
SB	1.640	F	VW-054R	30	30		HIDDEN DRIVE RIGHT			1				X															
SB	0.410	F	M1-5A	24	24			2.00							X	1	X							GREEN ON WHITE SHEETING	X				
		F	M3-3	12	24			5.00																			E-136B		
		F	M1-5	30	24																								
SB	0.320	F	W11-6H	30	30										X														
		F	W11-6H	30	30	REMOVE PER TRAFFIC OPPS.		6.25									1	X						INSTALL IN CLOSED POSITION			E-153		
SB	0.001	F	S1-S	30	30								1		X														
		F	S1-S	30	30			6.25									1	X							X				
SIGN SUMMARY SHEET						SHEET TOTALS		19.50	0.00	3	1	1	3	0	0	4	60							PROJECT NAME: Royalton-Barre Town VT110					
								SF	SF	EA	EA	EA	EA	EA	EA	EA		FT							PROJECT NUMBER: STPG SIGN(23)				
						TOWN TOTALS		56.7	0.0	3.0	1.0	1.0	9	0.0	0.0	11	165.0							FILE NAME: Orange.xls					
VERMONT AGENCY OF TRANSPORTATION																							PROJECT MANAGER: N. Avery			PLOT DATE: 6/15/2009			
																							DESIGNED BY: A. Gamble			DRAWN BY: T. Guazzoni			
																							ORANGE SHEET 2			CHECKED BY: S. Menard			
																							SHEET 67 OF 80						

DIRECTION	MILEPOINT	LOCATION CODE (SHEET 2)	SIGN CODE	WIDTH (IN)	HEIGHT (IN)	SHEETING REMARKS	SIGN LEGEND	NEW SIGNS		EXISTING SIGNS				EXIST POST		NUMBER OF NEW POSTS	SQUARE STEEL (IN)			TUBULAR STEEL Ø (IN)				SIGN FRAME REQUIRED	REMARKS	SIGN DETAIL				
								"A"	"B"	RETAIN	SALVAGE FROM	SALVAGE TO	REMOVE	RETAIN	REMOVE		1.75	2.00	2.50	FOUNDATION	3.00	3.50	4.00			5.00	DETAIL IN SHS	DETAIL ON SHEET NUMBER	DETAIL ON STD SHEET NUMBER	
																	(LB / FT)				(LB / FT)									
																	1.88	2.42	3.35		7.60	9.00	10.80			14.60				
BARRE TOWN VT 110							FY-FLUORESCENT YELLOW FYG-FLUORESCENT YELLOW GREEN															"SHS"-STANDARD HIGHWAY SIGNS								
NB	0.000	C	VD-025	60	7.5		BARRE TOWN ORANGE WASHINGTON CO ORANGE CO 1100 1202 0000 1100 0917 0179					1		X																
		C	VD-024	60	7.5							0+																		
		C	VD-025	72	10			5.00								2		X								4				
		C	VD-024	72	10			5.00																		4				
		C	VD-700	6	10			0.42																BARRE TOWN MILE MARKER ~ INSTALL ON LEFT POST			E-138			
		C	VD-700	6	10			0.42																ORANGE MILE MARKER ~ INSTALL ON RIGHT POST			E-138			
NB	0.400	A	W11-6	30	30		REMOVE PER TRAFFIC OPPS. SPEED LIMIT 35					2+		X																
		A	W11-6H	30	30	6.25									1		X							INSTALL IN CLOSED POSITION			E-153			
NB	0.530	A	R2-5A	24	30	REDUCED SPEED AHEAD						1		X																
		A	W3-5	36	36		9.00								2		X							X						
NB	0.601	A	VD-062A	72	16	BUSINESS SIGN				1			X																	
		A	VD-062A	72	16	BUSINESS SIGN				1																				
NB	0.640	A	VD-018	30	18	EAST BARRE JCT US 302						1		x																
		A	VD-018	30	18		3.75								1		X									E-128A				
NB	0.680	A	W11-2	30	30							1		X																
SIGN SUMMARY SHEET							SHEET TOTALS	29.84	0.00	2	0	0	6	0	0	6	90							PROJECT NAME: Royalton-Barre Town VT110						
								SF	SF	EA	EA	EA	EA	EA	EA	EA		FT					PROJECT NUMBER: STPG SIGN(23)							
							TOWN TOTALS	258.0	0.0	29.0	4.0	4.0	50	0.0	0.0	41	615.0							FILE NAME: Barre Town.xls	PLOT DATE: 6/15/2009					
VERMONT AGENCY OF TRANSPORTATION																							PROJECT MANAGER: N. Avery	DRAWN BY: T. Guazzoni						
																											DESIGNED BY: A. Gamble	CHECKED BY: S. Menard		
																						BARRE TOWN SHEET 1	SHEET 68 OF 80							

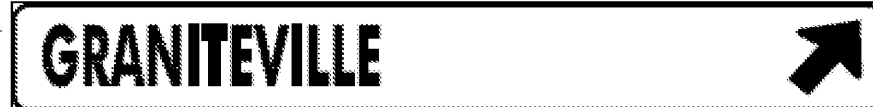
DIRECTION	MILEPOINT	LOCATION CODE (SHEET 2)	SIGN CODE	WIDTH (IN)	HEIGHT (IN)	SHEETING REMARKS	SIGN LEGEND	NEW SIGNS		EXISTING SIGNS				EXIST POST		NUMBER OF NEW POSTS	SQUARE STEEL (IN)			TUBULAR STEEL Ø (IN)				SIGN FRAME REQUIRED	REMARKS	SIGN DETAIL				
								"A"	"B"	RETAIN	SALVAGE FROM	SALVAGE TO	REMOVE	RETAIN	REMOVE		1.75	2.00	2.50	FOUNDATION	3.00	3.50	4.00			5.00	DETAIL IN SHS	DETAIL ON SHEET NUMBER	DETAIL ON STD SHEET NUMBER	
																	(LB / FT)				(LB / FT)									
																	1.88	2.42	3.35		7.60	9.00	10.80			14.60				
BARRE TOWN VT 110							FY-FLUORESCENT YELLOW FYG-FLUORESCENT YELLOW GREEN															"SHS"-STANDARD HIGHWAY SIGNS								
			A	W11-2	30	30	FYG		6.25							1		X							X					
			A	W16-4	24	18	FYG		3.00																X					
NB	0.720	A	R2-1	30	36		SPEED LIMIT 35			1				X																
NB	0.745	C	VR-017	24	30								1		X									TH-94, PROSPECT ST						
		C	UNK			TOWN PARKING REGULATION SIGN					1																			
		C	VR-017	24	30			5.00								1		X								E-141				
		C	UNK										1											RE-INSTALL TOWN'S PARKING REGULATION SIGN BELOW LEGAL LOAD SIGN						
NB	0.750	D	R1-1	30	30								1		X															
		D	R1-1	30	30			6.25								1		X						TH-94, PROSPECT ST	X					
NB	0.780	A	W1-1MR	30	30		RIGHT TURN						1		X															
		A	W13-1	18	18		25 MPH PLAQUE						1																	
NB	0.785	C	VR-017	24	30		LEGAL LOAD LIMIT 24,000 LBS						1		X									TH-93, PLEASANT ST						
		C	UNK				TOWN PARKING REGULATION SIGN				1																			
		C	VR-017	24	30			5.00								1		X								E-141				
		C	UNK									1												RE-INSTALL TOWN'S PARKING REGULATION SIGN BELOW LEGAL LOAD SIGN						
SIGN SUMMARY SHEET							SHEET TOTALS	25.50	0.00	1	2	2	5	0	0	4	60							PROJECT NAME: Royalton-Barre Town VT110						
								SF	SF	EA	EA	EA	EA	EA	EA	EA		FT					PROJECT NUMBER: STPG SIGN(23)							
																											FILE NAME: Barre Town.xls			
																												PLOT DATE: 6/15/2009		
VERMONT AGENCY OF TRANSPORTATION							TOWN TOTALS	258.0	0.0	29.0	4.0	4.0	50	0.0	0.0	41	615.0							DRAWN BY: T. Guazzoni						
																											PROJECT MANAGER: N. Avery			
																											DESIGNED BY: A. Gamble			
																												CHECKED BY: S. Menard		
																							SHEET 69 OF 80							

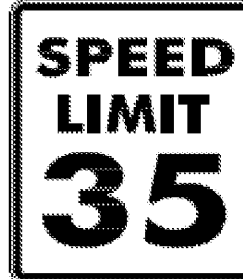
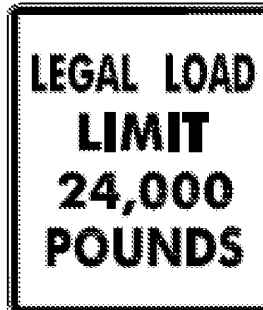
DIRECTION	MILEPOINT	LOCATION CODE (SHEET 2)	SIGN CODE	WIDTH (IN)	HEIGHT (IN)	SHEETING REMARKS	SIGN LEGEND	NEW SIGNS		EXISTING SIGNS				EXIST POST		NUMBER OF NEW POSTS	SQUARE STEEL (IN)			TUBULAR STEEL Ø (IN)				SIGN FRAME REQUIRED	REMARKS	SIGN DETAIL			
								"A"	"B"	RETAIN	SALVAGE FROM	SALVAGE TO	REMOVE	RETAIN	REMOVE		1.75	2.00	2.50	FOUNDATION	3.00	3.50	4.00			5.00	DETAIL IN SHS	DETAIL ON SHEET NUMBER	DETAIL ON STD SHEET NUMBER
																	(LB / FT)				(LB / FT)								
																	1.88	2.42	3.35		7.60	9.00	10.80			14.60			
BARRE TOWN VT 110							FY-FLUORESCENT YELLOW FYG-FLUORESCENT YELLOW GREEN															"SHS"-STANDARD HIGHWAY SIGNS							
NB	0.790	D	R1-1	30	30								1		X														
		D	R1-1	30	30			6.25									1	X						TH-93, PLEASANT ST	X				
NB	0.810	A	VR-644	24	12		BEGIN			+			1	X															
		A	R8-3A	24	24		NO PARKING			+			1																
NB	0.835	A	S3-1	30	30		SCHOOL BUS STOP AHEAD						1		X														
		A	W1-1MdR	30	30			6.25								1	X									6			
		A	W16-8	30	8			1.67																		4			
NB	0.870	A	R8-3A	24	24		NO PARKING			+			1	X															
		A	M4-6	24	12		END			+			1																
NB	0.940	A	W1-10R	30	30		CURVE W/SIDE RDS						1		X														
		A	W13-1	18	18		20 MPH PLAQUE						1																
		A	W1-2MaR	30	30			6.25								1	X									6			
		A	W16-2	24	18			3.00																X					
NB	0.945	C	VR-017	24	30		LEGAL LOAD LIMIT 24,000 LBS						1		X										TH-85, CARNES RD				
		C	UNK				TOWN PARKING REGULATION SIGN				1																		
SIGN SUMMARY SHEET							SHEET TOTALS	23.42	0.00	4	1	0	5	0	0	3	45							PROJECT NAME: Royalton-Barre Town VT110					
								SF	SF	EA	EA	EA	EA	EA	EA	EA		FT					PROJECT NUMBER: STPG SIGN(23)						
										0			9													FILE NAME: Barre Town.xls			
VERMONT AGENCY OF TRANSPORTATION							TOWN TOTALS	258.0	0.0	29.0	4.0	4.0	50	0.0	0.0	41	615.0							PLOT DATE: 6/15/2009					
																								DRAWN BY: T. Guazzoni					
																								CHECKED BY: S. Menard					
																						DESIGNED BY: A. Gamble							
																						BARRE TOWN SHEET 3							
																						SHEET 70 OF 80							

DIRECTION	MILEPOINT	LOCATION CODE (SHEET 2)	SIGN CODE	WIDTH (IN)	HEIGHT (IN)	SHEETING REMARKS	SIGN LEGEND	NEW SIGNS		EXISTING SIGNS				EXIST POST		NUMBER OF NEW POSTS	SQUARE STEEL (IN)			TUBULAR STEEL Ø (IN)				SIGN FRAME REQUIRED	REMARKS	SIGN DETAIL			
								"A"	"B"	RETAIN	SALVAGE FROM	SALVAGE TO	REMOVE	RETAIN	REMOVE		1.75	2.00	2.50	FOUNDATION	3.00	3.50	4.00			5.00	DETAIL IN SHS	DETAIL ON SHEET NUMBER	DETAIL ON STD SHEET NUMBER
																	(LB / FT)				(LB / FT)								
																	1.88	2.42	3.35		7.60	9.00	10.80			14.60			
BARRE TOWN VT 110							FY-FLUORESCENT YELLOW FYG-FLUORESCENT YELLOW GREEN															"SHS"-STANDARD HIGHWAY SIGNS							
		C	VR-017	24	30			5.00							1		X									E-141			
		C	UNK							1													RE-INSTALL TOWN'S PARKING REGULATION SIGN BELOW LEGAL LOAD SIGN						
NB	0.950	D	R1-1	30	30							1		X															
		D	R1-1	30	30			6.25							1		X							TH-85, CARNES RD					
NB	0.970	A	W3-1	30	30		STOP AHEAD			1				X										TO BE REMOVED AND REPLACED BY ROUNDABOUT WARNING SIGN, HES 026-1(38)					
NB	1.030	A	M2-1	21	15		JCT			1				X										TO BE REPLACED AND RELOCATED TO MP 1.00 BY HES 026-1(38)					
		A	M1-4	30	24		US 302			1																			
		A	M4-6	24	12		END			1																			
		A	M1-5A	24	24		VT 110			1																			
NB	1.050	C	VR-017	24	30							1			X														
		C	VR-017	24	30			5.00								1		X							TH-84, BIANCHI ST		E-141		
NB	1.060	D	R1-1	30	30								1		X														
		D	R1-1	30	30			6.25								1		X						TH-84, BIANCHI ST	X				
NB	1.075	A	D1-1A	72	10								1		X														
		A	D1-1A	72	10								1																
SIGN SUMMARY SHEET							SHEET TOTALS	22.50	0.00	5	0	1	5	0	0	4	60							PROJECT NAME: Royalton-Barre Town VT110					
								SF	SF	EA	EA	EA	EA	EA	EA	EA		FT					PROJECT NUMBER: STPG SIGN(23)						
							TOWN TOTALS	258.0	0.0	29.0	4.0	4.0	50	0.0	0.0	41	615.0							FILE NAME: Barre Town.xls PROJECT MANAGER: N. Averv DESIGNED BY: A. Gamble BARRE TOWN SHEET 4			PLOT DATE: 6/15/2009 DRAWN BY: T. Guazzoni CHECKED BY: S. Menard SHEET 71 OF 80		

DIRECTION	MILEPOINT	LOCATION CODE (SHEET 2)	SIGN CODE	WIDTH (IN)	HEIGHT (IN)	SHEETING REMARKS	SIGN LEGEND	NEW SIGNS		EXISTING SIGNS				EXIST POST		NUMBER OF NEW POSTS	SQUARE STEEL (IN)			TUBULAR STEEL Ø (IN)				SIGN FRAME REQUIRED	REMARKS	SIGN DETAIL			
								"A"	"B"	RETAIN	SALVAGE FROM	SALVAGE TO	REMOVE	RETAIN	REMOVE		1.75	2.00	2.50	FOUNDATION	3.00	3.50	4.00			5.00	DETAIL IN SHS	DETAIL ON SHEET NUMBER	DETAIL ON STD SHEET NUMBER
																	(LB / FT)				(LB / FT)								
																	1.88	2.42	3.35		7.60	9.00	10.80			14.60			
BARRE TOWN VT 110							FY-FLUORESCENT YELLOW FYG-FLUORESCENT YELLOW GREEN															"SHS"-STANDARD HIGHWAY SIGNS							
			A	D1-1A	72	10						1																	
			A	D1-1A	72	10						1																	
			A	D1-1A	72	12	← BARRE 4	6.00							2			X									5		
			A	D1-1A	72	12	← MONTPELIER 11	6.00																			5		
			A	D1-1A	72	12	ORANGE 3 →	6.00																			5		
			A	D1-1A	72	12	WELLS RIVER 27 →	6.00																			5		
NB	1.090	K	R1-1	24	24		STOP			1				X										NEW SIGNS TO BE INSTALLED AT INTERSECTION PER HES 026-1(38)					
		J	R4-7	24	30		RIGHT BULLNOSE			1																			
		K	OM1-1	18	18		YELLOW CLUSTER			1																			
		J	OM1-1	18	18		YELLOW CLUSTER			1																			
NB	1.100	J	R4-7	24	30		RIGHT BULLNOSE			1				X										NEW SIGNS TO BE INSTALLED AT INTERSECTION PER HES 026-1(38)					
SB	1.120	F	R1-1	24	24		STOP			1				X										NEW SIGNS TO BE INSTALLED AT INTERSECTION PER HES 026-1(38)					
SB	1.103	H	R1-2	30	30		YIELD			1				X										NEW SIGNS TO BE INSTALLED AT INTERSECTION PER HES 026-1(38)					
		G	R5-1	30	30		DO NOT ENTER			1				X															
SB	1.100	J	OM1-1	18	18		YELLOW CLUSTER			1														NEW SIGNS TO BE INSTALLED AT INTERSECTION PER HES 026-1(38)					
SIGN SUMMARY SHEET							SHEET TOTALS	24.00	0.00	9	0	0	2	0	0	2	30							PROJECT NAME: Royalton-Barre Town VT110					
								SF	SF	EA	EA	EA	EA	EA	EA	EA		FT					PROJECT NUMBER: STPG SIGN(23)						
																										FILE NAME: Barre Town.xls			
																										PLOT DATE: 6/15/2009			
VERMONT AGENCY OF TRANSPORTATION										EA	EA	EA	EA	EA	EA	EA							DRAWN BY: T. Guazzoni						
																									CHECKED BY: S. Menard				
							TOWN TOTALS	258.0	0.0	29.0	4.0	4.0	50	0.0	0.0	41	615.0							BARRE TOWN SHEET 5					
																							SHEET 72 OF 80						

DIRECTION	MILEPOINT	LOCATION CODE (SHEET 2)	SIGN CODE	WIDTH (IN)	HEIGHT (IN)	SHEETING REMARKS	SIGN LEGEND	NEW SIGNS		EXISTING SIGNS				EXIST POST		NUMBER OF NEW POSTS	SQUARE STEEL (IN)			TUBULAR STEEL Ø (IN)				SIGN FRAME REQUIRED	REMARKS	SIGN DETAIL			
								"A"	"B"	RETAIN	SALVAGE FROM	SALVAGE TO	REMOVE	RETAIN	REMOVE		1.75	2.00	2.50	FOUNDATION	3.00	3.50	4.00			5.00	DETAIL IN SHS	DETAIL ON SHEET NUMBER	DETAIL ON STD SHEET NUMBER
																	(LB / FT)				(LB / FT)								
																	1.88	2.42	3.35		7.60	9.00	10.80			14.60			
BARRE TOWN VT 110							FY-FLUORESCENT YELLOW FYG-FLUORESCENT YELLOW GREEN															"SHS"-STANDARD HIGHWAY SIGNS							
		H	R1-2	30	30		YIELD			1																			
		G	R5-1	30	30		DO NOT ENTER			1																			
SB	1.090	F	R2-1	24	30			5.00				1		X	1		X							X					
SB	1.070	G	VR-017	24	30			5.00				1		X	1		X												
		G	VR-017	24	30			5.00							1		X						TH-125, OLD 302			E-141			
SB	1.060	H	R1-1	30	30			6.25				1		X	1		X						TH-125, OLD 302	X					
SB	1.055	G	VR-017	24	30		LEGAL LOAD LIMIT 24,000 LBS					1		X									TH-2, MILL ST						
		G	R2-1	24	30		TOWN SPEED LIMIT SIGN			1																E-141			
		H	R1-1	36	36			5.00							1		X						REINSTALL TOWN'S SL SIGN BELOW LL 24000 SIGN, 30 FT +/- SOUTH OF INTERSECTION			E-141			
		G	R2-1	24	30			9.00				1			2		X						LEFT SIDE OF MILL ST APPROACH, OFFSET FROM G FACING SIGNS FOR VISIBILITY	X					
SB	1.050	H	R1-1	30	30							1		X															
SIGN SUMMARY SHEET							SHEET TOTALS	30.25	0.00	2	1	+	6	0	0	6	90							PROJECT NAME: Royalton-Barre Town VT110					
								SF	SF	EA	EA	EA	EA	EA	EA	EA		FT							PROJECT NUMBER: STPG SIGN(23)				
												2													FILE NAME: Barre Town.xls				
VERMONT AGENCY OF TRANSPORTATION							TOWN TOTALS	258.0	0.0	29.0	4.0	4.0	50	0.0	0.0	41	615.0							PLOT DATE: 6/15/2009					
																						DRAWN BY: T. Guazzoni							
																						CHECKED BY: S. Menard							
																						SHEET 73 OF 80							

DIRECTION	MILEPOINT	LOCATION CODE (SHEET 2)	SIGN CODE	WIDTH (IN)	HEIGHT (IN)	SHEETING REMARKS	SIGN LEGEND	NEW SIGNS		EXISTING SIGNS				EXIST POST		NUMBER OF NEW POSTS	SQUARE STEEL (IN)			TUBULAR STEEL Ø (IN)				SIGN FRAME REQUIRED	REMARKS	SIGN DETAIL			
								"A"	"B"	RETAIN	SALVAGE FROM	SALVAGE TO	REMOVE	RETAIN	REMOVE		1.75	2.00	2.50	FOUNDATION	3.00	3.50	4.00			5.00	DETAIL IN SHS	DETAIL ON SHEET NUMBER	DETAIL ON STD SHEET NUMBER
																	(LB / FT)				(LB / FT)								
																	1.88	2.42	3.35		7.60	9.00	10.80			14.60			
BARRE TOWN VT 110							FY-FLUORESCENT YELLOW FYG-FLUORESCENT YELLOW GREEN															"SHS"-STANDARD HIGHWAY SIGNS							
			H	R1-1	30	30		6.25							1		X						TH-125, OLD 302	X					
SB	1.050		F	D1-1A	54	7.5							1		X														
			F	D1-1A	54	7.5							1																
			F	D1-1	54	7.5							1																
			F	D1-1	54	7.5							1																
			F	D1-1	UNK		EAST BARRE SHOPPING AREA						1									REMOVE AND DO NOT REPLACE TOWN DIRECTIONAL SIGN							
			F	D1-1	UNK		GRANITE QUARRIES						1									REMOVE AND DO NOT REPLACE TOWN DIRECTIONAL SIGN							
			F	D1-1	UNK		MILLSTONE HILL						1									REMOVE AND DO NOT REPLACE TOWN DIRECTIONAL SIGN							
			F	D1-1A	72	12		6.00							2		X								5				
			F	D1-1A	72	12		6.00																	5				
			F	D1-1	72	12		6.00																	5				
			F	D1-1	72	12		6.00																	5				
SB	1.049		F	M3-3	24	12							1		X														
			F	M1-5A	24	24							1																
			F	M6-2	21	15							1																
SIGN SUMMARY SHEET							SHEET TOTALS	30.25	0.00	0	0	0	10	0	0	3	45							PROJECT NAME: Royalton-Barre Town VT110					
								SF	SF	EA	EA	EA	EA	EA	EA	EA		FT					PROJECT NUMBER: STPG SIGN(23)						
																									FILE NAME: Barre Town.xls				
							VERMONT AGENCY OF TRANSPORTATION																		PLOT DATE: 6/15/2009				
							TOWN TOTALS	258.0	0.0	29.0	4.0	4.0	50	0.0	0.0	41	615.0							DRAWN BY: T. Guazzoni					
																						DESIGNED BY: A. Gamble							
																						CHECKED BY: S. Menard							
																						SHEET 74 OF 80							

DIRECTION	MILEPOINT	LOCATION CODE (SHEET 2)	SIGN CODE	WIDTH (IN)	HEIGHT (IN)	SHEETING REMARKS	SIGN LEGEND	NEW SIGNS		EXISTING SIGNS				EXIST POST		NUMBER OF NEW POSTS	SQUARE STEEL (IN)			TUBULAR STEEL Ø (IN)				SIGN FRAME REQUIRED	REMARKS	SIGN DETAIL			
								"A"	"B"	RETAIN	SALVAGE FROM	SALVAGE TO	REMOVE	RETAIN	REMOVE		1.75	2.00	2.50	FOUNDATION	3.00	3.50	4.00			5.00	DETAIL IN SHS	DETAIL ON SHEET NUMBER	DETAIL ON STD SHEET NUMBER
																	(LB / FT)				(LB / FT)								
																	1.88	2.42	3.35		7.60	9.00	10.80			14.60			
BARRE TOWN VT 110							FY-FLUORESCENT YELLOW FYG-FLUORESCENT YELLOW GREEN															"SHS"-STANDARD HIGHWAY SIGNS							
			F	M3-3	24	12		2.00							1		X						GREEN ON WHITE SHEETING. INSTALL TO THE LEFT OF THE DESTINATION SIGN ASSEMBLY	X					
			F	M1-5	30	24		5.00																	E-136B				
			F	M6-2	21	15		2.19															GREEN ON WHITE SHEETING	X					
SB	1.020		F	R2-1	24	30	 						1		X														
			F	R2-1	24	30		5.00							1		X							X					
SB	0.995		F	W1-1L	30	30							1		X														
			F	W1-1MdL	30	30		6.25							1		X								6				
SB	0.933		F	S3-1	30	30	SCHOOL BUS STOP AHEAD			1				X															
SB	0.905		H	R1-1	30	30	 						1		X								TH-55, WATERMAN ST						
			G	VR-017	24	30							1		X														
			H	R1-1	30	30		6.25							1		X						GATEPOSTED STOP SIGN	X					
			G	VR-017	24	30		5.00							1		X						INSTALL LEGAL LOAD 30-50 FT BEYOND STOP SIGN.			E-141			
SB	0.897		H	R1-1	30	30							1		X														
			H	R1-1	30	30		6.25							1		X						TH-55, WATERMAN ST	X					
SB	0.895		F	W1-6	48	24							1		X														
SIGN SUMMARY SHEET							SHEET TOTALS	37.94	0.00	1	0	0	6	0	0	6	90							PROJECT NAME: Royalton-Barre Town VT110					
								SF	SF	EA	EA	EA	EA	EA	EA	EA		FT					PROJECT NUMBER: STPG SIGN(23)						
																										FILE NAME: Barre Town.xls			
																										PLOT DATE: 6/15/2009			
VERMONT AGENCY OF TRANSPORTATION																							DRAWN BY: T. Guazzoni						
																										CHECKED BY: S. Menard			
TOWN TOTALS							258.0	0.0	29.0	4.0	4.0	50	0.0	0.0	41	615.0							BARRE TOWN SHEET 8						
																							SHEET 75 OF 80						

DIRECTION	MILEPOINT	LOCATION CODE (SHEET 2)	SIGN CODE	WIDTH (IN)	HEIGHT (IN)	SHEETING REMARKS	SIGN LEGEND	NEW SIGNS		EXISTING SIGNS				EXIST POST		NUMBER OF NEW POSTS	SQUARE STEEL (IN)			TUBULAR STEEL Ø (IN)				SIGN FRAME REQUIRED	REMARKS	SIGN DETAIL			
								"A"	"B"	RETAIN	SALVAGE FROM	SALVAGE TO	REMOVE	RETAIN	REMOVE		1.75	2.00	2.50	FOUNDATION	3.00	3.50	4.00			5.00	DETAIL IN SHS	DETAIL ON SHEET NUMBER	DETAIL ON STD SHEET NUMBER
																	(LB / FT)				(LB / FT)								
																	1.88	2.42	3.35		7.60	9.00	10.80			14.60			
BARRE TOWN VT 110							FY-FLUORESCENT YELLOW FYG-FLUORESCENT YELLOW GREEN															"SHS"-STANDARD HIGHWAY SIGNS							
		F	W1-6	48	24	FY		8.00							2		X							X					
SB	0.894	E	W1-6	48	24							1		X															
		E	W1-6	48	24	FY		8.00							2		X							X					
SB	0.860	F	VR-644	24	12		BEGIN			+			1	X										RETAIN IF PRESENT					
		F	R8-3A	24	24		NO PARKING			+			1																
SB	0.840	F	R8-3A	24	24		NO PARKING			+			1	X										RETAIN IF PRESENT					
SB	0.800	F	M4-6	24	12		END			+			1	X										RETAIN IF PRESENT					
		F	R8-3A	24	24		NO PARKING			+			1																
SB	0.730	F	R2-1	24	30			5.00					1		X	1		X						X					
		F	R2-1	24	30																								
SB	0.680	F	M3-3	24	12								1		X														
		F	M1-5A	24	24			2.00					1			1		X						GREEN ON WHITE SHEETING	X				
		F	M3-3	24	12																								
		F	M1-5A	30	24			5.00																		E-136B			
SB	0.640	F	W11-6	30	30								1		X														
SIGN SUMMARY SHEET							SHEET TOTALS	28.00	0.00	5	0	0	5	0	0	6	90							PROJECT NAME: Royalton-Barre Town VT110					
								SF	SF	EA	EA	EA	EA	EA	EA	EA		FT					PROJECT NUMBER: STPG SIGN(23)						
										0			10												FILE NAME: Barre Town.xls				
VERMONT AGENCY OF TRANSPORTATION							TOWN TOTALS	258.0	0.0	29.0	4.0	4.0	50	0.0	0.0	41	615.0							PLOT DATE: 6/15/2009					
																							DRAWN BY: T. Guazzoni						
																							CHECKED BY: S. Menard						
																						DESIGNED BY: A. Gamble							
																							BARRE TOWN SHEET 9						
																							SHEET 76 OF 80						

DIRECTION	MILEPOINT	LOCATION CODE (SHEET 2)	SIGN CODE	WIDTH (IN)	HEIGHT (IN)	SHEETING REMARKS	SIGN LEGEND	NEW SIGNS		EXISTING SIGNS				EXIST POST		NUMBER OF NEW POSTS	SQUARE STEEL (IN)			TUBULAR STEEL Ø (IN)				SIGN FRAME REQUIRED	REMARKS	SIGN DETAIL			
								"A"	"B"	RETAIN	SALVAGE FROM	SALVAGE TO	REMOVE	RETAIN	REMOVE		1.75	2.00	2.50	FOUNDATION	3.00	3.50	4.00			5.00	DETAIL IN SHS	DETAIL ON SHEET NUMBER	DETAIL ON STD SHEET NUMBER
																	(LB / FT)				(LB / FT)								
																	1.88	2.42	3.35		7.60	9.00	10.80			14.60			
BARRE TOWN VT 110							FY-FLUORESCENT YELLOW FYG-FLUORESCENT YELLOW GREEN															"SHS"-STANDARD HIGHWAY SIGNS							
		F	W11-6	30	30			6.25							1	X							INSTALL IN CLOSED POSITION			E-153			
SIGN SUMMARY SHEET							SHEET TOTALS	6.25	0.00	0	0	0	0	0	0	1	15						PROJECT NAME: Royalton-Barre Town VT110						
								SF	SF	EA	EA	EA	EA	EA	EA	EA		FT					PROJECT NUMBER: STPG SIGN(23)						
																							FILE NAME: Barre Town.xls						
																							PLOT DATE: 6/15/2009						
VERMONT AGENCY OF TRANSPORTATION							TOWN TOTALS	258.0	0.0	29.0	4.0	4.0	50	0.0	0.0	41	615.0						PROJECT MANAGER: N. Avery						
																						DRAWN BY: T. Guazzoni							
																					DESIGNED BY: A. Gamble								
																					CHECKED BY: S. Menard								
																					BARRE TOWN SHEET 10								
																					SHEET 77 OF 80								

TOWN TOTAL SIGN SUMMARY SHEET

VT ROUTE 110 ROYALTON - BARRE TOWN STPG SIGN (23)																						
Townname	County	TOWN MILEAGE	NEW SIGNS (SF)		EXISTING SIGNS (EA)				EXIST POST (EA)		NUMBER OF NEW POSTS (EA)				SQUARE STEEL (IN)			TUBULAR STEEL Ø (IN)				
			TYPE A	TYPE B	RETAIN	SALVAGE FROM	SALVAGE TO	REMOVE	RETAIN	REMOVE	1.75"	2"	2.5"	TOTAL POSTS	1.75	2.00	2.50	FOUNDATION	3.00	3.50	4.00	5.00
											(LB / FT)				(LB / FT)				(LB / FT)			
											1.88	2.42	3.35		1.88	2.42	3.35		7.60	9.00	10.80	14.60
Royalton	Windsor	2.32	189.8	0	4	4	4	36	0	0	0	30	0	30	0	450	0					
Tunbridge	Orange	7.934	743.6	0	47	7	7	122	0	0	0	133	0	133	0	1995	0					
Chelsea	Orange	6.96	539.5	0	59	5	5	107	0	0	0	92	4	96	0	1380	60					
Washington	Orange	7.025	320.1	0	42	3	3	66	2	0	12	61	0	73	180	915	0					
Orange	Orange	1.79	56.7	0	3	1	1	9	0	0	0	11	0	11	0	165	0					
Barre (Town)	Washington	1.124	258	0	29	4	4	50	0	0	0	37	4	41	0	555	60					
					Sub-Total			24	390			Sub-Total			180	5460	120					
Estimated Salvaged Street Name Signs to be erected onto new posts =							25															
Salvaged To signs to be added to Remove total =								24														

REFER TO ADDITIONAL PAGES
ON THIS SHEET
FOR SIGN SUMMARY SHEET

SEE SHEET 79 OF 80
FOR DAMAGED SIGN REPLACEMENT

PROJECT NAME: ROYALTON - BARRE TOWN	
PROJECT NUMBER: STPG SIGN (23)	
FILE NAME: 09C028_TS.DGN	PLOT DATE: 16-JUN-2009
PROJECT LEADER: N. AVERY	DRAWN BY: N. AVERY
DESIGNED BY: N. AVERY	CHECKED BY: A. GAMBLE
TOWN TOTAL SIGN SUMMARY SHEET	SHEET 78 OF 80

TOWN TOTAL SIGN SUMMARY SHEET

VT ROUTE 110 ROYAL TON - BARRE TOWN STPG SIGN (23)

As of : 10/12/2010					Royalton - Barre Town				Page 1 of 2
ITEM #	675.20	675.341	675.50	675.60					
LINE #	0030	0035	0040	0045					
Plan Page #	SIGN AREA	POST LENGTH	REMOVAL	SALVAGE					
	SQ FT	FT	EA	EA					
8 of 80	27.50	69.00	8	0					0
9 of 80	40.00	100.75	8	0					0
10 of 80	52.75	129.00	7	0					0
11 of 80	20.00	58.75	6	4					0
12 of 80	36.00	55.00	7	0					0
13 of 80	13.50	13.50	1	0					0
14 of 80	32.34	63.00	7	0					0
15 of 80	22.50	56.50	5	0					0
16 of 80	34.00	64.75	6	0					0
17 of 80	17.50	65.25	3	2					0
18 of 80	28.25	67.00	7	0					0
19 of 80	47.75	121.25	6	0					0
20 of 80	33.75	80.00	7	0					0
21 of 80	37.75	88.75	8	0					0
22 of 80	52.75	135.25	6	0					0
23 of 80	35.25	80.00	8	0					0
24 of 80	47.75	109.00	8	0					0
25 of 80	49.25	103.50	6	0					0
26 of 80	36.75	69.50	8	0					0
27 of 80	44.75	148.25	6	0					0
28 of 80	41.50	81.00	5	0					0
29 of 80	37.50	86.00	7	0					0
30 of 80	43.00	92.50	6	0					0
31 of 80	17.50	37.25	3	0					0
32 of 80	21.25	50.00	4	0					0
33 of 80	28.50	76.75	5	3					0
34 of 80	34.00	73.25	4	0					0
35 of 80	23.09	75.75	8	1					0
36 of 80	34.50	84.75	8	0					0
37 of 80	38.00	88.25	7	1					0
38 of 80	27.75	102.50	6	0					0
39 of 80	25.94	56.00	5	1					0
40 of 80	30.25	43.50	5	2					0
41 of 80	17.50	41.00	3	0					0
42 of 80	33.50	62.25	7	1					0
43 of 80	21.00	44.50	7	0					0
44 of 80	31.50	104.75	4	1					0
45 of 80	25.25	70.50	7	0					0
46 of 80	26.50	69.75	4	2					0
47 of 80	24.50	83.75	5	1					0
48 of 80	19.44	41.25	4	0					0
49 of 80	26.00	44.00	6	0					0
50 of 80	28.25	55.50	4	0					0
51 of 80	35.25	69.50	7	0					0
52 of 80	40.75	95.50	5	0					0
53 of 80	30.50	75.25	6	0					0
PG 1 TOTALS	1472.81	3485.00	270	19					

As of : 10/12/2010					Royalton - Barre Town				Page 2 of 2
ITEM #	675.20	675.341	675.50	675.60					
LINE #	0030	0035	0040	0045					
Plan Page #	SIGN AREA	POST LENGTH	REMOVAL	SALVAGE					
	SQ FT	FT	EA	EA					
54 of 80	37.59	102.25	8	0					0
55 of 80	23.50	65.75	10	0					0
56 of 80	18.75	42.50	3	0					0
57 of 80	23.75	53.25	4	0					0
58 of 80	21.25	52.00	4	0					0
59 of 80	31.25	69.75	5	0					0
60 of 80	18.75	57.25	3	2					0
61 of 80	17.51	54.25	3	1					0
62 of 80	35.75	84.25	7	0					0
63 of 80	41.00	106.00	7	1					0
64 of 80	25.51	100.25	15	0					0
65 of 80	19.29	96.50	8	0					0
66 of 80	37.17	100.75	7	0					0
67 of 80	19.50	55.00	4	1					0
68 of 80	29.84	83.00	5	0					0
69 of 80	25.50	59.25	5	2					0
70 of 80	23.42	43.50	9	0					0
71 of 80	22.50	41.50	9	2					0
72 of 80	24.00	28.25	2	0					0
73 of 80	30.25	84.00	6	2					0
74 of 80	30.25	43.75	10	0					0
75 of 80	37.94	82.75	6	0					0
76 of 80	28.00	80.00	9	0					0
77 of 80	6.25	14.00	0	0					0
PG 2 TOTALS	628.49	1599.75	147	11					
PG 1 TOTALS	1472.81	3485.00	270	19					
Final Total	2101.30	5084.75	417.00	30.00					

CPA
10/12/10
SEE SHEET 79 of 80
FOR DAMAGED SIGN REPLACEMENT

Table 6H-2. Meaning of Symbols on Typical Application Diagrams

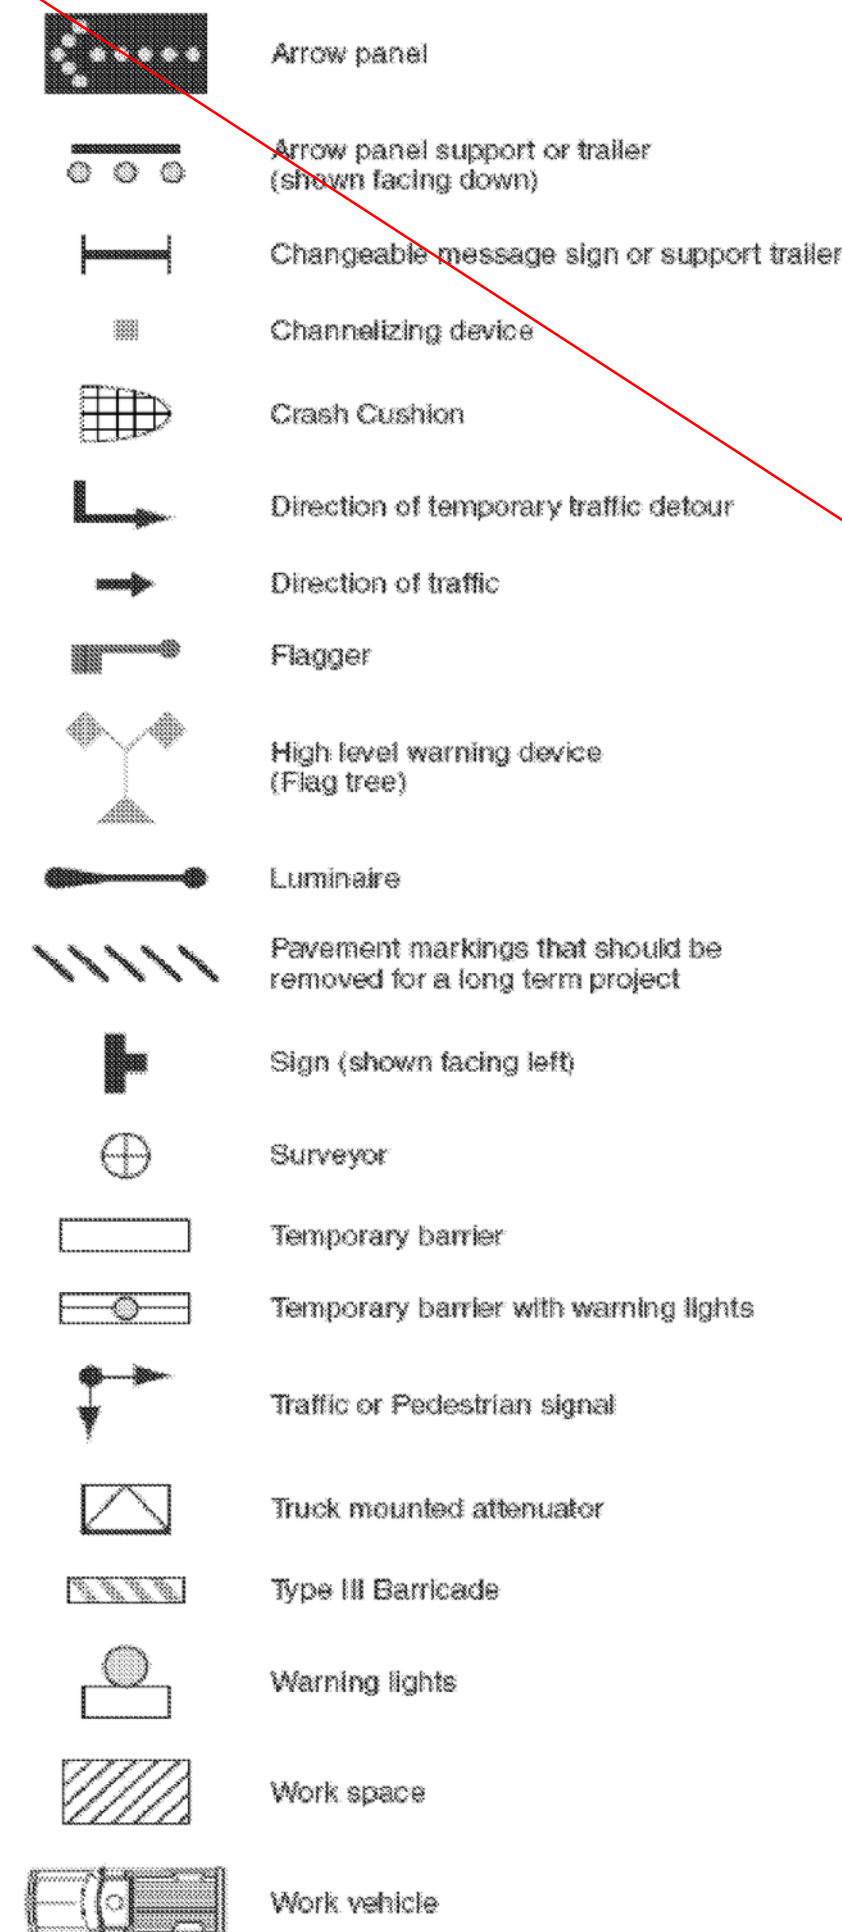


Figure 6E-1. Use of Hand-Signaling Devices by Flaggers

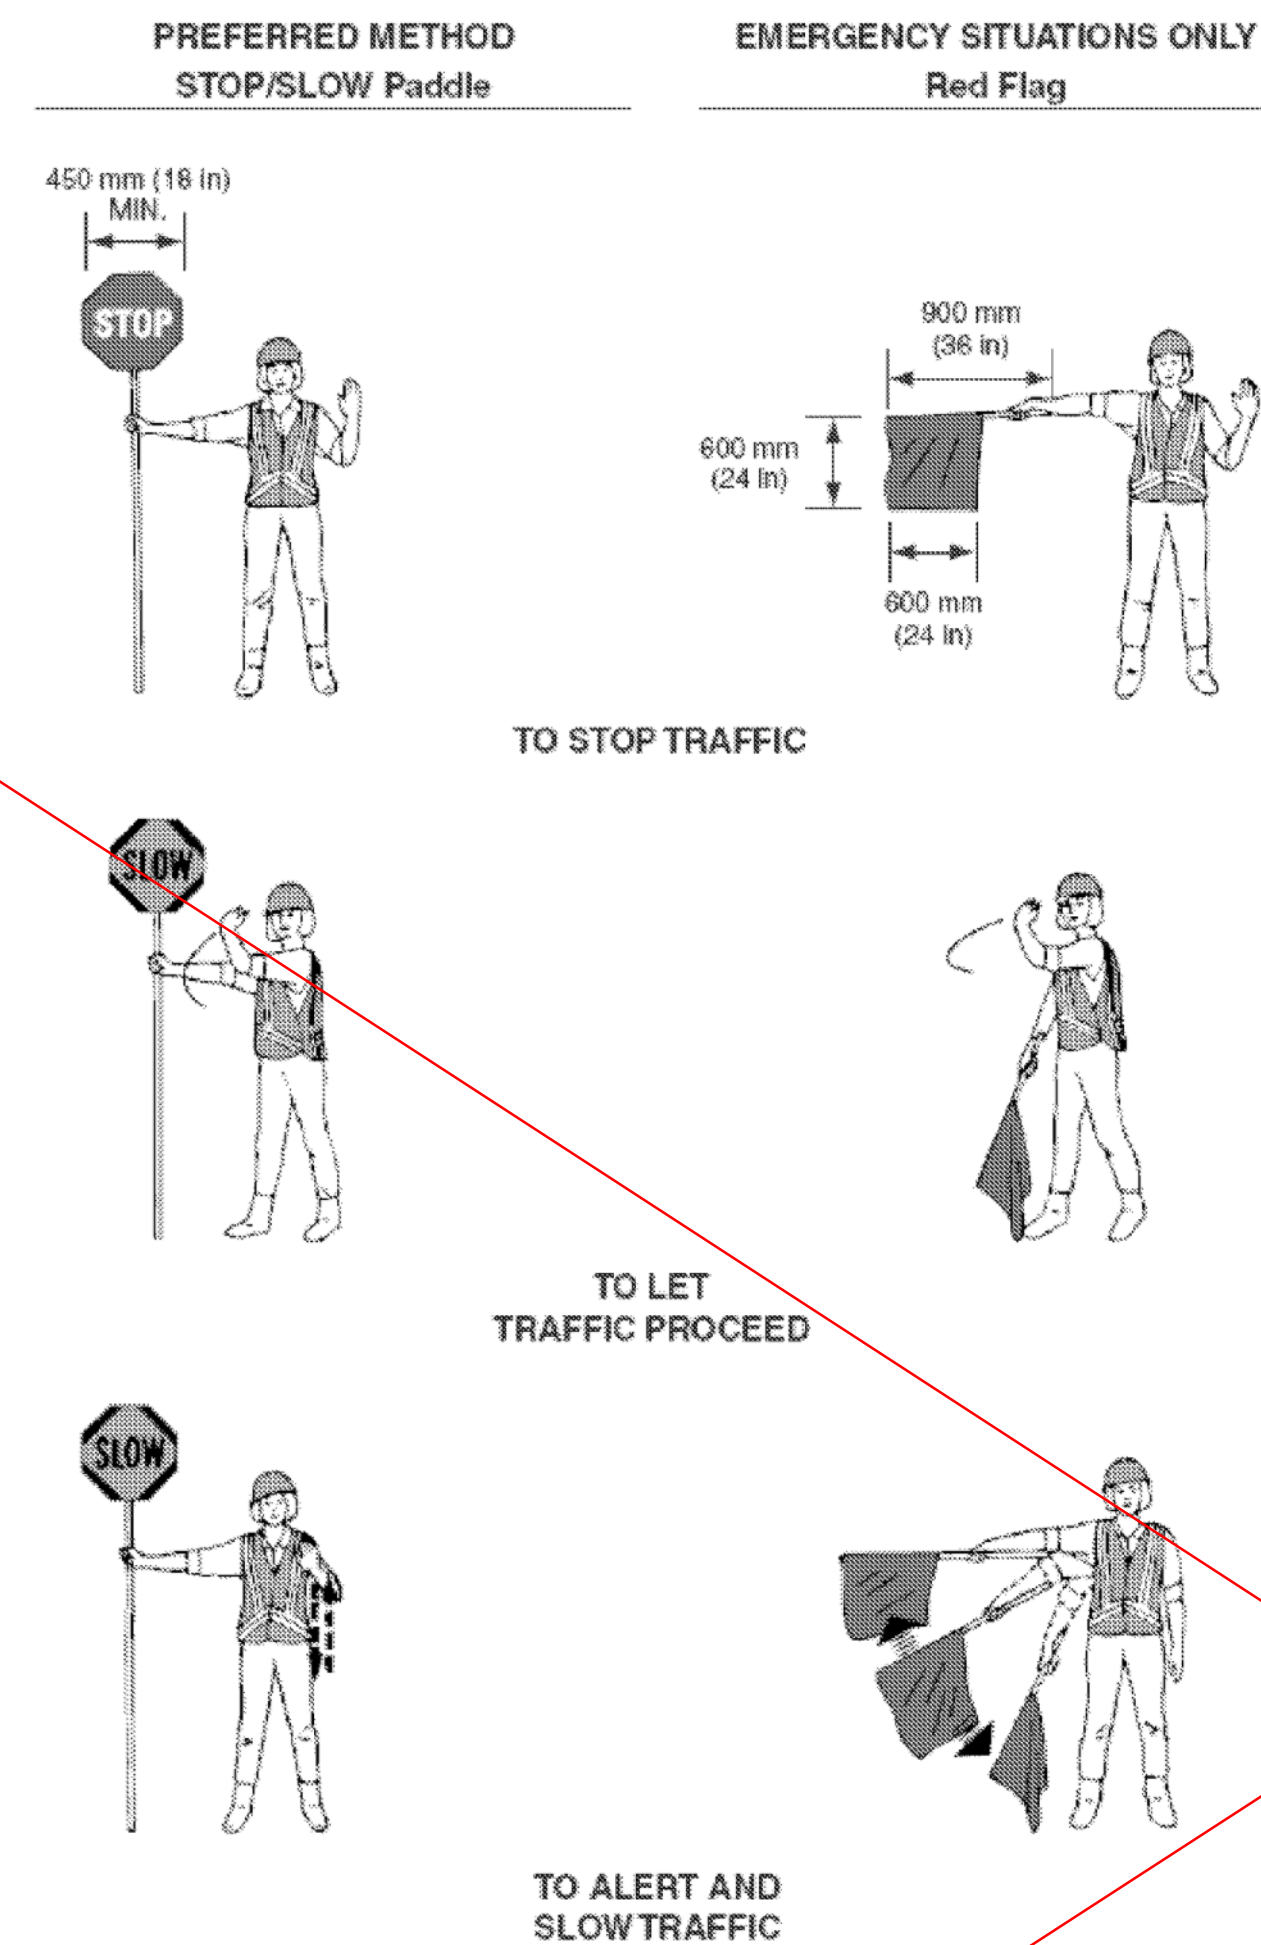


Figure 6C-2. Types of Tapers and Buffer Spaces

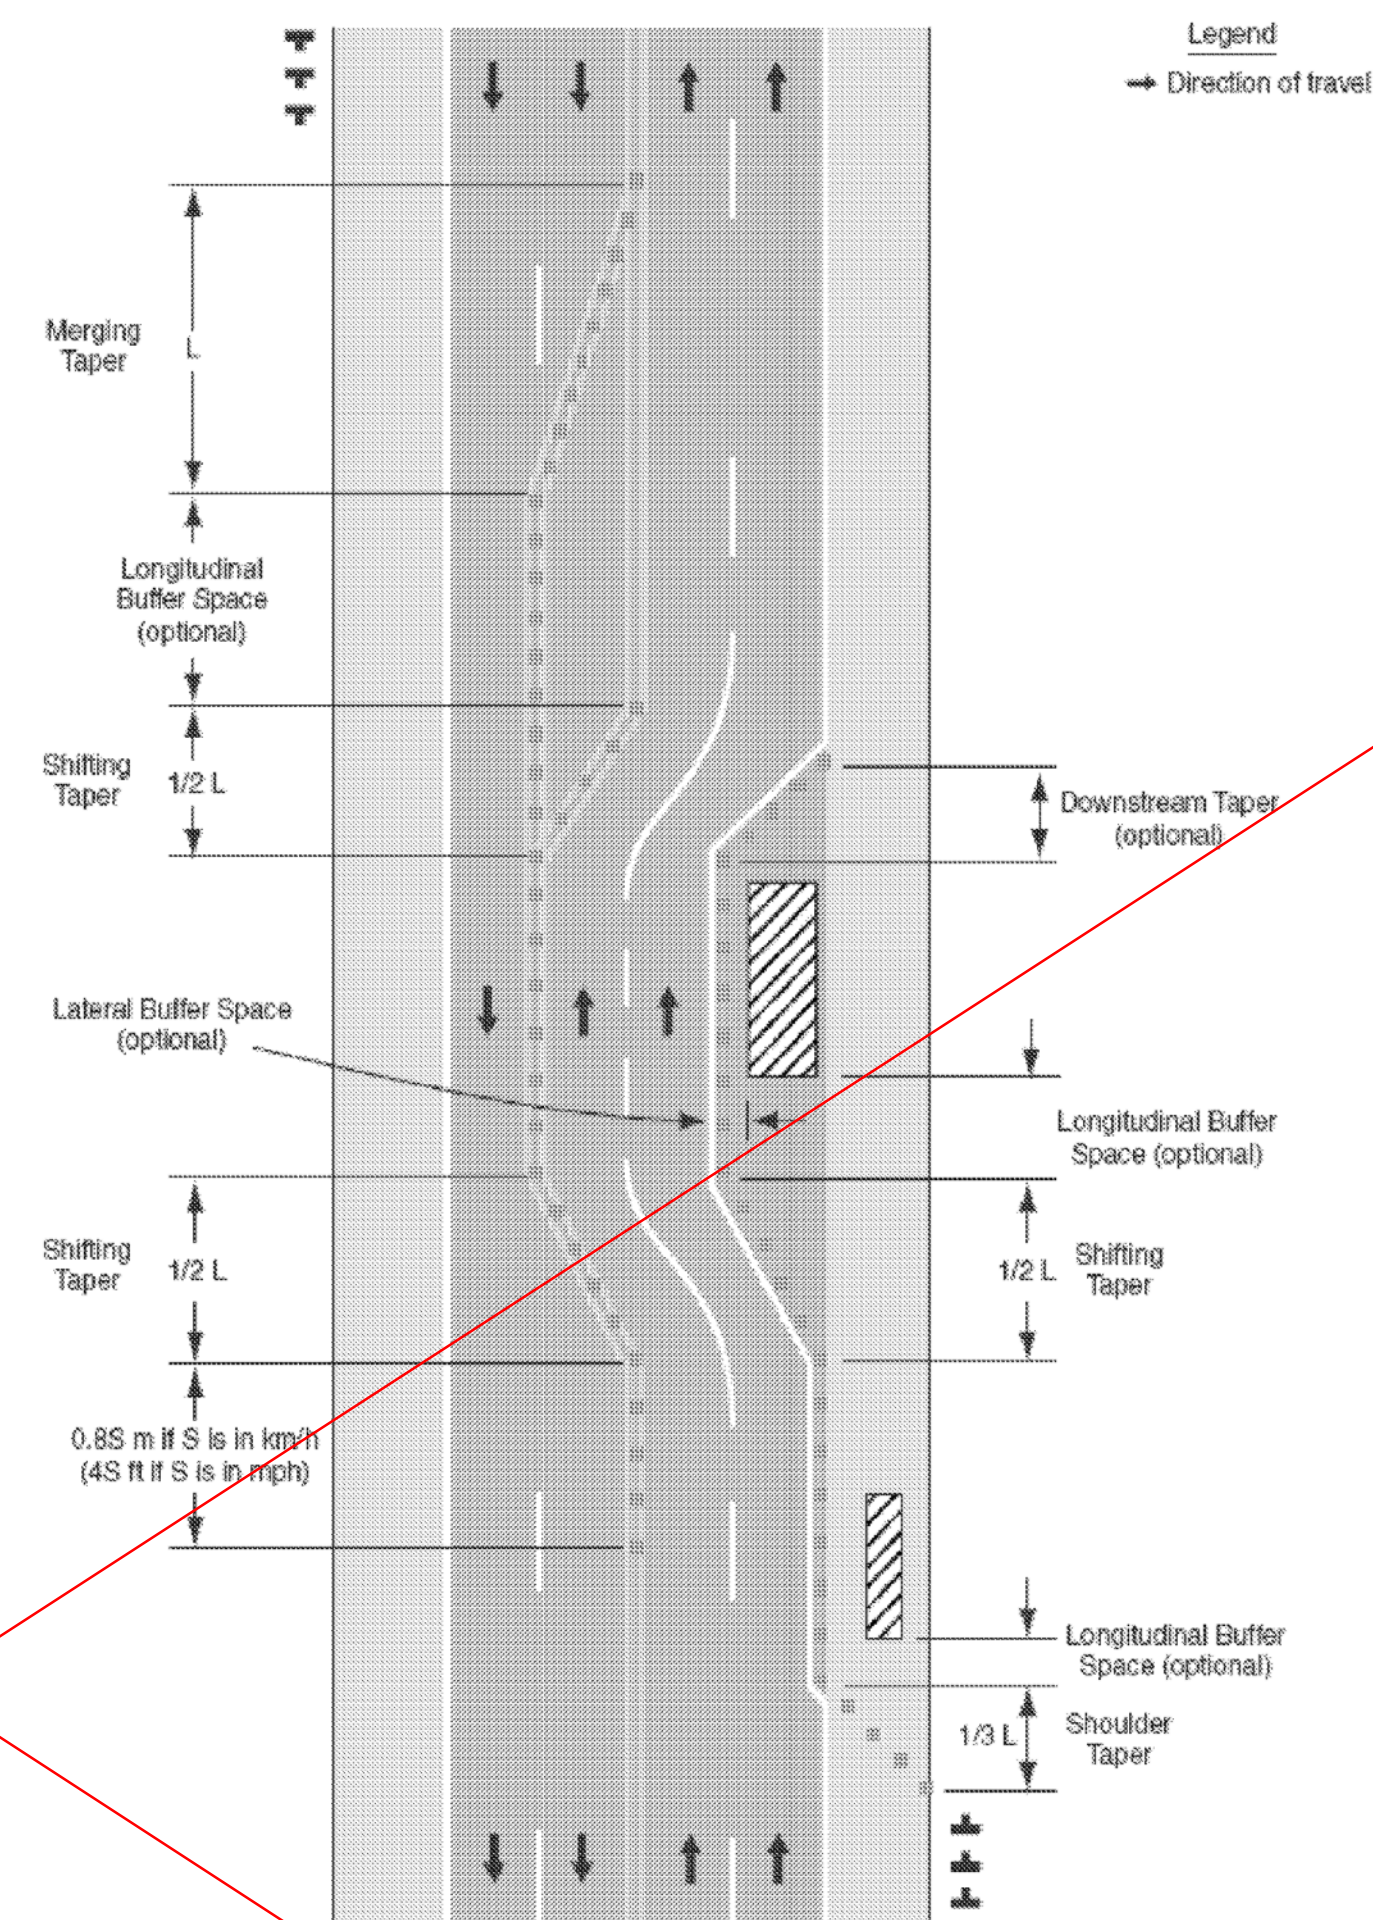


Figure 6H-1. Work Beyond the Shoulder (TA-1)

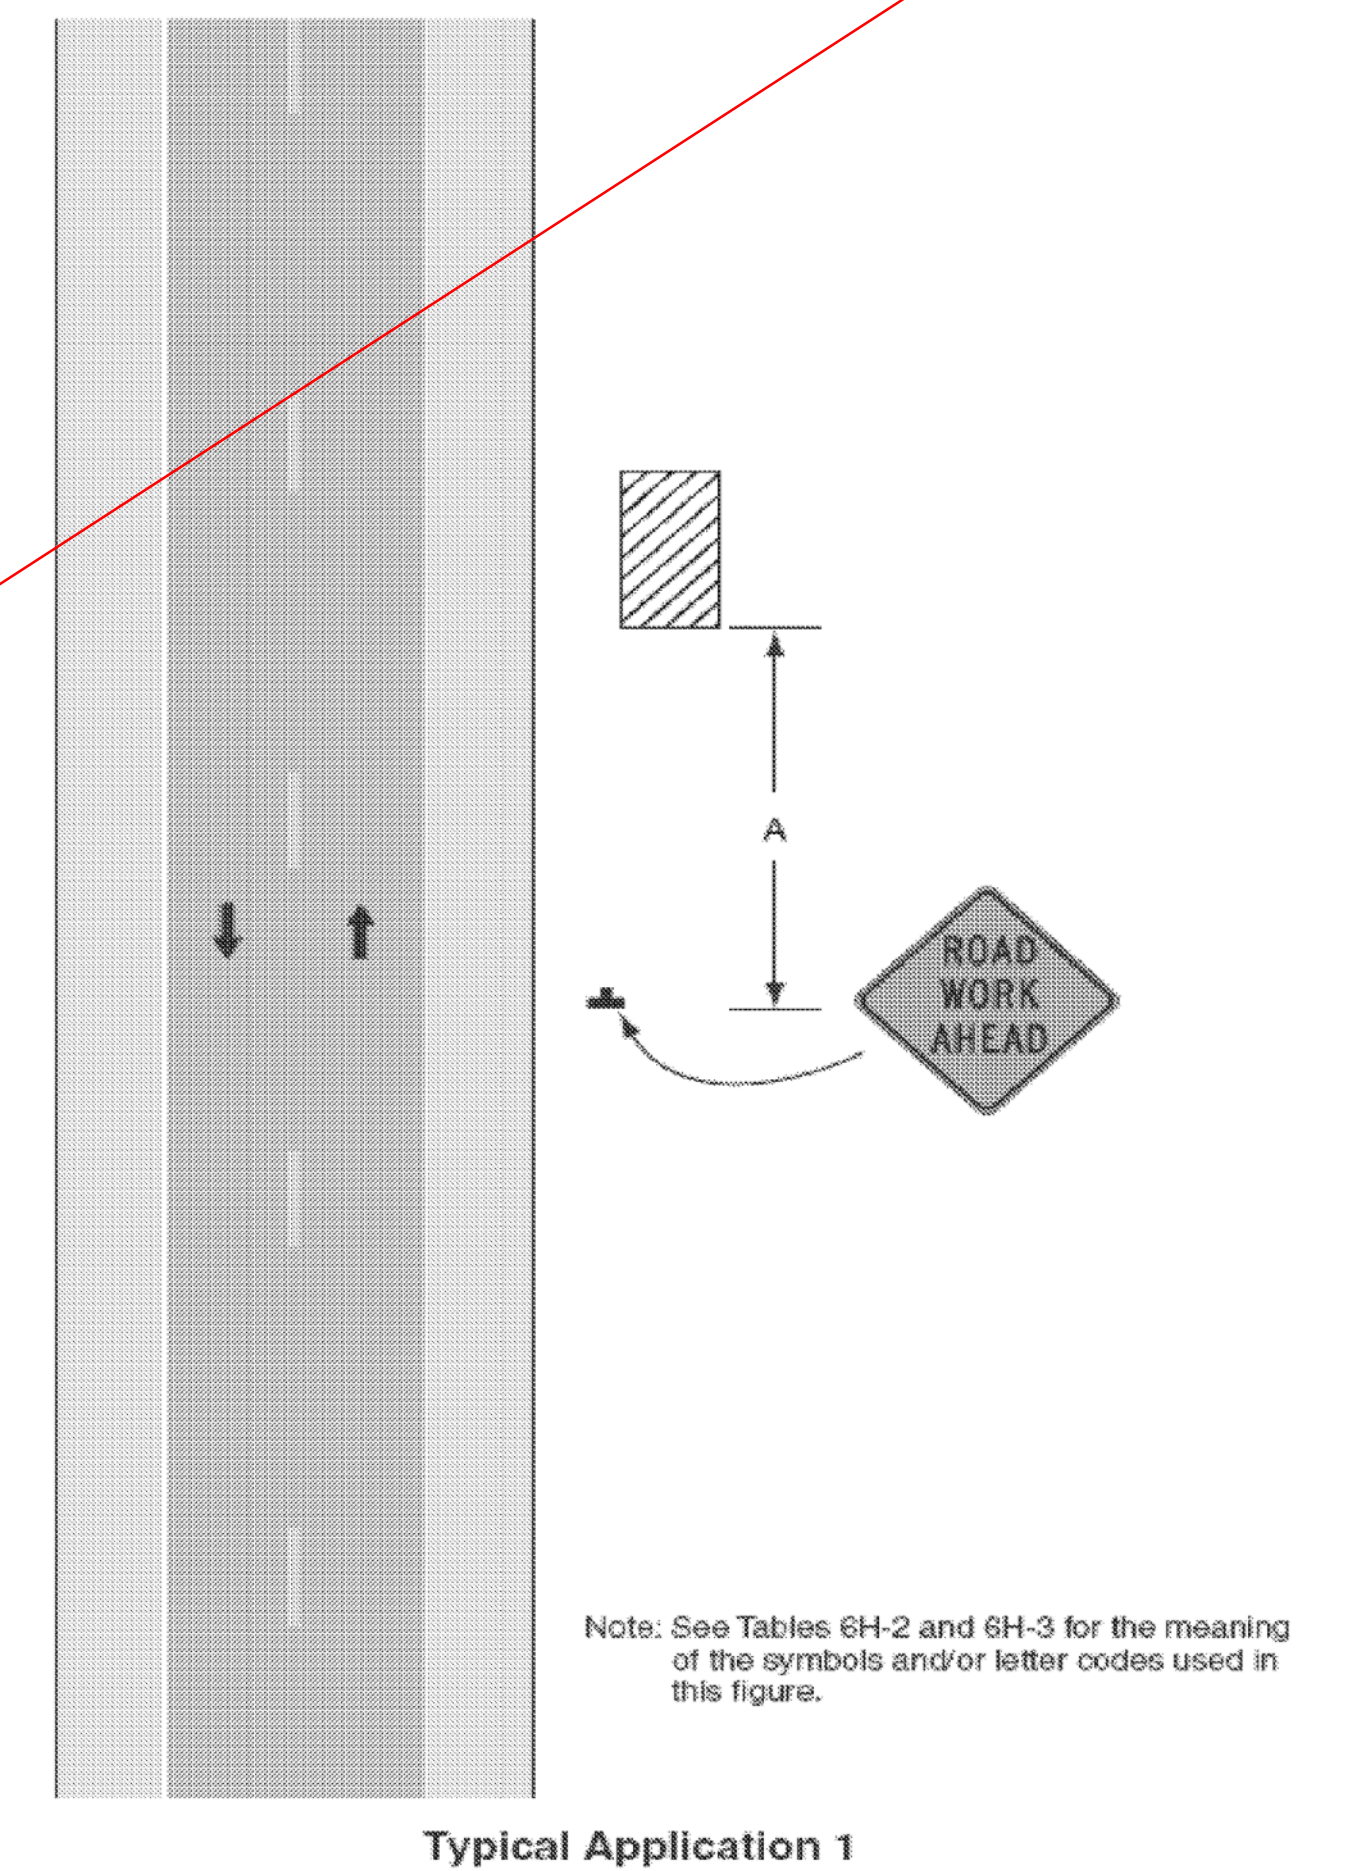


Table 6C-3. Taper Length Criteria for Temporary Traffic Control Zones

Type of Taper	Taper Length (L)*
Merging Taper	at least L
Shifting Taper	at least 0.5L
Shoulder Taper	at least 0.33L
One-Lane, Two-Way Traffic Taper	30 m (100 ft) maximum
Downstream Taper	30 m (100 ft) per lane

Table 6C-4. Formulas for Determining Taper Lengths

Speed Limit (S)	Taper Length (L) Meters	Speed Limit (S)	Taper Length (L) Feet
60 km/h or less	$L = \frac{WS^2}{155}$	40 mph or less	$L = \frac{WS^2}{80}$
70 km/h or more	$L = \frac{WS}{1.6}$	45 mph or more	$L = WS$

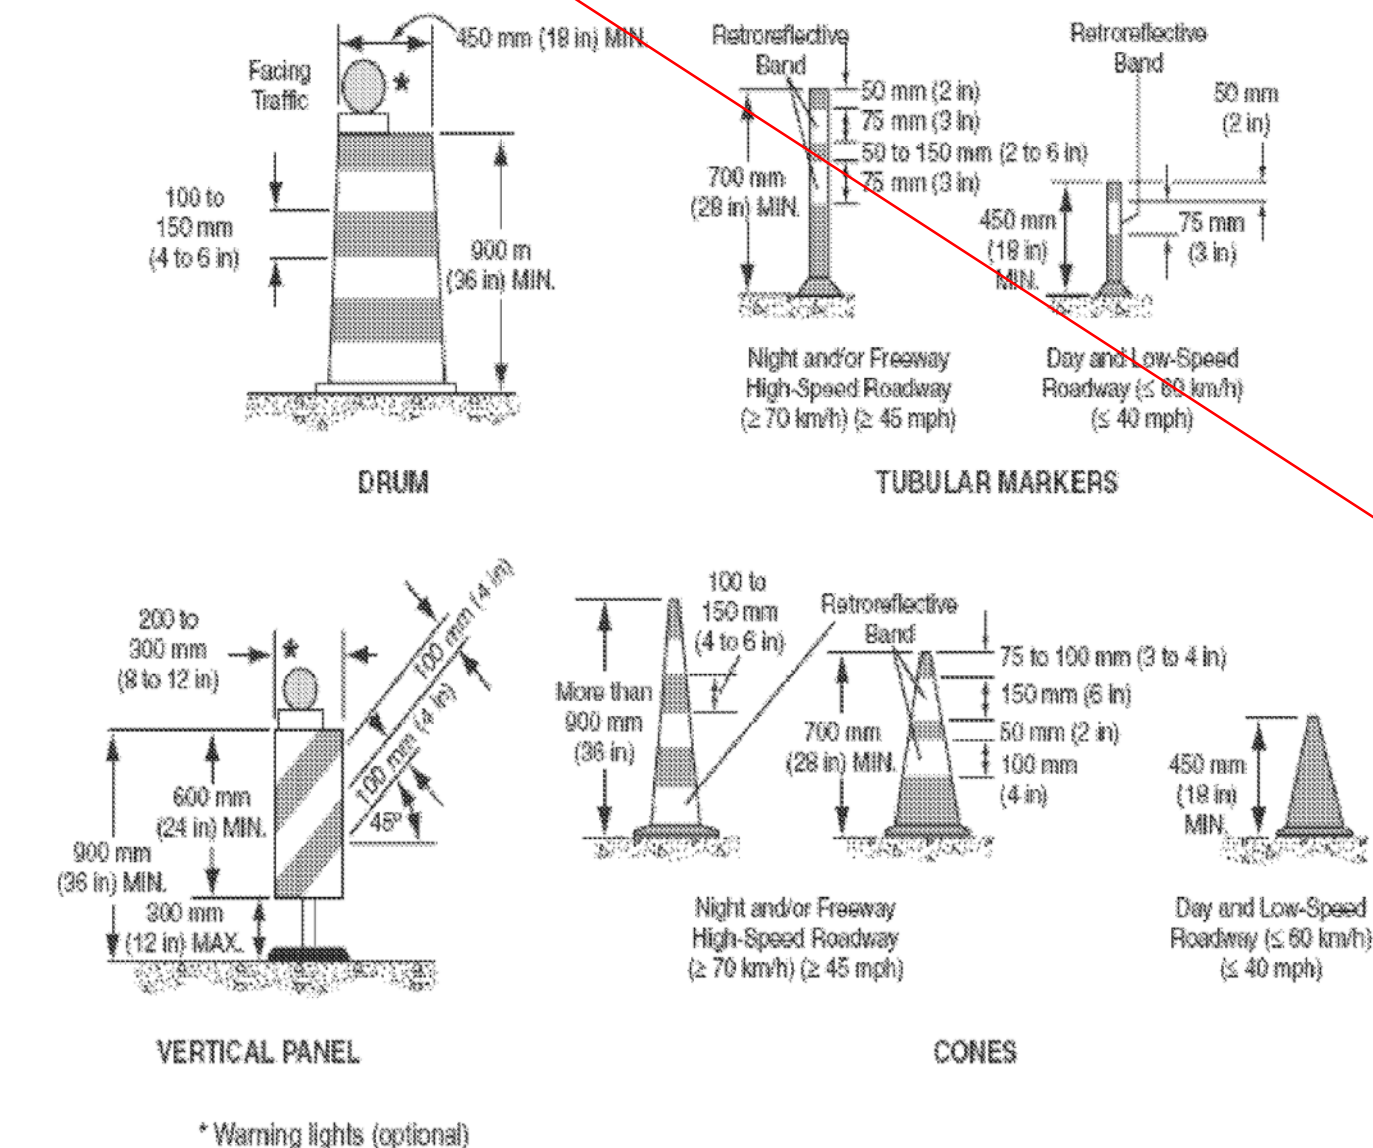
Where: L = taper length in meters (feet)
W = width of offset in meters (feet)
S = posted speed limit, or off-peak 85th-percentile speed prior to work starting, or the anticipated operating speed in km/h (mph)

Table 6H-3. Meaning of Letter Codes on Typical Application Diagrams

Road Type	Distance Between Signs**		
	A	B	C
Urban (low speed)*	30 (100)	30 (100)	30 (100)
Urban (high speed)*	100 (350)	100 (350)	100 (350)
Rural	150 (500)	150 (500)	150 (500)
Expressway / Freeway	300 (1,000)	450 (1,500)	800 (2,640)

* Speed category to be determined by highway agency
** Distances are shown in meters (feet). The column headings A, B, and C are the dimensions shown in Figures shown on the Traffic Control Detail Sheets. The A dimension is the distance from the transition or point of restriction to the first sign. The B dimension is the distance between the first and second signs. The C dimension is the distance between the second and third signs. (The third sign is the first one in a three-sign series encountered by a driver approaching a TTC zone.)

Figure 6F-7. Channelizing Devices (Sheet 1 of 2)



TEMPORARY TRAFFIC CONTROL NOTES

- ALL TEMPORARY TRAFFIC CONTROL SHALL BE IN ACCORDANCE WITH THESE PROJECT PLANS, APPLICABLE VTRANS E-SERIES STANDARD DRAWINGS, AND THE MANUAL ON UNIFORM TRAFFIC CONTROL DEVICES (MUTCD), DATED 2003, AND ITS LATEST REVISIONS, OR AS DIRECTED BY THE RESIDENT ENGINEER. IF THE CONTRACTOR DOES NOT WISH TO FOLLOW THE TEMPORARY TRAFFIC CONTROL PROVIDED, HE/SHE MAY SUBMIT AN ALTERNATE PROPOSAL AT THE PRE-CONSTRUCTION MEETING IMPLEMENTING THE PROPOSED CHANGES FOR REVIEW AND APPROVAL BY THE RESIDENT ENGINEER.
- THE CONTRACTOR MUST PROVIDE ACCESS THROUGH THE WORK ZONE FOR EMERGENCY VEHICLES AT ALL TIMES.
- THE CONTRACTOR SHALL CONDUCT THE WORK AT ALL TIMES IN SUCH A MANNER AND IN SUCH SEQUENCE SO AS TO ENSURE THE LEAST INTERFERENCE WITH TRAFFIC OCCURS.
- SIGNS SHALL ONLY BE VISIBLE TO MOTORIST AT THE TIMES WHEN THE MESSAGE IS PERTINENT, I.E. A "FLAGGER AHEAD" SIGN SHALL ONLY BE VISIBLE TO MOTORIST WHEN THE FLAGGER IS ACTUALLY PRESENT PERFORMING THEIR DUTIES.
- PAYMENT FOR CONSTRUCTION SIGNING WILL BE MADE UNDER CONTRACT ITEM 641.0.

SEE ADDITIONAL PAGE ON THIS SHEET FOR DAMAGED SIGN REPLACEMENT SUMMARY

PROJECT NAME: ROYALTON - BARRE TOWN

PROJECT NUMBER: STPG SIGN (23)

FILE NAME: 09c028_TS.DGN
PROJECT LEADER: N. AVERY
DESIGNED BY: N. AVERY
TRAFFIC CONTROL I

PLOT DATE: 16-JUN-2009
DRAWN BY: N. AVERY
CHECKED BY: A. GAMBLE
SHEET 79 OF 80

As of : 1/25/2011		Royalton - Barre Town		Sign Damage Replaceme	
ITEM #	675.20	675.341	675.50	675.60	
LINE #	0030	0035	0040	0045	
Plan Page #	SIGN AREA	POST LENGTH	REMOVAL	SALVAGE	
	SQ FT	FT	EA	EA	
Royalton NB 1.51	6.25				0
Royalton SB .12	2.50				
Royalton SB .51	5.00				0
Royalton SB .60	12.00				0
Tunbridge SB 2.219	0.00	16.00			0
Tunbridge NB .575	6.25				0
Tunbridge NB 1.96	6.25				0
Tunbridge NB 2.380	3.75				
Tunbridge NB 3.180	5.00				
Tunbridge SB 2.755	6.25				0
Tunbridge SB 1.24	6.25				
Tunbridge NB 6.701			1		0
Tunbridge NB 6.701					1
Tunbridge NB 6.701		4.00			0
Tunbridge NB 7.13			2		
Tunbridge NB 7.20					2
Chelsea NB 0.00	0.84				
Chelsea NB 2.821	7.50				0
Chelsea NB 3.990	6.25				0
Chelsea SB 4.231	9.00				
Chelsea SB 4.05	3.00				0
Chelsea SB 3.366	11.00	15.50			0
Chelsea SB 1.990	5.00				0
Chelsea SB 0.60	5.00		0		0
Washington NB 4.762	5.00		0		0
Washington SB 1.395	3.00		0		0
Washington SB 4.600	6.25		0		0
Orange SB .320	6.25	17.00	0		0
Barretown SB 1.02	5.00				
Barretown SB .730	5.00				
PG 3 TOTALS	137.59	52.50	3	3	

GRAND TOTAL

PEW
1/25/11

CPH
or

