


- INDEX OF SHEETS**
- 1 TITLE SHEET
 - 2 QUANTITY SHEET
 - 3,4,5,6 ROUTE QUANTITIES SHEETS
 - 7 PAVEMENT MARKING LOCATION DETAIL
 - 8 RUMBLE STRIP DETAIL SHEET
 - 9-13 PAVEMENT MARKING DETAILS SHEETS

- STANDARDS**
- E-106 TRAFFIC CONTROL MISCELLANEOUS DETAILS 03/01/04
 - E-110 TRAFFIC CONTROL FOR TYPICAL MOVING MAINTENANCE OPERATIONS 08/08/95

STATE OF VERMONT AGENCY OF TRANSPORTATION




PROPOSED IMPROVEMENT STATEWIDE NATIONAL HIGHWAY SYSTEM MARKING NHG MARK (203)

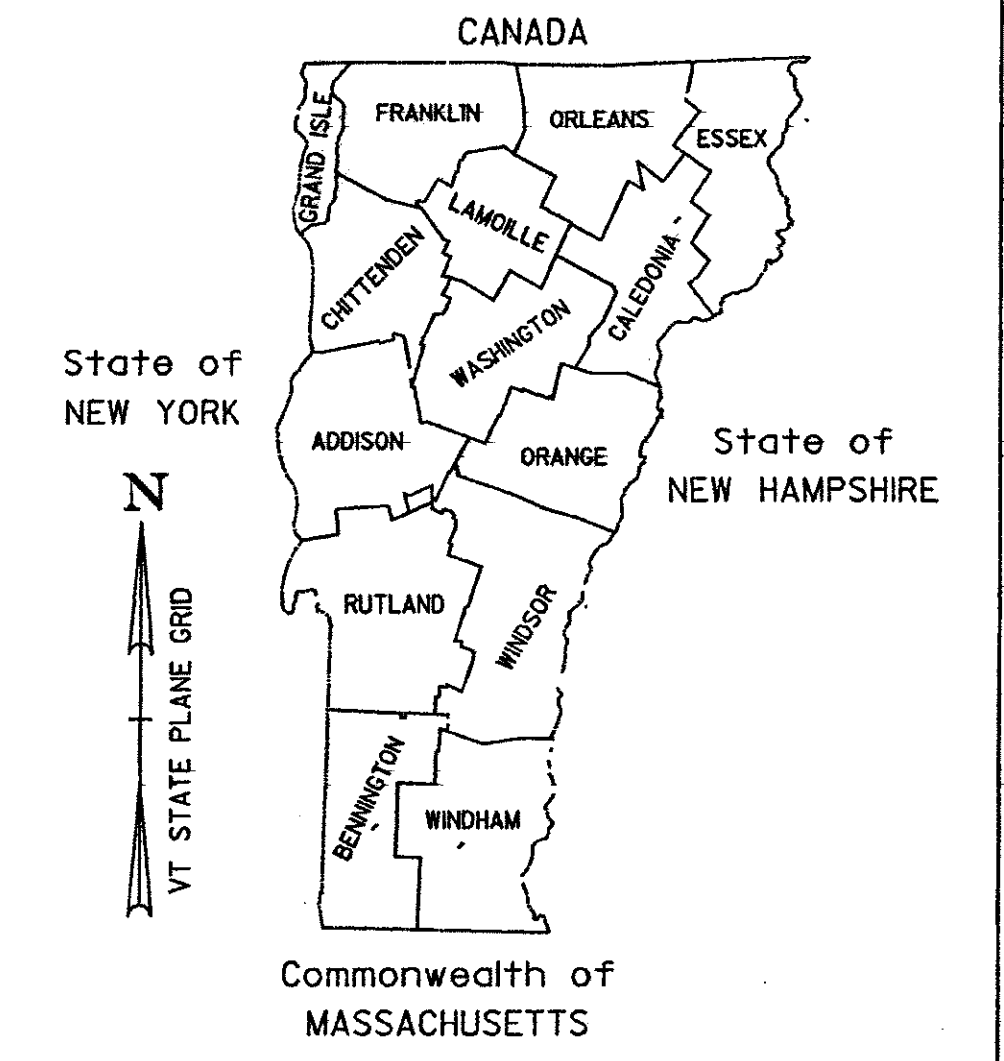

**PROPOSED IMPROVEMENT
NATIONAL HIGHWAY SYSTEM
PAVEMENT MARKING**

WORK TO BE PERFORMED UNDER THIS PROJECT INCLUDES GRINDING CENTERLINE RUMBLE STRIPS, NEW PAVEMENT MARKINGS INCLUDING CENTERLINES, EDGELINES, LANE LINES, DASHED AND DOTTED ACCELERATION AND DECELERATION LANES, GORE MARKINGS, RAMP EDGELINES, STOP BARS AND STOP LETTERS, SYMBOLS, AND CROSSWALKS.

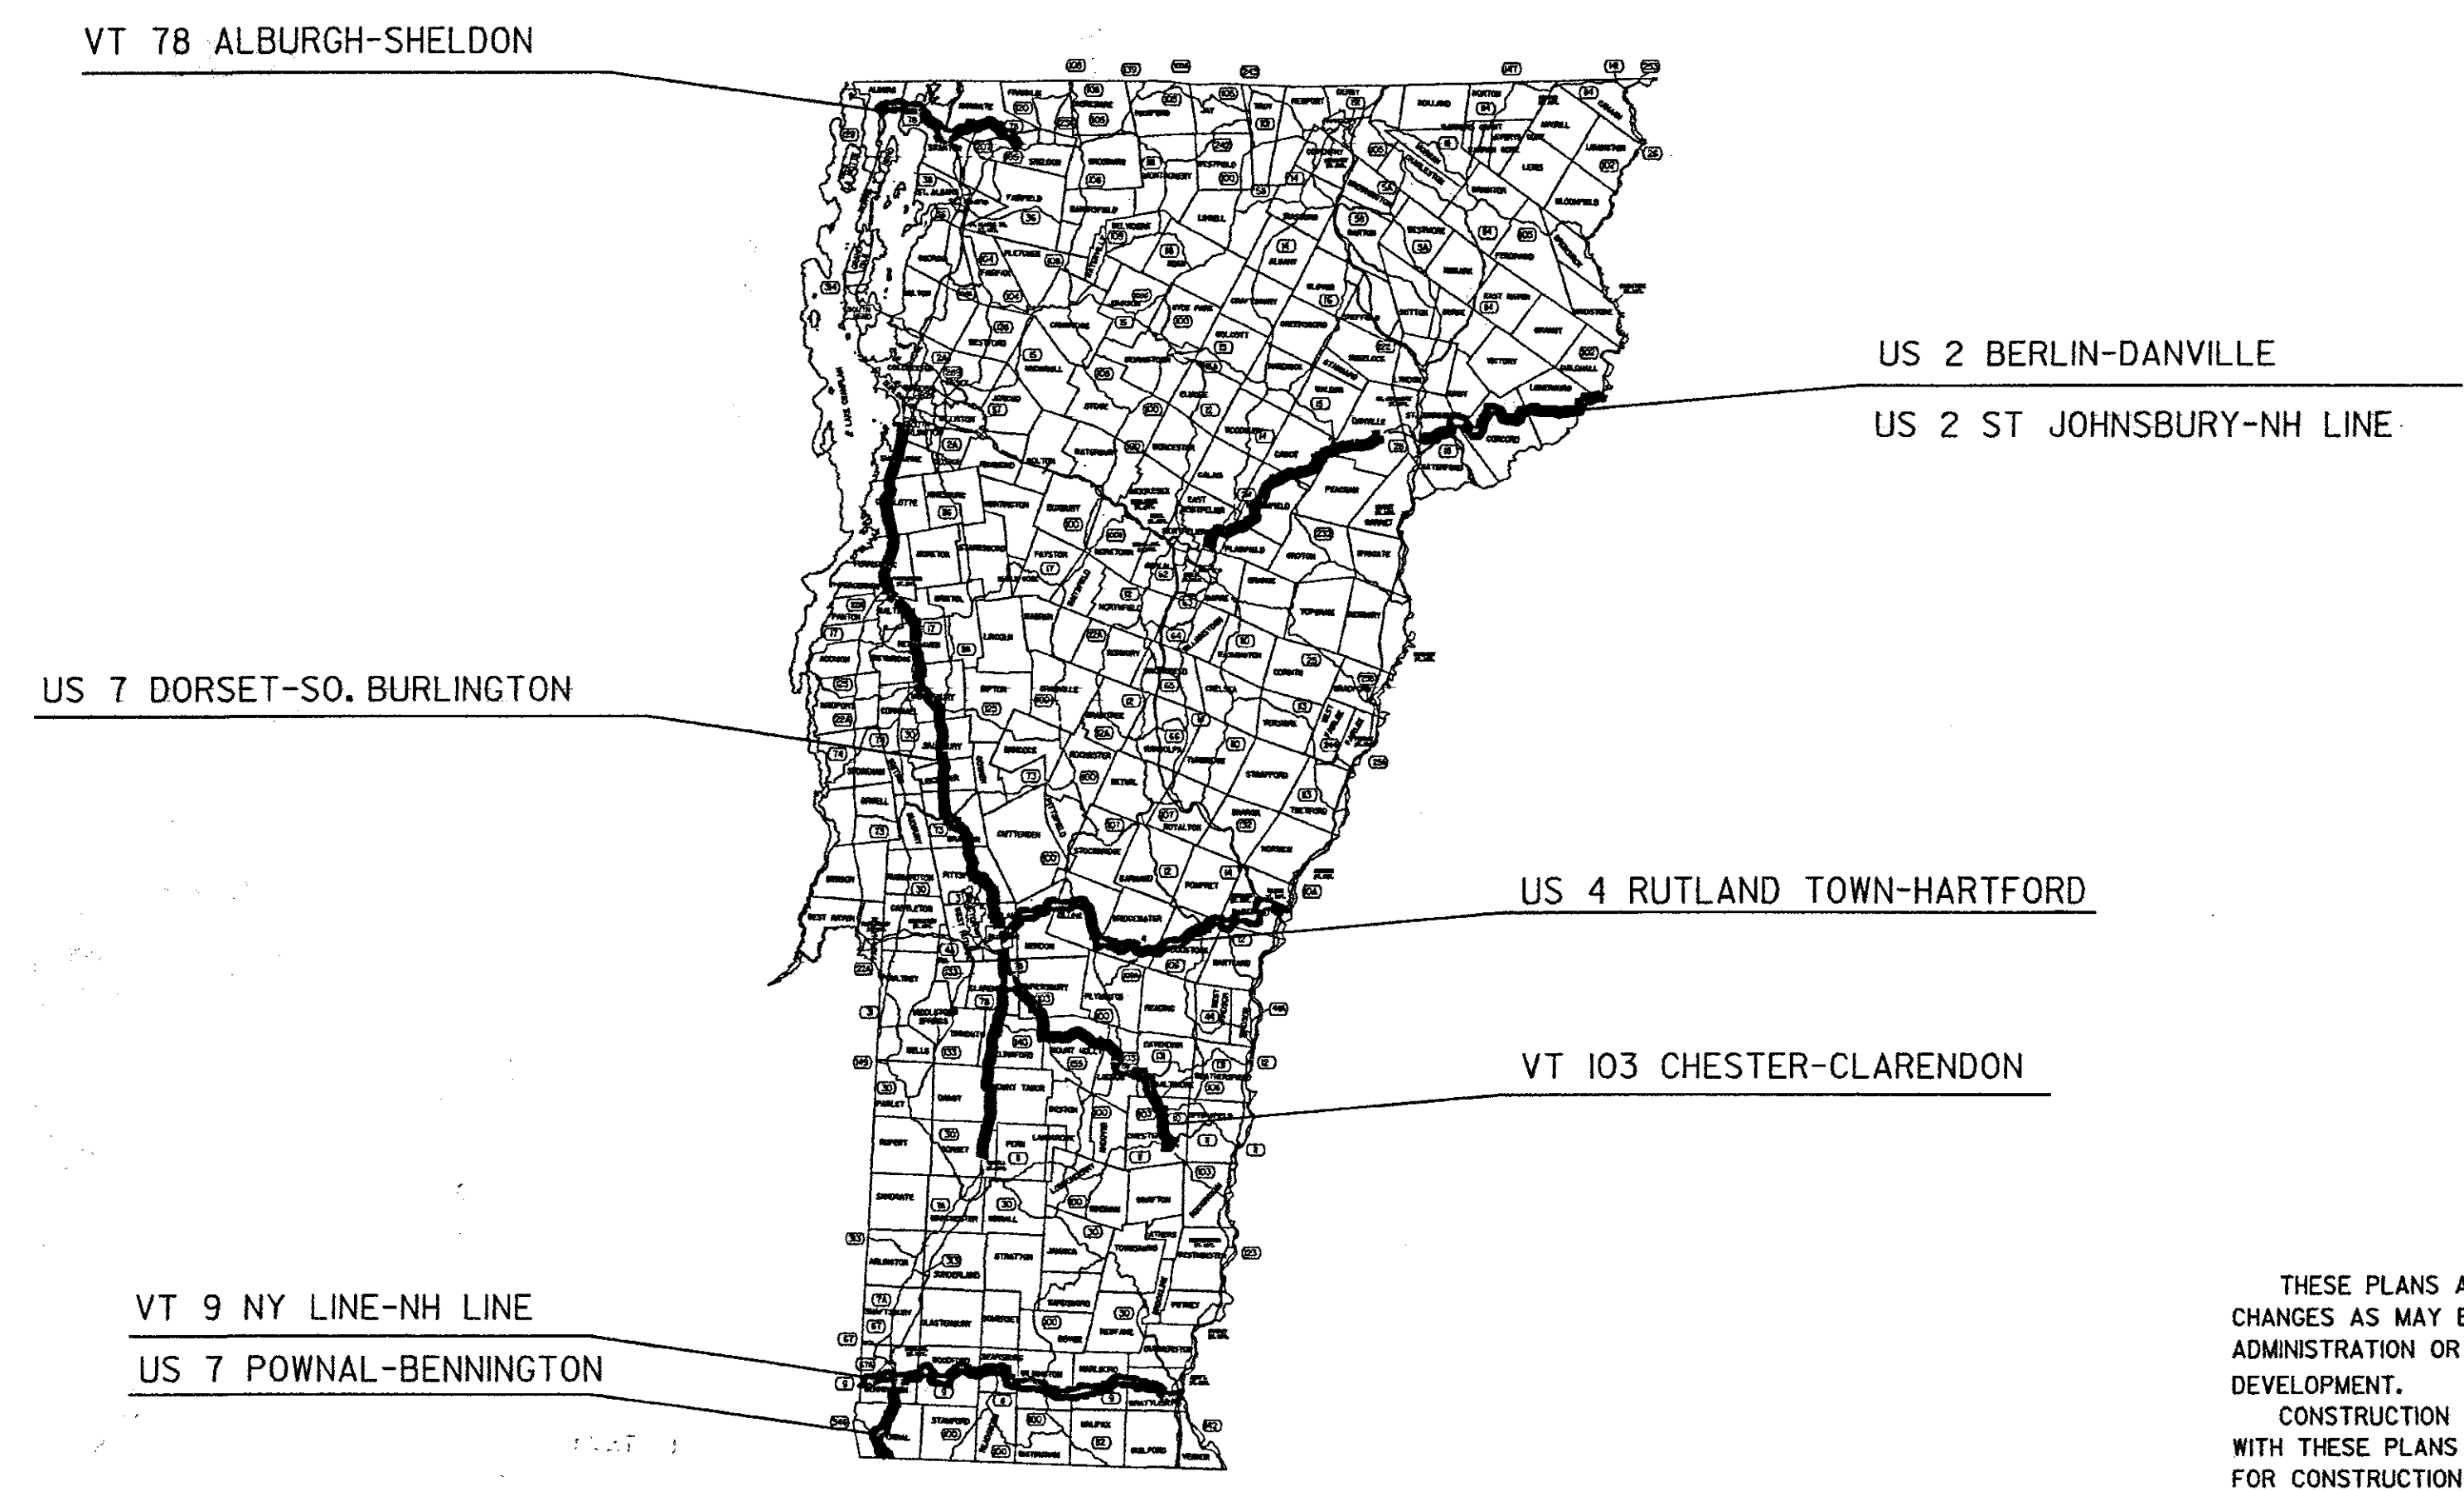

RECORD PLANS

CONTRACTOR: I & D SAFETY MARKINGS CORP. - BERLIN, VT

RESIDENT ENGINEER: BOB SUCKERT

CONSTRUCTION BEGAN: AUGUST 25, 2009

CONSTRUCTION COMPLETE: NOVEMBER 4, 2009

RECORD PLANS BY: BOB SUCKERT

I HEREBY CERTIFY THAT ALL THE CONSTRUCTION REQUIRED BY THIS SET OF DRAWINGS HAS BEEN ACCOMPLISHED AS INDICATED HEREIN.

BY *[Signature]* RESIDENT ENGINEER

DATE 2-2-11

NOTE: Any further information concerning final quantities, amounts or other details relative to this project may be found at Central Files in the electronic archives.

CONVENTIONAL SYMBOLS

COUNTY LINE	
TOWN LINE	
LIMITS OF ACCESS	
POINT OF ACCESS	
FENCE LINE	
STONE WALL	
TRAVELED WAY	
GUARD RAIL	
RAILROAD	
SURVEY LINE	
CULVERT	
POWER POLE	
TELEPHONE POLE	
TREES	
CONTROL OF ACCESS	
PROPERTY LINE	
R.O.W. TAKING LINE	
SLOPE RIGHTS	
TOP OF CUT	
TOE OF SLOPE	

SURVEYED BY : N/A
 SURVEYED DATE : N/A

DATUM

VERTICAL N/A
 HORIZONTAL N/A

BUILT AS DESIGNED

THESE PLANS ARE SUBJECT TO SUCH ENGINEERING CHANGES AS MAY BE REQUIRED BY THE FEDERAL HIGHWAY ADMINISTRATION OR THE DIRECTOR OF PROGRAM DEVELOPMENT.

CONSTRUCTION IS TO BE CARRIED ON IN ACCORDANCE WITH THESE PLANS AND THE STANDARD SPECIFICATIONS FOR CONSTRUCTION DATED 2006, AS APPROVED BY THE FEDERAL HIGHWAY ADMINISTRATION ON JUNE 15, 2006. FOR USE ON THIS PROJECT, INCLUDING ALL SUBSEQUENT REVISIONS AND SUCH REVISED SPECIFICATIONS AND SPECIAL PROVISIONS AS ARE INCORPORATED IN THESE PLANS.

DIRECTOR OF PROGRAM DEVELOPMENT

APPROVED *[Signature]* DATE 5-18-09

PROJECT MANAGER : A GAMBLE

PROJECT NAME : STATEWIDE
 PROJECT NUMBER : NHG MARK (203)

SHEET 1 OF 13 SHEETS