


# STATE OF VERMONT AGENCY OF TRANSPORTATION



## PROPOSED IMPROVEMENT TOWNS OF STAMFORD - ANDOVER COUNTIES OF BENNINGTON, WINDHAM AND WINDSOR VERMONT ROUTE 100


BEGINNING AT THE VERMONT-MASSACHUSETTS STATE LINE ON VT ROUTE 100 IN THE TOWN OF STAMFORD AT MILE MARKER 0.000 AND EXTENDING NORTHERLY ALONG VT ROUTE 100 FOR A DISTANCE OF 66.945 MILES TO THE ANDOVER-LUDLOW TOWN LINE IN THE TOWN OF ANDOVER AT MILE MARKER 0.208; EXCLUDING CLASS 1 SECTIONS WITHIN THE PROJECT CORRIDOR.  
LENGTH OF ROADWAY = 66.945 MILES  
LENGTH OF PROJECT = 66.416 MILES

WORK TO BE PERFORMED UNDER THIS PROJECT INCLUDES THE REMOVAL OF EXISTING SIGNS & POSTS AND THE INSTALLATION OF SIGNS & SIGN POSTS AND OTHER RELATED ITEMS.

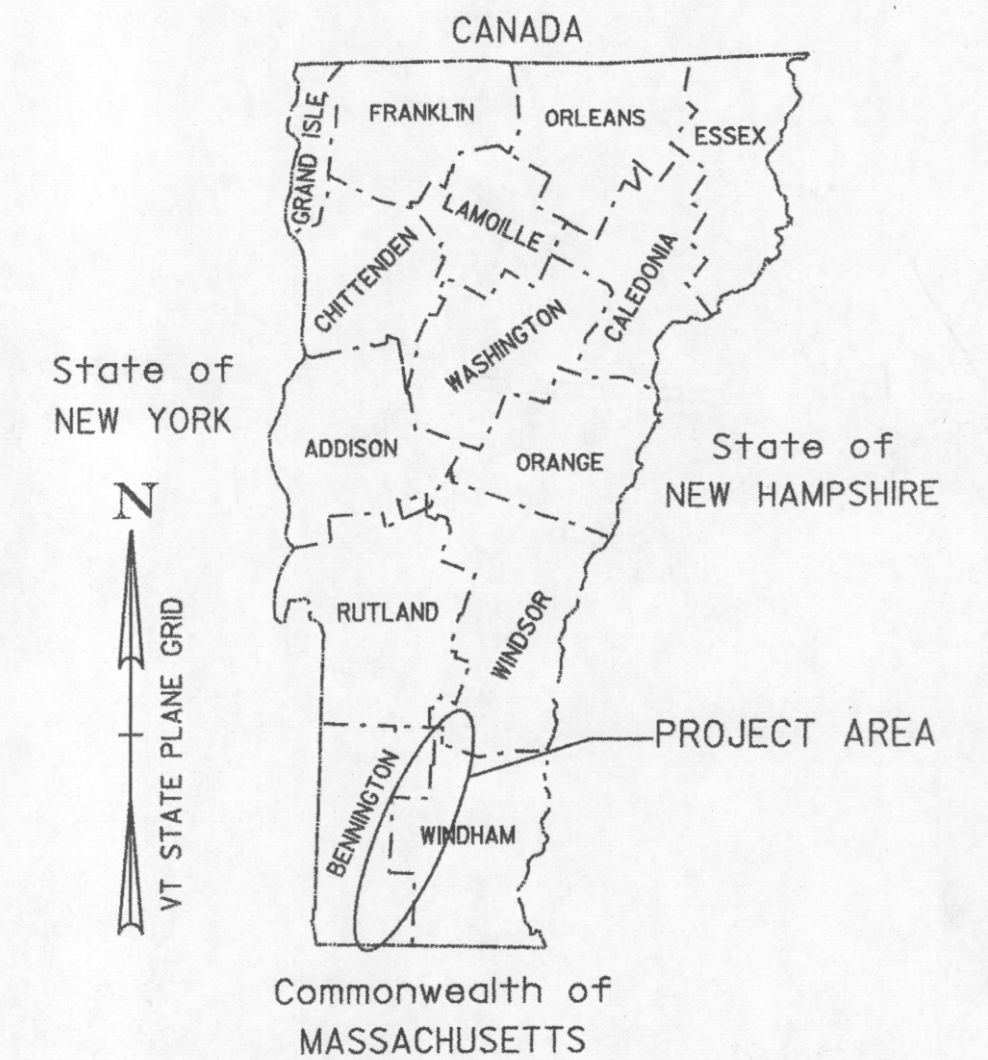

INDEX OF SHEETS  
SEE SHEET 2

RECORD PLANS	
CONTRACTOR:	F. R. LAFAYETTE, INC. - ESSEX JUNCTION, VT
RESIDENT ENGINEER:	MARK HAUGHWOUT
CONSTRUCTION BEGAN:	APRIL 7, 2010
CONSTRUCTION COMPLETE:	JULY 27, 2011
RECORD PLANS BY:	M. HAUGHWOUT & J. HYDE
I HEREBY CERTIFY THAT ALL THE CONSTRUCTION REQUIRED BY THIS SET OF DRAWINGS HAS BEEN ACCOMPLISHED AS INDICATED HEREIN.	
BY	<i>Mark W. Haughwout</i> RESIDENT ENGINEER
DATE	1/31/13
NOTE: Any further information concerning final quantities, amounts or other details relative to this project may be found at Central Files in the electronic archives.	

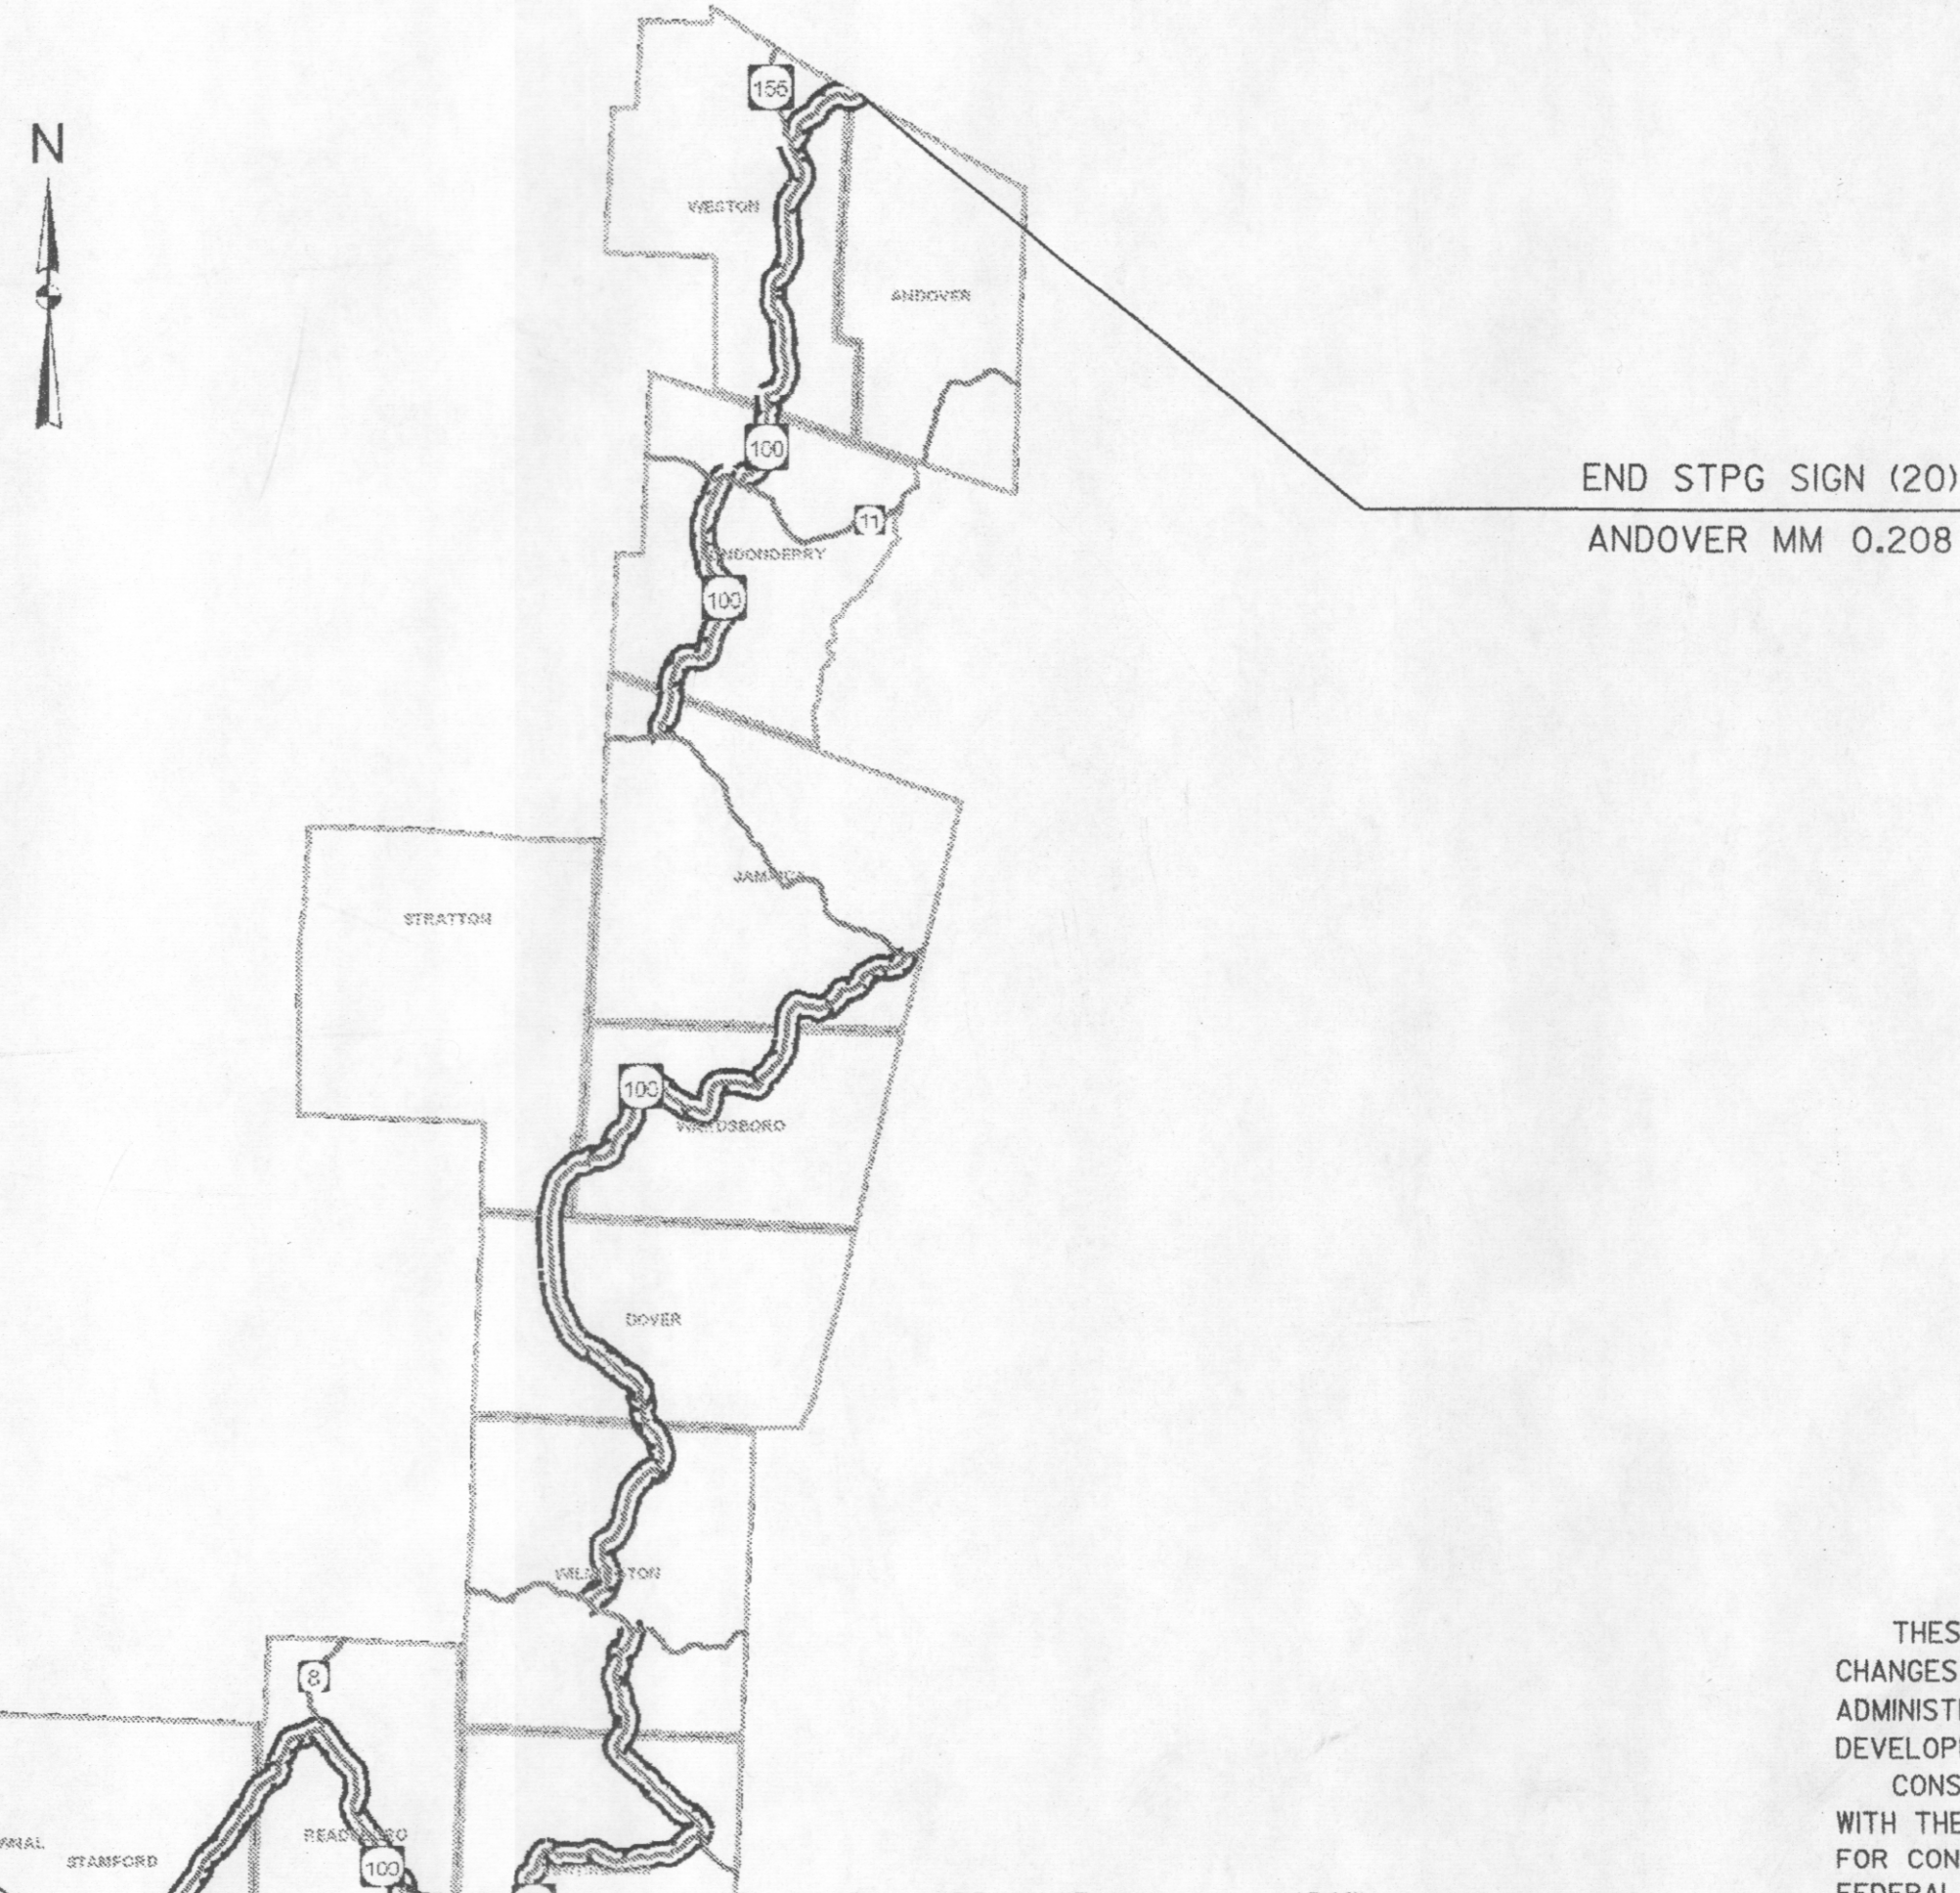

CONVENTIONAL SYMBOLS	
COUNTY LINE	
TOWN LINE	
LIMITS OF ACCESS	
POINT OF ACCESS	
FENCE LINE	
STONE WALL	
TRAVELED WAY	
GUARD RAIL	
RAILROAD	
SURVEY LINE	
CULVERT	
POWER POLE	
TELEPHONE POLE	
TREES	
CONTROL OF ACCESS	
PROPERTY LINE	

SURVEYED BY : N/A  
SURVEYED DATE : N/A

THESE PLANS ARE SUBJECT TO SUCH ENGINEERING CHANGES AS MAY BE REQUIRED BY THE FEDERAL HIGHWAY ADMINISTRATION OR THE DIRECTOR OF PROGRAM DEVELOPMENT.  
CONSTRUCTION IS TO BE CARRIED ON IN ACCORDANCE WITH THESE PLANS AND THE STANDARD SPECIFICATIONS FOR CONSTRUCTION DATED 2006, AS APPROVED BY THE FEDERAL HIGHWAY ADMINISTRATION ON JUNE 15, 2006

DIRECTOR OF PROGRAM DEVELOPMENT	
APPROVED	<i>Jan V. Paul</i> DATE 7-7-2011
PROJECT MANAGER :	AMY GAMBLE