

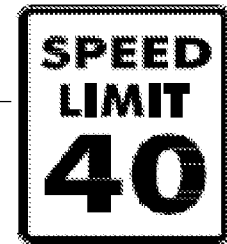

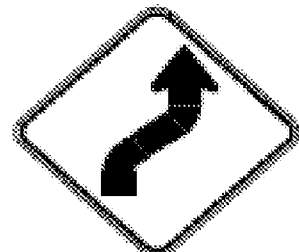
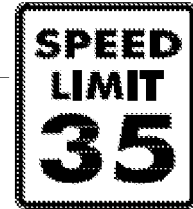


DIRECTION	MILEPOINT	LOCATION CODE (SHEET 2)	SIGN CODE	WIDTH (IN)	HEIGHT (IN)	SHEETING REMARKS	SIGN LEGEND	NEW SIGNS		EXISTING SIGNS			EXIST POST		NUMBER OF NEW POSTS	SQUARE STEEL (IN)			TUBULAR STEEL Ø (IN)				SIGN FRAME REQUIRED	REMARKS	SIGN DETAIL				
								"A"	"B"	RETAIN	SALVAGE FROM	SALVAGE TO	REMOVE	RETAIN		REMOVE	1.75	2.00	2.50	FOUNDATION	3.00	3.50			4.00	5.00	DETAIL IN SHS	DETAIL ON SHEET NUMBER	DETAIL ON STD SHEET NUMBER
																	(LB / FT)				(LB / FT)								
STAMFORD VT 100							FY-FLUORESCENT YELLOW FYG-FLUORESCENT YELLOW GREEN															"SHS"-STANDARD HIGHWAY SIGNS							
NB	0.150	A	VR-655	24	18		STRICTLY ENFORCED 					1																	
		A	VR-654	24	24			4.00					1	X											E-143				
NB	0.191	A	VR-048	24	30							1																	
		A	VR-048	24	30			5.00					1	X											E-144				
NB	0.220	A	R2-1	24	30							1																	
		A	R2-1	24	30			5.00					1	X									X						
NB	0.260	A	W11-7	30	30		EQUESTRIAN SYMBOL					+													STUB ONLY REMOVED				
NB	0.260	A	W7-3A	30	30		NEXT 2 MILES					+																	
NB	0.310	A	VD-018	30	18							1																	
		A	VD-018	30	18			3.75					1	X											E-128A				
NB	0.360	A	W1-4R	30	30		RIGHT REVERSE CURVE 					1																	
NB	0.360 0.379	A	W1-4R	30	30			6.25					1	X											THIS SIGN WAS KEPT AT THE SAME LOCATION AT REQUEST OF AOT-DIST. #1 INSTALL ⁰ 100 FEET NORTH OF EXISTING				
NB	0.421	A	R2-1	24	30							1																	
		A	R2-1	30	36			7.50					1	X											6				
NB	0.460	A	VD-062B	72	16		BUSINESS SIGN			1																			
SIGN SUMMARY SHEET							SHEET TOTALS	31.50	0.00	1	0	0	8 ⁶	0	0	6	90					PROJECT NAME: Stamford-Andover VT100							
VERMONT AGENCY OF TRANSPORTATION							TOWN TOTALS	455.0	0.0	16.0	5.0	5.0	75	0.0	0.0	83	1245.0					PROJECT NUMBER: STPG SIGN(20)							
								SF	SF	EA	EA	EA	EA	EA	EA	EA	FT					FILE NAME: Stamford.xls	PLOT DATE: 8/5/2009						
																					PROJECT MANAGER: N. Avery	DRAWN BY: T. Guazzoni							
																					DESIGNED BY: J. Kelly	CHECKED BY: T. Guazzoni							
																					STAMFORD SHEET 2	SHEET 10 OF 198							