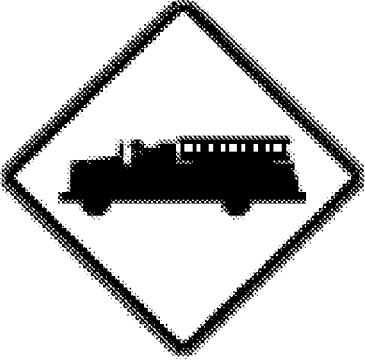


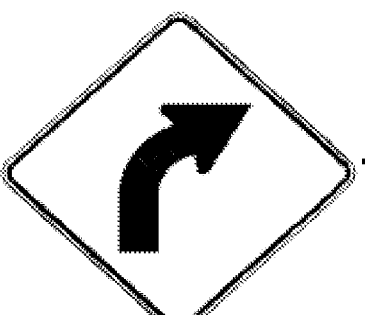



| DIRECTION | MILEPOINT | LOCATION CODE (SHEET 2) | SIGN CODE | WIDTH (IN) | HEIGHT (IN) | SHEETING REMARKS | SIGN LEGEND | NEW SIGNS | | EXISTING SIGNS | | | EXIST POST | | NUMBER OF NEW POSTS | SQUARE STEEL (IN) | | | TUBULAR STEEL Ø (IN) | | | | SIGN FRAME REQUIRED | REMARKS | SIGN DETAIL | | | | |
|----------------------------------|---------------------------|-------------------------|-----------|------------|-------------|------------------|---|-----------|------|----------------|--------------|------------|------------|--------|---------------------|-------------------|-----------|------|----------------------|------------|-----------|----------------------------------|---|----------------------------|-------------|------|---------------|------------------------|----------------------------|
| | | | | | | | | "A" | "B" | RETAIN | SALVAGE FROM | SALVAGE TO | REMOVE | RETAIN | | REMOVE | 1.75 | 2.00 | 2.50 | FOUNDATION | 3.00 | 3.50 | | | 4.00 | 5.00 | DETAIL IN SHS | DETAIL ON SHEET NUMBER | DETAIL ON STD SHEET NUMBER |
| | | | | | | | | | | | | | | | | | (LB / FT) | | | | (LB / FT) | | | | | | | | |
| STAMFORD VT 100 | | | | | | | FY-FLUORESCENT YELLOW FYG-FLUORESCENT YELLOW GREEN | | | | | | | | | | | | | | | "SHS"-STANDARD HIGHWAY SIGNS | | | | | | | |
| NB | 0.842 | A | S1-1YG | 30 | 30 | | SCHOOL PENTAGON | | | 1 | | | | | | | | | | | | | | | | | | | |
| | | A | W16-9YG | 24 | 12 | | AHEAD | | | 1 | | | | | | | | | | | | | | | | | | | |
| NB | 0.880 | A | S4-3YG | 24 | 8 | | SCHOOL | | | 1 | | | | | | | | | | | | | | | | | | | |
| | | A | R2-1 | 24 | 30 | | SPEED LIMIT 30 | | | 1 | | | | | | | | | | | | | | | | | | | |
| | | A | S4-4 | 24 | 10 | | WHEN FLASHING | | | 1 | | | | | | | | | | | | | | | | | | | |
| NB | 0.924 0.900 | A | W11-8 | 30 | 30 | |  | 6.25 | | | | | | 1 | | X | | | | | | | | | | | | | |
| | | | | | | | | | | | | | | | | | | | | | | | | | | | | | |
| NB | 0.963 | A | S1-1YG | 30 | 30 | | SCHOOL PENTAGON | | | 1 | | | | | | | | | | | | | | | | | | | |
| | | A | W16-7YG | 24 | 12 | | DOWN LH ARROW | | | 1 | | | | | | | | | | | | | | | | | | | |
| NB | 1.005 | A | S1-1YG | 30 | 30 | | SCHOOL PENTAGON | | | 1 | | | | | | | | | | | | | | | | | | | |
| | | A | W16-7YG | 24 | 12 | | DOWN LH ARROW | | | 1 | | | | | | | | | | | | | | | | | | | |
| NB | 1.117 | A | S5-2 | 24 | 30 | |  | 5.00 | | | | | | 1 | | X | | | | | | | | | | | | | |
| NB | 1.170 | A | R2-1 | 24 | 30 | |  | | | | | 1 | | | | | | | | | | | | | | | | | |
| | | A | R2-1 | 24 | 30 | |  | 5.00 | | | | | | 1 | | X | | | | | | | | | | | | | |
| NB | 1.500 | A | W1-2R | 30 | 30 | | RIGHT CURVE | | | | | 1 | | | | | | | | | | | | | | | | | |
| | | | | | | |  | | | | | | | | | | | | | | | | | | | | | | |
| NB | 1.520 | A | W1-2R | 30 | 30 | | | 6.25 | | | | | | 1 | | X | | | | | | | | | | | | | |
| SIGN SUMMARY SHEET | | | | | | | SHEET TOTALS | 22.50 | 0.00 | 9 | 0 | 0 | 2 | 0 | 0 | 4 | 60 | | | | | | PROJECT NAME: Stamford-Andover VT100 | | | | | | |
| VERMONT AGENCY OF TRANSPORTATION | | | | | | | TOWN TOTALS | 455.0 | 0.0 | 16.0 | 5.0 | 5.0 | 75 | 0.0 | 0.0 | 83 | 1245.0 | | | | | | PROJECT NUMBER: STPG SIGN(20) | | | | | | |
| | | | | | | | | SF | SF | EA | EA | EA | EA | EA | EA | EA | FT | | | | | | FILE NAME: Stamford.xls | PLOT DATE: 8/5/2009 | | | | | |
| | | | | | | | | | | | | | | | | | | | | | | PROJECT MANAGER: N. Avery | DRAWN BY: T. Guazzoni | | | | | | |
| | | | | | | | | | | | | | | | | | | | | | | DESIGNED BY: J. Kelly | CHECKED BY: T. Guazzoni | | | | | | |
| | | | | | | | | | | | | | | | | | | | | | | STAMFORD SHEET 4 | SHEET 12 OF 198 | | | | | | |