






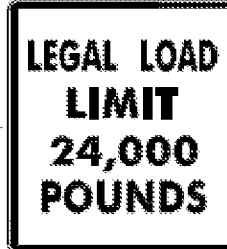


DIRECTION	MILEPOINT	LOCATION CODE (SHEET 2)	SIGN CODE	WIDTH (IN)	HEIGHT (IN)	SHEETING REMARKS	SIGN LEGEND	NEW SIGNS		EXISTING SIGNS			EXIST POST		NUMBER OF NEW POSTS	SQUARE STEEL (IN)			TUBULAR STEEL Ø (IN)				SIGN FRAME REQUIRED	REMARKS	SIGN DETAIL														
								"A"	"B"	RETAIN	SALVAGE FROM	SALVAGE TO	REMOVE	RETAIN		REMOVE	1.75	2.00	2.50	FOUNDATION	3.00	3.50			4.00	5.00	DETAIL IN SHS	DETAIL ON SHEET NUMBER	DETAIL ON STD SHEET NUMBER										
																	(LB / FT)				(LB / FT)																		
STAMFORD VT 100							FY-FLUORESCENT YELLOW FYG-FLUORESCENT YELLOW GREEN															"SHS"-STANDARD HIGHWAY SIGNS																	
		A	W13-1	18	18			2.25																	X														
NB	1.560	C	VR-017	24	24																																		
		C	VR-017	24	30			5.00																				TH-22, CLAYTON AVE			E-141								
NB	1.565	D	R1-1	24	24																																		
		D	R1-1	30	30			6.25																						TH-22, CLAYTON AVE	X								
NB	1.565	A	R2-1	24	30		SPEED LIMIT 45																																
																																							
NB	1.678	A	R2-1	24	30			5.00																							INSTALL 600 FEET NORTH OF EXISTING SPEED LIMIT 45 SIGN	X							
																																							
NB	1.824	C	VR-017	24	24																																		
		C	VR-017	24	30			5.00																								TH-1, CLOUGH RD			E-141				
NB	1.832	D	R1-1	24	24																																		
		D	R1-1	30	30			6.25																								TH-1, CLOUGH RD	X						
NB	1.870	A	R2-1	24	30																																		
		A	VR-208	24	24																													6					
NB	2.185	C	VR-017	24	30																																		
								5.00																										TH-25, CLOUGH RD			E-141		
NB	2.200	D	R1-1	30	30																																		
SIGN SUMMARY SHEET							SHEET TOTALS	43.75	0.00	0	2	2	7	0	0	7	105																						
VERMONT AGENCY OF TRANSPORTATION							TOWN TOTALS	455.0	0.0	16.0	5.0	5.0	75	0.0	0.0	83	1245.0																						
																					PROJECT NAME:	Stamford-Andover VT100						PROJECT NUMBER:						STPG SIGN(20)					
																					FILE NAME:	Stamford.xls						PLOT DATE:						8/5/2009					
																					PROJECT MANAGER: N. Avery						DRAWN BY:						T. Guazzoni						
																					DESIGNED BY: J. Kelly						CHECKED BY:						T. Guazzoni						
																					STAMFORD SHEET 5						SHEET						13 OF 198						