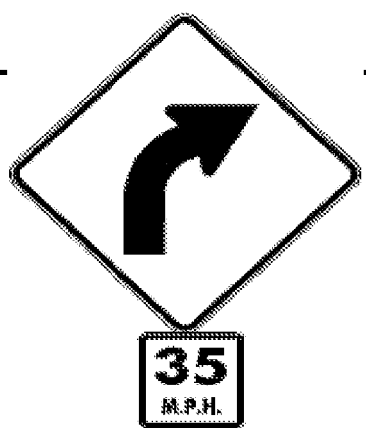

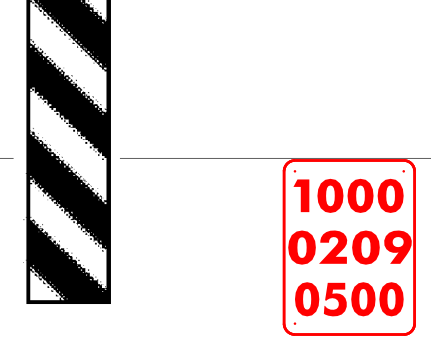





DIRECTION	MILEPOINT	LOCATION CODE (SHEET 2)	SIGN CODE	WIDTH (IN)	HEIGHT (IN)	SHEETING REMARKS	SIGN LEGEND	NEW SIGNS		EXISTING SIGNS			EXIST POST		NUMBER OF NEW POSTS	SQUARE STEEL (IN)			TUBULAR STEEL Ø (IN)				SIGN FRAME REQUIRED	REMARKS	SIGN DETAIL				
								"A"	"B"	RETAIN	SALVAGE FROM	SALVAGE TO	REMOVE	RETAIN		REMOVE	1.75	2.00	2.50	FOUNDATION	3.00	3.50			4.00	5.00	DETAIL IN SHS	DETAIL ON SHEET NUMBER	DETAIL ON STD SHEET NUMBER
																	(LB / FT)				(LB / FT)								
<b>READSBORO VT 100</b>							FY-FLUORESCENT YELLOW FYG-FLUORESCENT YELLOW GREEN															"SHS"-STANDARD HIGHWAY SIGNS							
SB	6.144	F	W1-2R	30	30		RIGHT CURVE																						
		F	W13-1	18	18		35 MPH PLAQUE																						
SB	6.059	F	W1-2R	30	30	FY		6.25															INSTALL 450 FEET SOUTH OF EXISTING RIGHT CURVE	X					
		F	W13-1	18	18	FY		2.25															X						
SB	5.039	F	OM-3R	12	36																								
		F	OM-3R	12	36			3.00															X						
SB	5.004	E	OM-3L	12	36																								
		E	OM-3L	12	36			3.00															X						
SB	4.359	F	VD-018	30	18																								
		F	VD-018	30	18			3.75																	E-128A				
SB	3.710	F	S3-1	30	30																		SIGN ALREADY REMOVED PRIOR TO PROJECT.						
		F	S3-1	30	30			6.25															INSTALL 500 FEET NORTH OF BAILEY HILL ROAD INTERSECTION	X					
SB	3.624	G	VR-017	24	30		LEGAL LOAD LIMIT 24,000 LBS																TH-29, BAILEY HILL RD						
SB	3.616	H	R1-1	30	30		STOP 																TH-29, BAILEY HILL RD						
SB	2.338	F	W1-2L	30	30		LEFT CURVE																						
<b>SIGN SUMMARY SHEET</b>							SHEET TOTALS	24.50	0.00	2	0	0	6	0	0	5	75					PROJECT NAME: Stamford-Andover VT100							
								SF	SF	EA	EA	EA	EA	EA	EA	EA	FT					PROJECT NUMBER: STPG SIGN(20)							
VERMONT AGENCY OF TRANSPORTATION							TOWN TOTALS	408.4	0.0	34.0	3.0	3.0	84	0.0	2.0	64	960.0					FILE NAME: Readsboro.xls	PLOT DATE: 8/5/2009						
																					PROJECT MANAGER: N. Avery	DRAWN BY: T. Guazzoni							
																					DESIGNED BY: J. Kelly	CHECKED BY: T. Guazzoni							
																					READSBORO SHEET 10	SHEET 31 OF 198							