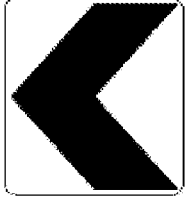

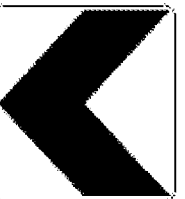

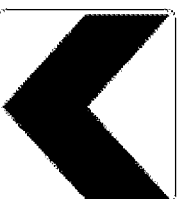
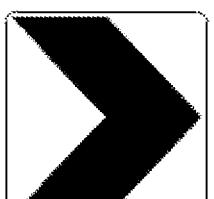
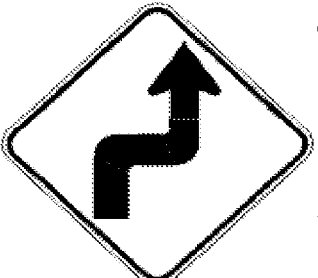



DIRECTION	MILEPOINT	LOCATION CODE (SHEET 2)	SIGN CODE	WIDTH (IN)	HEIGHT (IN)	SHEETING REMARKS	SIGN LEGEND	NEW SIGNS		EXISTING SIGNS			EXIST POST		NUMBER OF NEW POSTS	SQUARE STEEL (IN)			TUBULAR STEEL Ø (IN)				SIGN FRAME REQUIRED	REMARKS	SIGN DETAIL				
								"A"	"B"	RETAIN	SALVAGE FROM	SALVAGE TO	REMOVE	RETAIN		REMOVE	1.75	2.00	2.50	FOUNDATION	3.00	3.50			4.00	5.00	DETAIL IN SHS	DETAIL ON SHEET NUMBER	DETAIL ON STD SHEET NUMBER
																	(LB / FT)				(LB / FT)								
<b>WHITINGHAM VT 100</b>							FY-FLUORESCENT YELLOW FYG-FLUORESCENT YELLOW															"SHS"-STANDARD HIGHWAY SIGNS							
NB	4.116	A	W1-8	18	24	FY		3.00						1		X								X					
NB	4.116	B	W1-8	18	24							1				X							ON 5-9-11 THIS SIGN WAS FOUND ON THE GROUND. ON 7-2-11 CONTRACTOR RE-ERECTED THIS SIGN. 2 PAY ITEMS FOR THIS WORK. FACES SB TRAFFIC.		X				
		B	W1-8	18	24	FY		3.00						1		X								X					
NB	4.132	A	W1-8	18	24							1				X													
		A	W1-8	18	24	FY		3.00						1		X								X					
NB	4.132	B	W1-8	18	24							1				X													
		B	W1-8	18	24	FY		3.00						1		X							FACES SB TRAFFIC		X				
NB	4.145	A	W1-8	18	24							1				X													
		A	W1-8	18	24	FY		3.00						1		X								X					
NB	4.145	B	W1-8	18	24							1				X													
		B	W1-8	18	24	FY		3.00						1		X							FACES SB TRAFFIC		X				
NB	4.210	B	W1-3R	30	30	FY		6.25						1		X							INSTALL 125 FEET SOUTH OF EXISTING ASSEMBLY		X				
		B	W13-1	18	18	FY		2.25															GATE-POSTED ASSEMBLIES SHOULD BE INSTALLED AT SAME MILE POINT		X				
NB	4.232	B	W1-3R	30	30		RIGHT REVERSE CURVE							1		X													
		B	W13-1	18	18		20 MPH PLAQUE							1															
<b>SIGN SUMMARY SHEET</b>							SHEET TOTALS	26.50	0.00	0	0	0	0	0	0	0	7	105					PROJECT NAME: Stamford-Andover VT100						
								SF	SF	EA	EA	EA	EA	EA	EA	EA	EA	FT					PROJECT NUMBER: STPG SIGN(20)						
VERMONT AGENCY OF TRANSPORTATION							TOWN TOTALS	1058.3	0.0	40.0	13.0	13.0	220	0.0	0.0	193	2895.0					FILE NAME: Whitingham.xls	PLOT DATE: 8/5/2009						
																						PROJECT MANAGER: N. Avery	DRAWN BY: I. Shea						
																						DESIGNED BY: J. Kelly	CHECKED BY: T. Guazzoni						
																						WHITINGHAM SHEET 7	SHEET 43 OF 198						