







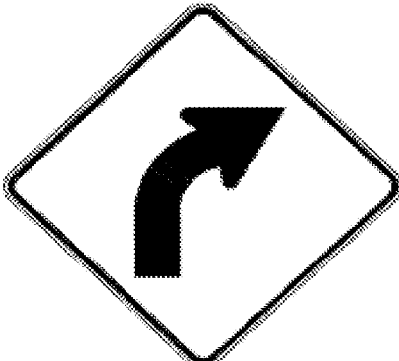
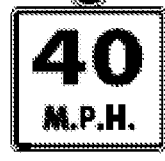
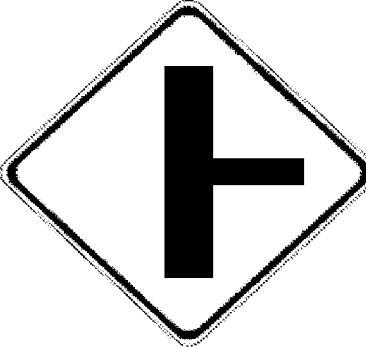


DIRECTION	MILEPOINT	LOCATION CODE (SHEET 2)	SIGN CODE	WIDTH (IN)	HEIGHT (IN)	SHEETING REMARKS	SIGN LEGEND	NEW SIGNS		EXISTING SIGNS			EXIST POST		NUMBER OF NEW POSTS	SQUARE STEEL (IN)			TUBULAR STEEL Ø (IN)				SIGN FRAME REQUIRED	REMARKS	SIGN DETAIL				
								"A"	"B"	RETAIN	SALVAGE FROM	SALVAGE TO	REMOVE	RETAIN		REMOVE	1.75	2.00	2.50	3.00	3.50	4.00			5.00	DETAIL IN SHS	DETAIL ON SHEET NUMBER	DETAIL ON STD SHEET NUMBER	
																	(LB / FT)			(LB / FT)									
WHITINGHAM VT 100							FY-FLUORESCENT YELLOW FYG-FLUORESCENT YELLOW GREEN															"SHS"-STANDARD HIGHWAY SIGNS							
NB	4.270	A	OM-3R	12	36			3.00										X						INSTALL ON SOUTH SIDE OF LEDGE/CONCRETE OUTCROPPING	X				
NB	4.286	B	OM-3L	12	36		LEFT OBJECT MARKER						1																
NB	4.322	A	R2-1	24	30								1																
		A	R2-1	24	30			5.00										X							X				
NB	4.409	C	VR-017	24	30			5.00											X					TH-55, SADAWGA LAKE RD			E-141		
NB	4.417	D	R1-1	30	30		 						1											TH-55, SADAWGA LAKE RD					
		D	R1-1	30	30		 	6.25		2	2								X					SALVAGED TWO STREET SIGNS ONTO NEW POSTS. ALSO MM.	X				
NB	4.600	A	R2-1	24	30								1																
		A	R2-1	24	30			5.00										X							X				
NB	4.757	A	W1-2R	30	30		RIGHT CURVE						1																
		A	W13-1	18	18		40 MPH PLAQUE						1																
NB	4.780	A	W1-2R	30	30	FY		6.25											X					INSTALL 125 FEET NORTH OF EXISTING ASSEMBLY	X				
		A	W13-1	18	18	FY		2.25																	X				
NB	4.846	A	S3-1	30	30		SCHOOL BUS STOP AHEAD						1																
NB	4.906 4.900	A	W2-2MaR	30	30			6.25											X					INSTALL ³¹⁵ 285 FEET NORTH OF EXISTING SCHOOL BUS STOP AHEAD			6		
SIGN SUMMARY SHEET							SHEET TOTALS	39.00	0.00	0	0 2	0 2	7	0	0	8	120							PROJECT NAME: Stamford-Andover VT100					
								SF	SF	EA	EA	EA	EA	EA	EA	EA	FT								PROJECT NUMBER: STPG SIGN(20)				
VERMONT AGENCY OF TRANSPORTATION							TOWN TOTALS	1058.3	0.0	40.0	13.0	13.0	220	0.0	0.0	193	2895.0								FILE NAME: Whitingham.xls	PLOT DATE: 8/5/2009			
																									PROJECT MANAGER: N. Avery	DRAWN BY: I. Shea			
																									DESIGNED BY: J. Kelly	CHECKED BY: T. Guazzoni			
																									WHITINGHAM SHEET 8	SHEET 44 OF 198			