


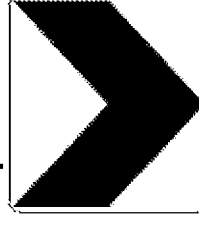
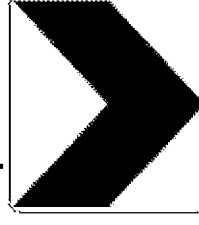

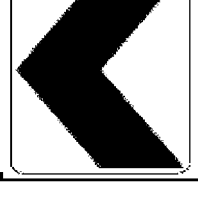


DIRECTION	MILEPOINT	LOCATION CODE (SHEET 2)	SIGN CODE	WIDTH (IN)	HEIGHT (IN)	SHEETING REMARKS	SIGN LEGEND	NEW SIGNS		EXISTING SIGNS			EXIST POST		NUMBER OF NEW POSTS	SQUARE STEEL (IN)			TUBULAR STEEL Ø (IN)				SIGN FRAME REQUIRED	REMARKS	SIGN DETAIL				
								"A"	"B"	RETAIN	SALVAGE FROM	SALVAGE TO	REMOVE	RETAIN		REMOVE	1.75	2.00	2.50	FOUNDATION	3.00	3.50			4.00	5.00	DETAIL IN SHS	DETAIL ON SHEET NUMBER	DETAIL ON STD SHEET NUMBER
																	(LB / FT)				(LB / FT)								
WHITINGHAM VT 100							FY-FLUORESCENT YELLOW FYG-FLUORESCENT YELLOW GREEN															"SHS"-STANDARD HIGHWAY SIGNS							
SB	7.410	H	R1-1	30	30						1		X																
		H	R1-1	30	30			6.25						1		X									TH-42, ACADEMY RD	X			
SB	7.405	F	R2-1	24	30						1		X																
		F	R2-1	24	30			5.00						1		X										X			
SB	7.383	F	W1-8	18	24						1		X																
		F	W1-8	18	24	FY		3.00						1		X										X			
SB	7.383	E	W1-8	18	24						1		X																
		E	W1-8	18	24	FY		3.00						1		X										X			
SB	7.368	F	W1-8	18	24		CHEVRON				1		X																
SB	7.368	E	W1-8	18	24		CHEVRON				1		X																
SB	7.358	F	W1-8	18	24						1		X																
		F	W1-8	18	24	FY		3.00						1		X										X			
SB	7.358	E	W1-8	18	24						1		X																
		E	W1-8	18	24	FY		3.00						1		X										X			
SB	7.333	F	W1-8	18	24						1		X														X		INSTALL BOTH SIGNS SOUTH OF DRIVE
SIGN SUMMARY SHEET							SHEET TOTALS	26.25	0.00	0	0	0	8	0	0	7	105							PROJECT NAME: Stamford-Andover VT100					
								SF	SF	EA	EA	EA	EA	EA	EA	EA	EA	FT							PROJECT NUMBER: STPG SIGN(20)				
VERMONT AGENCY OF TRANSPORTATION							TOWN TOTALS	1058.3	0.0	40.0	13.0	13.0	220	0.0	0.0	193	2895.0							FILE NAME: Whitingham.xls	PLOT DATE: 8/5/2009				
																								PROJECT MANAGER: N. Avery	DRAWN BY: I. Shea				
																								DESIGNED BY: J. Kelly	CHECKED BY: T. Guazzoni				
																								WHITINGHAM SHEET 24	SHEET 60 OF 198				