

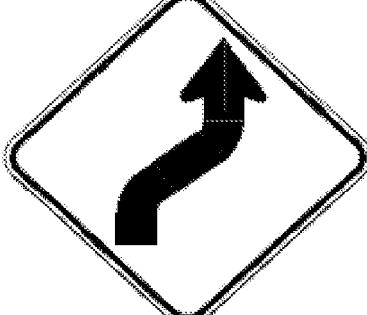


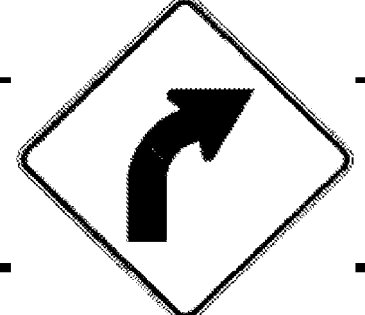


DIRECTION	MILEPOINT	LOCATION CODE (SHEET 2)	SIGN CODE	WIDTH (IN)	HEIGHT (IN)	SHEETING REMARKS	SIGN LEGEND	NEW SIGNS		EXISTING SIGNS			EXIST POST		NUMBER OF NEW POSTS	SQUARE STEEL (IN)			TUBULAR STEEL Ø (IN)				SIGN FRAME REQUIRED	REMARKS	SIGN DETAIL													
								"A"	"B"	RETAIN	SALVAGE FROM	SALVAGE TO	REMOVE	RETAIN		REMOVE	1.75	2.00	2.50	FOUNDATION	3.00	3.50			4.00	5.00	DETAIL IN SHS	DETAIL ON SHEET NUMBER	DETAIL ON STD SHEET NUMBER									
																	(LB / FT)				(LB / FT)																	
WHITINGHAM VT 100							FY-FLUORESCENT YELLOW FYG-FLUORESCENT YELLOW GREEN															"SHS"-STANDARD HIGHWAY SIGNS																
SB	7.333	E	W1-8	18	24	FY		3.00						1		X								X														
SB	7.128	F	R2-1	24	30		SPEED LIMIT 50 				1																											
SB	7.103	F	R2-1	24	30			5.00						1		X											INSTALL ¹⁵⁰ 125 FEET SOUTH OF EXISTING SPEED LIMIT 50 SIGN	X										
SB	7.098	F	W1-5L	30	30		LEFT WINDING ROAD 				1																											
SB	7.065	F	W1-4R	30	30			6.25						1		X												INSTALL 200 FEET SOUTH OF EXISTING WINDING ROAD SIGN	X									
SB	6.964	F	OM-3R	12	36		OBJECT MARKER (RIGHT)					+																										
SB	6.955	E	OM-3L	12	36		OBJECT MARKER (LEFT)					+																										
SB	6.774	F	VW-202	30	30		TRUCKS ENTERING 				1																											
SB	6.645	F	VW-202	30	30			6.25						1		X												INSTALL 200 FEET NORTH OF EXISTING SCHOOL SIGN ASSEMBLY				E-154						
SB	6.607	F	S1-1YG	36	36		SCHOOL PENTAGON			1																												
		F	W16-9YG	24	12		AHEAD			1																												
SB	6.542	F	OM-3R	12	36		RIGHT OBJECT MARKER					1																										
SB	6.538	F	OM-3L	12	36		LEFT OBJECT MARKER					1																										
SB	6.525	F	W11-6(H)	30	30			6.25						1		X												INSTALL HINGED SIGN IN CLOSED POSITION, 90 FEET SOUTH OF BRIDGE #36					E-153					
SB	6.355	F	W1-2R	30	30			6.25						1		X												INSTALL 200 FEET NORTH OF BEGINNING OF GUARD RAIL	X									
SIGN SUMMARY SHEET							SHEET TOTALS	33.00	0.00	4	2	0	0	5	7	0	0	6	90																			
VERMONT AGENCY OF TRANSPORTATION							TOWN TOTALS	1058.3	0.0	40.0	13.0	13.0	220	0.0	0.0	193	2895.0																					
																					PROJECT NAME:	Stamford-Andover VT100																
																					PROJECT NUMBER:	STPG SIGN(20)																
											FILE NAME:	Whitingham.xls				PLOT DATE:	8/5/2009																					
											PROJECT MANAGER:	N. Avery				DRAWN BY:	I. Shea																					
											DESIGNED BY:	J. Kelly				CHECKED BY:	T. Guazzoni																					
																					WHITINGHAM SHEET 25								SHEET	61		OF	198					