




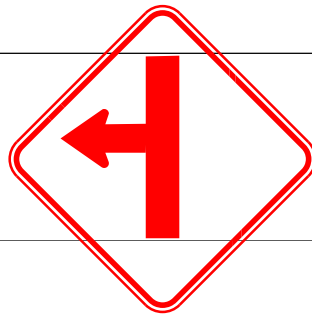



DIRECTION	MILEPOINT	LOCATION CODE (SHEET 2)	SIGN CODE	WIDTH (IN)	HEIGHT (IN)	SHEETING REMARKS	SIGN LEGEND	NEW SIGNS		EXISTING SIGNS			EXIST POST		NUMBER OF NEW POSTS	SQUARE STEEL (IN)			TUBULAR STEEL Ø (IN)				SIGN FRAME REQUIRED	REMARKS	SIGN DETAIL			
								"A"	"B"	RETAIN	SALVAGE FROM	SALVAGE TO	REMOVE	RETAIN		REMOVE	1.75	2.00	2.50	3.00	3.50	4.00			5.00	DETAIL IN SHS	DETAIL ON SHEET NUMBER	DETAIL ON STD SHEET NUMBER
																	(LB / FT)			(LB / FT)								
WHITINGHAM VT 100							FY-FLUORESCENT YELLOW FYG-FLUORESCENT YELLOW GREEN															"SHS"-STANDARD HIGHWAY SIGNS						
SB	0.264	E	OM-3L	12	36			3.00						1	X									X				
NB	0.191	A	W5-2	30	30			6.25															NEW SIGNS INSTALLED BY THE CONTRACTOR PER RECOMMENDATION OF M. MILLER, TRAFFIC OPS.					
SB	0.358	A	W5-2	30	30			6.25																				
NB	6.868	A	W5-2	36	36			—															THESE TWO LARGER NEW SIGNS WERE INSTALLED IN LATE 2011. THEY WERE INSTALLED BY STATE FORCES AS PART OF A WORK ORDER SUBMITTED BY TRAFFIC OPS.					
SB	7.026	A	W5-2	36	36			—																				
NB	7.650	A	WI-IMBL	30	30			6.25															THESE TWO NEW SIGNS WERE MISTAKENLY OMITTED FROM THE PROJECT PLANS.					
		A	WI3-1	18	18			2.25																				
SIGN SUMMARY SHEET							SHEET TOTALS	24.00 3.00	0.00	0	0	0	2 0	0	0	1	15						PROJECT NAME: Stamford-Andover VT100					
VERMONT AGENCY OF TRANSPORTATION							TOWN TOTALS	1058.3	0.0	40.0	13.0	13.0	220	0.0	0.0	193	2895.0						PROJECT NUMBER: STPG SIGN(20)					
								SF	SF	EA	EA	EA	EA	EA	EA	EA	FT						FILE NAME: Whitingham.xls	PLOT DATE: 8/5/2009				
																							PROJECT MANAGER: N. Avery	DRAWN BY: I. Shea				
																							DESIGNED BY: J. Kelly	CHECKED BY: T. Guazzoni				
																							WHITINGHAM SHEET 34	SHEET 70 OF 198				