
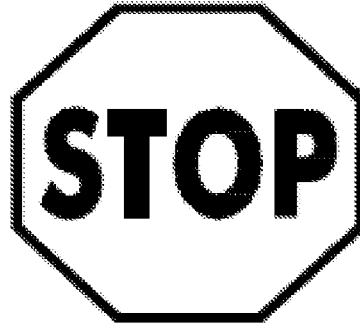
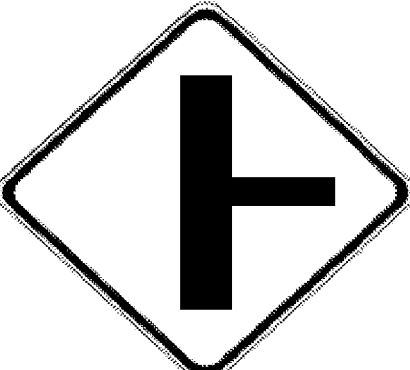


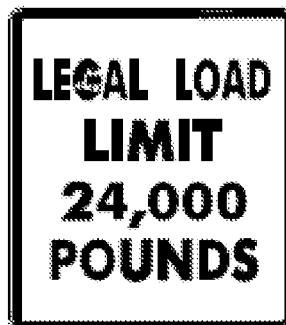
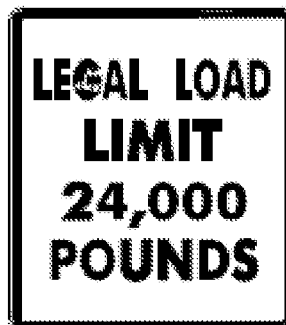
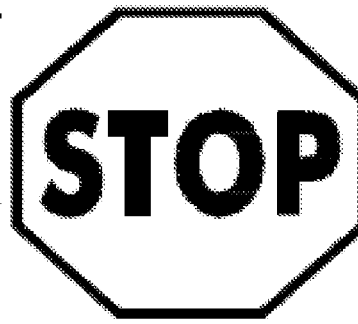
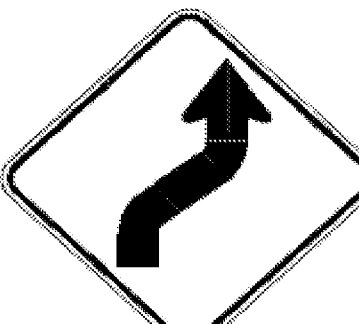
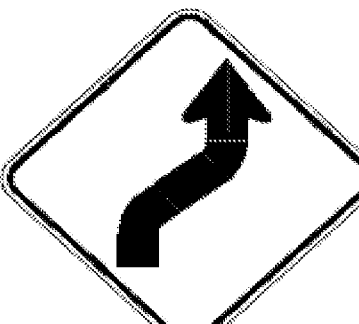



DIRECTION	MILEPOINT	LOCATION CODE (SHEET 2)	SIGN CODE	WIDTH (IN)	HEIGHT (IN)	SHEETING REMARKS	SIGN LEGEND	NEW SIGNS		EXISTING SIGNS			EXIST POST		NUMBER OF NEW POSTS	SQUARE STEEL (IN)			TUBULAR STEEL Ø (IN)				SIGN FRAME REQUIRED	REMARKS	SIGN DETAIL				
								"A"	"B"	RETAIN	SALVAGE FROM	SALVAGE TO	REMOVE	RETAIN		REMOVE	1.75	2.00	2.50	3.00	3.50	4.00			5.00	DETAIL IN SHS	DETAIL ON SHEET NUMBER	DETAIL ON STD SHEET NUMBER	
																	(LB / FT)			(LB / FT)									
WILMINGTON VT 100							FY-FLUORESCENT YELLOW FYG-FLUORESCENT YELLOW GREEN															"SHS"-STANDARD HIGHWAY SIGNS							
NB	0.949	D	R1-1	30	30			6.25						1	X									X					
NB	0.984	D	R1-1	24	24		STOP (INSTALLED BACK-TO-BACK WITH THE LEGAL LOAD LIMIT SIGN)					1			X										RADER ROAD (TH-69), NORTHERLY APPROACH.				
		C	VR-017	24	24		LEGAL LOAD LIMIT 24,000 LBS 					1													INSTALLED BACK-TO-BACK WITH THE STOP SIGN				
		D	R1-1	30	30			6.25						1	X									X					
NB	1.366	A	W2-2R	30	30		SIDE ROAD RIGHT (SYMBOL) 					1			X														
NB	1.396	A	W2-2MaR	30	30			6.25						1	X											INSTALL 160 FT ± NORTH OF PREVIOUS LOCATION.		6	
		A	W16-8	24	8			1.33																			8		
NB	1.480	C	VR-017	24	24							1			X											DIX ROAD (TH-35)			
		C	N/A	18	24		DEAD END ROAD 				1																		
		C	VR-017	24	30			5.00						1	X												E-141		
		C	N/A	18	24		DEAD END ROAD 					1															INSTALL THE TOWN SIGN UNDER THE NEW LEGAL LOAD LIMIT SIGN.		
NB	1.488	D	R1-1	24	24							1			X											DIX ROAD (TH-35)			
		D	R1-1	30	30			6.25						1	X										X				
NB	1.540	A	VD-062AS	72	16		BUSINESS SIGN 					1			X														
NB	1.772	A	W1-4R	30	30	FY		6.25						1	X												INSTALL 25 FT ± IN ADVANCE OF EXISTING ASSEMBLY (TO BE REMOVED), BEHIND RAIL.	X	
SIGN SUMMARY SHEET							SHEET TOTALS	37.58	0.00	1	1	1	5	0	0	6	90												
VERMONT AGENCY OF TRANSPORTATION							TOWN TOTALS	825.4	0.0	64.0	15.0	15.0	145	0.0	0.0	145	2175.0												
PROJECT NAME: Stamford-Andover VT100																					PROJECT NUMBER: STPG SIGN(20)								
FILE NAME: Wilmington.xls												PLOT DATE: 8/6/2009																	
PROJECT MANAGER: N. Avery												DRAWN BY: T. Guazzoni																	
DESIGNED BY: M. Miller												CHECKED BY: T. Guazzoni																	
WILMINGTON SHEET 2																					SHEET 72 OF 198								