
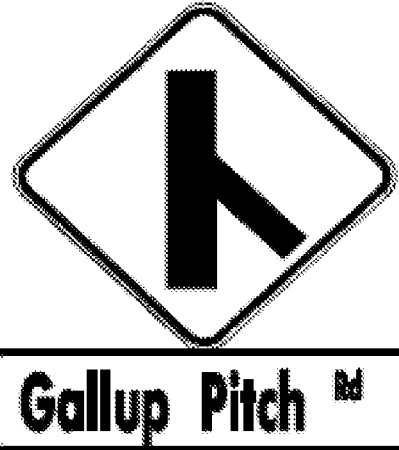


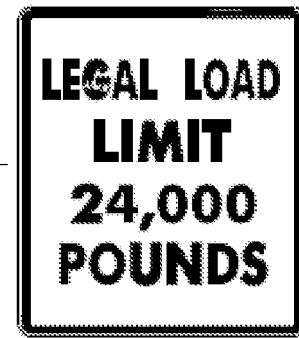

DIRECTION	MILEPOINT	LOCATION CODE (SHEET 2)	SIGN CODE	WIDTH (IN)	HEIGHT (IN)	SHEETING REMARKS	SIGN LEGEND	NEW SIGNS		EXISTING SIGNS			EXIST POST		NUMBER OF NEW POSTS	SQUARE STEEL (IN)			TUBULAR STEEL Ø (IN)				SIGN FRAME REQUIRED	REMARKS	SIGN DETAIL			
								"A"	"B"	RETAIN	SALVAGE FROM	SALVAGE TO	REMOVE	RETAIN		REMOVE	1.75	2.00	2.50	3.00	3.50	4.00			5.00	DETAIL IN SHS	DETAIL ON SHEET NUMBER	DETAIL ON STD SHEET NUMBER
																	(LB / FT)			(LB / FT)								
<b>WILMINGTON VT 100</b>							FY-FLUORESCENT YELLOW FYG-FLUORESCENT YELLOW GREEN															"SHS"-STANDARD HIGHWAY SIGNS						
SB	7.040	F	W2-3MR	30	30						1		X															
		F	W16-8A	24	18							1																
		F	W2-3MaL	30	30	FY		6.25								X								INSTALL SIGN AS SHOWN		6		
		F	W16-8	30	18	FY		3.75 <del>3.00</del>																		8		
SB	6.972	G	VR-017	24	30						1		X															
		G	VR-017	24	30			5.00								X								GALLUP PITCH RD (TH-50)			E-141	
SB	6.964	H	R1-1	30	30						1		X															
		H	R1-1	30	30			6.25								X								INSTALL AS CLOSE TO STOPPING POINT AS POSSIBLE	X			
SB	6.690	F	VD-062AS	72	16		BUSINESS SIGN			1			X															
SB	6.634	F	W1-2R	30	30		CURVE RIGHT			1			X															
SB	6.410	F	M3-3	24	12						1		X															
		F	M1-5	30	24							1																
		F	M3-3	24	12			2.00								X								GREEN ON WHITE SHEETING	X			
		F	M1-5	30	24			5.00																			E-136B	
SB	6.330	F	W1-4R	30	30		REVERSE TURN RIGHT				1		X															
<b>SIGN SUMMARY SHEET</b>							SHEET TOTALS	28.25 <del>27.50</del>	0.00	2	0	0	7	0	0	4	60						PROJECT NAME: <b>Stamford-Andover VT100</b>					
VERMONT AGENCY OF TRANSPORTATION							TOWN TOTALS	825.4	0.0	64.0	15.0	15.0	145	0.0	0.0	145	2175.0						PROJECT NUMBER: <b>STPG SIGN(20)</b>					
								SF	SF	EA	EA	EA	EA	EA	EA	EA	FT						FILE NAME: <b>Wilmington.xls</b>	PLOT DATE: <b>8/6/2009</b>				
																							PROJECT MANAGER: <b>N. Avery</b>	DRAWN BY: <b>T. Guazzoni</b>				
																							DESIGNED BY: <b>M. Miller</b>	CHECKED BY: <b>T. Guazzoni</b>				
																							WILMINGTON SHEET 17	SHEET <b>87</b>	OF <b>198</b>			