


STATE OF VERMONT AGENCY OF TRANSPORTATION



PROPOSED IMPROVEMENT TOWNS OF STAMFORD - ANDOVER COUNTIES OF BENNINGTON, WINDHAM AND WINDSOR VERMONT ROUTE 100


BEGINNING AT THE VERMONT-MASSACHUSETTS STATE LINE ON VT ROUTE 100 IN THE TOWN OF STAMFORD AT MILE MARKER 0.000 AND EXTENDING NORTHERLY ALONG VT ROUTE 100 FOR A DISTANCE OF 66.945 MILES TO THE ANDOVER-LUDLOW TOWN LINE IN THE TOWN OF ANDOVER AT MILE MARKER 0.208; EXCLUDING CLASS 1 SECTIONS WITHIN THE PROJECT CORRIDOR.
LENGTH OF ROADWAY = 66.945 MILES
LENGTH OF PROJECT = 66.416 MILES

WORK TO BE PERFORMED UNDER THIS PROJECT INCLUDES THE REMOVAL OF EXISTING SIGNS & POSTS AND THE INSTALLATION OF SIGNS & SIGN POSTS AND OTHER RELATED ITEMS.

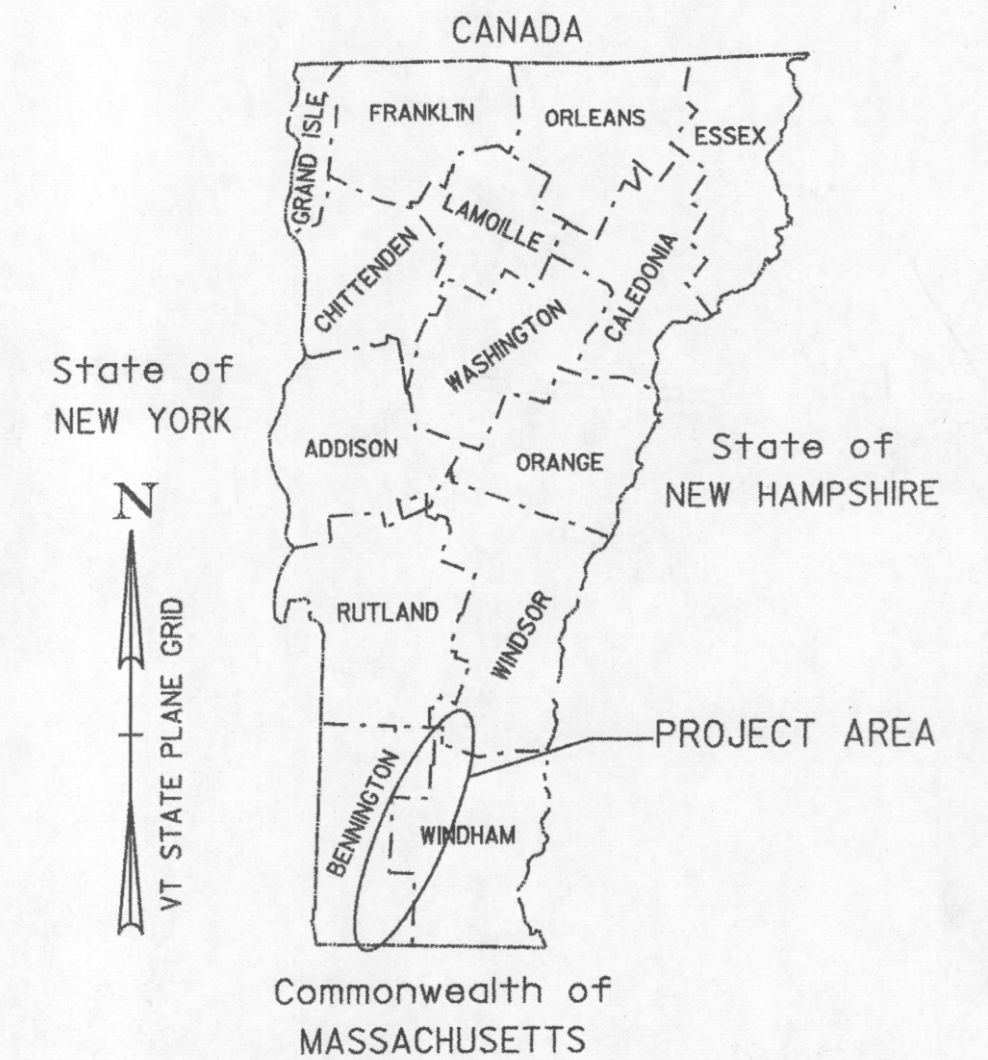

INDEX OF SHEETS
SEE SHEET 2

RECORD PLANS	
CONTRACTOR:	F. R. LAFAYETTE, INC. - ESSEX JUNCTION, VT
RESIDENT ENGINEER:	MARK HAUGHWOUT
CONSTRUCTION BEGAN:	APRIL 7, 2010
CONSTRUCTION COMPLETE:	JULY 27, 2011
RECORD PLANS BY:	M. HAUGHWOUT & J. HYDE
I HEREBY CERTIFY THAT ALL THE CONSTRUCTION REQUIRED BY THIS SET OF DRAWINGS HAS BEEN ACCOMPLISHED AS INDICATED HEREIN.	
BY	<i>Mark W. Haughwout</i> RESIDENT ENGINEER
DATE	1/31/13
NOTE: Any further information concerning final quantities, amounts or other details relative to this project may be found at Central Files in the electronic archives.	

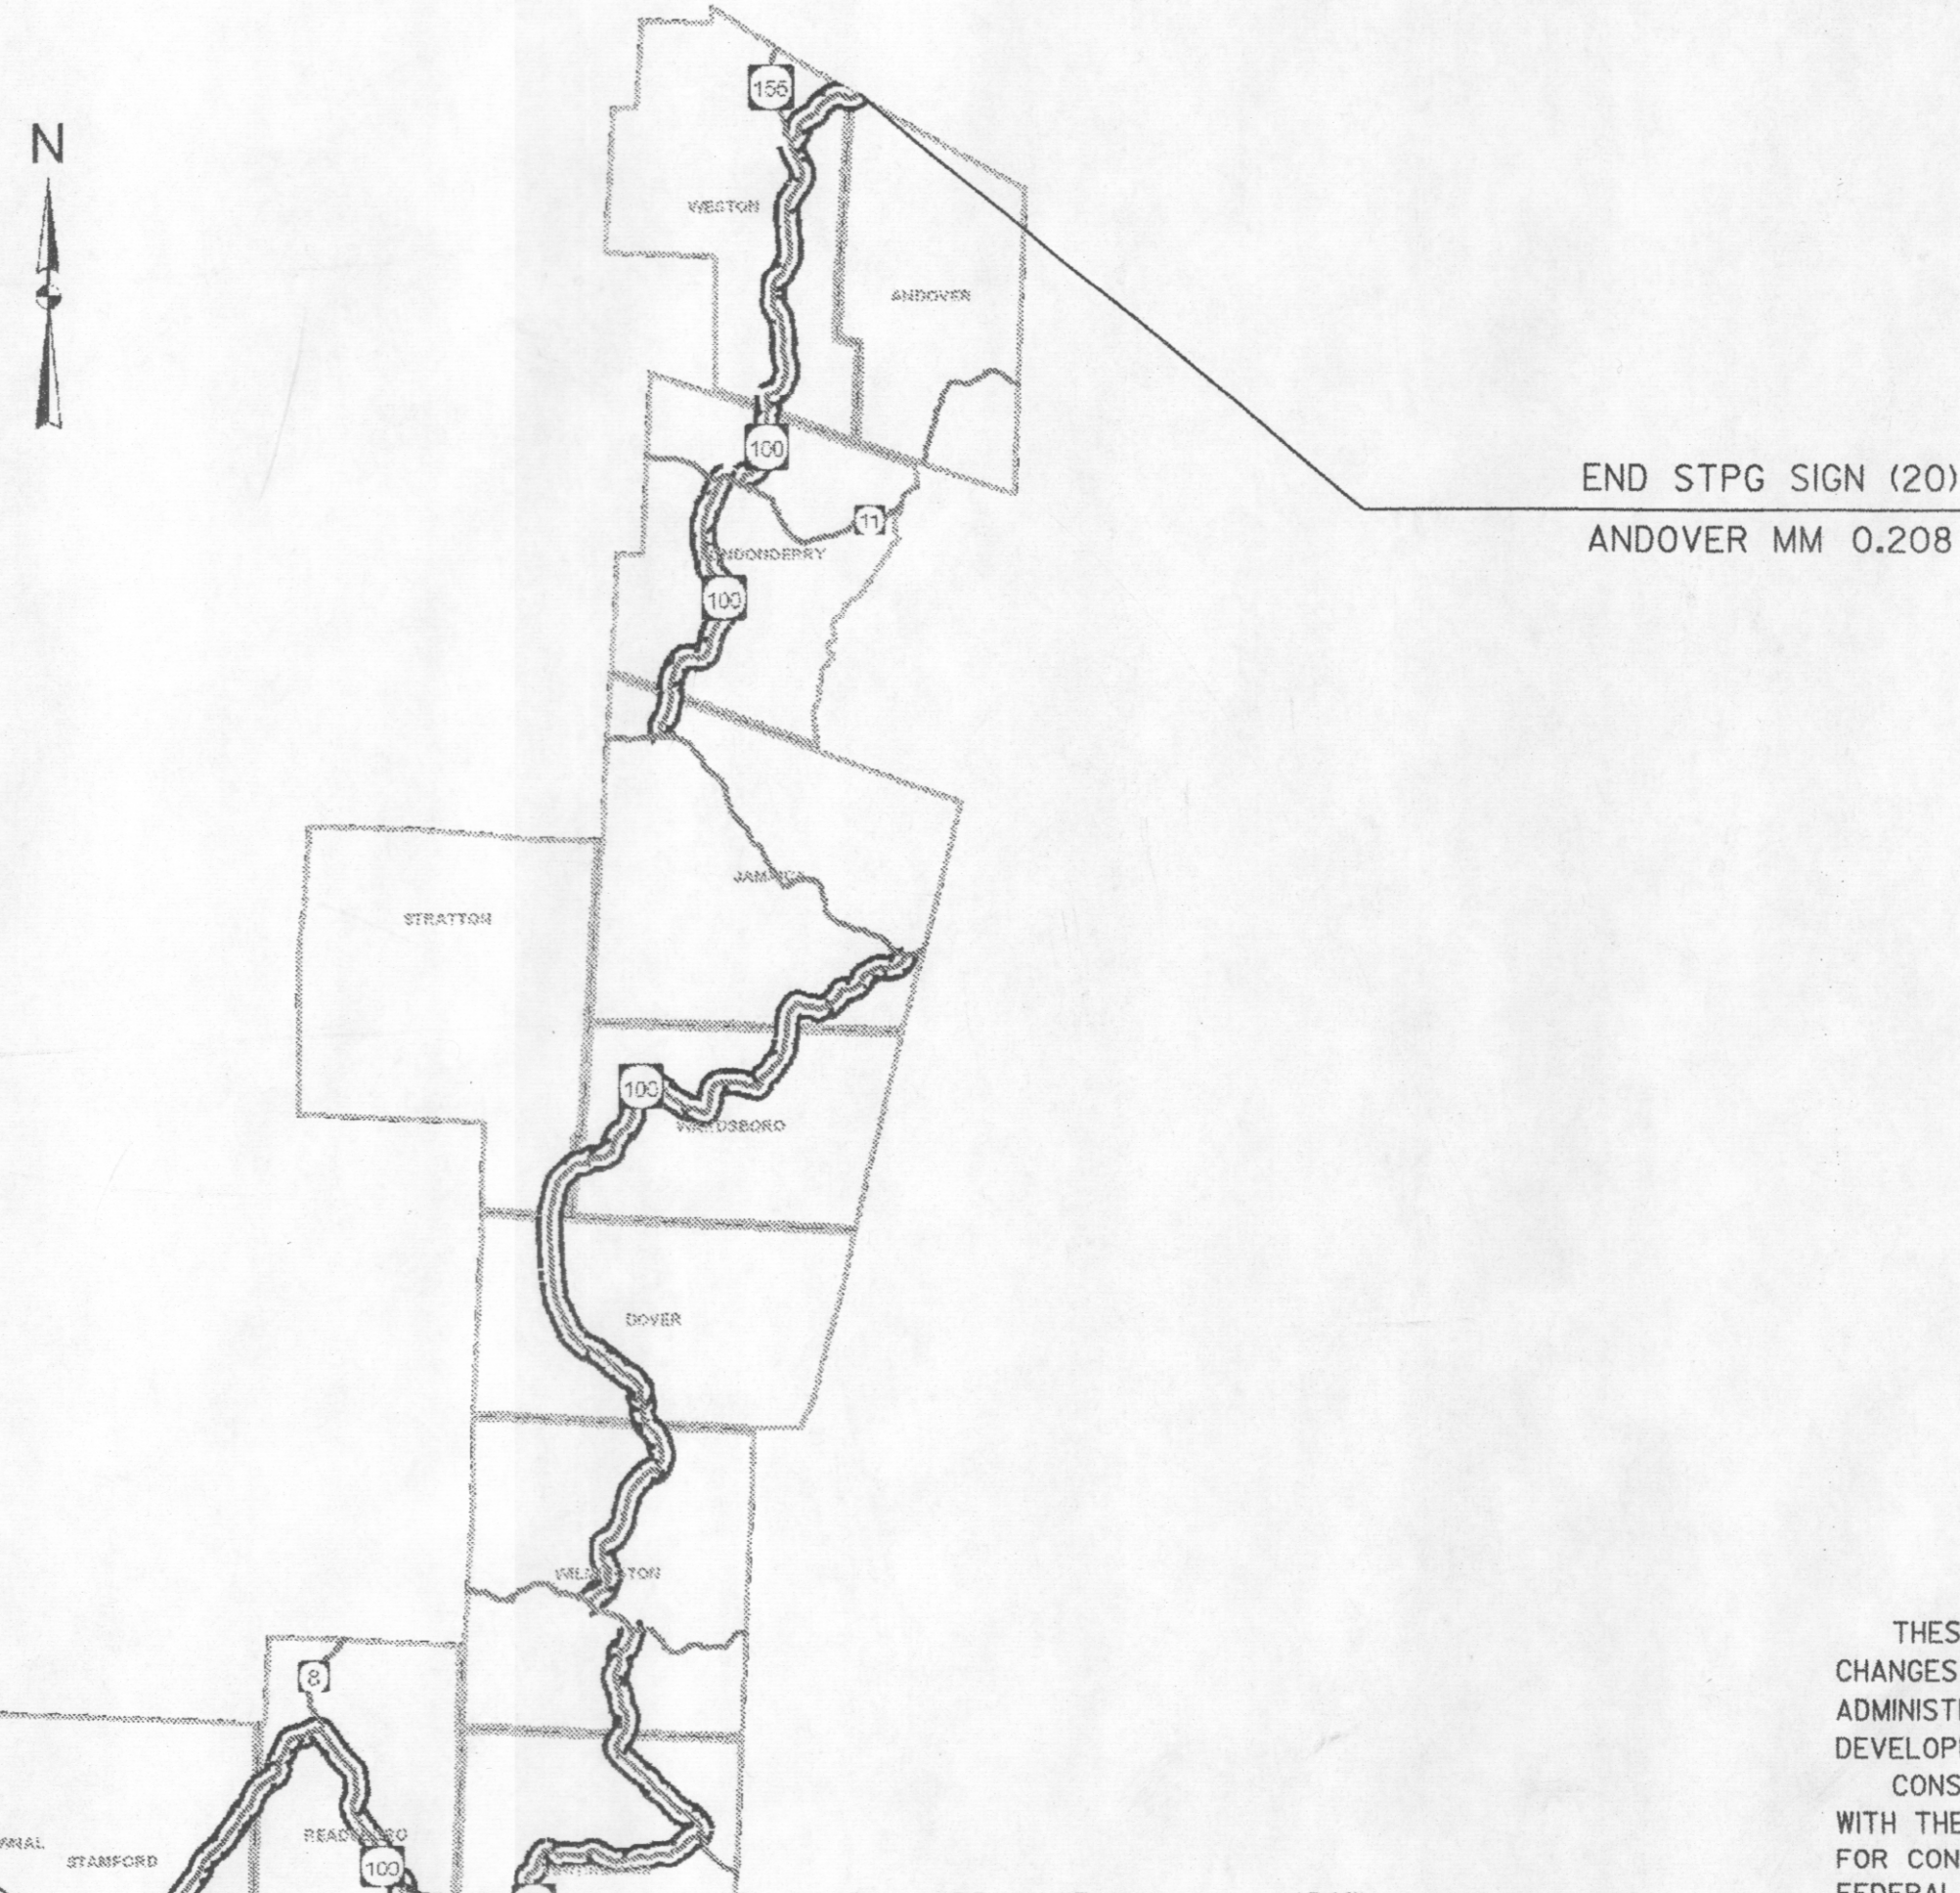

CONVENTIONAL SYMBOLS	
COUNTY LINE	
TOWN LINE	
LIMITS OF ACCESS	
POINT OF ACCESS	
FENCE LINE	
STONE WALL	
TRAVELED WAY	
GUARD RAIL	
RAILROAD	
SURVEY LINE	
CULVERT	
POWER POLE	
TELEPHONE POLE	
TREES	
CONTROL OF ACCESS	
PROPERTY LINE	

BEGIN STPG SIGN (20)
STAMFORD MM 0.000

END STPG SIGN (20)
ANDOVER MM 0.208

SURVEYED BY : N/A
SURVEYED DATE : N/A

THESE PLANS ARE SUBJECT TO SUCH ENGINEERING CHANGES AS MAY BE REQUIRED BY THE FEDERAL HIGHWAY ADMINISTRATION OR THE DIRECTOR OF PROGRAM DEVELOPMENT.
CONSTRUCTION IS TO BE CARRIED ON IN ACCORDANCE WITH THESE PLANS AND THE STANDARD SPECIFICATIONS FOR CONSTRUCTION DATED 2006, AS APPROVED BY THE FEDERAL HIGHWAY ADMINISTRATION ON JUNE 15, 2006

DIRECTOR OF PROGRAM DEVELOPMENT	
APPROVED	<i>Jan V. Paul</i> DATE 7-7-2011
PROJECT MANAGER :	AMY GAMBLE

INDEX OF SHEETS



1	TITLE SHEET
2	GENERAL NOTES
3	QUANTITY SHEET
4	COUNTY/ TOWN LINE DESIGN
5-6	SIGN DETAILS
7	GUIDE SIGN ASSEMBLY
8	WARNING STREET NAME PLAQUES DETAIL
9-21	STAMFORD TRAFFIC SIGN SUMMARY SHEETS 1-13
22-36	READSBORO TRAFFIC SIGN SUMMARY SHEETS 1-15
37-70	WHITINGHAM TRAFFIC SIGN SUMMARY SHEETS 1-34
71-97	WILMINGTON TRAFFIC SIGN SUMMARY SHEETS 1-27
98-116	DOVER TRAFFIC SIGN SUMMARY SHEETS 1-19
117-118	STRATTON TRAFFIC SIGN SUMMARY SHEETS 1-2
119-136	WARDSBORO TRAFFIC SIGN SUMMARY SHEETS 1-18
137-149	JAMAICA TRAFFIC SIGN SUMMARY SHEETS 1-13
150-171	LONDONDERRY TRAFFIC SIGN SUMMARY SHEETS 1-22
172-194	WESTON TRAFFIC SIGN SUMMARY SHEETS 1-23
195	ANDOVER TRAFFIC SIGN SUMMARY SHEET 1
196	TOWN TOTAL SIGN SUMMARY SHEET
197-198	TRAFFIC CONTROL SHEETS

STANDARDS		
E-120	STANDARD SIGN PLACEMENT EXPRESSWAY AND FREEWAY	08/08/1995
E-121	STANDARD SIGN PLACEMENT CONVENTIONAL ROAD	08/08/1995
E-123	GUIDE SIGN PLACEMENT	03/16/2004
E-127	ROUTE MARKINGS AT RURAL INTERSECTIONS	08/08/1995
E-128A	VILLAGE SIGNS A-M	08/08/1995
E-128B	VILLAGE SIGNS N-W	08/08/1995
E-132	GENERAL MOTORIST SERVICES SIGN DETAIL	08/18/1995
E-136B	STATE ROUTE MARKER SIGN DETAILS	08/08/1995
E-136C	STATE NUMBER TOWN HIGHWAY SIGN DETAILS	08/08/1995
E-138	MILEMARKER DETAILS STATE AND TOWN HIGHWAYS	05/30/2003
E-141	REGULATORY SIGN DETAILS	09/20/1995
E-144	REGULATORY SIGN DETAILS	03/29/1999
E-145A	REGULATORY SIGN DETAILS LANE USE CONTROL SIGNS	12/23/1994
E-145B	REGULATORY SIGN DETAILS LANE USE CONTROL SIGNS	12/23/1994
E-153	WARNING SIGN DETAILS	05/01/2004
E-154	WARNING SIGN DETAILS	05/01/2004
E-155	WARNING SIGN DETAILS	05/01/2004
E-164	SQUARE STEEL POSTS	06/08/2009

GENERAL NOTES

- ALL NEW SIGNS SHALL BE IN ACCORDANCE WITH THESE PLANS, THE LATEST EDITION OF THE 2003 MANUAL ON UNIFORM TRAFFIC CONTROL DEVICES, THE STANDARD HIGHWAY SIGN BOOK (SHS) PUBLISHED BY THE FEDERAL HIGHWAY ADMINISTRATION (FHWA), AND APPLICABLE VTRANS E-SERIES STANDARDS OR AS DIRECTED BY THE ENGINEER. SIGN LOCATIONS AS SHOWN ON THE PLANS ARE APPROXIMATE. EXACT LOCATIONS TO BE DETERMINED BY THE ENGINEER IN THE FIELD.
- ALL SIGNS WITHIN THE PROJECT LIMITS ARE TO BE REPLACED UNLESS OTHERWISE NOTED OR AS DIRECTED BY THE RESIDENT ENGINEER.
- THE CONTRACTOR SHALL BE RESPONSIBLE FOR REPAIRING ANY DAMAGE TO PRIVATE OR PUBLIC PROPERTY CAUSED BY THE CONTRACTOR, AT THEIR EXPENSE.
- ALL EXISTING MILE MARKER PLAQUES ATTACHED TO A DELINEATOR POST OR ATTACHED TO A RETAINED STAND ALONE SIGN POST ASSEMBLY SHALL BE RETAINED. IF AN EXISTING MILE MARKER PLAQUE IS ATTACHED TO A SIGN POST THAT IS TO BE REMOVED AND REPLACED IN THE SAME LOCATION, THE MILE MARKER PLAQUE SHALL BE REMOVED, SALVAGED AND INSTALLED TO THE NEW SIGN POST. IF AN EXISTING MILE MARKER PLAQUE IS ATTACHED TO A SIGN POST THAT IS TO BE RELOCATED TO A DIFFERENT LOCATION, THE MILE MARKER PLAQUE SHALL BE REMOVED, UNLESS OTHERWISE DIRECTED BY THE ENGINEER. PAYMENT FOR ANY OF THIS WORK SHALL BE INCIDENTAL TO ITEM 675.341 SQUARE TUBE POST AND ANCHOR. PAYMENT FOR NEW MILE MARKERS AS SHOWN ON THESE PLANS SHALL BE PAID FOR AS ITEM 675.20 TRAFFIC SIGN, TYPE A.
- SALVAGED SIGN TOTALS HAS BEEN ADDED TO THE TOTAL SIGN REMOVAL COLUMN ON THE TOWN TOTAL SIGN SUMMARY SHEET.
- EXISTING STREET NAME SIGNS ATTACHED TO SIGN POSTS THAT ARE TO BE REPLACED, SHALL BE REMOVED AND INSTALLED ONTO NEW POST. ALL WORK AND MATERIALS NECESSARY TO REMOVE AND INSTALL THE STREET NAME PLAQUES SHALL BE PAID FOR UNDER ITEM 675.60 ERECTING SALVAGED SIGNS. AN ESTIMATED QUANTITY HAS BEEN ADDED TO ITEM 675.60 TO PAY FOR THIS WORK.
- ALL EXISTING STREET NAME PLAQUES INSTALLED ON STAND ALONE SIGN POSTS SHALL BE RETAINED WITHIN THE PROJECT LIMITS.
- ALL SIGN PLACEMENT SHALL BE IN CONFORMANCE WITH STATE STANDARD E-120 STANDARD SIGN PLACEMENT CONVENTIONAL ROADS AND E-121 STANDARD SIGN PLACEMENT EXPRESSWAY AND FREEWAY.
- ALL SIGN LETTERING, DIGITS, ARROWS, AND DESIGN OF SYMBOLS FOR SIGNS DETAILED REFERENCED IN THESE PLANS SHALL CONFORM WITH THE "STANDARD ALPHABET FOR HIGHWAY SIGNS AND PAVEMENT MARKING" AS ADOPTED BY THE U.S. DEPARTMENT OF TRANSPORTATION AND THE FEDERAL HIGHWAY ADMINISTRATION (FHWA), UNLESS DETAILED WITHIN THESE PLANS.
- ALL COLORS SHALL CONFORM WITH THE STANDARD COLORS ADOPTED BY THE AMERICAN ASSOCIATION OF STATE HIGHWAY AND TRANSPORTATION OFFICIALS (AASHTO) AND APPROVED BY FHWA, UNLESS OTHERWISE NOTED.
- WITHIN THE TRAFFIC SIGN SUMMARY SHEETS FY= FLUORESCENT YELLOW SHEETING (ASTM VII, VIII, OR IX) AND FYG = FLUORESCENT YELLOW-GREEN SHEETING (ASTM TYPE VII, VIII, OR IX).
- SALVAGED SIGNS CALCULATED IN THE TRAFFIC SIGN SUMMARY SHEET HAVE BEEN INCLUDED INTO THE TOTAL FOR REMOVING SIGNS.
- UNLESS OTHERWISE DETAILED ON THE PLANS, ALL SIGN BASE MATERIAL SHALL BE FLAT SHEET ALUMINUM WITH THE FOLLOWING MINIMUM THICKNESSES:

SIZES			
	24" X 10"	36" X 12"	
	24" X 12"	36" X 15"	
	24" X 18"	36" X 18"	48" X 18"
	24" X 24"	36" X 24"	48" X 24"
	24" X 30"	30" X 15"	30" X 42"
	30" X 15"	30" X 18"	36" X 36"
	30" X 18"	30" X 30"	36" X 48"
	30" X 30"	30" X 42"	36" X 54"
	30" X 42"	36" X 48"	48" X 48"
	30" X 42"	36" X 54"	48" X 60"
THICKNESS	0.060"	0.080"	0.100"
			0.125"

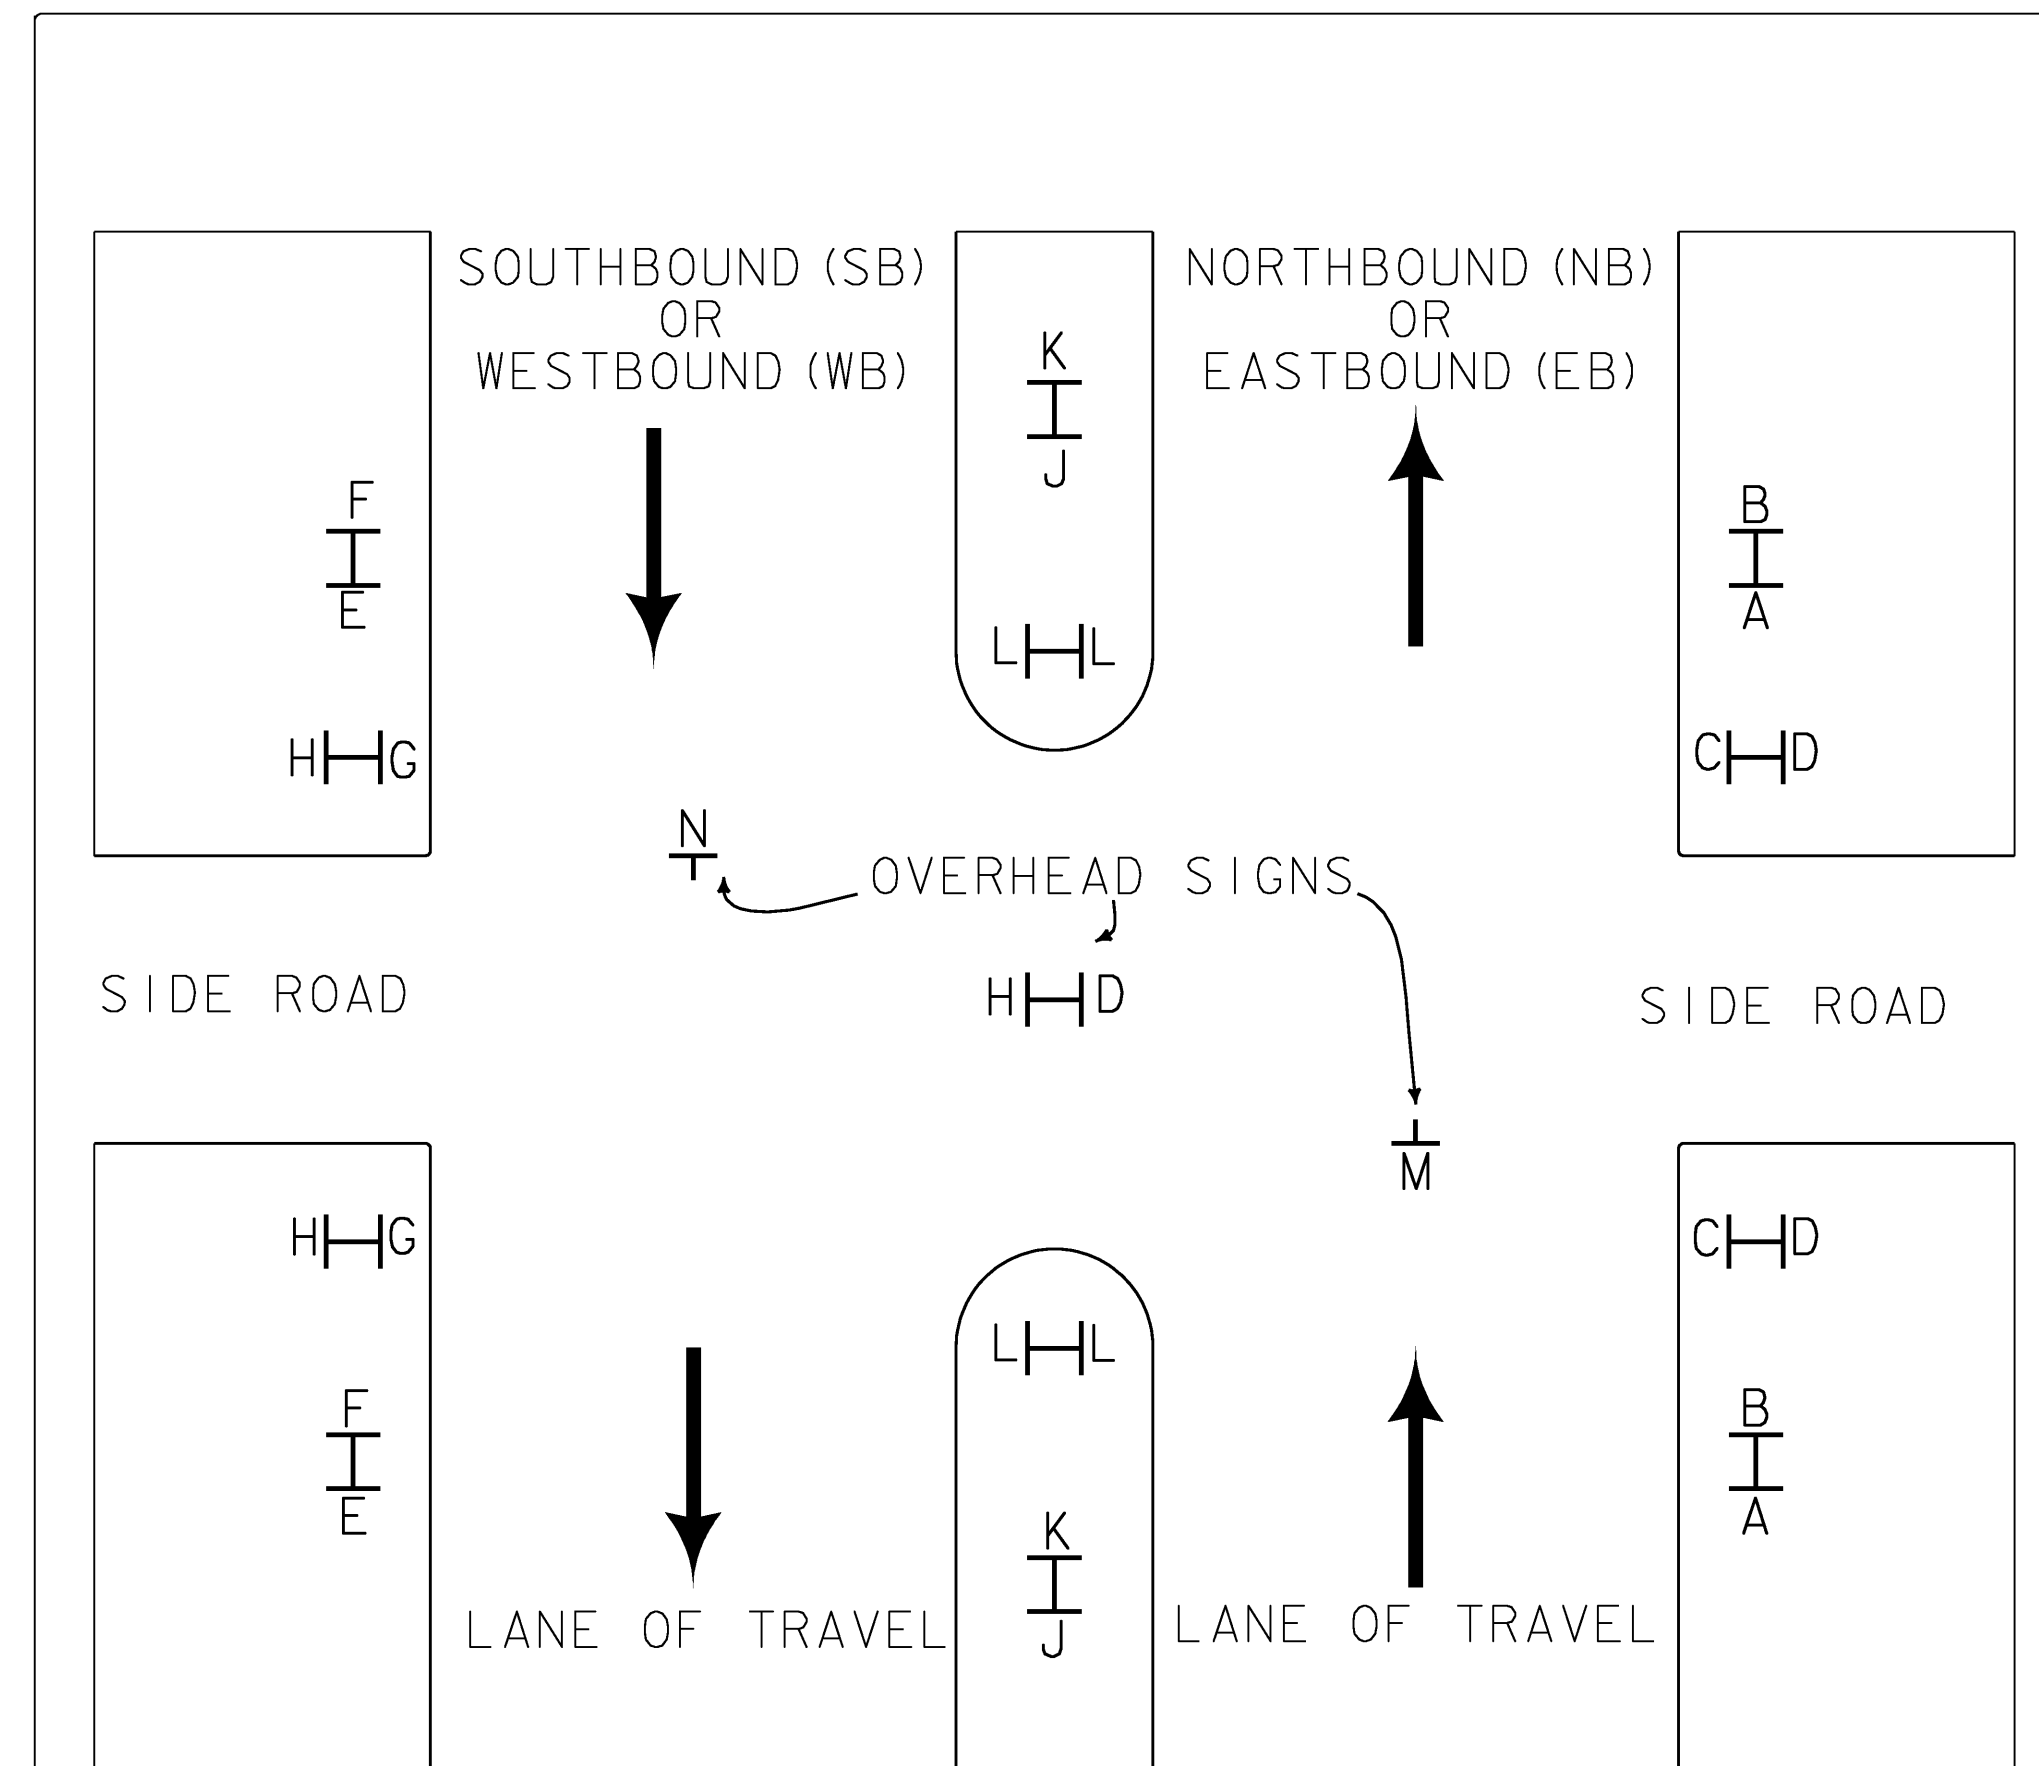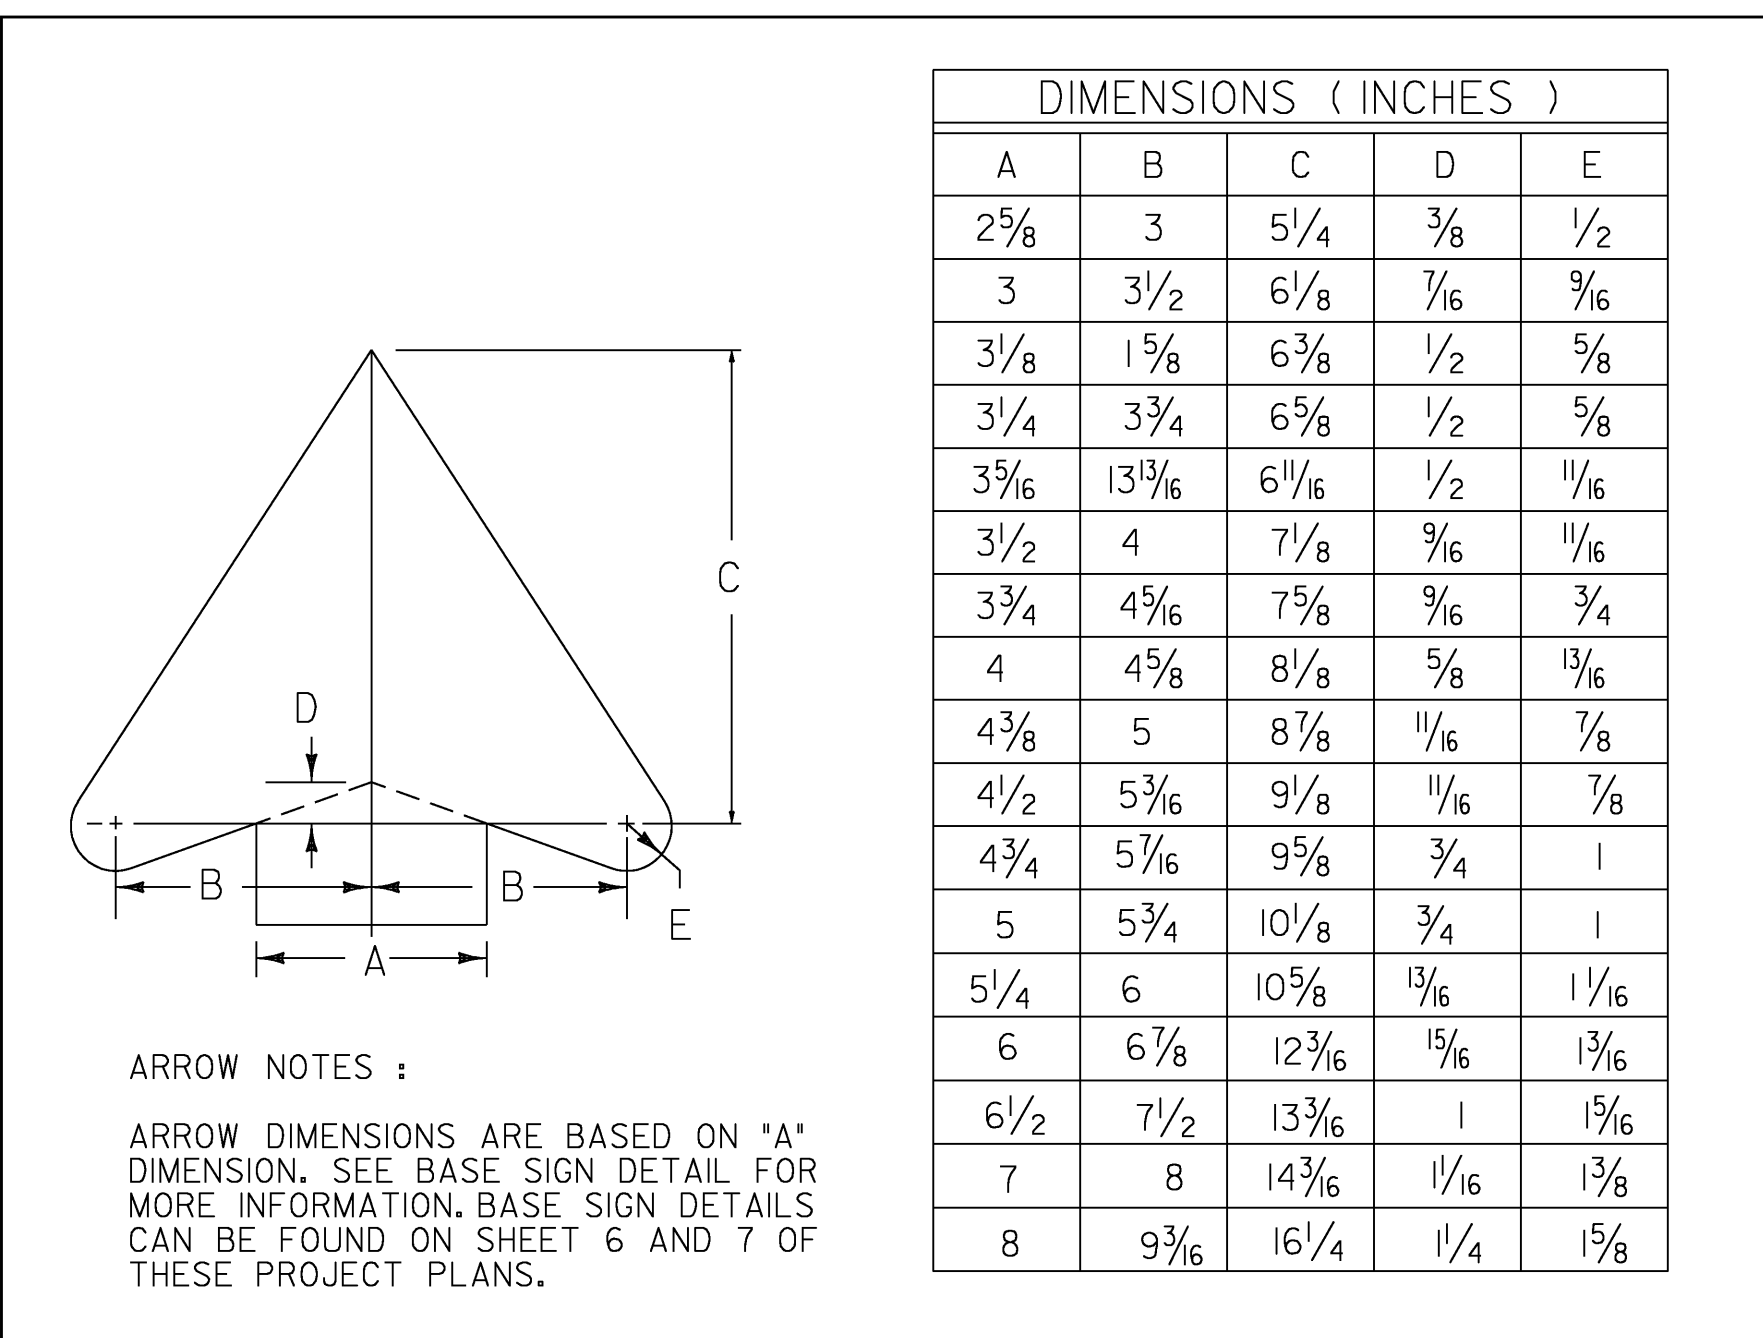

THE TRAFFIC SIGN LOCATION CODES ARE TO BE USED INCONJUNCTION WITH THE SIGN SUMMARY SHEETS TO ESTABLISH PROPER SIGN INSTALLATION IN THE FIELD.

TRAFFIC SIGN LOCATION CODES
NOT TO SCALE


PROJECT NAME:	STAMFORD - ANDOVER
PROJECT NUMBER:	STPG SIGN (20)
FILE NAME:	O9B022_TS.DGN
PROJECT LEADER:	N. AVERY
DESIGNED BY:	N. AVERY
GENREAL NOTES	
PLOT DATE:	06-AUG-2009
DRAWN BY:	N. AVERY
CHECKED BY:	A. GAMBLE
SHEET 2	OF 198

QUANTITY SHEET 1

SUMMARY OF ESTIMATED QUANTITIES										TOTALS			DESCRIPTIONS				DETAILED SUMMARY OF QUANTITIES		
										ROADWAY	GRAND TOTAL	FINAL	UNIT	ITEMS	ITEM NUMBER	ROUND	QUANTITIES	UNIT	ITEMS
										1	1		CY	TRENCH EXCAVATION OF EARTH, EXPLORATORY (N.A.B.I.)	204.22				
										56	56		HR	UNIFORMED TRAFFIC OFFICERS	630.10				
										940	940		HR	FLAGGERS	630.15				
										1	1		LS	MOBILIZATION/DEMOBILIZATION	635.11				
										1	1		LS	TRAFFIC CONTROL	641.10				
										5989.7	5989.7		SF	TRAFFIC SIGNS, TYPE A	675.20				
										16095	16095		LF	SQUARE TUBE SIGN POST AND ANCHOR	675.341				
										1195	1195		EACH	REMOVING SIGNS	675.50				
										97	97		EACH	ERECTING SALVAGED SIGNS	675.60				

TEXT	SERIES	DIMENSIONS	TEXT	SERIES	DIMENSIONS	TEXT	SERIES	DIMENSIONS
ADDISON	C	28.27	GEORGIA	C	27.74	POULTNEY	C	32.50
ALBANY	C	25.88	GLOVER	C	25.00	POWNAL	C	26.35
ALBURGH	C	29.99	GOSHEN	C	25.16	PROCTOR	C	29.31
ANDOVER	C	30.05	GLASTENBURY	B (5'')	31.32	PUTNEY	C	24.83
ARLINGTON	B	29.35	GRAFTON	C	29.31	RANDOLPH	C	32.50
ATHENS	C	24.49	GRAND ISLE	B	32.50	READING	C	27.47
AVERILL	C	26.44	GRANVILLE	C	32.50	READSBORO	B	31.09
BAKERSFIELD	B	32.50	GREENSBORO	B	32.50	RICHFORD	C	32.06
BARNARD	C	30.49	GROTON	C	25.35	RICHMOND	C	32.50
BARNET	C	24.83	GUILDHALL	C	32.50	RIFTON	C	22.97
BARRE CITY	B	32.50	GUILFORD	C	31.78	ROCHESTER	B	29.54
BARRE TOWN	B	32.50	HALIFAX	C	27.14	ROCKINGHAM	B	32.50
BARTON	C	25.38	HANCOCK	C	29.96	ROXBURY	C	30.44
BELVIDERE	C	32.50	HARDWICK	C	32.50	ROYALTON	C	32.50
BENNINGTON	B	32.50	HARTFORD	C	32.50	RUPERT	C	24.94
BENSON	C	25.41	HARTLAND	C	32.50	RUTLAND CITY	B (5'')	32.50
BERKSHIRE	B	29.04	HIGHGATE	C	31.14	RUTLAND TOWN	B (5'')	32.50
BERLIN	C	22.50	HINESBURG	B	28.47	RYEGATE	C	28.47
BETHEL	C	23.80	HOLLAND	C	29.22	ST. ALBANS CITY	B (5'')	32.50
BLOOMFIELD	B	32.13	HUBBARDTON	B	31.42	ST. ALBANS TOWN	B (5'')	32.50
BOLTON	C	24.39	HYDE PARK	B	32.50	ST. GEORGE	B	32.50
BRADFORD	C	32.50	IRA	C	10.15	ST. JOHNSBURY	B (5'')	32.50
BRAINTREE	C	32.50	IRASBURG	C	32.37	SALISBURY	C	32.50
BRANDON	C	30.46	ISLE LA MOTTE	B (5'')	32.50	SEARSBURG	B	30.93
BRATTLEBORO	B	32.50	JAMAICA	C	28.26	SHAFTSBURY	B	32.50
BRIDGEWATER	B	32.50	JAY	C	11.85	SHARON	C	25.91
BRIDPORT	C	32.06	JERICHO	C	27.24	SHEFFIELD	C	32.50
BRIGHTON	C	32.06	JOHNSON	C	30.39	SHELDON	C	29.42
BRISTOL	C	27.24	KILLINGTON	B	30.16	SHOREHAM	C	32.50
BROOKFIELD	B	31.91	KIRBY	C	18.99	SHREWSBURY	B	32.50
BROWNINGTON	B	31.22	LANDGROVE	B	30.33	S. BURLINGTON	B (5'')	32.50
BRUNSWICK	B	30.60	LEICESTER	C	32.50	SOUTH HERO	B	32.50
BURKE	C	20.93	LEMINGTON	B	28.79	SPRINGFIELD	B	32.50
BUELS GORE	B	32.50	LONDONDERRY	B (5'')	32.18	STAMFORD	C	32.50
BURLINGTON	B	32.50	LOWELL	C	25.04	STARKSBORO	B	32.50
CABOT	C	20.50	LUDLOW	C	26.10	STOCKBRIDGE	B	32.50
CALAIS	C	22.22	LUNENBERG	B	30.01	STOWE	C	21.30
CAMBRIDGE	B	29.74	LYNDON	C	24.96	STRAFFORD	B	30.42
CANAAN	C	25.15	MAIDSTONE	B	29.51	STRATTON	C	32.06
CASTLETON	B	29.32	MANCHESTER	B	32.50	SUDBURY	C	30.77
CAVENDISH	C	32.50	MARLBORO	C	32.50	SUNDERLAND	B	32.50
CHARLESTON	B	32.50	MARSHFIELD	B	32.47	SUTTON	C	24.21
CHARLOTTE	B	29.32	MENDON	C	26.02	SWANTON	C	30.22
CHELSEA	C	28.84	MIDDLEBURY	B	32.50	THETFORD	C	32.50
CHESTER	C	28.46	MIDDLESEX	B	29.06	TINMOUTH	C	32.14
CHITTENDEN	B	30.56	MIDDLETOWN SPR	B (5'')	32.50	TOPSHAM	C	30.53
CLARENDON	B	30.32	MILTON	C	22.63	TOWNSHEND	B	31.70
COLCHESTER	B	32.50	MONTGOMERY	B	32.50	TROY	C	16.54
CONCORD	C	30.42	MONTPELIER	B	31.94	TUNBRIDGE	C	32.50
CORINTH	C	27.27	MORETOWN	C	32.50	UNDERHILL	C	32.50
CORNWALL	C	32.50	MORGAN	C	26.52	VERGENNES	B	30.03
COVENTRY	C	32.50	MORRISTOWN	B	32.50	VERNON	C	25.79
CRAFTSBURY	B	32.50	MOUNT HOLLY	B (5'')	31.97	VERSHIRE	C	31.72
DANBY	C	21.65	MOUNT TABOR	B	32.02	WAITSFIELD	B	30.44
DANVILLE	C	31.16	NEWARK	C	25.65	WALDEN	C	25.46
DERBY	C	21.15	NEWBURY	C	30.87	WALLINGFORD	B	32.50
DORSET	C	24.55	NEWFANE	C	29.73	WALTHAM	C	29.91
DOVER	C	20.74	NEW HAVEN	B	32.50	WARDSBORO	B	32.29
DUMMERSTON	B	32.50	NEWPORT CITY	B (5'')	32.50	WARREN	C	25.99
DUXBURY	C	30.75	NEWPORT TOWN	B (5'')	32.50	WARRENS GORE	B (5'')	32.50
EDEN	C	15.85	NORTH HERO	B	32.50	WASHINGTON	B	32.50
ENOSBURG	C	32.50	NORTHFIELD	B	31.57	WATERBURY	B	31.40
EAST HAVEN	B	32.50	NORTON	C	25.60	WATERFORD	B	30.65
E. MONTPELIER	B (5'')	32.50	NORWICH	C	28.77	WATERVILLE	B	31.35
ELMORE	C	25.46	ORANGE	C	25.88	WEATHERSFIELD	B (5'')	32.50
ESSEX	C	20.38	ORWELL	C	25.57	WELLS	C	20.83
FAIRFAX	C	27.05	PANTON	C	25.38	WEST FAIRLEE	B (5'')	32.50
FAIRFIELD	C	32.50	PAWLET	C	24.59	WESTFIELD	C	32.50
FAIR HAVEN	B	32.50	PEACHAM	C	30.23	WEST HAVEN	B	32.50
FAIRLEE	C	26.12	PERU	C	16.38	WESTFORD	C	32.50
FAYSTON	C	28.85	PITTSFIELD	C	32.50	WESTMINISTER	B	32.50
FERDINAND	B	29.17	PITTSFORD	C	32.50	WESTMORE	C	32.50
FERRISBURGH	B	32.50	PLAINFIELD	B	29.65	WESTON	C	25.85
FLETCHER	C	31.85	PLYMOUTH	C	32.50			
FRANKLIN	C	31.31	POMFRET	C	29.42			


TEXT	SERIES	DIMENSIONS
WEST RUTLAND	B (5'')	32.50
WEST WINDSOR	B (5'')	32.50
WEYBRIDGE	C	32.50
WHEELLOCK	C	32.50
WHITING	C	25.86
WHITINGHAM	B	32.50
WILLIAMSTOWN	B (5'')	32.50
WILLISTON	C	32.50
WILMINGTON	B	32.16
WINDHAM	C	29.66
WINDSOR	C	28.77
WINHALL	C	28.24
WINOOSKI	C	30.81
WOLCOTT	C	29.38
WOODBURY	C	32.50
WOODFORD	C	32.50
WOODSTOCK	B	31.79
WORCESTER	B	30.76

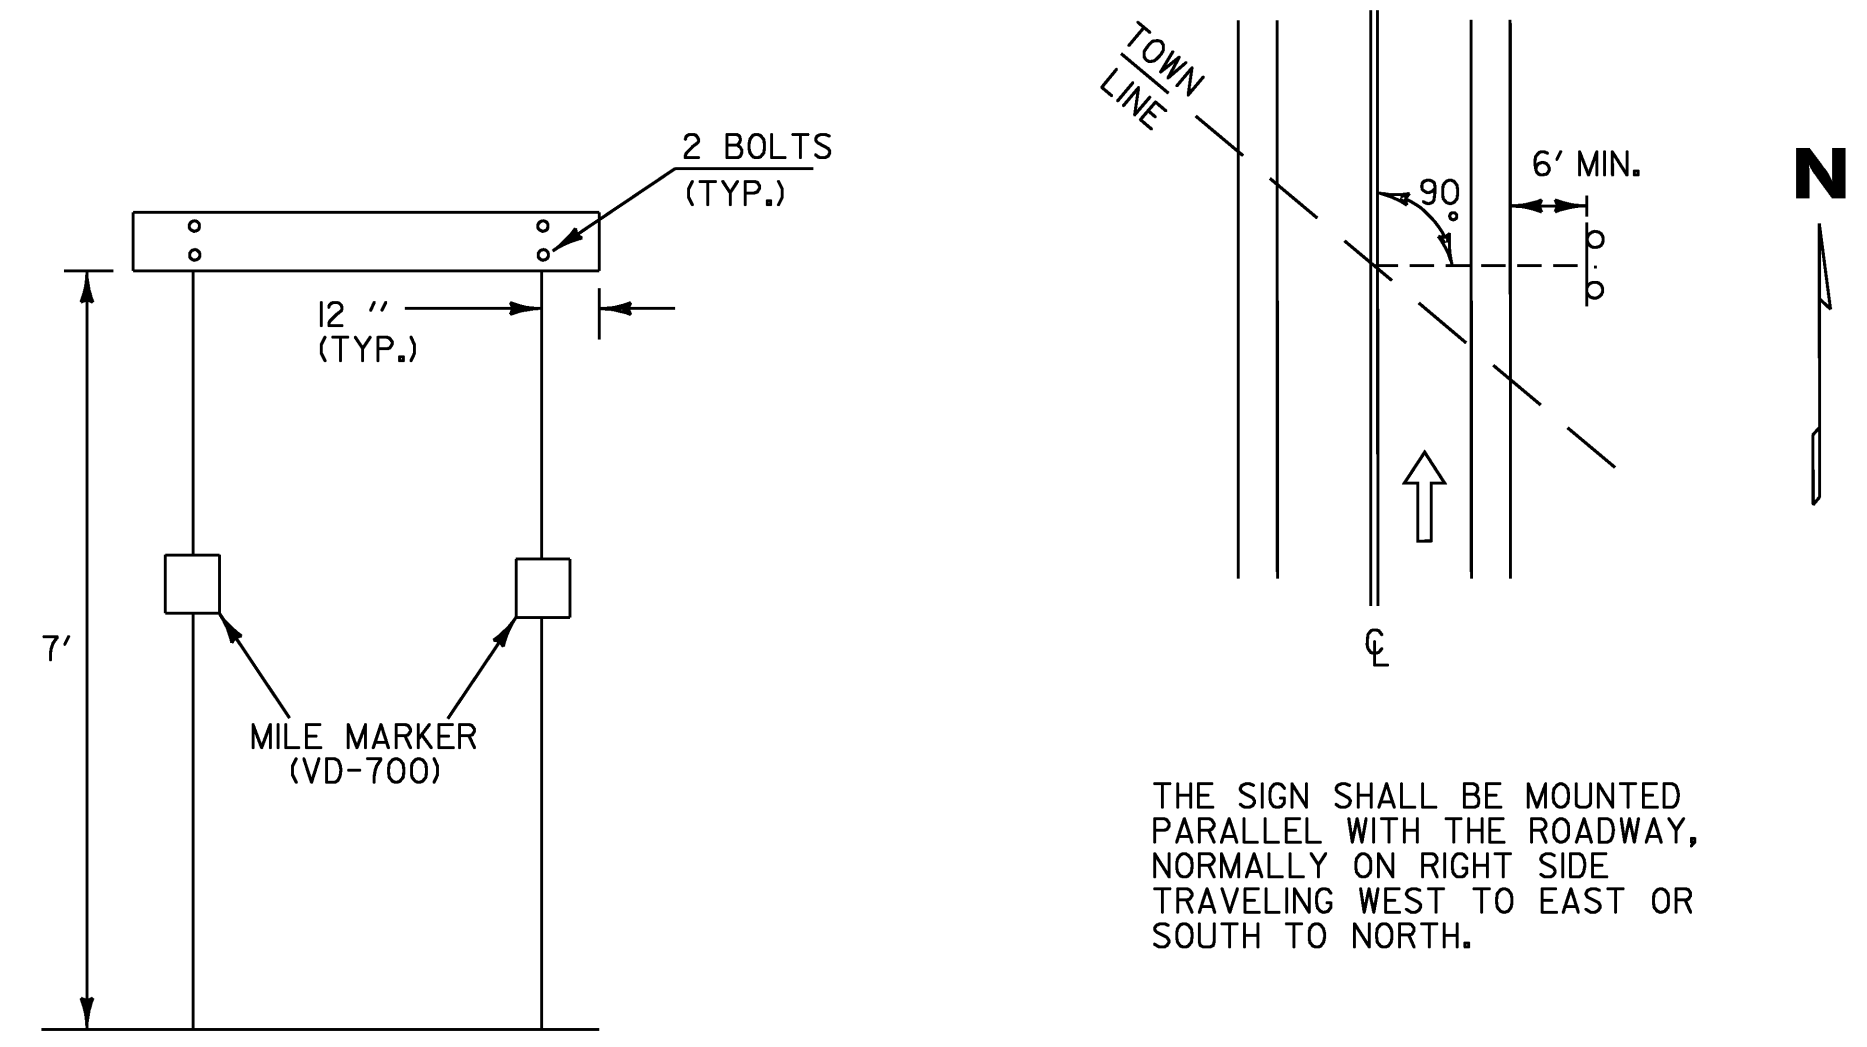

- NOTES:**
- WORD TO WORD SPACING FOR MULTIPLE TEXT TOWN NAMES IS ADJUSTABLE TO ACCOMMODATE DIMENSION REQUIREMENTS.
 - DIMENSIONS SHOWN ARE APPROXIMATE AND MAY BE ADJUSTED SLIGHTLY TO ACCOMMODATE VARIOUS MANUFACTURER'S LETTER WIDTHS.
 - ALL DIMENSIONS ARE IN INCHES UNLESS OTHERWISE NOTED

WHEN CROSSING COUNTY BOUNDARIES AN ADDITIONAL COUNTY LINE SIGN SHALL BE MOUNTED BELOW THE TOWN LINE SIGN MAINTAINING AN SEVEN FOOT CLEARANCE.

TEXT	SERIES	DIMENSIONS
ADDISON CO.	B	32.50
BENNINGTON CO.	B (5'')	32.50
CALEDONIA CO.	B (5'')	32.50
CHITTENDEN CO.	B (5'')	32.50
ESSEX CO.	C	32.50
FRANKLIN CO.	B (5'')	32.50
GRAND ISLE CO.	B (5'')	32.50
LAMOILLE CO.	B (5'')	32.50
ORANGE CO.	B	32.50
ORLEANS CO.	B	32.50
RUTLAND CO.	B	32.50
WASHINGTON CO.	B (5'')	32.50
WINDHAM CO.	B	32.50
WINDSOR CO.	B	32.50

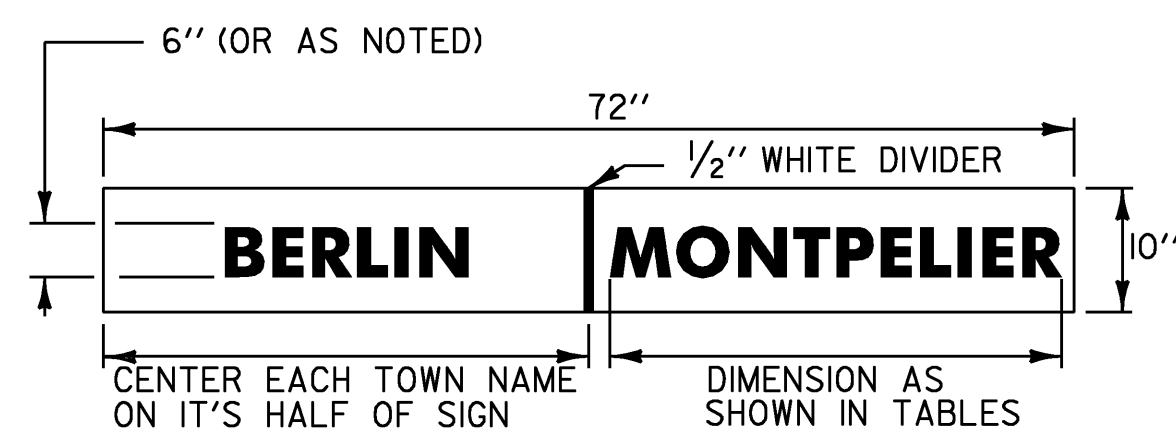

VD-024
VD-025 SIMILAR


VD-025

- TOWN/COUNTY LINE SIGN NOTES:**
- THE SIGN BASE MATERIAL SHALL BE HIGH DENSITY OVERLAIN PLYWOOD 5/8 INCH THICK OR ALUMINUM SHEETING 0.125" MINIMUM THICKNESS. THE RETROREFLECTIVE MATERIAL SHALL BE SHEETING APPLIED TO THE ENTIRE BACKGROUND OF THE SIGN. THE LEGEND SHALL BE CUT-OUT RETROREFLECTIVE LEGEND. ALL RETROREFLECTIVE MATERIAL SHALL BE EQUAL TO OR EXCEEDING THE "THE AMERICAN SOCIETY OF TESTING AND MATERIALS" (ASTM 4956-01) TYPE III SHEETING.
 - SIGNS SHALL HAVE A MINIMUM ASTM TYPE III SHEETING WITH A WHITE LEGEND ON A GREEN BACKGROUND.
 - LEGEND SHALL CONFORM WITH THE STANDARD ALPHABETS FOR HIGHWAY SIGNS APPROVED BY THE NATIONAL JOINT COMMITTEE ON UNIFORM TRAFFIC CONTROL DEVICES.
 - ALL SIGNS SHALL BE IN ACCORDANCE WITH "THE MANUAL ON UNIFORM TRAFFIC CONTROL DEVICES" (2003 MUTCD) AND THE "STANDARD HIGHWAY SIGNS" BOOK (SHS) PUBLISHED BY THE FEDERAL HIGHWAY ADMINISTRATION (FHWA).

PROJECT NAME:	STAMFORD - ANDOVER
PROJECT NUMBER:	STPG SIGN (20)
FILE NAME:	09b022_TS.DGN
PLOT DATE:	06-AUG-2009
PROJECT LEADER:	N. AVERY
DRAWN BY:	N. AVERY
DESIGNED BY:	N. AVERY
CHECKED BY:	A. GAMBLE
COUNTY/ TOWNLIN DESIGN	SHEET 4 OF 198




D1-1

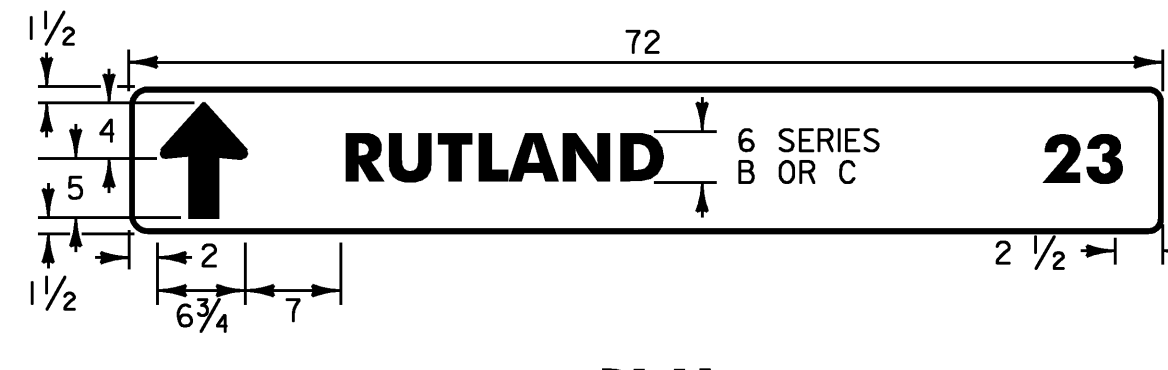

D1-1A




D1-1A

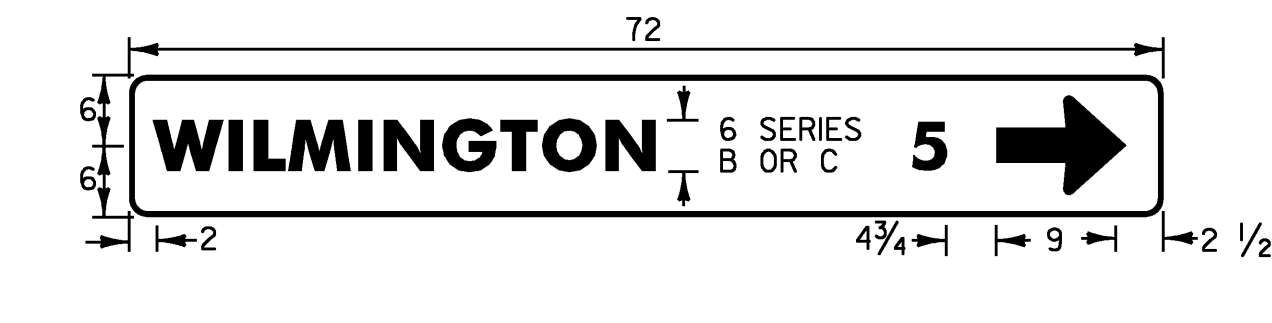

D1-1A




D2-1

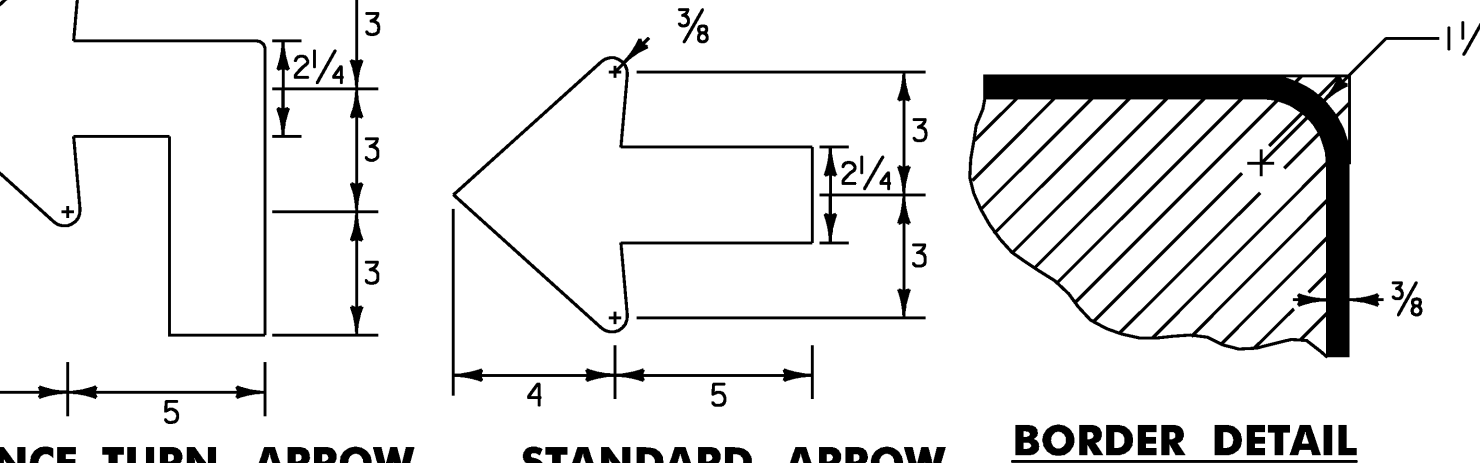


**STANDARD DESTINATION SIGN NOTES
D1-1, D1-1A, D1-2, D2-1**

- ALL SIGNS SHALL BE IN ACCORDANCE WITH THE MUTCD AND THE "STANDARD HIGHWAY SIGNS" BOOK (SHS) PUBLISHED BY THE FEDERAL HIGHWAY ADMINISTRATION (FHWA).
- THE SIGN BASE MATERIAL FOR STANDARD DESTINATION SIGNS SHALL BE HIGH DENSITY OVERLAYED PLYWOOD 3/8" INCH THICK OR FLAT SHEET ALUMINUM 1/8" INCH THICK.
- THE DESTINATION SIGNS SHOWN ON THIS SHEET SHALL HAVE WHITE RETROREFLECTIVE ASTM TYPE III TEXT, ARROWS AND BORDERS ON A GREEN RETROREFLECTIVE ASTM TYPE III BACKGROUND, THE COLORS SHALL CONFORM WITH THE COLORS ADOPTED BY AASHTO AND APPROVED BY THE FHWA.
- MULTIPLE ASSEMBLIES SHALL USE THE SAME SIZE THROUGHOUT. DO NOT MIX AND MATCH OLDER SIGN SIZES WITH NEW SIGN HEIGHTS AND WIDTHS.
- ALL DIMENSIONS SHOWN IN INCHES UNLESS OTHERWISE NOTED.

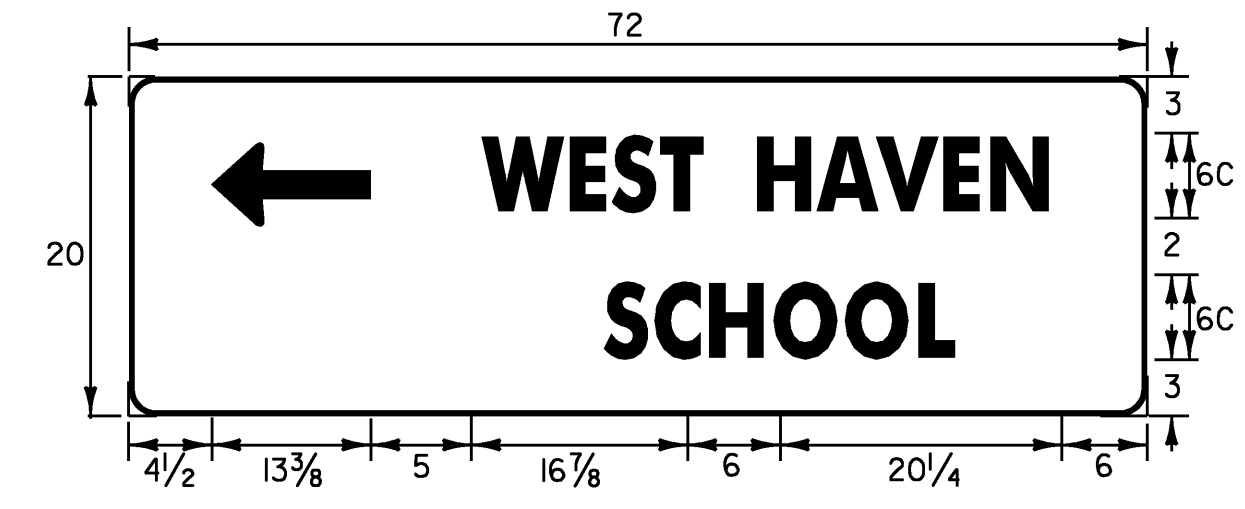


D1-2 (L)

LATERAL SPACING OF "SCHOOL" TEXT SHALL BE CENTERED TO TOP LINE TEXT.

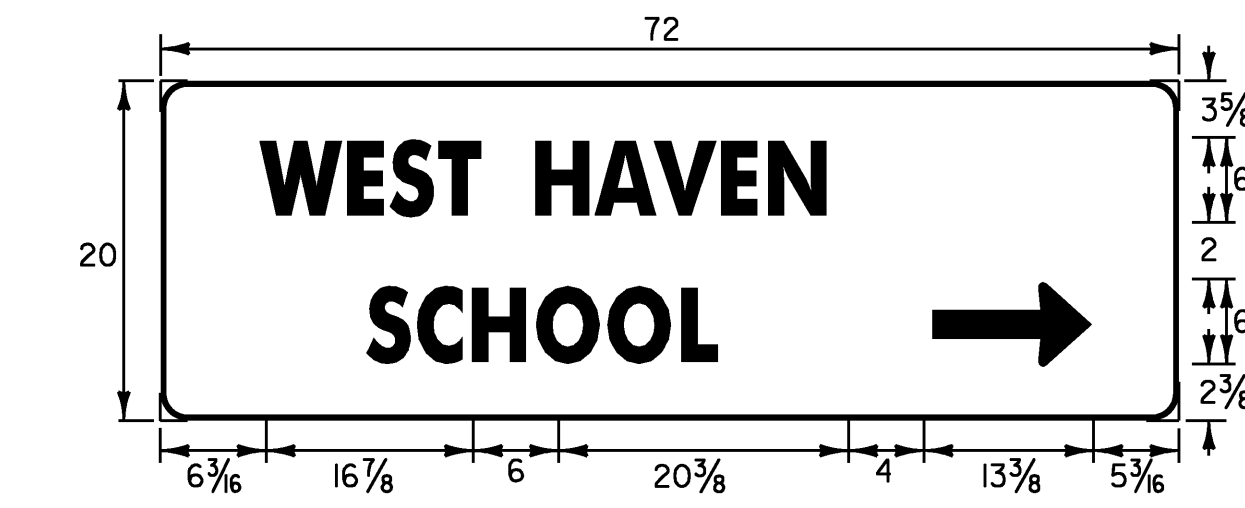



D1-2 (R)

LATERAL SPACING OF "SCHOOL" TEXT SHALL BE CENTERED TO TOP LINE TEXT.

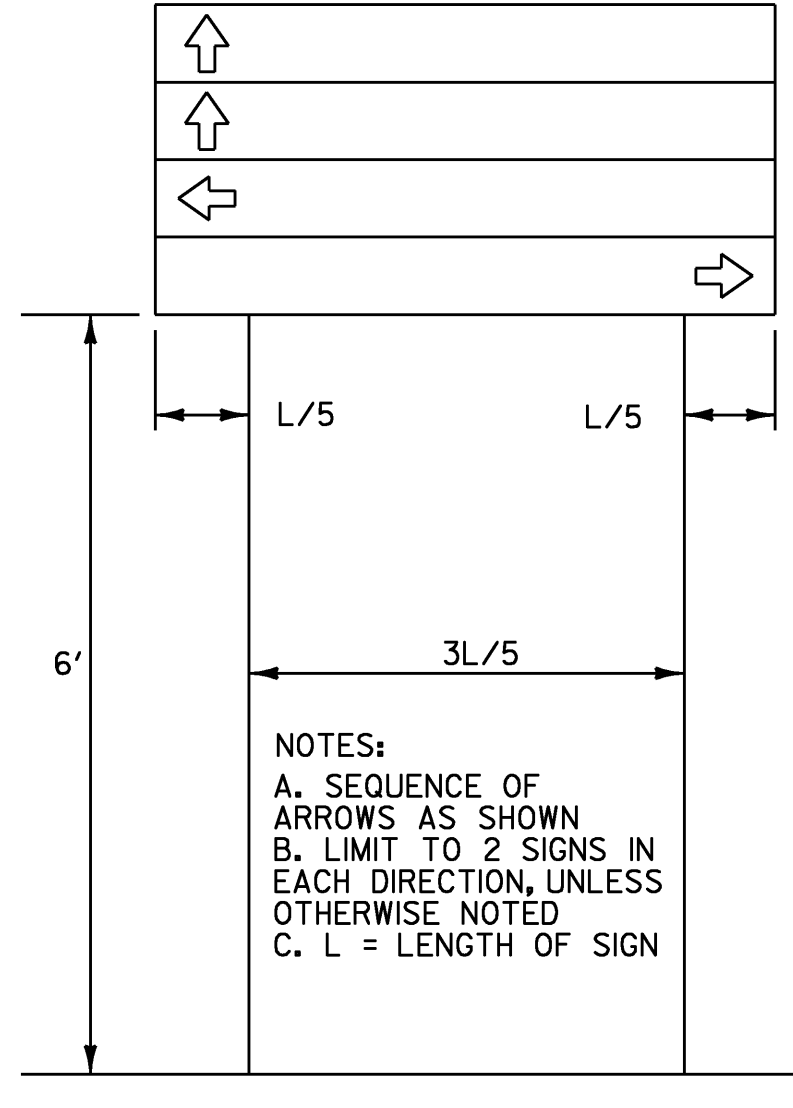

DESTINATION ASSEMBLY

NOTES:
A. SEQUENCE OF ARROWS AS SHOWN
B. LIMIT TO 2 SIGNS IN EACH DIRECTION, UNLESS OTHERWISE NOTED
C. L = LENGTH OF SIGN

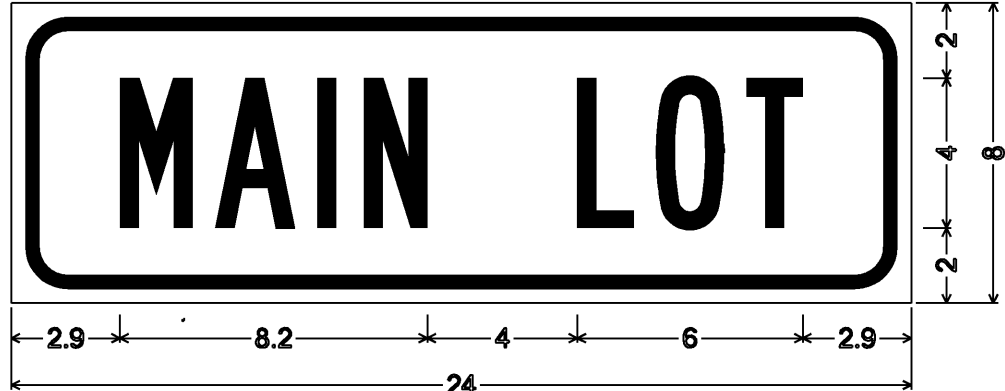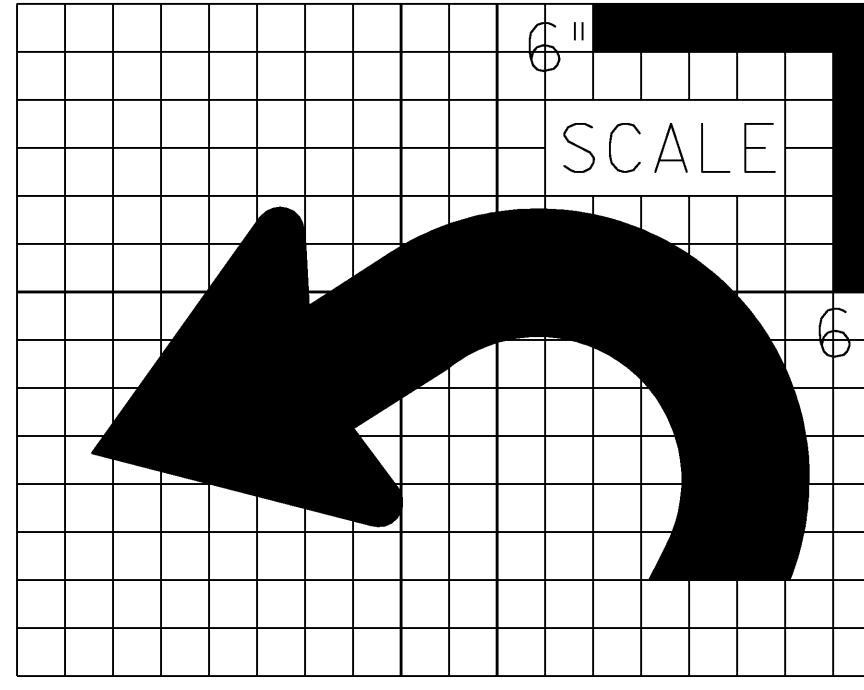


1.5" Radius, 0.4" Border, 0.4" Indent, Green on White; "MAIN LOT" B: VR-731




D1-1A

1.5" Radius, 0.4" Border, White on Green; Standard Arrow Custom 9.0" X 6.8" 180°; "STRATTON MTN" B specified length; "SKI" C; "AREA" C; "10" B specified length;

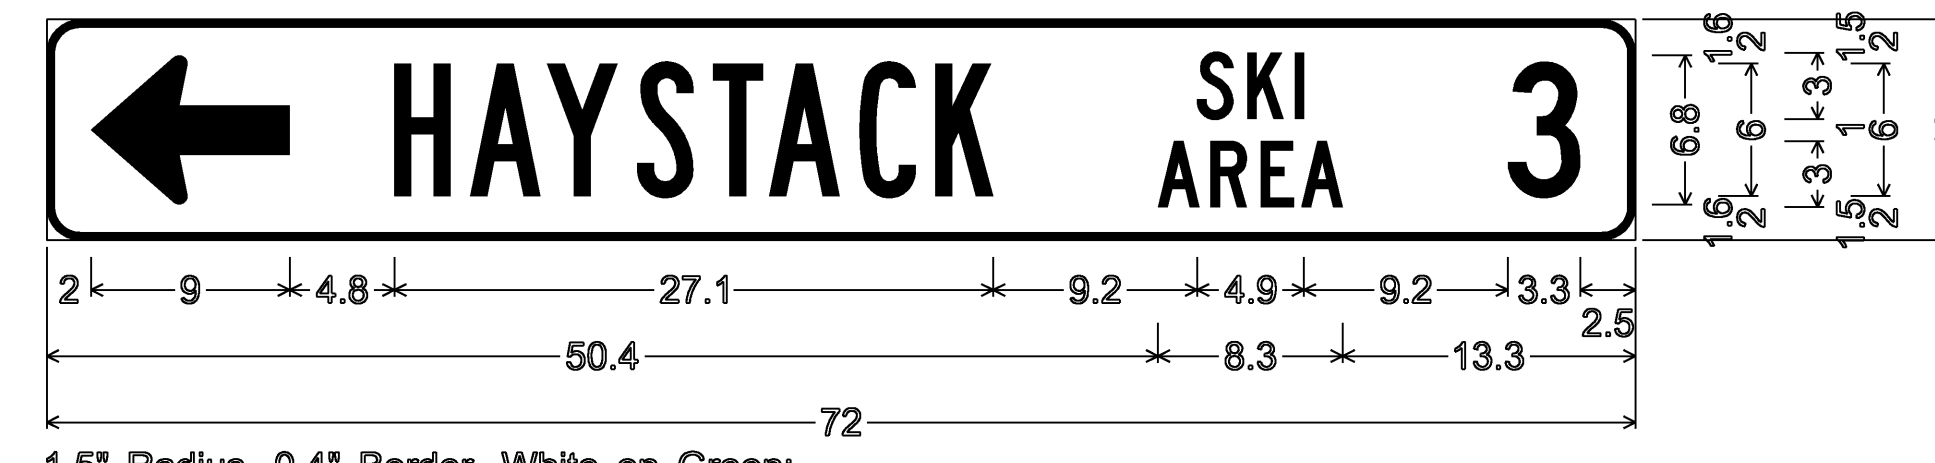

D1-1A

1.5" Radius, 0.4" Border, White on Green; Standard Arrow Custom 9.0" X 6.8" 180°; "HAYSTACK" B; "SKI" C; "AREA" C; "3" C;

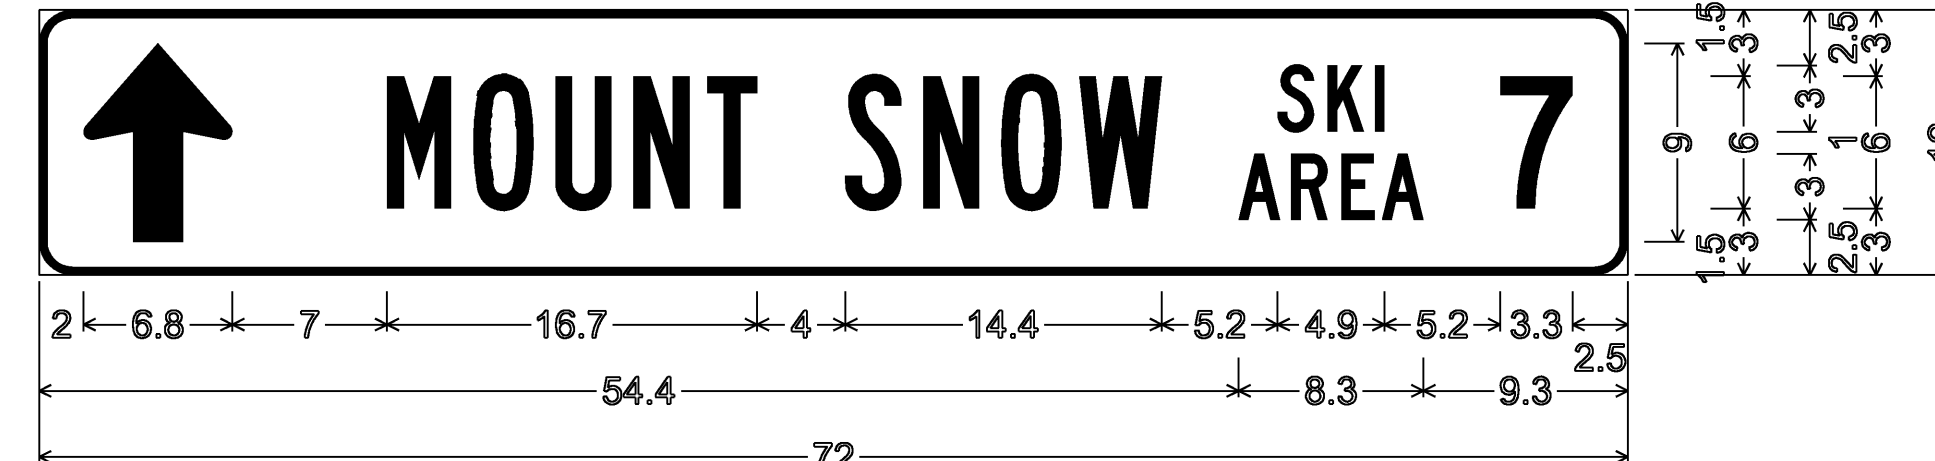

D1-1A

1.5" Radius, 0.4" Border, White on Green; Standard Arrow Custom 9.0" X 6.8" 90°; "MOUNT SNOW" B 90% spacing; "SKI" C; "AREA" C; "7" C;




D1-1A

1.5" Radius, 0.4" Border, White on Green; Arrow Custom - 9.0" 135°; "GREENFIELD," B " " C "MA" B " " C "26" B specified length;




D2-1

1.5" Radius, 0.4" Border, White on Green; "GREENFIELD, MA" B; Standard Arrow Custom 14.9" X 6.8" 0°;

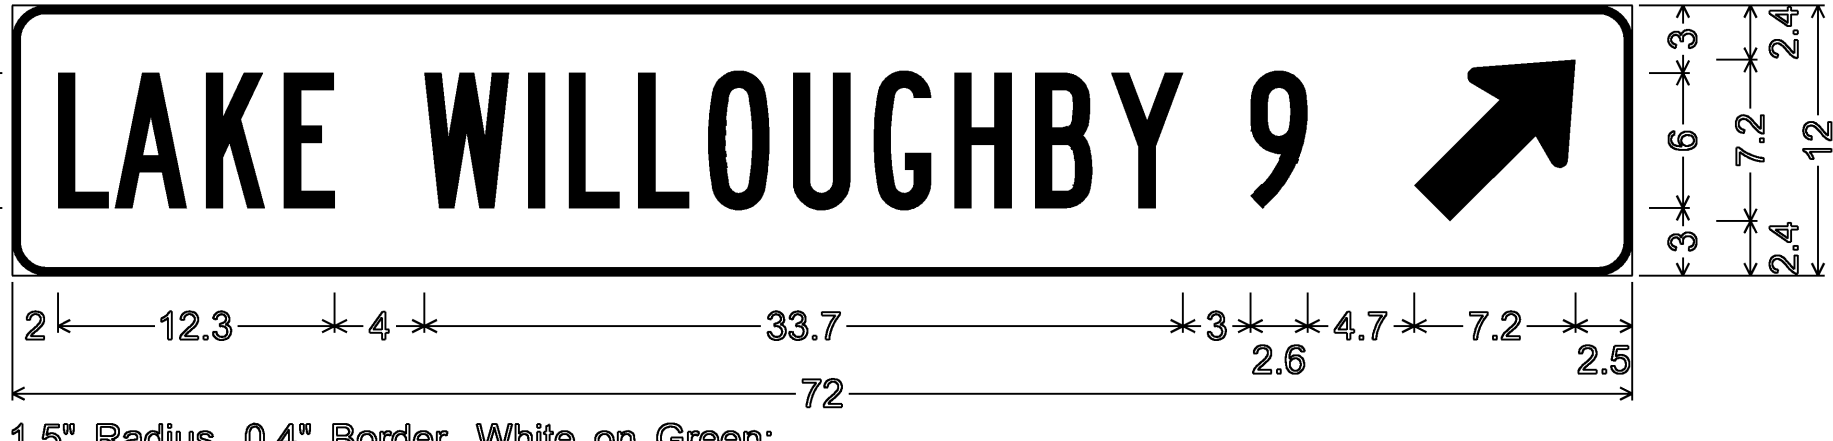


D1-1A

1.5" Radius, 0.4" Border, White on Green; "LAKE WILLOUGHBY" B specified length; "9" B; Standard Arrow Custom 9.0" X 6.0" 45°;

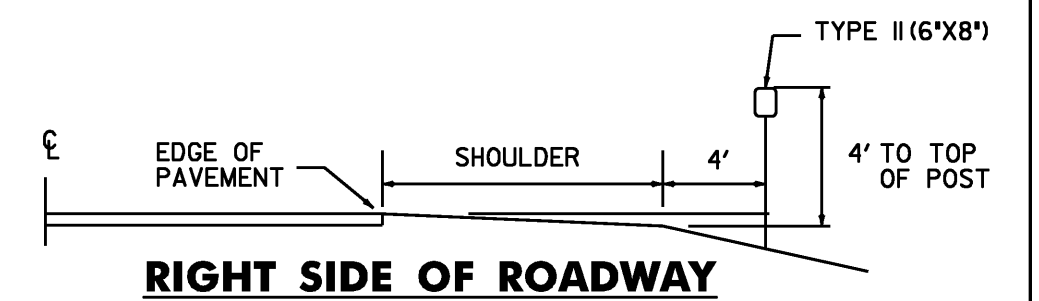


RIGHT SIDE OF ROADWAY

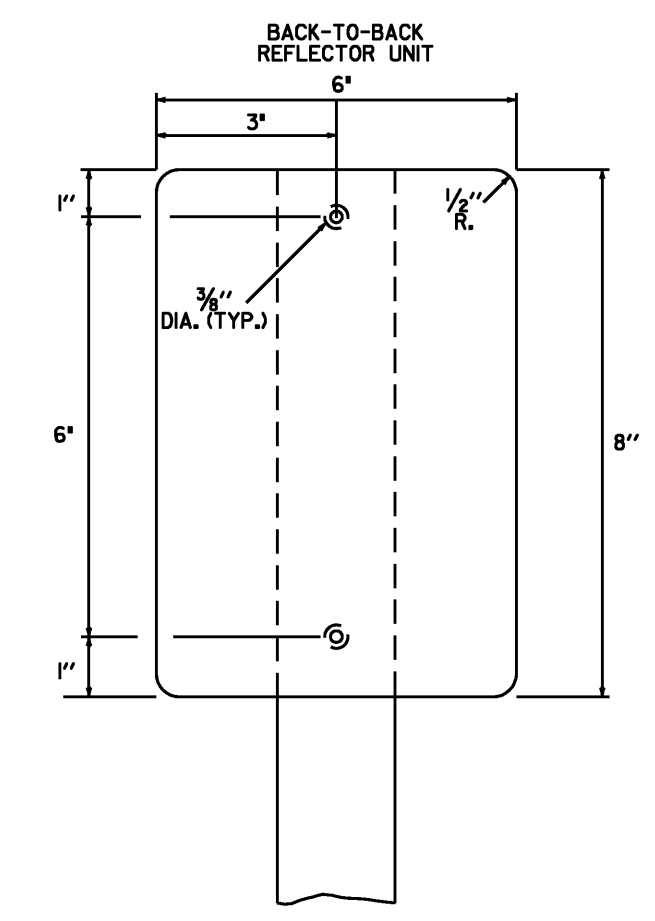

TYPE II (6"X8")

DELINEATORS WITH RETROREFLECTIVE SHEETING

MATERIAL FOR RETROREFLECTIVE SHEETING FOR DELINEATORS SHALL BE A 0.063" ALUMINUM BACKING WITH A WHITE ASTM TYPE III OR TYPE IV.

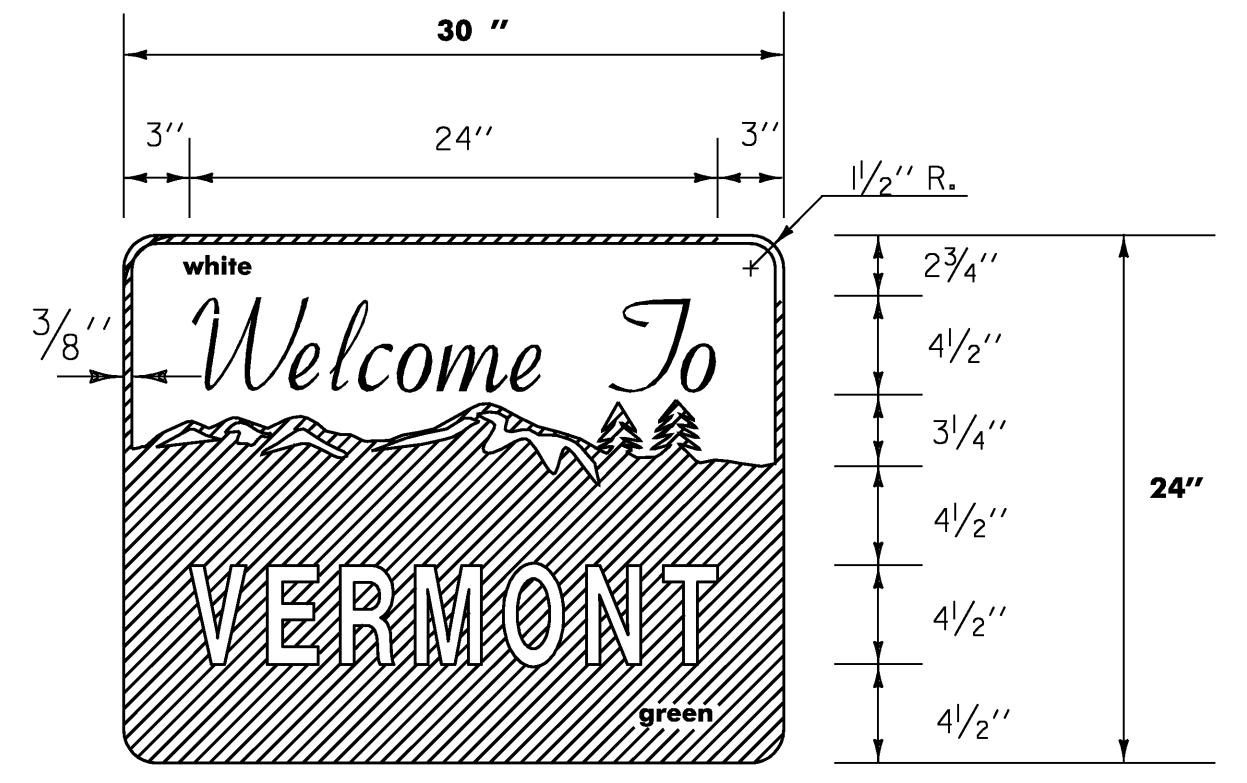

VD-421

NOTE:
FOR THE WORDS "WELCOME TO" USE GERBER FONT MURRAY HILL BOLD OR EQUIVALENT. TEXT COLOR IS GREEN. ALL OTHER TEXT USE GERBER FONT SOUVENIR DEMIBOLD OR EQUIVALENT. TEXT COLOR IS WHITE. REFER TO STD. E-131 FOR COLORS.

MATERIALS:
SEE STD. E-136 FOR MATERIALS




PROJECT NAME: STAMFORD - ANDOVER

PROJECT NUMBER: STPG SIGN (20)


FILE NAME: 09B022_TS.DGN
PROJECT LEADER: N. AVERY
DESIGNED BY: N. AVERY
SIGN DESIGNS I

PLOT DATE: 06-AUG-2009
DRAWN BY: N. AVERY
CHECKED BY: A. GAMBLE
SHEET 5 OF 198

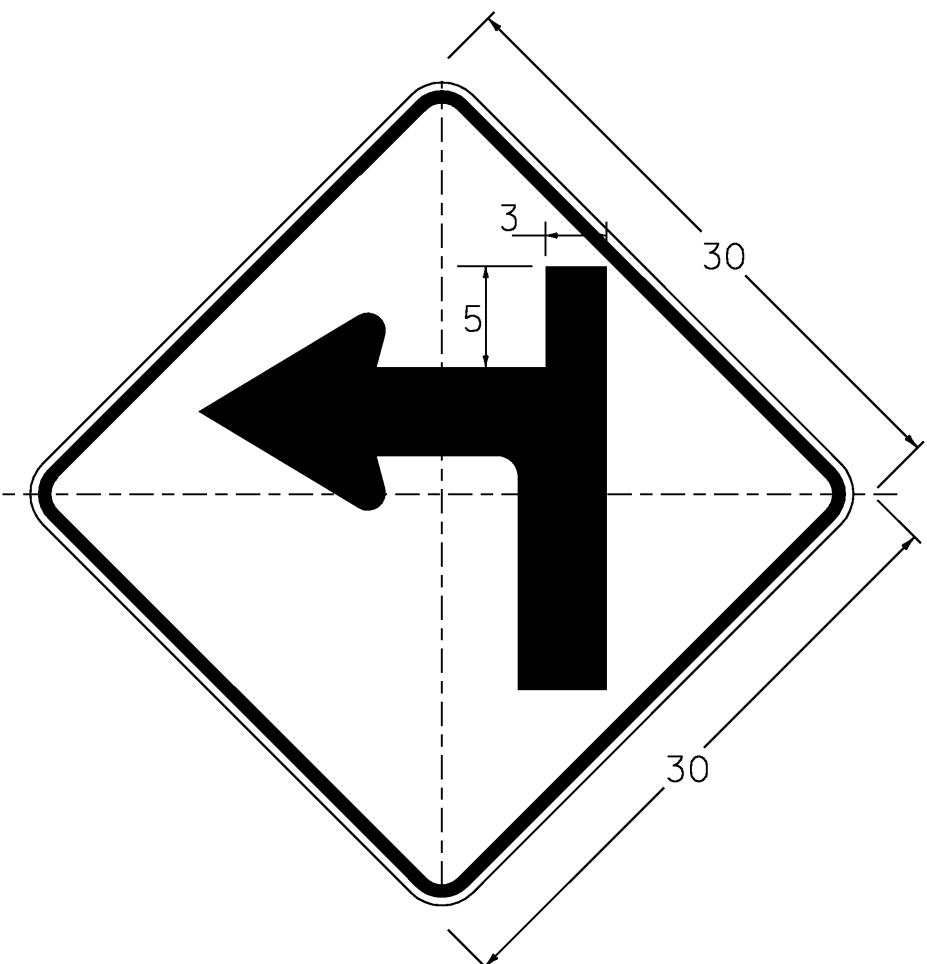


W1-1Mb L(R)

DIMENSIONS NOT SHOWN
FOR THIS DETAIL SHALL CONFORM
TO THE LATEST EDITION OF THE 2003 MUTCD
FOR SIGN DETAIL W1-1.
UNLESS OTHERWISE NOTED FOR THIS DETAIL

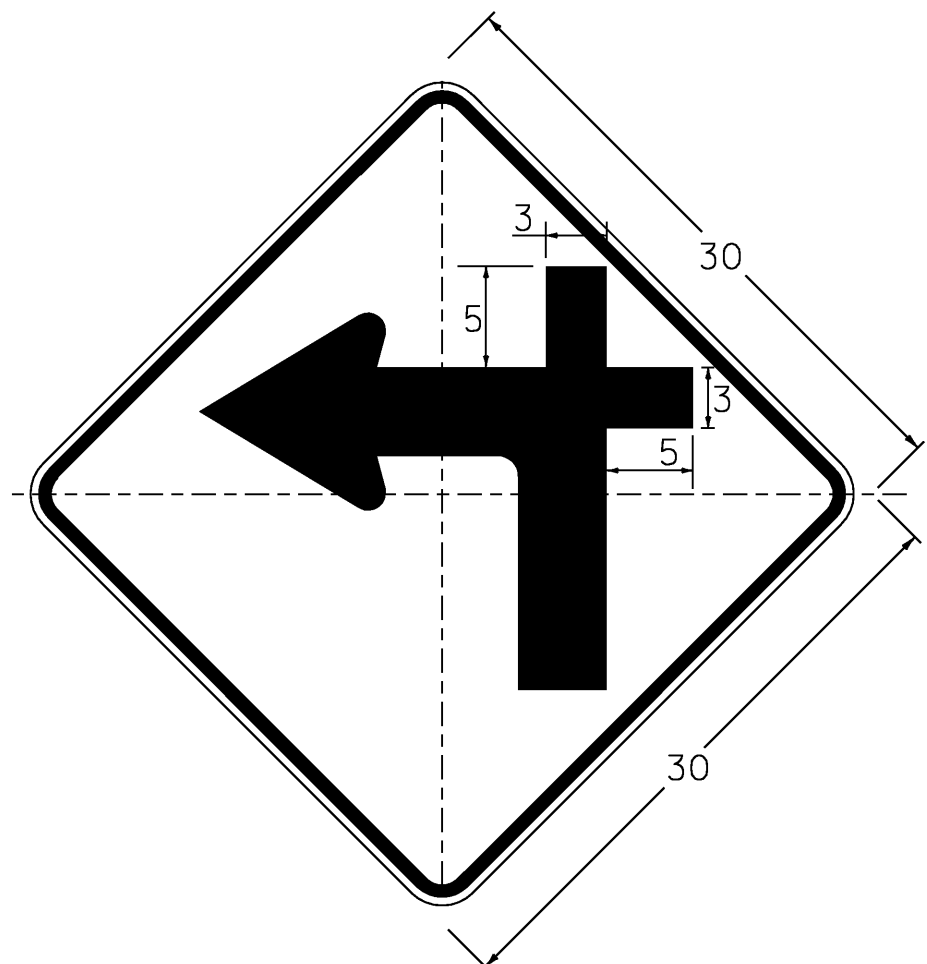


W1-1Mc L(R)

DIMENSIONS NOT SHOWN
FOR THIS DETAIL SHALL CONFORM
TO THE LATEST EDITION OF THE 2003 MUTCD
FOR SIGN DETAIL W1-1.
UNLESS OTHERWISE NOTED FOR THIS DETAIL

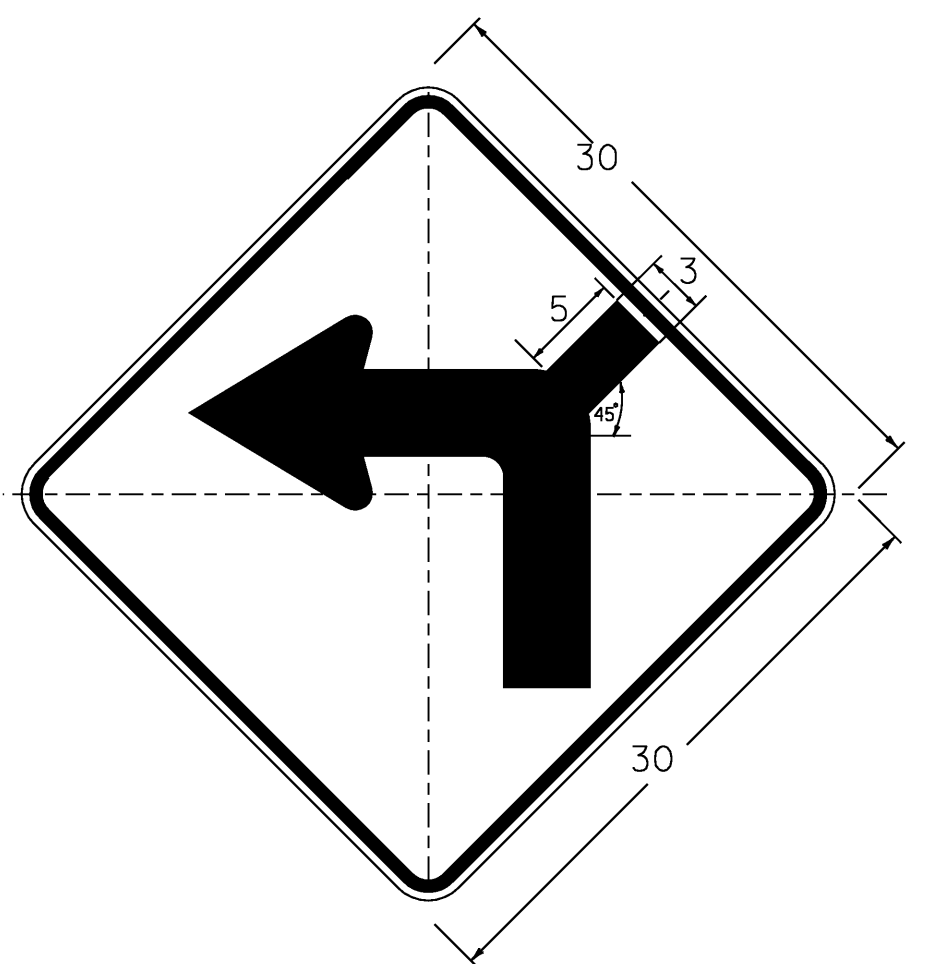


W1-1Md L(R)

DIMENSIONS NOT SHOWN
FOR THIS DETAIL SHALL CONFORM
TO THE LATEST EDITION OF THE 2003 MUTCD
FOR SIGN DETAIL W1-1.
UNLESS OTHERWISE NOTED FOR THIS DETAIL

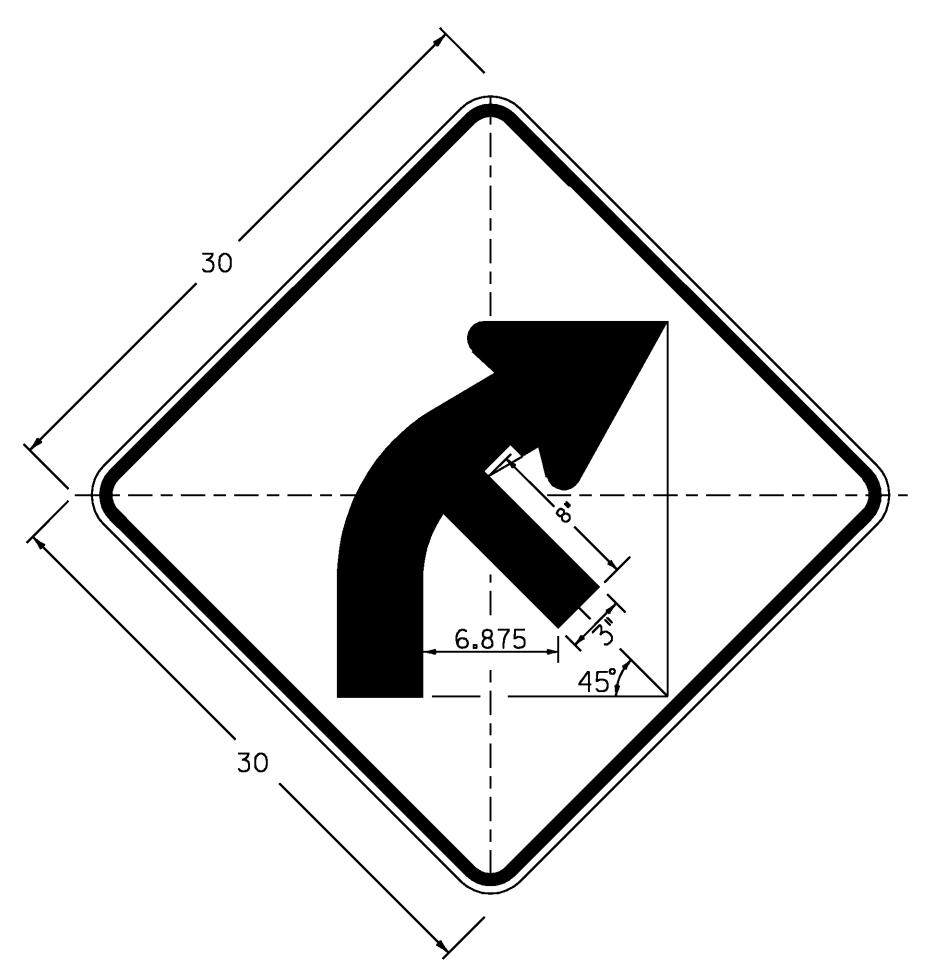


W1-2Mb R(L)

DIMENSIONS NOT SHOWN
FOR THIS DETAIL SHALL CONFORM
TO THE LATEST EDITION OF THE 2003 MUTCD
FOR SIGN DETAIL W1-2.
UNLESS OTHERWISE NOTED FOR THIS DETAIL

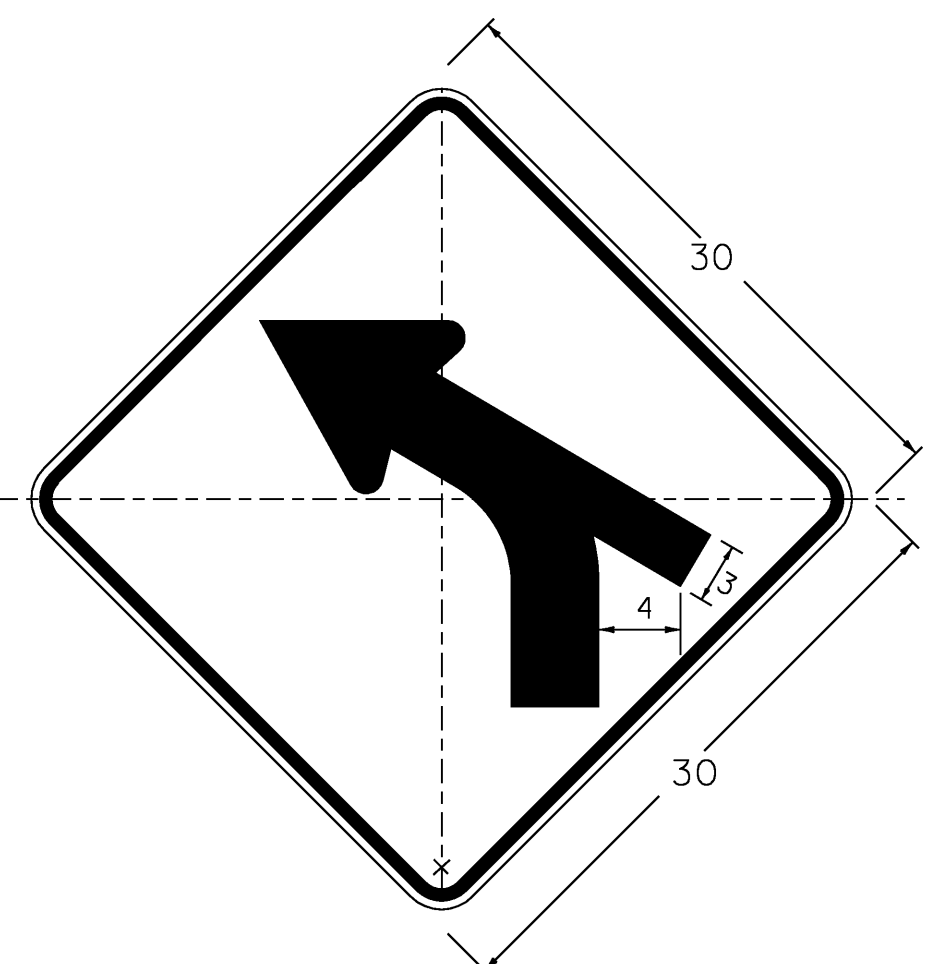

W1-2Mh L(R)


DIMENSIONS NOT SHOWN
FOR THIS DETAIL SHALL CONFORM
TO THE LATEST EDITION OF THE 2003 MUTCD
FOR SIGN DETAIL W1-2.
UNLESS OTHERWISE NOTED FOR THIS DETAIL

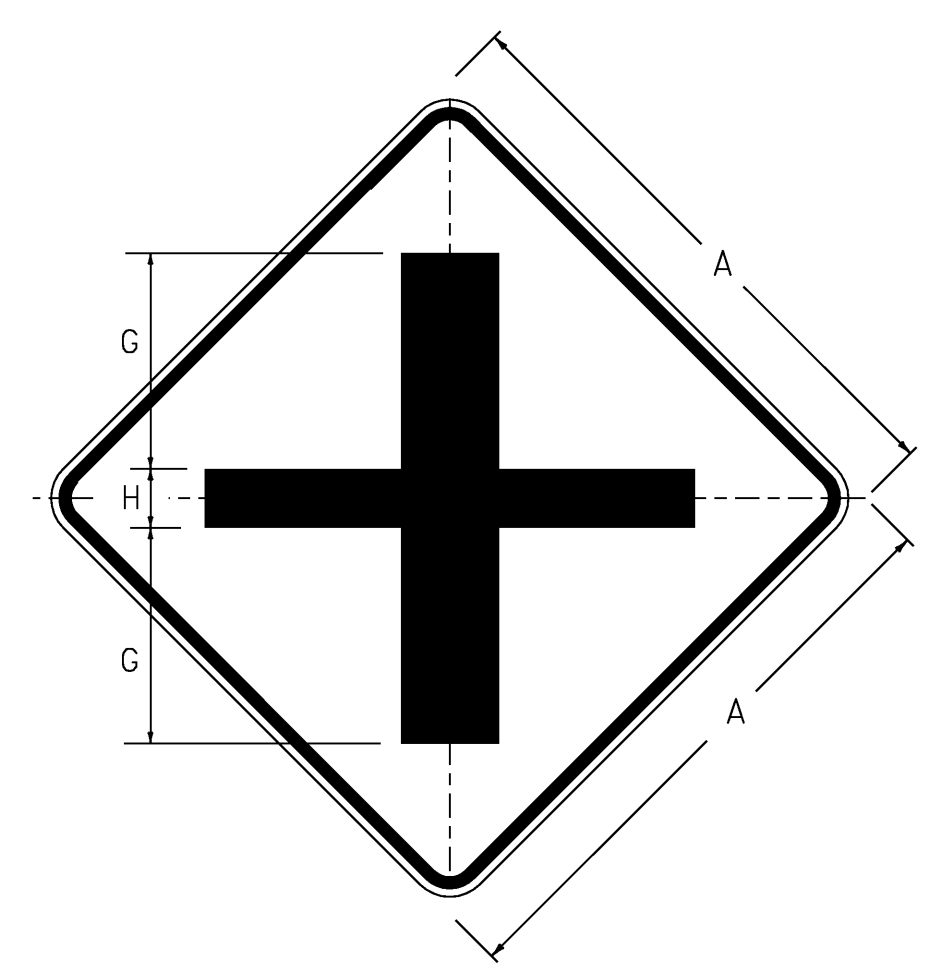

W2-1Mb


DIMENSIONS NOT SHOWN
FOR THIS DETAIL SHALL CONFORM
TO THE LATEST EDITION OF THE 2003 MUTCD
FOR SIGN DETAIL W2-1.
UNLESS OTHERWISE NOTED FOR THIS DETAIL

SIGN	DIMENSIONS (IN)		
	A	G	H
MIN & STD.	30	11	3
SPECIAL	36	13	4

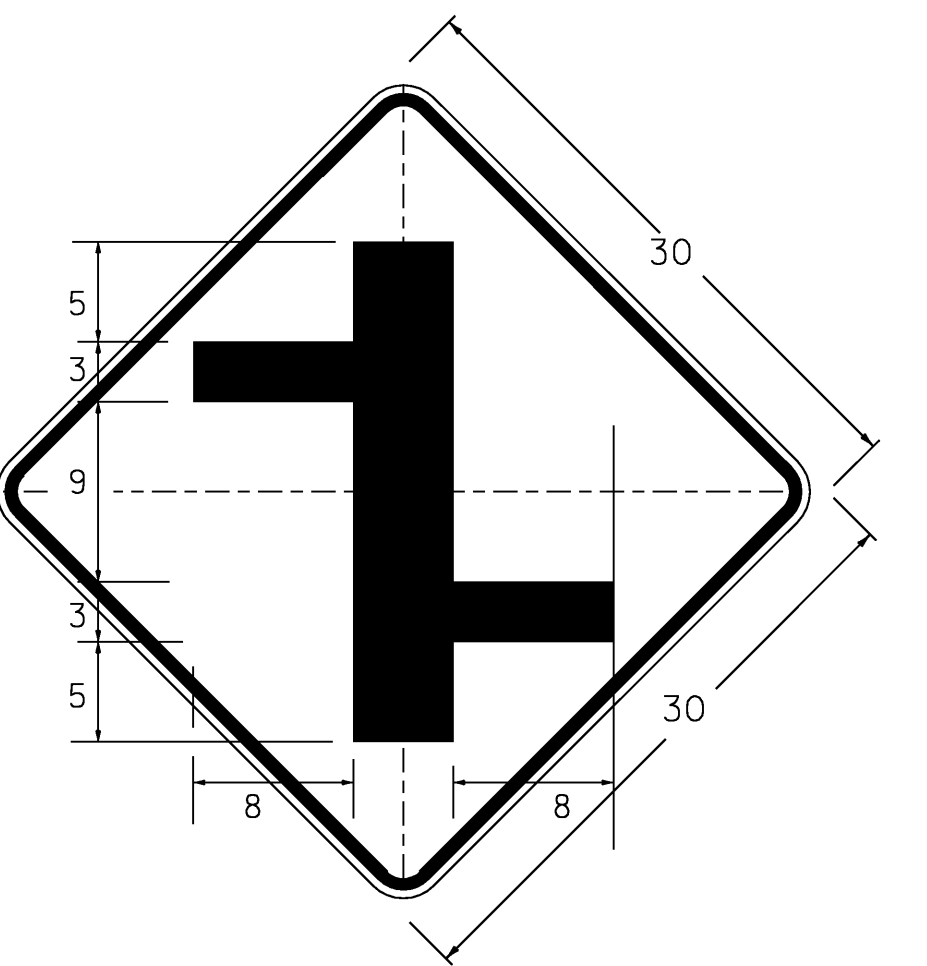


W2-1Md

DIMENSIONS NOT SHOWN
FOR THIS DETAIL SHALL CONFORM
TO THE LATEST EDITION OF THE 2003 MUTCD
FOR SIGN DETAIL W2-1.
UNLESS OTHERWISE NOTED FOR THIS DETAIL

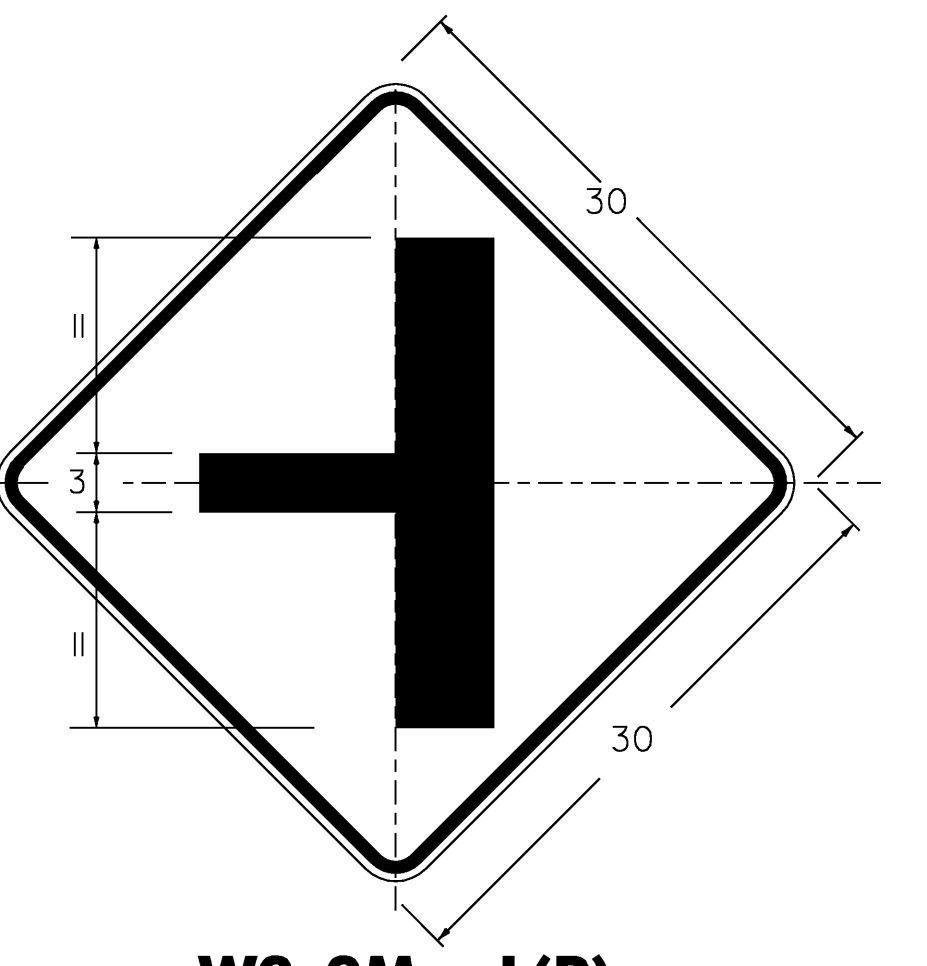


W2-2Ma L(R)

DIMENSIONS NOT SHOWN
FOR THIS DETAIL SHALL CONFORM
TO THE LATEST EDITION OF THE 2003 MUTCD
FOR SIGN DETAIL W2-2.
UNLESS OTHERWISE NOTED FOR THIS DETAIL

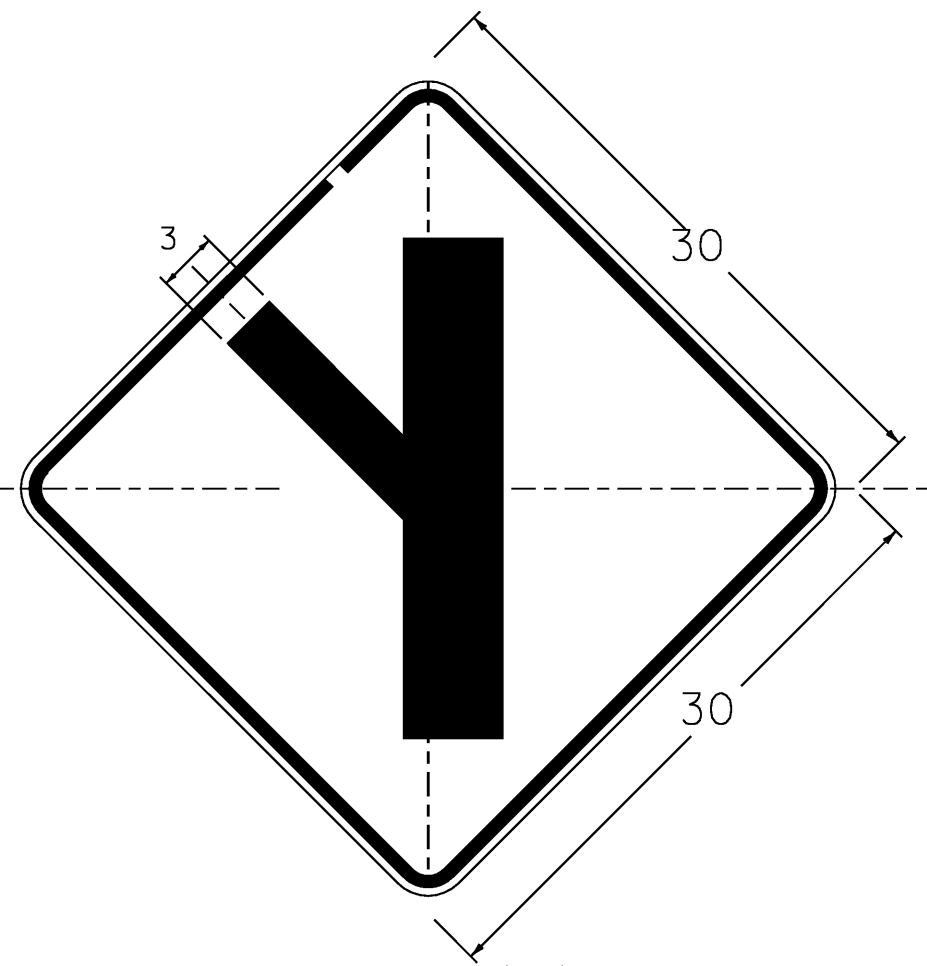

W2-3Ma L(R)

DIMENSIONS NOT SHOWN
FOR THIS DETAIL SHALL CONFORM
TO THE LATEST EDITION OF THE 2003 MUTCD
FOR SIGN DETAIL W2-3.
UNLESS OTHERWISE NOTED FOR THIS DETAIL

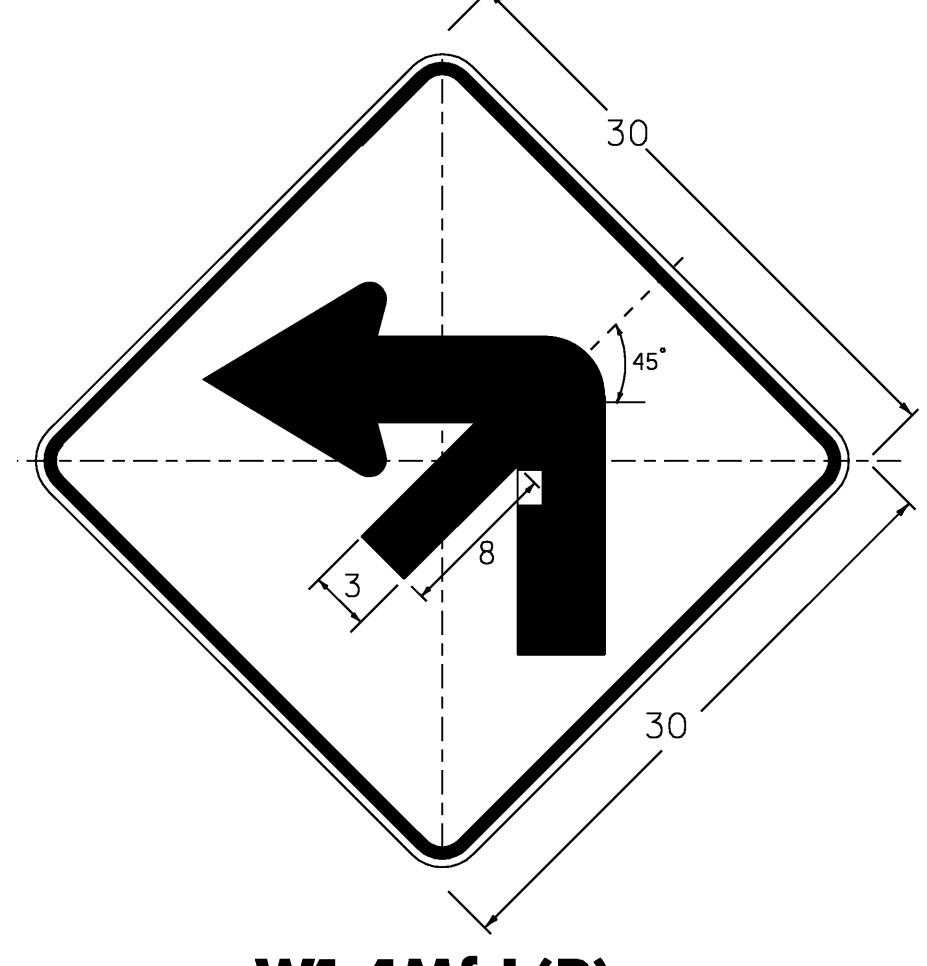

W1-1Mf L(R)

DIMENSIONS NOT SHOWN
FOR THIS DETAIL SHALL CONFORM
TO THE LATEST EDITION OF THE 2003 MUTCD
FOR SIGN DETAIL W1-1.
UNLESS OTHERWISE NOTED FOR THIS DETAIL




VR-644p

1.5" RADIUS, 0.625" BORDER, 0.375" INDENT
COLORS: LEGEND - RED
BACKGROUND - WHITE
TEXT STYLE: "BEGIN" C




VR-208

1.5" RADIUS, 0.625" BORDER, 0.375" INDENT
COLORS: LEGEND - BLACK
BACKGROUND - WHITE
TEXT STYLE: "UNLESS" C;
"OTHERWISE" C - SPECIFIED LENGTH;
"POSTED" C

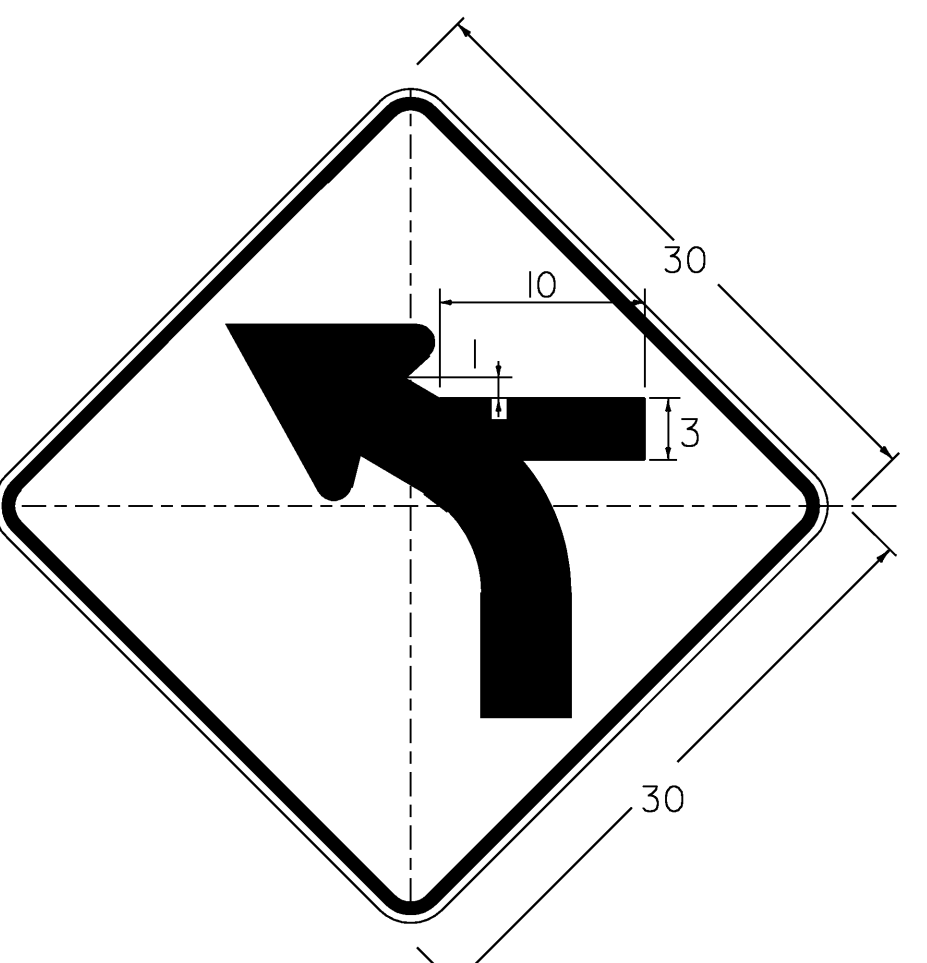


W1-2Md L

DIMENSIONS NOT SHOWN
FOR THIS DETAIL SHALL CONFORM
TO THE LATEST EDITION OF THE 2003 MUTCD
FOR SIGN DETAIL W1-2.
UNLESS OTHERWISE NOTED FOR THIS DETAIL

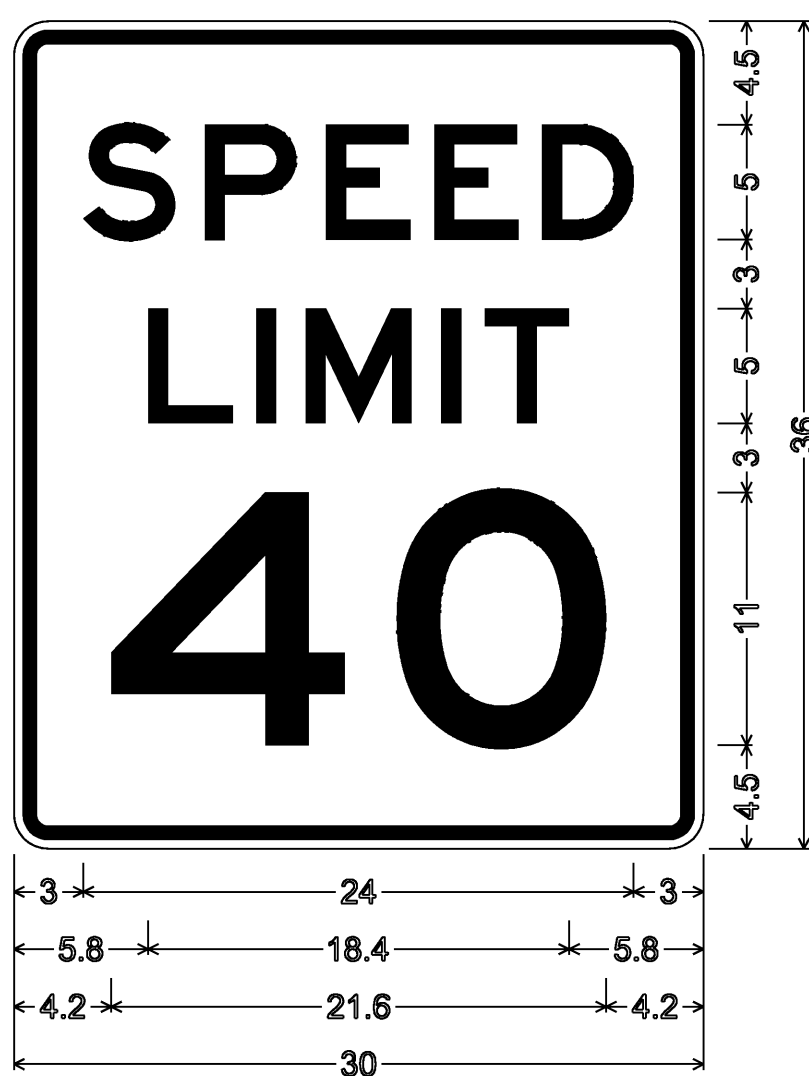


R2-1

1.5" RADIUS, 0.625" BORDER, 0.375" INDENT
COLORS: LEGEND - BLACK
BACKGROUND - WHITE
TEXT STYLE: "SPEED" E; "LIMIT" E; "40" E

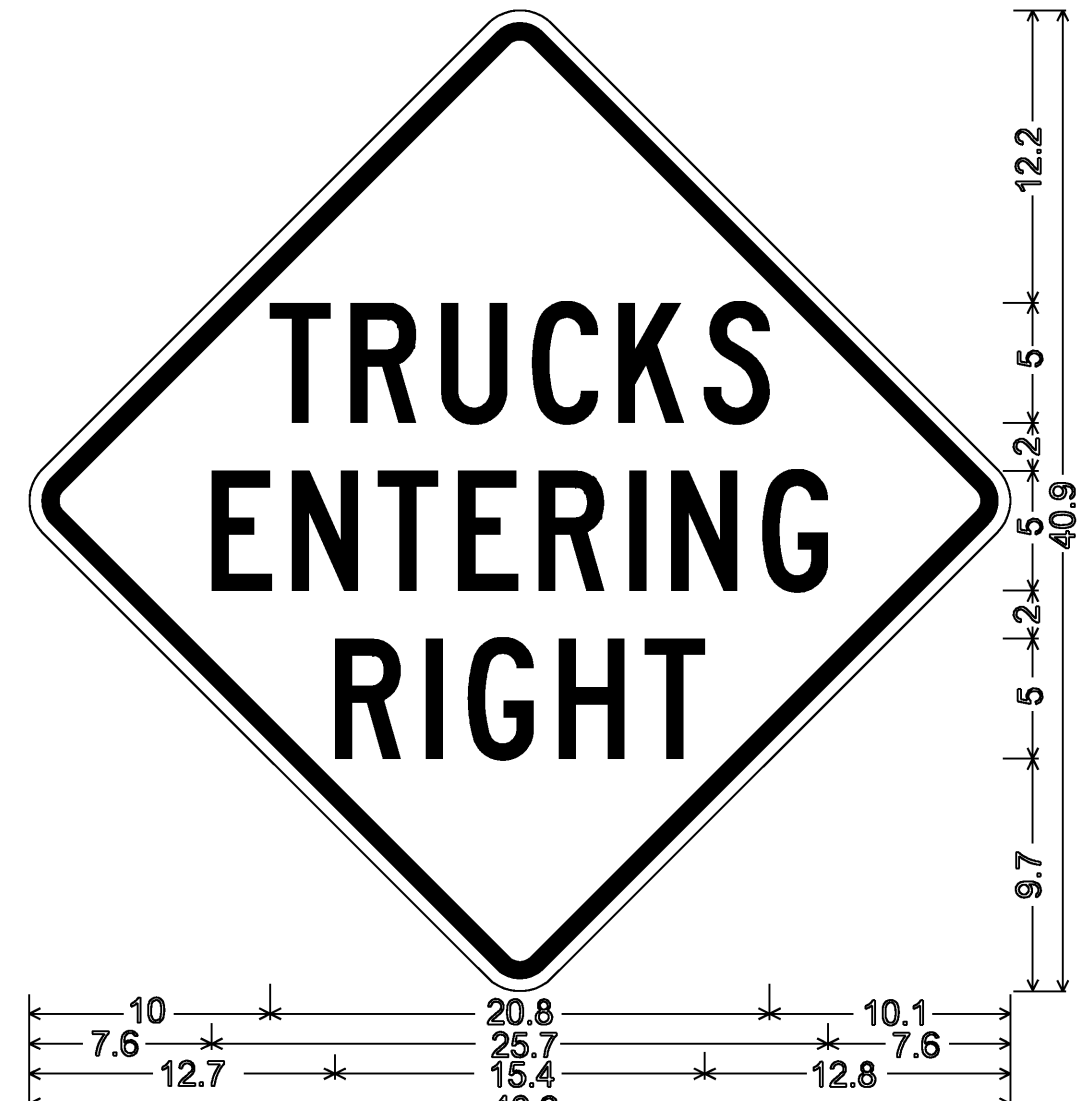

VW-081

30" SQUARE SIGN FACE
1.875" RADIUS, 0.75" BORDER, 0.50" INDENT
COLORS: LEGEND - BLACK
BACKGROUND - YELLOW
TEXT STYLE: C

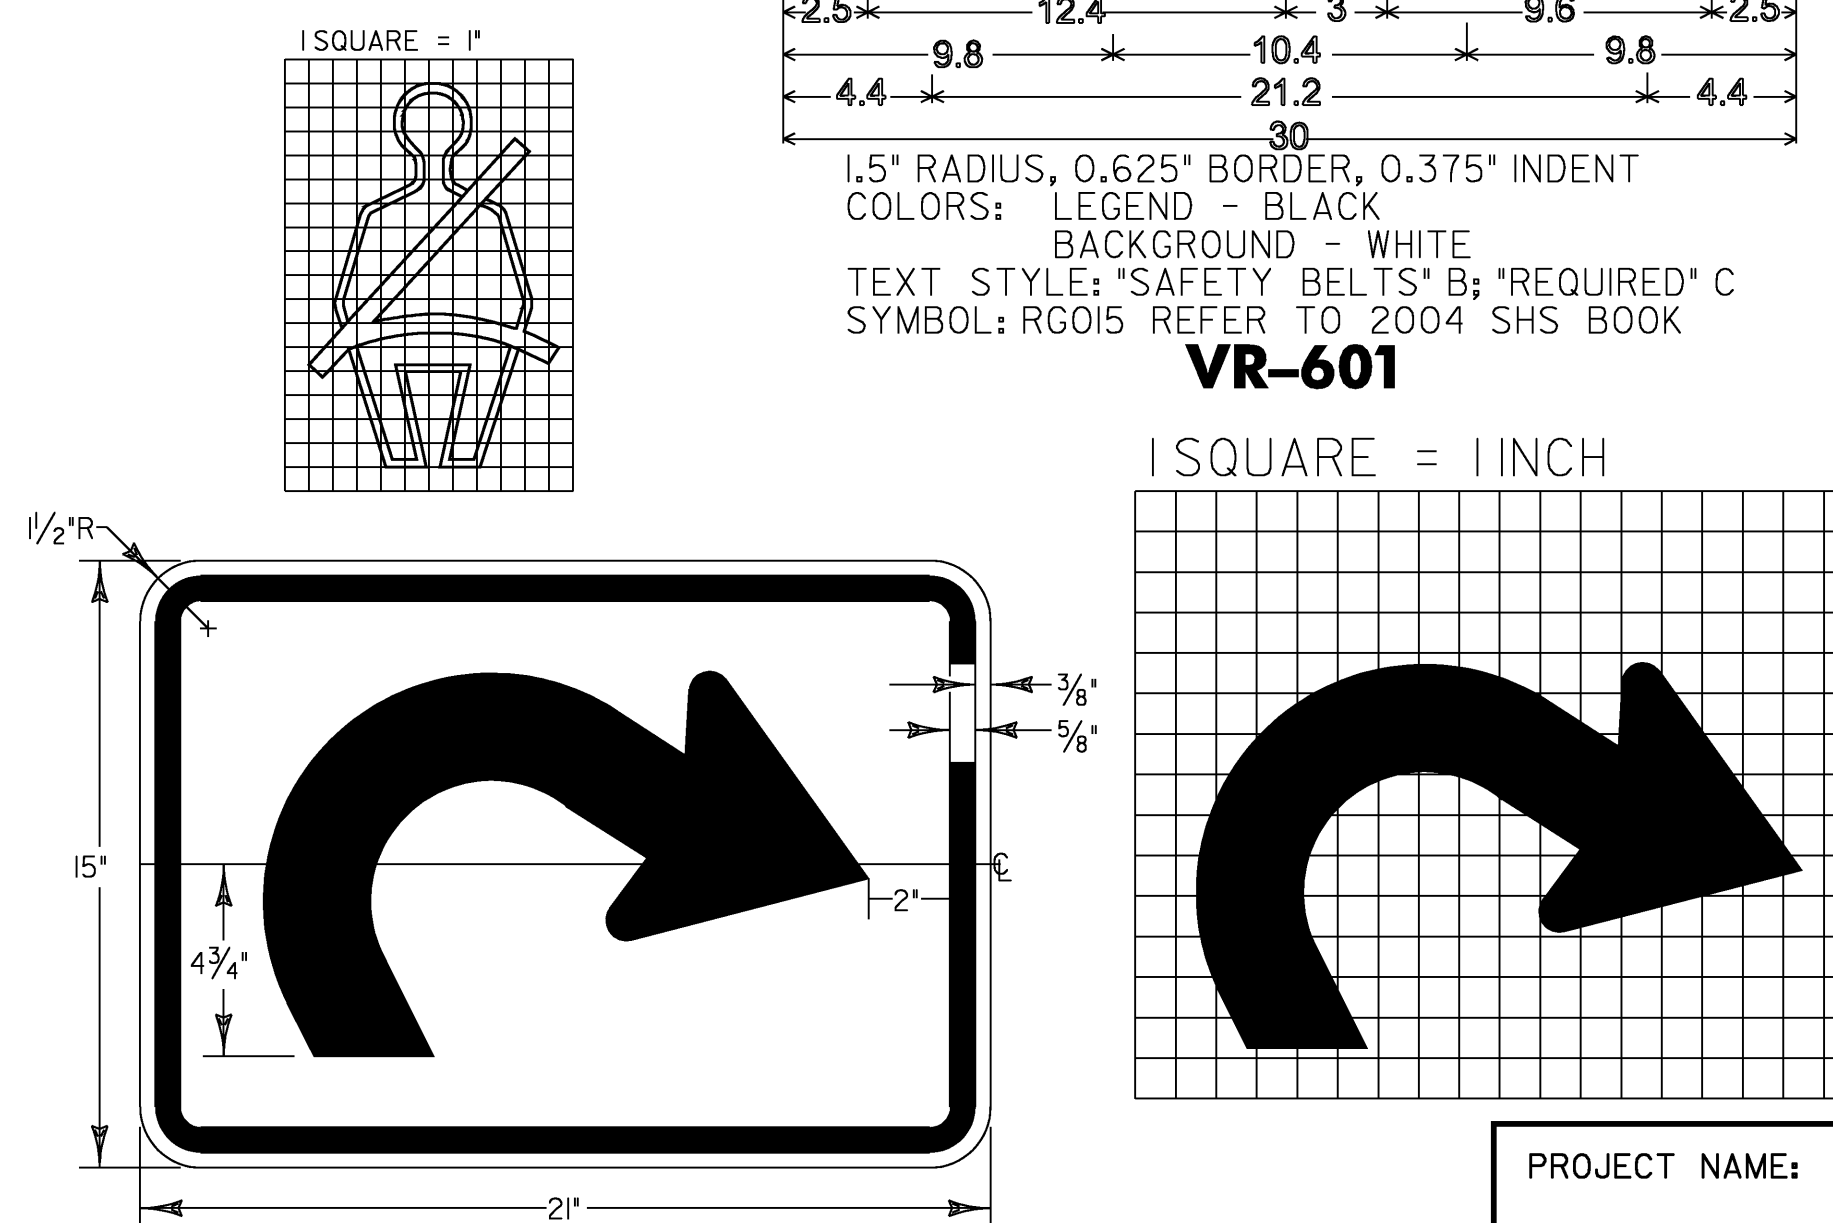

VM-013 R(L)

COLORS: LEGEND - VARIES
BACKGROUND - VARIES
REFER TO TRAFFIC SIGN SUMMARY SHEET
FOR SIGN COLORS REQUIRED.


PROJECT NAME: STAMFORD - ANDOVER

PROJECT NUMBER: STPG SIGN (20)

FILE NAME: 09B022_TS.DGN
PROJECT LEADER: N. AVERY
DESIGNED BY: N. AVERY
SIGN DESIGNS 2

PLOT DATE: 06-AUG-2009
DRAWN BY: N. AVERY
CHECKED BY: A. GAMBLE
SHEET 6 OF 198


ROUTE MARKER ASSEMBLY FRAMES

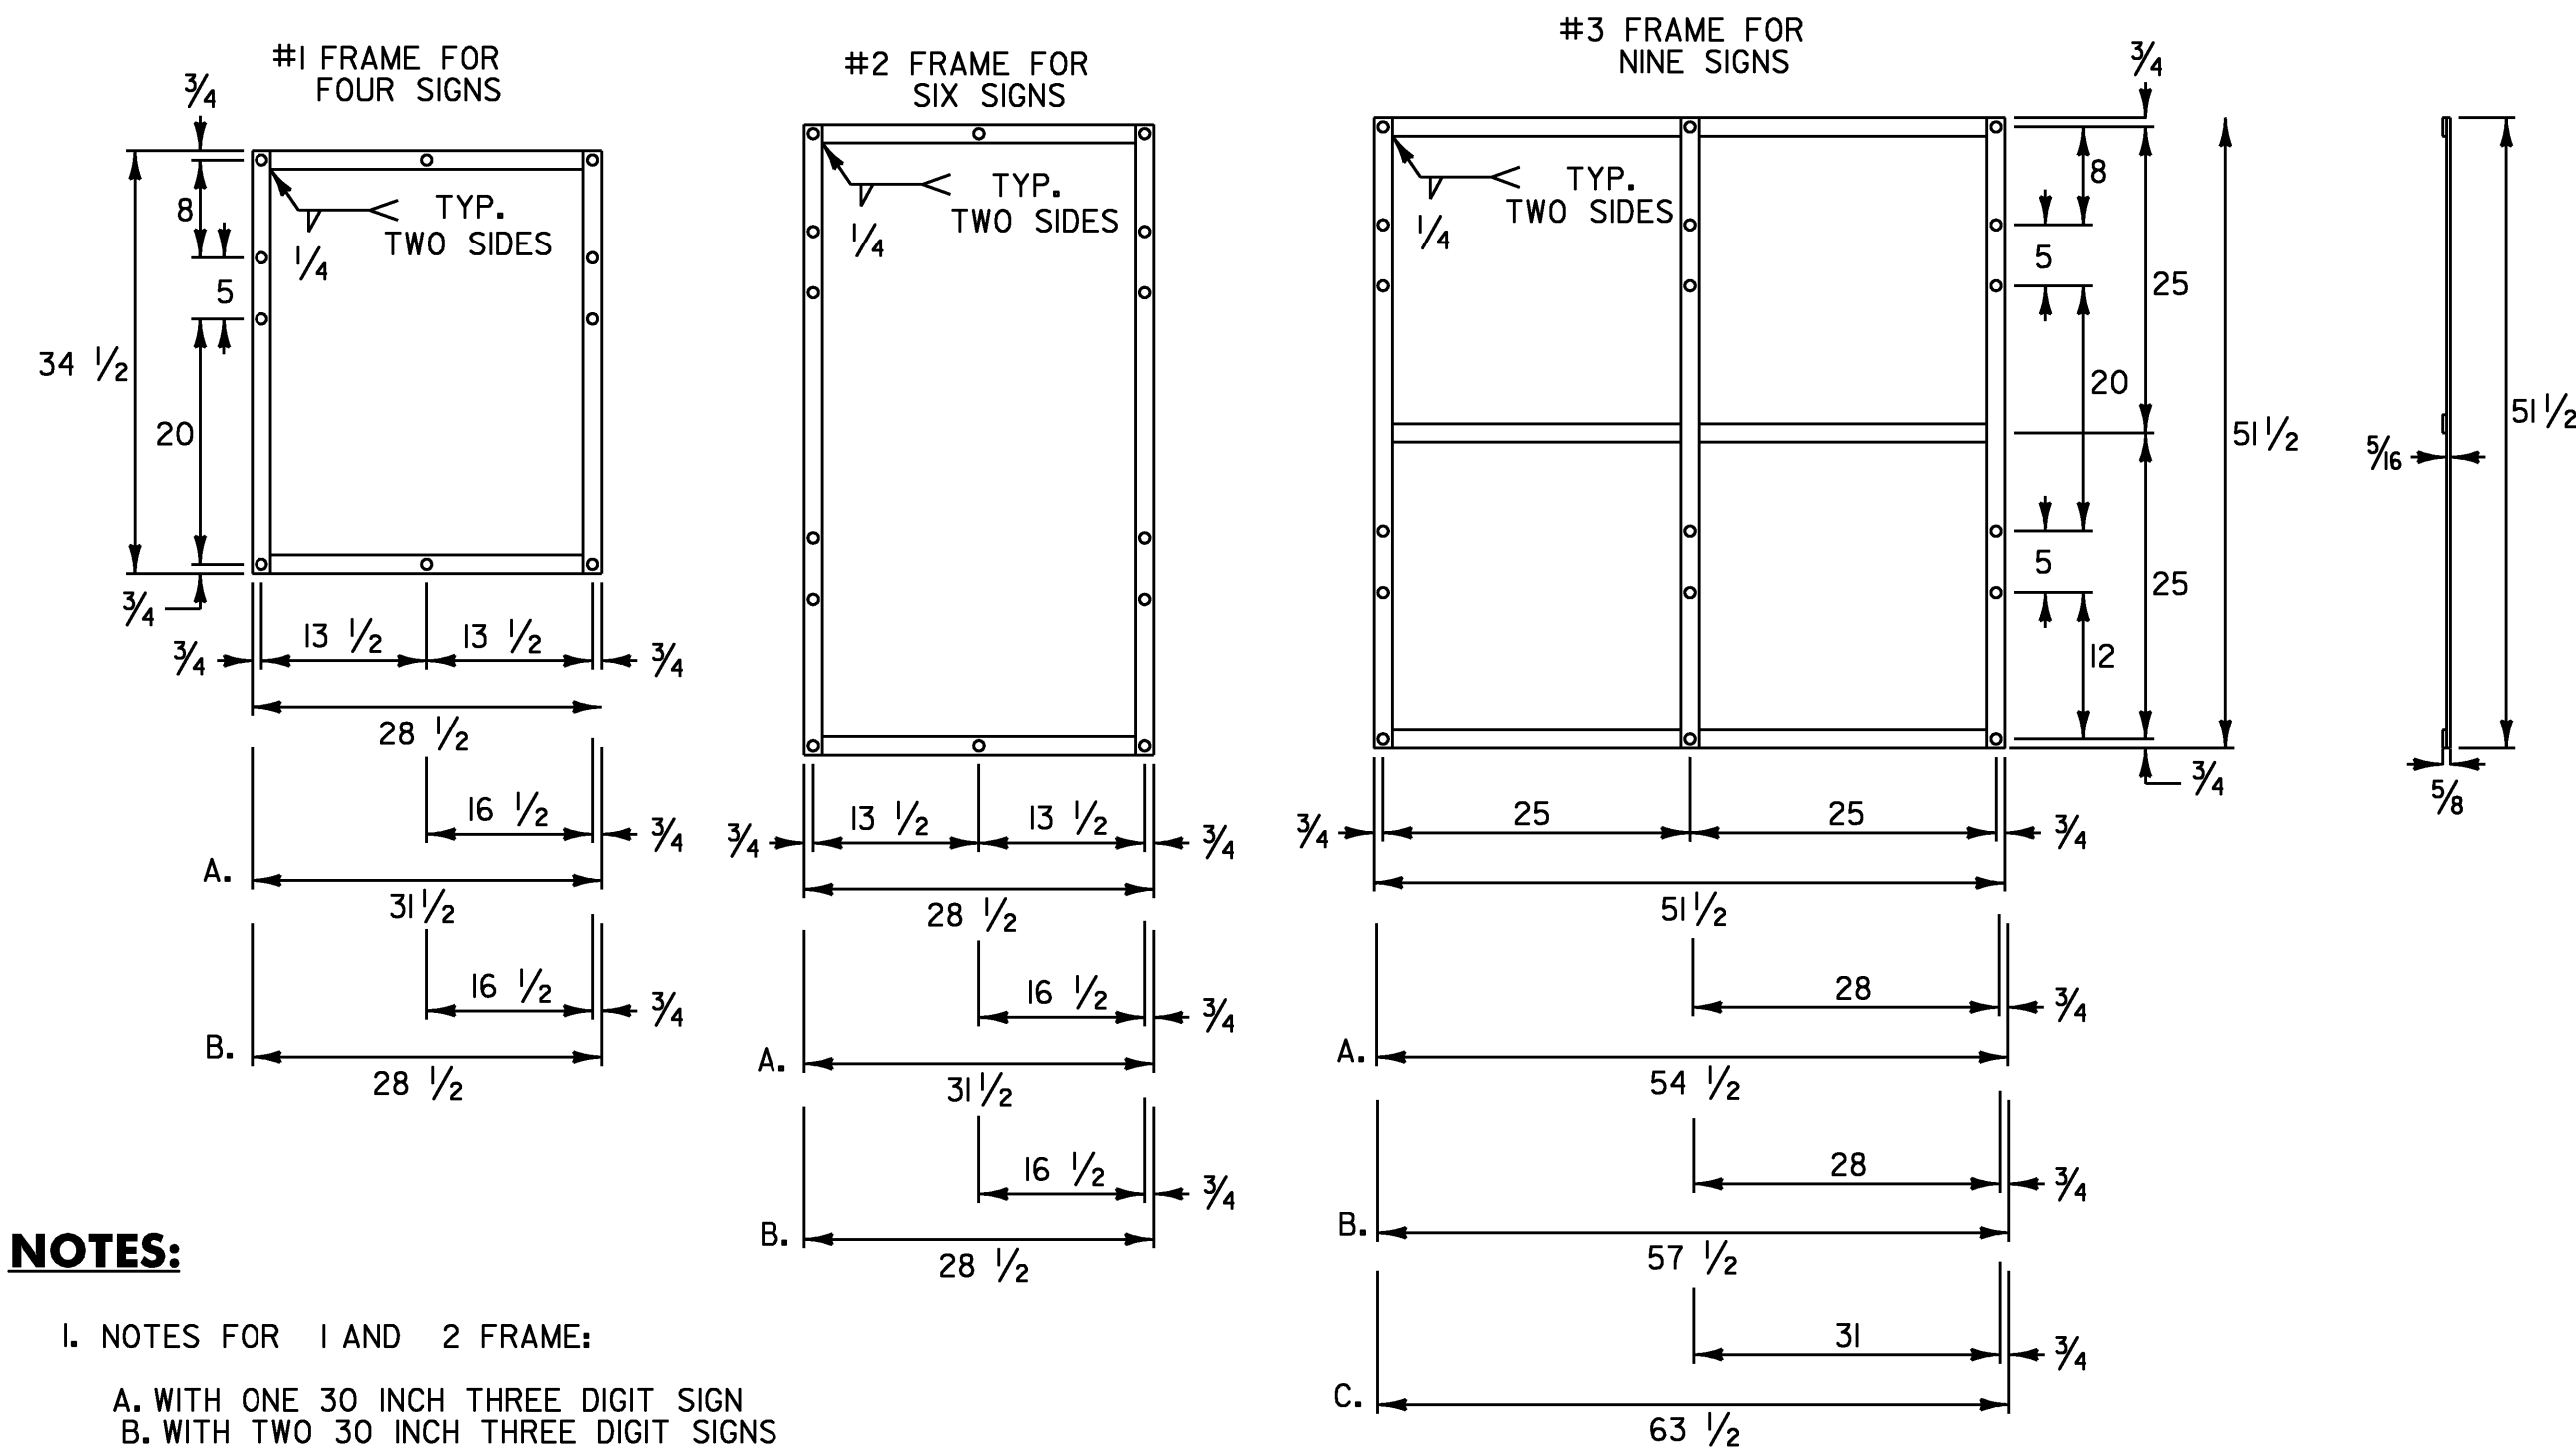

NOTES:

- NOTES FOR 1 AND 2 FRAME:
 - A. WITH ONE 30 INCH THREE DIGIT SIGN
 - B. WITH TWO 30 INCH THREE DIGIT SIGNS
- NOTES FOR 3 FRAME:
 - A. WITH ONE 30 INCH THREE DIGIT SIGN IN AN OUTSIDE POSITION.
 - B. WITH ONE 30 INCH THREE DIGIT SIGN IN THE CENTER POSITION OR TWO SUCH SIGNS IN THE OUTSIDE POSITIONS.
 - C. WITH THREE 30 INCH THREE DIGIT SIGNS.
- ALL HOLES SHALL BE 5/16 INCH DIAMETER. FOR OTHER SIGN COMBINATIONS, THAN ABOVE, THE FRAME DIMENSIONS AND HOLE SPACING SHALL BE MODIFIED AS NECESSARY. THE FRAME SHALL BE PAINTED WITH ONE COAT OF PRIMER AND A SECOND COAT OF BLACK PAINT. THE PAINT SHALL BE OF THE TYPE USED ON EXTERIOR METAL SURFACES TO PREVENT METAL CORROSION.
- STANDARD FRAMES SHALL BE 5/16 INCH x 1 1/2 INCH WELDED A-36 STEEL.
- ALL DIMENSIONS SHOWN IN INCHES UNLESS OTHERWISE NOTED.

STANDARD MOUNTING OF ROUTE MARKER ASSEMBLIES

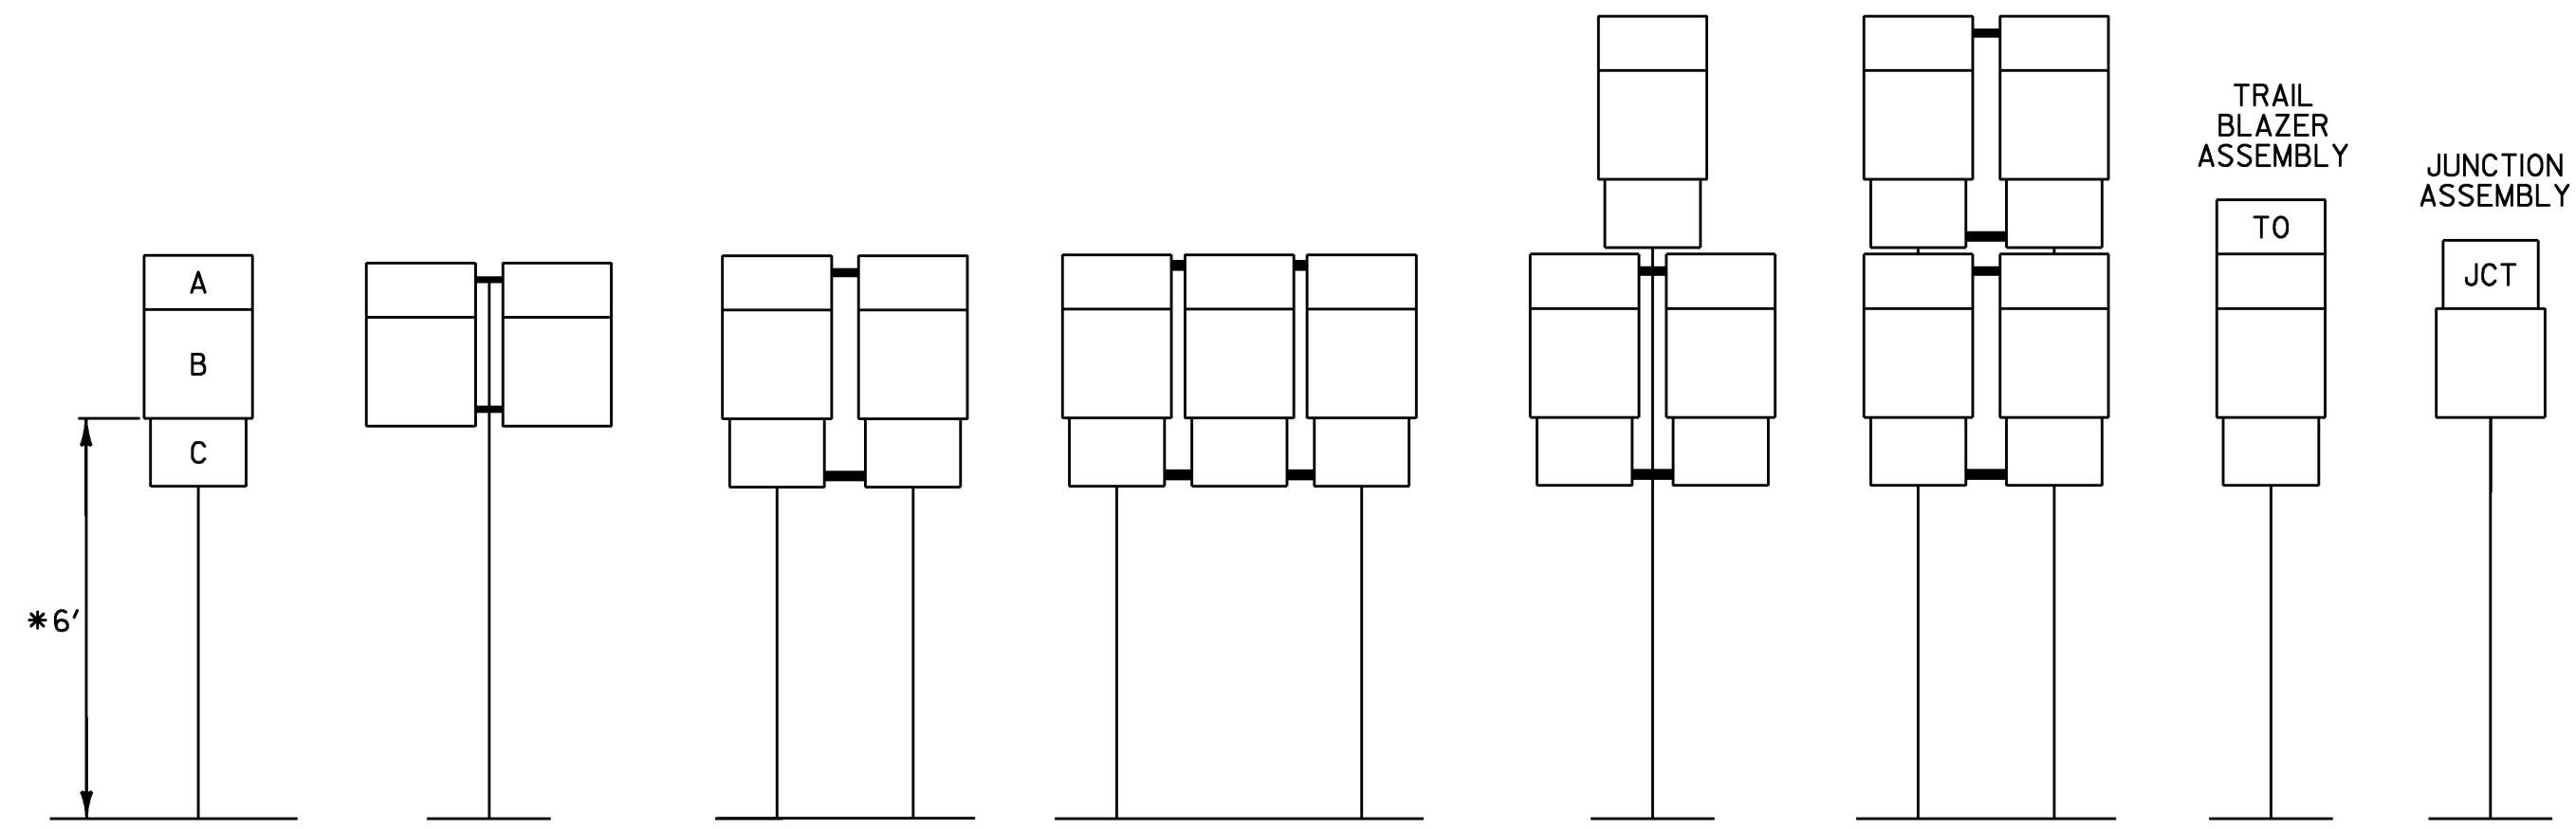

- A - CARDINAL DIRECTION MARKER
- B - ROUTE NUMBER
- C - ADVANCE TURN ARROW OR DIRECTIONAL ARROW


* WHERE PARKING OR PEDESTRIAN TRAFFIC WILL OCCUR IN THE IMMEDIATE VICINITY OF THESE SIGNS MINIMUM VERTICAL CLEARANCE SHALL BE INCREASED TO SEVEN FEET

INSTALLATION SEQUENCE:


IN MULTIPLE HORIZONTAL MOUNTINGS PLACE A ROUTE MARKER ASSEMBLY INDICATING A LEFT TURN ON THE LEFT SIDE OF THE ASSEMBLY; RIGHT TURN ON THE RIGHT SIDE. FOR VERTICALLY STACKED MOUNTINGS PLACE THE STRAIGHT THROUGH MOVE INDICATION ON TOP, THE LEFT OR RIGHT TURNS AS APPROPRIATE BENEATH.

NOTES:


- ALL DIMENSIONS SHOWN IN INCHES UNLESS OTHERWISE NOTED.
- VERTICAL FRAME MEMBERS SHALL LINE UP WITH SIGN POST ON WHICH THEY ARE MOUNTED.

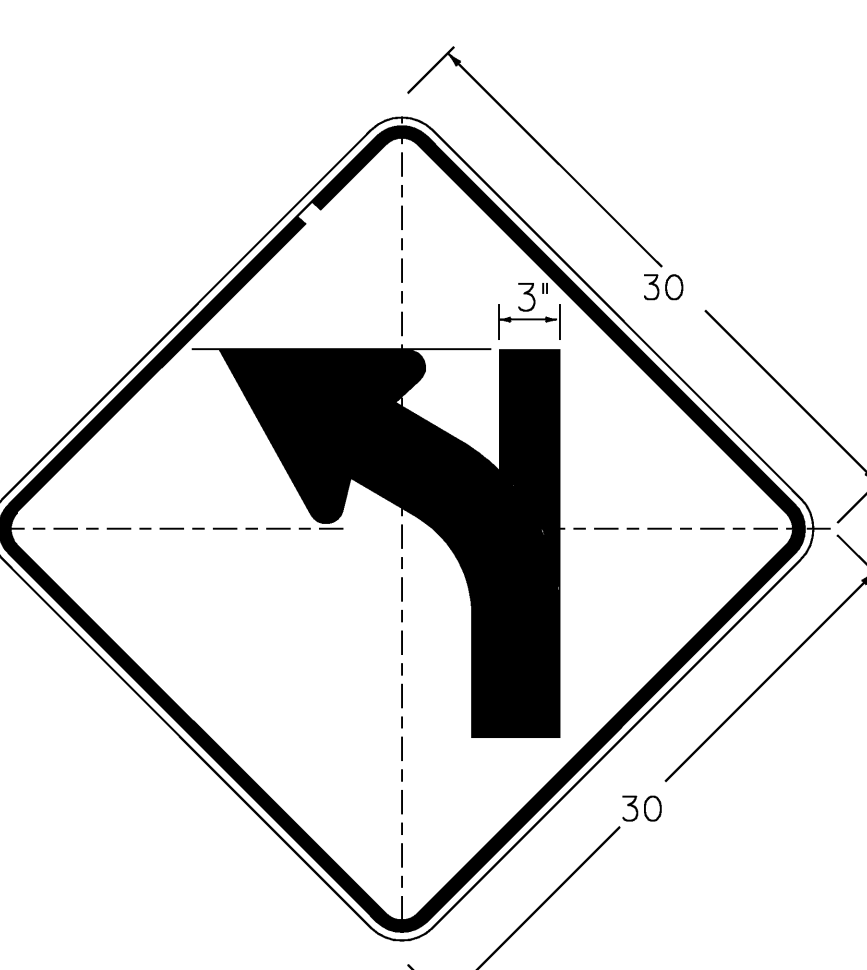


W1-2Mg L
DIMENSIONS NOT SHOWN FOR THIS DETAIL SHALL CONFORM TO THE LATEST EDITION OF THE 2003 MUTCD FOR SIGN DETAIL W1-2. UNLESS OTHERWISE NOTED FOR THIS DETAIL

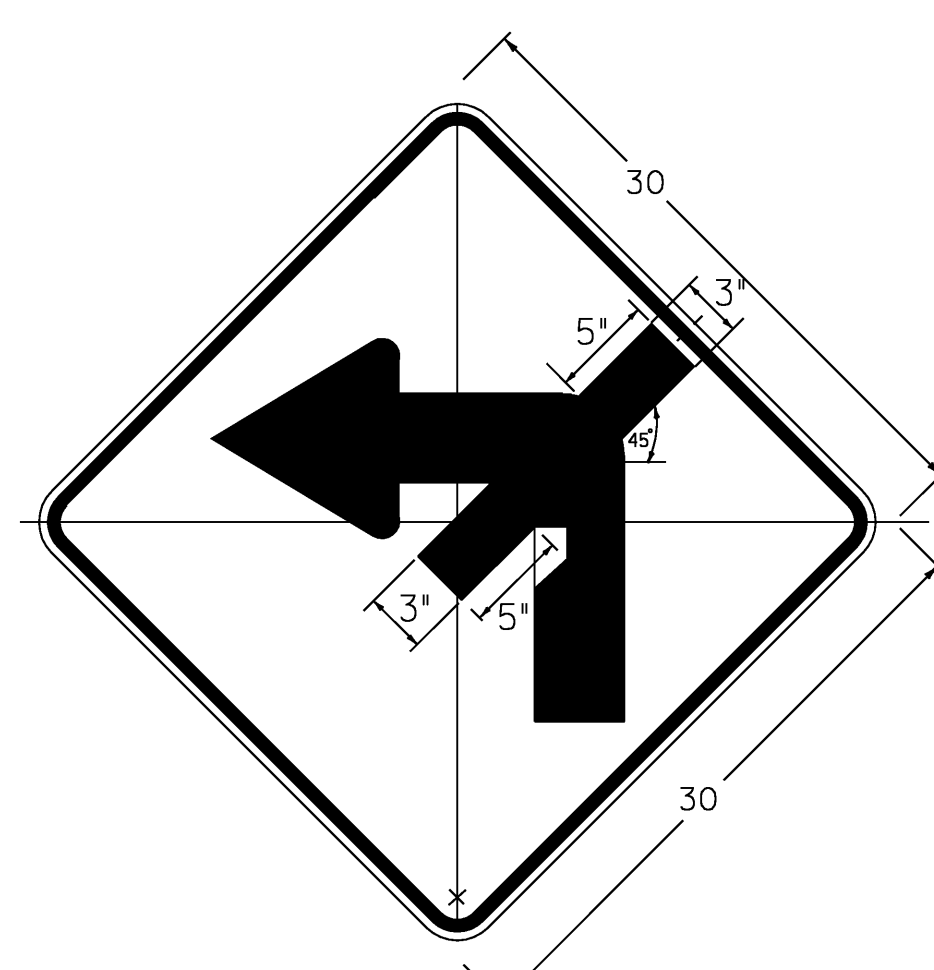


W1-1Me L(R)
DIMENSIONS NOT SHOWN FOR THIS DETAIL SHALL CONFORM TO THE LATEST EDITION OF THE 2003 MUTCD FOR SIGN DETAIL W1-1. UNLESS OTHERWISE NOTED FOR THIS DETAIL

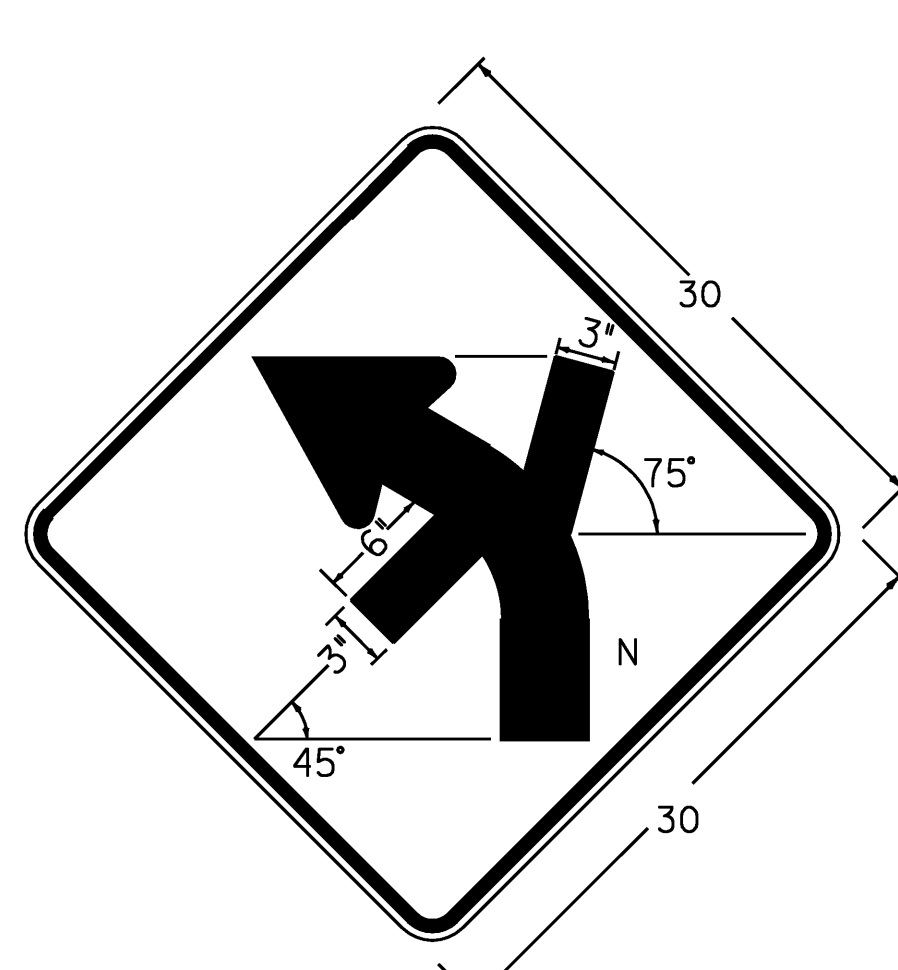


W1-2Mm L(R)
DIMENSIONS NOT SHOWN FOR THIS DETAIL SHALL CONFORM TO THE LATEST EDITION OF THE 2003 MUTCD FOR SIGN DETAIL W1-2. UNLESS OTHERWISE NOTED FOR THIS DETAIL

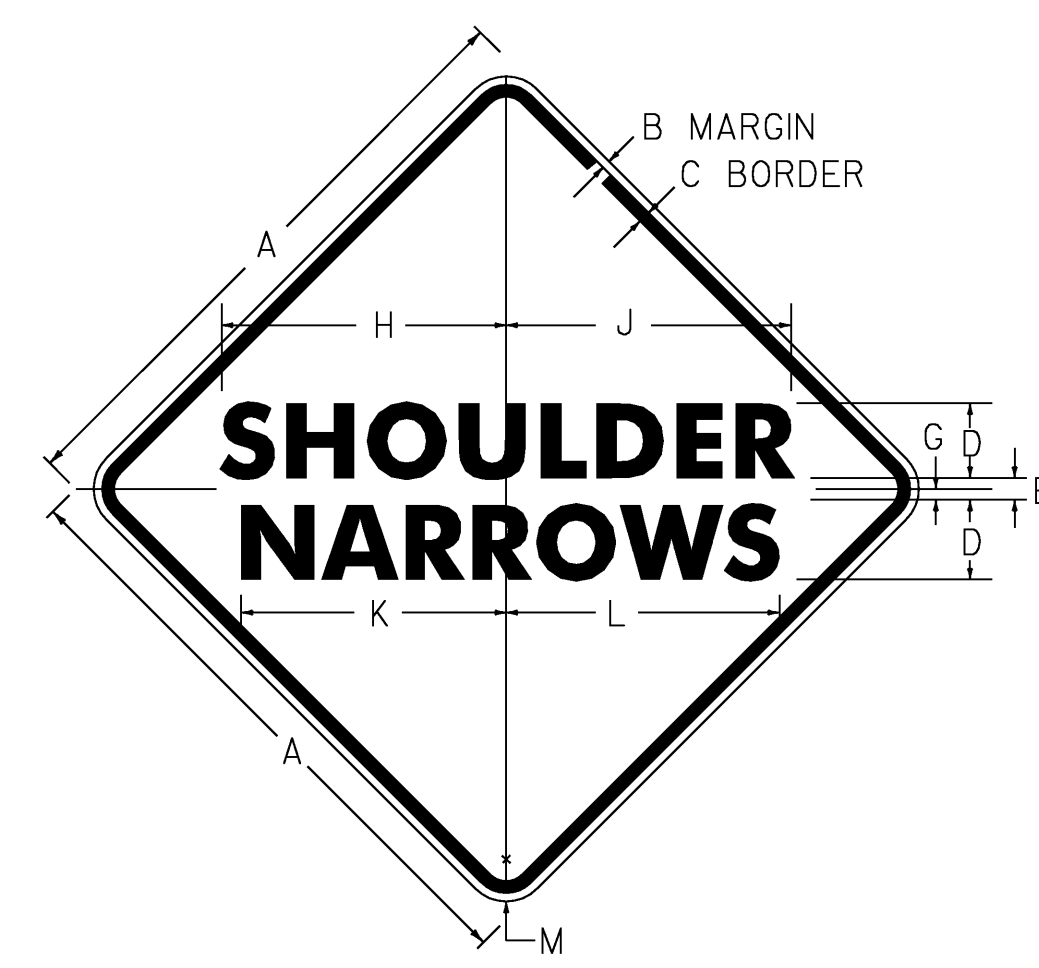

VW-619
COLORS: LEGEND - BLACK BACKGROUND - YELLOW

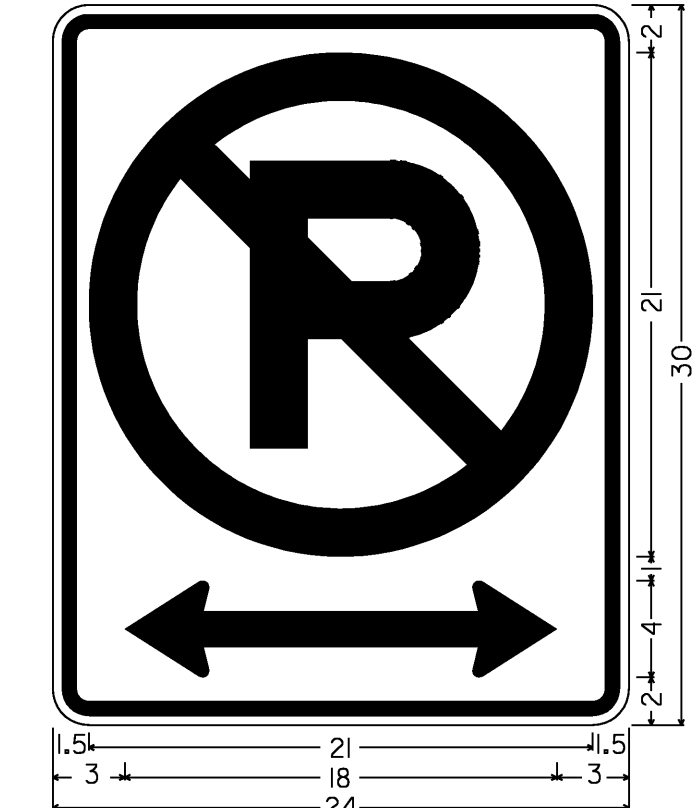

VR-052
1.5" RADIUS, 0.625" BORDER, 0.375" INDENT
COLORS: TEXT & BORDER - BLACK CIRCLE & DIAGONAL - RED BACKGROUND - WHITE REFER TO R8-3A

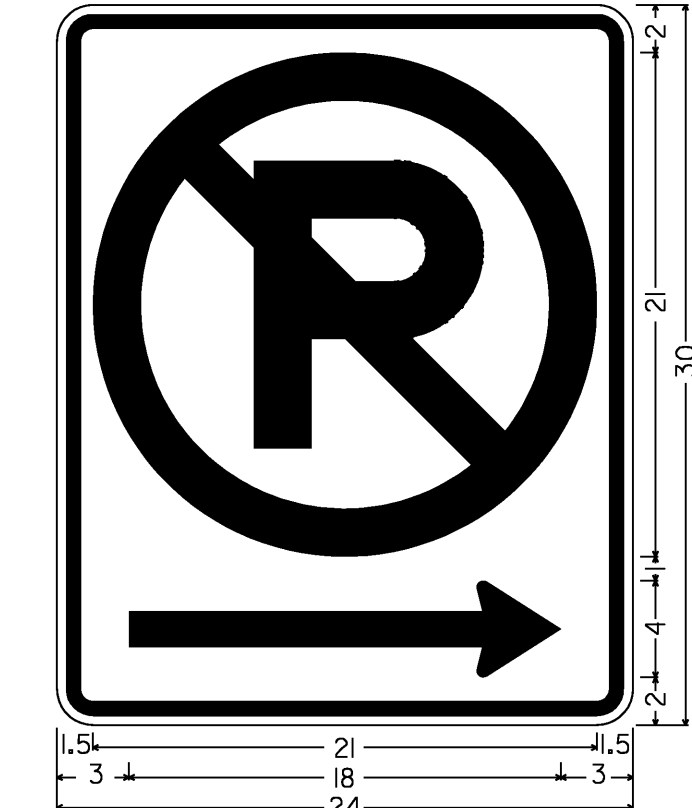

VR-052R (L)
1.5" RADIUS, 0.625" BORDER, 0.375" INDENT
COLORS: TEXT & BORDER - BLACK CIRCLE & DIAGONAL - RED BACKGROUND - WHITE REFER TO R8-3A

SIGN	DIMENSIONS (INCHES)												
	A	B	C	D	E	F	G	H	J	K	L	M	
MIN	30	1/2	3/4	4C	3	4C	I	11 5/2	11 5/2	10 5/2	10 5/2	1 7/8	
STD.	36	5/8	7/8	5C	3	6D	I	13 1/16	13 1/16	17 5/8	18 1/4	2 1/4	
EXPWY.	48	3/4	1 1/4	7D	3 1/2	7D	I	23 3/16	23 3/16	21 1/2	21 1/16	3	


PROJECT NAME: STAMFORD - ANDOVER
PROJECT NUMBER: STPG SIGN (20)
FILE NAME: 09b022_TS.DGN
PROJECT LEADER: N. AVERY
DESIGNED BY: N. AVERY
GUIDE SIGN ASSEMBLY
PLOT DATE: 06-AUG-2009
DRAWN BY: N. AVERY
CHECKED BY: A. GAMBLE
SHEET 7 OF 198



1.5" RADIUS, 0.375" BORDER, 0.375" INDENT
 COLORS: LEGEND - BLACK
 BACKGROUND - YELLOW
 TEXT STYLE: B

* LATERAL SPACING TO OUTSIDE OF PANEL
 SHALL BE A MINIMUM OF 1.5"


W16-8

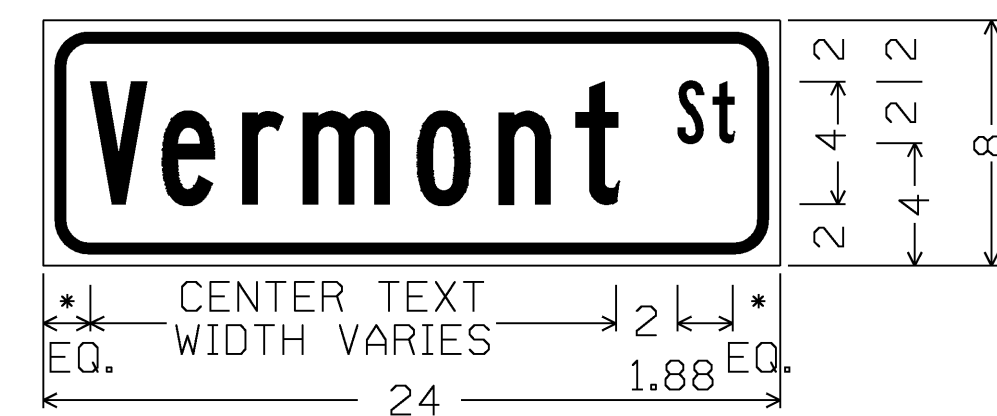

1.5" RADIUS, 0.375" BORDER, 0.375" INDENT
 COLORS: LEGEND - BLACK
 BACKGROUND - YELLOW
 TEXT STYLE: B

* LATERAL SPACING TO OUTSIDE OF PANEL
 SHALL BE A MINIMUM OF 1.5"


W16-8

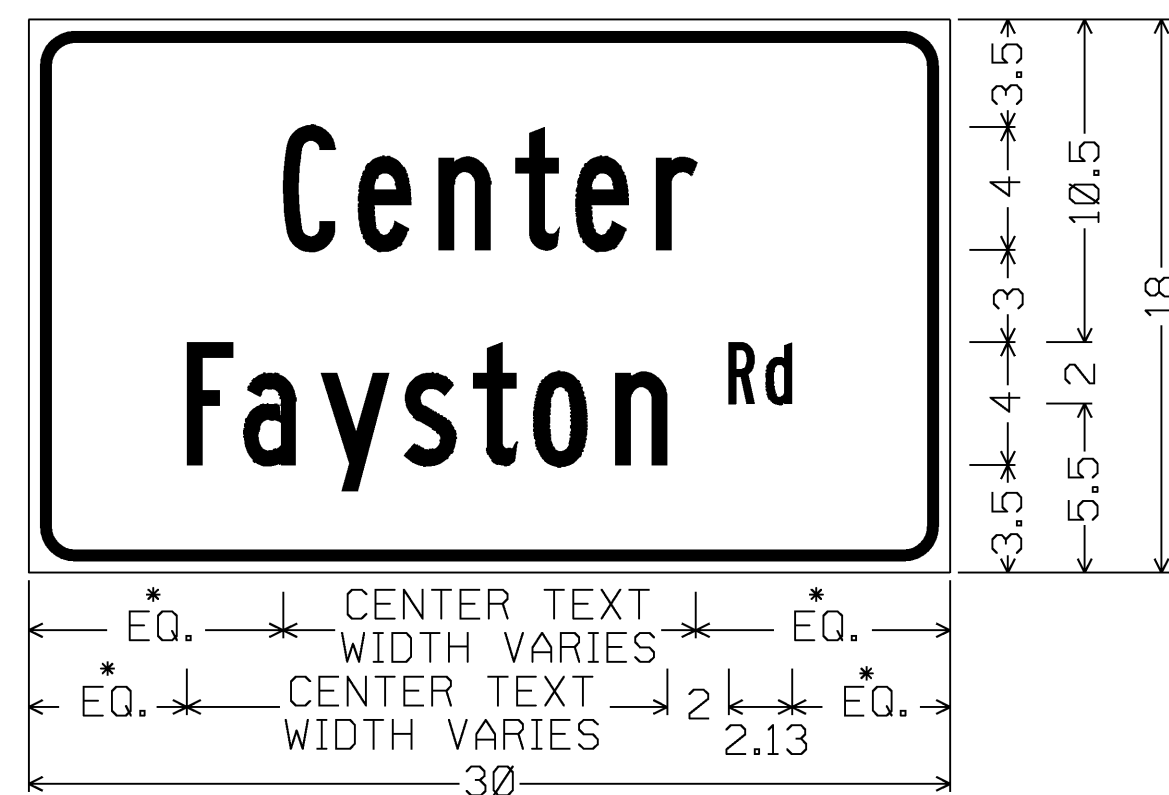

1.5" RADIUS, 0.375" BORDER, 0.375" INDENT
 COLORS: LEGEND - BLACK
 BACKGROUND - YELLOW
 TEXT STYLE: B

* LATERAL SPACING TO OUTSIDE OF PANEL
 SHALL BE A MINIMUM OF 1.5"

W16-8

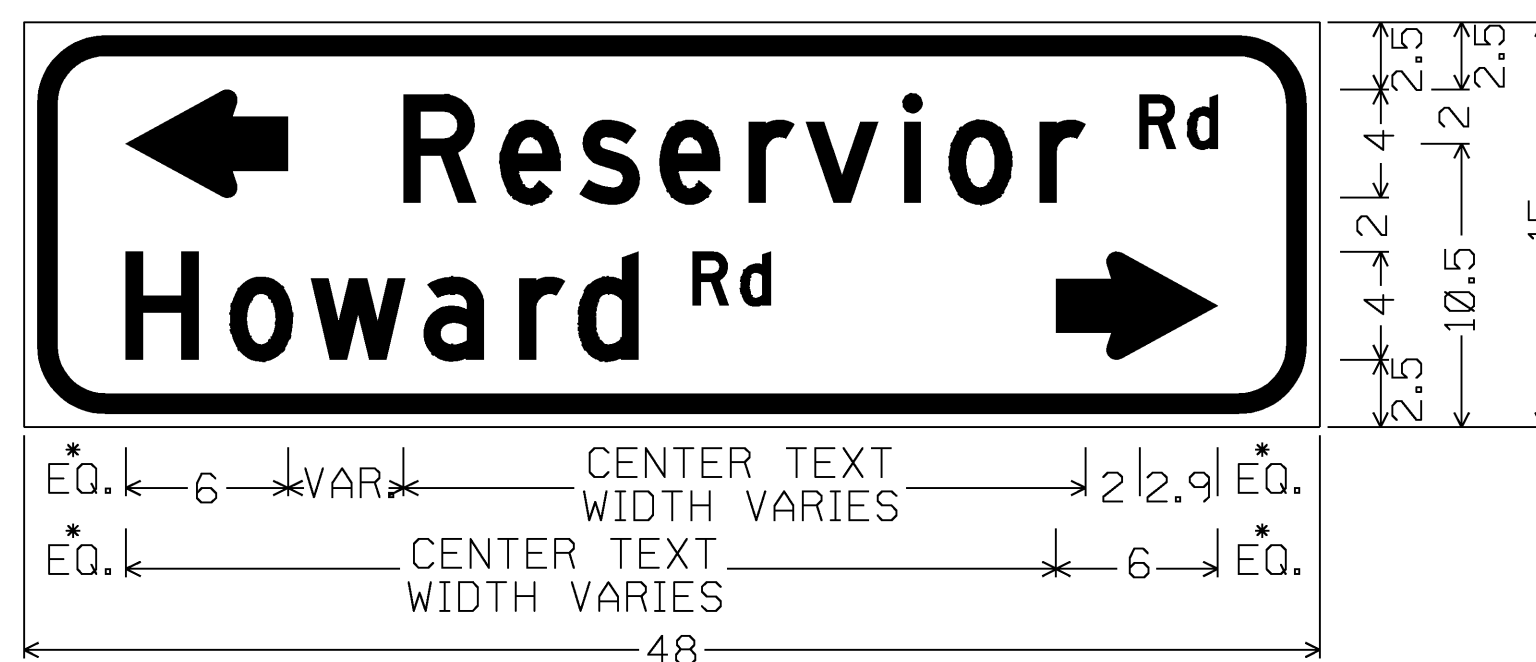


3" RADIUS, 0.75" BORDER, 0.50" INDENT
 COLORS: LEGEND - BLACK
 BACKGROUND - YELLOW
 TEXT STYLE: D; STANDARD ARROW CUSTOM 6" WIDE X 4" HIGH

* LATERAL SPACING TO OUTSIDE OF PANEL
 SHALL BE A MINIMUM OF 3"

W16-8a

ADVANCE WARNING SIGN PLAQUE NOTES:

- I. ALL ADVANCE STREET NAME PLAQUE SIGNS (W16-8 AND W16-8a) USED TO IDENTIFY THE NAME OF THE INTERSECTING STREETS SHALL HAVE INITIAL UPPER CASE LETTERS AND USED IN CONJUNCTION WITH LOWERCASE LETTERS (I.E. Main St, Foster Rd, East Ave, West Ln).

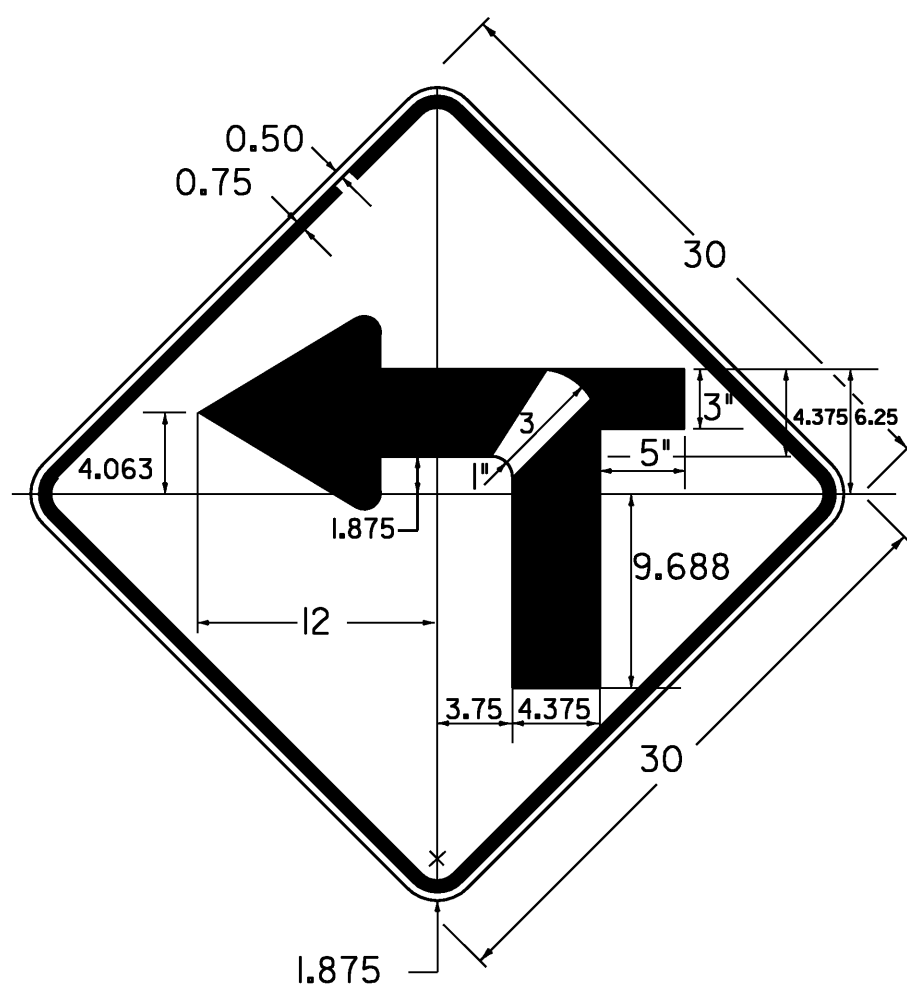

WI-1Ma L(R)

COLORS:
 TEXT & BORDER = BLACK
 BACKGROUND = YELLOW

PROJECT NAME: STAMFORD - ANDOVER

PROJECT NUMBER: STPG SIGN (20)

FILE NAME: 09b022_TS.DGN

PROJECT LEADER: N. AVERY

DESIGNED BY: N. AVERY



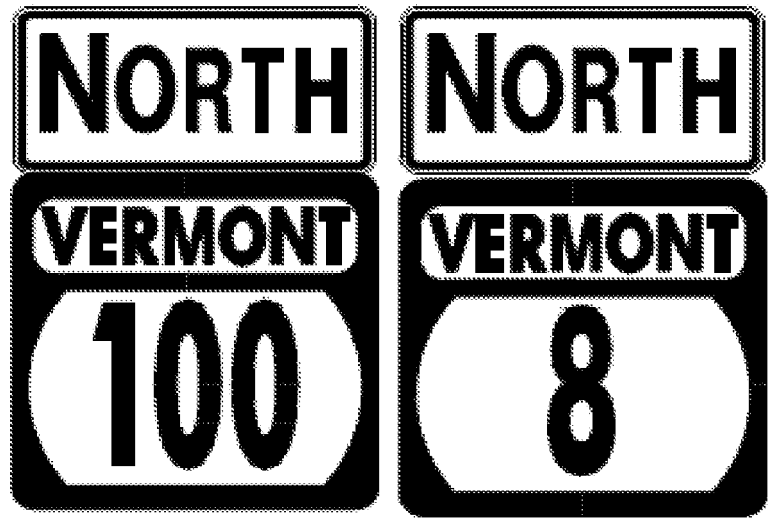

WARNING STREET NAME PLAQUES DETAIL





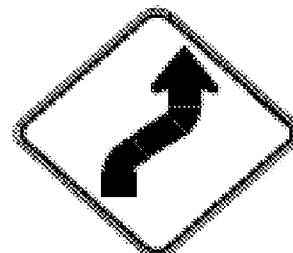

PLOT DATE: 18-AUG-2009






DRAWN BY: N. AVERY

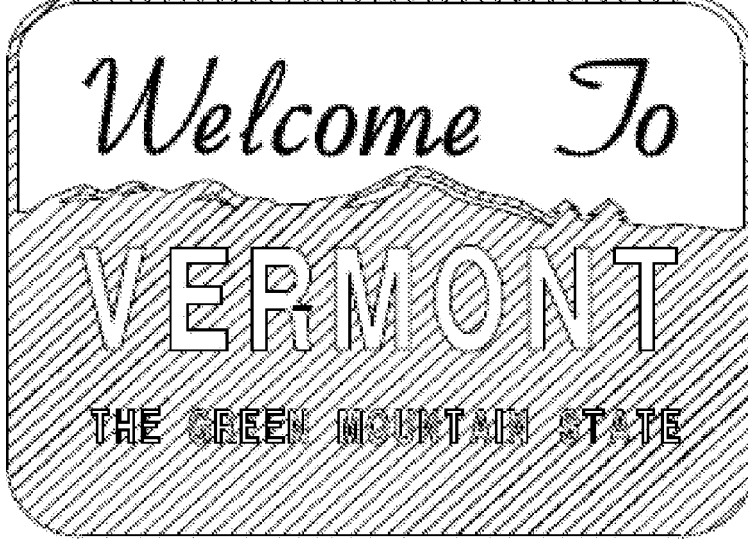





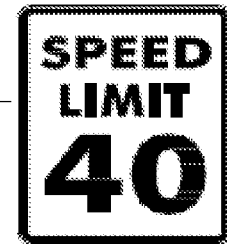

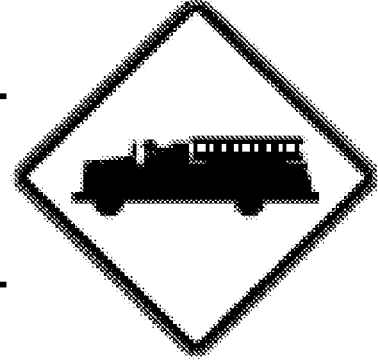CHECKED BY: A. GAMBLE

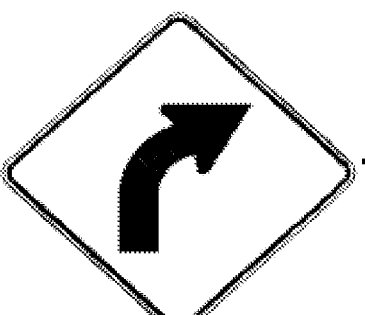

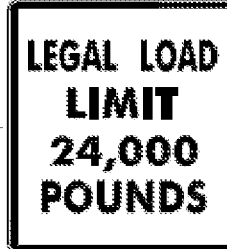

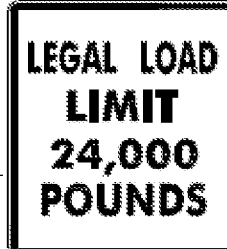








SHEET 8 OF 198





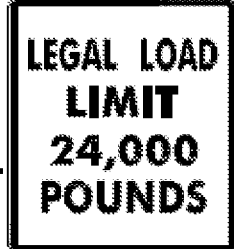


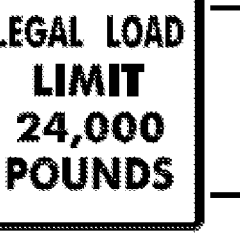



DIRECTION	MILEPOINT	LOCATION CODE (SHEET 2)	SIGN CODE	WIDTH (IN)	HEIGHT (IN)	SHEETING REMARKS	SIGN LEGEND	NEW SIGNS		EXISTING SIGNS			EXIST POST		NUMBER OF NEW POSTS	SQUARE STEEL (IN)			TUBULAR STEEL Ø (IN)				SIGN FRAME REQUIRED	REMARKS	SIGN DETAIL				
								"A"	"B"	RETAIN	SALVAGE FROM	SALVAGE TO	REMOVE	RETAIN		REMOVE	1.75	2.00	2.50	FOUNDATION	3.00	3.50			4.00	5.00	DETAIL IN SHS	DETAIL ON SHEET NUMBER	DETAIL ON STD SHEET NUMBER
																	(LB / FT)				(LB / FT)								
STAMFORD VT 100							FY-FLUORESCENT YELLOW FYG-FLUORESCENT YELLOW GREEN																"SHS"-STANDARD HIGHWAY SIGNS						
																													
NB	0.016	A	VD-421A	60	48							1		X															
		A	VD-421A	30	24			5.00							1		X										5		
NB	0.043	A	R2-1	24	30							1		X															
		A	R2-1	24	30			5.00							1		X								X				
NB	0.043	A	M3-1S	24	12		NORTH					1		X															
		A	M1-5	30	24		VERMONT 100					1																	
		A	M1-5A	24	24		VERMONT 8					1																	
NB	0.081	A	M3-1	24	12			2.00							2		X					#1A	INSTALL ASSEMBLY 200 FEET NORTH OF EXISTING ASSEMBLY. GREEN ON WHITE SHEETING	X		7			
		A	M1-5	30	24			5.00																			E-136B		
		A	M3-1	24	12			2.00															GREEN ON WHITE SHEETING	X					
		A	M1-5	24	24			4.00																			E-136B		
NB	0.125	A	VR-128	36	36							1		X															
		A	VR-601	30	36			7.50 7.00							1		X										6		
NB	0.150	A	VR-654	24	24							1		X															
SIGN SUMMARY SHEET							SHEET TOTALS	30.50 30.00	0.00	0	0	0	7	0	0	5	75					PROJECT NAME: Stamford-Andover VT100							
								SF	SF	EA	EA	EA	EA	EA	EA	EA	FT					PROJECT NUMBER: STPG SIGN(20)							
																						FILE NAME: Stamford.xls	PLOT DATE: 8/5/2009						
VERMONT AGENCY OF TRANSPORTATION							TOWN TOTALS	455.0	0.0	16.0	5.0	5.0	75	0.0	0.0	83	1245.0					PROJECT MANAGER: N. Avery	DRAWN BY: T. Guazzoni						
																					DESIGNED BY: J. Kelly	CHECKED BY: T. Guazzoni							
																					STAMFORD SHEET 1	SHEET 9 OF 198							








DIRECTION	MILEPOINT	LOCATION CODE (SHEET 2)	SIGN CODE	WIDTH (IN)	HEIGHT (IN)	SHEETING REMARKS	SIGN LEGEND	NEW SIGNS		EXISTING SIGNS			EXIST POST		NUMBER OF NEW POSTS	SQUARE STEEL (IN)			TUBULAR STEEL Ø (IN)				SIGN FRAME REQUIRED	REMARKS	SIGN DETAIL				
								"A"	"B"	RETAIN	SALVAGE FROM	SALVAGE TO	REMOVE	RETAIN		REMOVE	1.75	2.00	2.50	FOUNDATION	3.00	3.50			4.00	5.00	DETAIL IN SHS	DETAIL ON SHEET NUMBER	DETAIL ON STD SHEET NUMBER
																	(LB / FT)				(LB / FT)								
STAMFORD VT 100							FY-FLUORESCENT YELLOW FYG-FLUORESCENT YELLOW GREEN															"SHS"-STANDARD HIGHWAY SIGNS							
NB	0.150	A	VR-655	24	18		STRICTLY ENFORCED																						
		A	VR-654	24	24			4.00						1			X									E-143			
NB	0.191	A	VR-048	24	30																								
		A	VR-048	24	30			5.00						1			X								E-144				
NB	0.220	A	R2-1	24	30																								
		A	R2-1	24	30			5.00						1			X							X					
NB	0.260	A	W11-7	30	30		EQUESTRIAN SYMBOL																		STUB ONLY REMOVED				
NB	0.260	A	W7-3A	30	30		NEXT 2 MILES																						
NB	0.310	A	VD-018	30	18																								
		A	VD-018	30	18			3.75						1			X								E-128A				
NB	0.360	A	W1-4R	30	30		RIGHT REVERSE CURVE																						
NB	0.360 0.379	A	W1-4R	30	30			6.25						1			X								THIS SIGN WAS KEPT AT THE SAME LOCATION AT REQUEST OF AOT-DIST. #1				
NB	0.421	A	R2-1	24	30																								
		A	R2-1	30	36			7.50						1			X								6				
NB	0.460	A	VD-062B	72	16		BUSINESS SIGN			1							X												
SIGN SUMMARY SHEET							SHEET TOTALS	31.50	0.00	1	0	0	6	0	0	6	90					PROJECT NAME: Stamford-Andover VT100							
								SF	SF	EA	EA	EA	EA	EA	EA	EA	FT					PROJECT NUMBER: STPG SIGN(20)							
VERMONT AGENCY OF TRANSPORTATION							TOWN TOTALS	455.0	0.0	16.0	5.0	5.0	75	0.0	0.0	83	1245.0					FILE NAME: Stamford.xls	PLOT DATE: 8/5/2009						
																					PROJECT MANAGER: N. Avery	DRAWN BY: T. Guazzoni							
																					DESIGNED BY: J. Kelly	CHECKED BY: T. Guazzoni							
																					STAMFORD SHEET 2	SHEET 10 OF 198							









DIRECTION	MILEPOINT	LOCATION CODE (SHEET 2)	SIGN CODE	WIDTH (IN)	HEIGHT (IN)	SHEETING REMARKS	SIGN LEGEND	NEW SIGNS		EXISTING SIGNS			EXIST POST		NUMBER OF NEW POSTS	SQUARE STEEL (IN)			TUBULAR STEEL Ø (IN)				SIGN FRAME REQUIRED	REMARKS	SIGN DETAIL					
								"A"	"B"	RETAIN	SALVAGE FROM	SALVAGE TO	REMOVE	RETAIN		REMOVE	1.75	2.00	2.50	FOUNDATION	3.00	3.50			4.00	5.00	DETAIL IN SHS	DETAIL ON SHEET NUMBER	DETAIL ON STD SHEET NUMBER	
																	(LB / FT)				(LB / FT)									
STAMFORD VT 100							FY-FLUORESCENT YELLOW FYG-FLUORESCENT YELLOW GREEN															"SHS"-STANDARD HIGHWAY SIGNS								
NB	0.842	A	S1-1YG	30	30		SCHOOL PENTAGON			1																				
		A	W16-9YG	24	12		AHEAD			1																				
NB	0.880	A	S4-3YG	24	8		SCHOOL			1																				
		A	R2-1	24	30		SPEED LIMIT 30			1																				
		A	S4-4	24	10		WHEN FLASHING			1																				
NB	0.900 0.924	A	W11-8	30	30			6.25						1		X														
NB	0.963	A	S1-1YG	30	30		SCHOOL PENTAGON			1																				
		A	W16-7YG	24	12		DOWN LH ARROW			1																				
NB	1.005	A	S1-1YG	30	30		SCHOOL PENTAGON			1																				
		A	W16-7YG	24	12		DOWN LH ARROW			1																				
NB	1.117	A	S5-2	24	30			5.00						1		X														
NB	1.170	A	R2-1	24	30							1																		
		A	R2-1	24	30			5.00						1		X														
NB	1.500	A	W1-2R	30	30		RIGHT CURVE					1				X														
																														
NB	1.520	A	W1-2R	30	30			6.25						1		X														
SIGN SUMMARY SHEET							SHEET TOTALS	22.50	0.00	9	0	0	2	0	0	4		60												
VERMONT AGENCY OF TRANSPORTATION							TOWN TOTALS	455.0	0.0	16.0	5.0	5.0	75	0.0	0.0	83		1245.0												
PROJECT NAME: Stamford-Andover VT100																					PROJECT NUMBER: STPG SIGN(20)									
FILE NAME: Stamford.xls												PLOT DATE: 8/5/2009																		
PROJECT MANAGER: N. Avery												DRAWN BY: T. Guazzoni																		
DESIGNED BY: J. Kelly												CHECKED BY: T. Guazzoni																		
STAMFORD SHEET 4												SHEET 12 OF 198																		

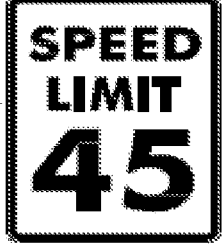


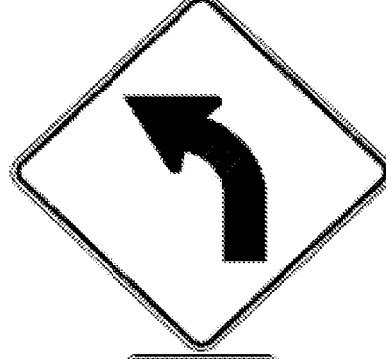


DIRECTION	MILEPOINT	LOCATION CODE (SHEET 2)	SIGN CODE	WIDTH (IN)	HEIGHT (IN)	SHEETING REMARKS	SIGN LEGEND	NEW SIGNS		EXISTING SIGNS			EXIST POST		NUMBER OF NEW POSTS	SQUARE STEEL (IN)			TUBULAR STEEL Ø (IN)				SIGN FRAME REQUIRED	REMARKS	SIGN DETAIL						
								"A"	"B"	RETAIN	SALVAGE FROM	SALVAGE TO	REMOVE	RETAIN		REMOVE	1.75	2.00	2.50	FOUNDATION	3.00	3.50			4.00	5.00	DETAIL IN SHS	DETAIL ON SHEET NUMBER	DETAIL ON STD SHEET NUMBER		
																	(LB / FT)				(LB / FT)										
STAMFORD VT 100							FY-FLUORESCENT YELLOW FYG-FLUORESCENT YELLOW GREEN															"SHS"-STANDARD HIGHWAY SIGNS									
		A	W13-1	18	18			2.25																X							
NB	1.560	C	VR-017	24	24						I		2 +		X																
		C	VR-017	24	30			5.00				I			1	X											TH-22, CLAYTON AVE		E-141		
NB	1.565	D	R1-1	24	24									1		X															
		D	R1-1	30	30			6.25							1	X											TH-22, CLAYTON AVE	X			
NB	1.565	A	R2-1	24	30		SPEED LIMIT 45							1		X															
NB	1.678	A	R2-1	24	30										1	X												INSTALL 600 FEET NORTH OF EXISTING SPEED LIMIT 45 SIGN	X		
NB	1.824	C	VR-017	24	24							I	I	1		X															
		C	VR-017	24	30			5.00							1	X												TH-1, CLOUGH RD		E-141	
NB	1.832	D	R1-1	24	24																										
		D	R1-1	30	30			6.25							1	X												TH-1, CLOUGH RD	X		
NB	1.870	A	R2-1	24	30																										
		A	VR-208	24	24																									6	
NB	2.185	C	VR-017	24	30																										
		C	VR-017	24	30			5.00							1	X													TH-25, CLOUGH RD		E-141
NB	2.200	D	R1-1	30	30									1		X															
SIGN SUMMARY SHEET							SHEET TOTALS	43.75	0.00	0	2	2	7	0	0	7	105							PROJECT NAME: Stamford-Andover VT100							
VERMONT AGENCY OF TRANSPORTATION							TOWN TOTALS	455.0	0.0	16.0	5.0	5.0	75	0.0	0.0	83	1245.0						PROJECT NUMBER: STPG SIGN(20)								
								SF	SF	EA	EA	EA	EA	EA	EA	EA	FT						FILE NAME: Stamford.xls								
																						PLOT DATE: 8/5/2009									
																						PROJECT MANAGER: N. Avery									
																					DRAWN BY: T. Guazzoni										
																					DESIGNED BY: J. Kelly										
																					CHECKED BY: T. Guazzoni										
																					STAMFORD SHEET 5										
																					SHEET 13 OF 198										






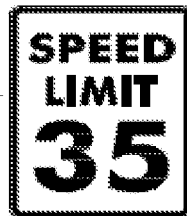
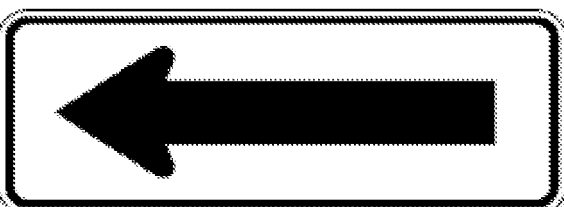
DIRECTION	MILEPOINT	LOCATION CODE (SHEET 2)	SIGN CODE	WIDTH (IN)	HEIGHT (IN)	SHEETING REMARKS	SIGN LEGEND	NEW SIGNS		EXISTING SIGNS			EXIST POST		NUMBER OF NEW POSTS	SQUARE STEEL (IN)			TUBULAR STEEL Ø (IN)				SIGN FRAME REQUIRED	REMARKS	SIGN DETAIL				
								"A"	"B"	RETAIN	SALVAGE FROM	SALVAGE TO	REMOVE	RETAIN		REMOVE	1.75	2.00	2.50	FOUNDATION	3.00	3.50			4.00	5.00	DETAIL IN SHS	DETAIL ON SHEET NUMBER	DETAIL ON STD SHEET NUMBER
																	(LB / FT)				(LB / FT)								
STAMFORD VT 100							FY-FLUORESCENT YELLOW FYG-FLUORESCENT YELLOW GREEN															"SHS"-STANDARD HIGHWAY SIGNS							
NB	2.200	D	R1-1	30	30		 	6.25						1		X							TH-25, CLOUGH RD	X					
NB	2.385	A	VW-054L	30	30			6.25						1		X							INSTALL ACROSS FROM DRIVE #2395			E-154			
NB	2.550	A	R2-1	24	30							1				X													
NB	3.085	C	VR-017	24	30							1				X													
		C	VR-017	24	30			5.00						1		X							TH-26, ROBILLARD RD SOUTH			E-141			
NB	3.090	D	R1-1	30	30							1				X													
		D	R1-1	30	30			6.25						1		X							TH-26, ROBILLARD RD SOUTH	X					
NB	3.382	C	VR-017	24	30			5.00						1		X							TH-26, ROBILLARD RD NORTH			E-141			
NB	3.390	D	R1-1	30	30							1				X													
		D	R1-1	30	30			6.25						1		X							TH-26, ROBILLARD RD NORTH	X					
NB	3.739	C	VR-017	24	30			5.00						1		X							TH-27, BROOKSIDE DR			E-141			
NB	3.747	D	R1-1	30	30							1				X													
		D	R1-1	30	30			6.25						1		X							TH-27, BROOKSIDE DR	X					
NB	4.921	C	VR-017	24	30							1				X													
SIGN SUMMARY SHEET							SHEET TOTALS	51.25	0.00	0	0	0	6	0	0	9	135						PROJECT NAME: Stamford-Andover VT100						
								SF	SF	EA	EA	EA	EA	EA	EA	EA	FT					PROJECT NUMBER: STPG SIGN(20)							
VERMONT AGENCY OF TRANSPORTATION							TOWN TOTALS	455.0	0.0	16.0	5.0	5.0	75	0.0	0.0	83	1245.0					FILE NAME: Stamford.xls	PLOT DATE: 8/5/2009						
																					PROJECT MANAGER: N. Averb	DRAWN BY: T. Guazzoni							
																					DESIGNED BY: J. Kelly	CHECKED BY: T. Guazzoni							
																					STAMFORD SHEET 6	SHEET 14 OF 198							

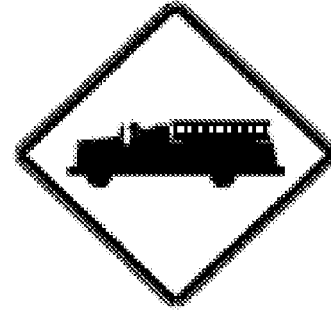




DIRECTION	MILEPOINT	LOCATION CODE (SHEET 2)	SIGN CODE	WIDTH (IN)	HEIGHT (IN)	SHEETING REMARKS	SIGN LEGEND	NEW SIGNS		EXISTING SIGNS			EXIST POST		NUMBER OF NEW POSTS	SQUARE STEEL (IN)			TUBULAR STEEL Ø (IN)				SIGN FRAME REQUIRED	REMARKS	SIGN DETAIL			
								"A"	"B"	RETAIN	SALVAGE FROM	SALVAGE TO	REMOVE	RETAIN		REMOVE	1.75	2.00	2.50	3.00	3.50	4.00			5.00	DETAIL IN SHS	DETAIL ON SHEET NUMBER	DETAIL ON STD SHEET NUMBER
																	(LB / FT)			(LB / FT)								
STAMFORD VT 100							FY-FLUORESCENT YELLOW FYG-FLUORESCENT YELLOW GREEN															"SHS"-STANDARD HIGHWAY SIGNS						
NB	4.921	C	VR-017	24	30			5.00						1	X								TH-28, BUSHIKA RD SOUTH REINSTALL TOWN'S SPEED LIMIT 25 SIGN BELOW NEW LEGAL LOAD SIGN			E-141		
		C	R2-1	24	30		SPEED LIMIT 25 (TOWN)			1	1																	
NB	4.930	D	R1-1	30	30			6.25						1	X								TH-28, BUSHIKA RD SOUTH	X				
NB	5.098	C	VR-017	24	30							1		X														
		C	VR-017	24	30			5.00						1	X								TH-28, BUSHIKA RD NORTH			E-141		
NB	5.106	D	R1-1	30	30							1		X														
		D	R1-1	30	30			6.25						1	X								TH-28, BUSHIKA RD NORTH	X				
SB	5.289	G	VR-017	24	24							1		X														
		G	VR-017	24	30			5.00						1	X								TH-3, SPORTSMEN RD			E-141		
SB	5.281	H	R1-1	30	30							1		X														
		H	R1-1	30	30			6.25						1	X								TH-3, SPORTSMEN RD	X				
SB	4.407	G	VR-017	24	30			5.00						1	X								TH-4, COLLINS RD			E-141		
SB	4.415	H	R1-1	30	30							1		X														
		H	R1-1	30	30			6.25						1	X								TH-4, COLLINS RD	X				
SB	4.051	F	VW-054L	30	30			6.25						1	X								INSTALL AT BEGINNING OF SB PASSING ZONE (MARK ON PAVEMENT)			E-154		
SIGN SUMMARY SHEET							SHEET TOTALS	51.25	0.00	0	1	1	6	0	0	9	135						PROJECT NAME: Stamford-Andover VT100					
VERMONT AGENCY OF TRANSPORTATION							TOWN TOTALS	455.0	0.0	16.0	5.0	5.0	75	0.0	0.0	83	1245.0						PROJECT NUMBER: STPG SIGN(20)					
								SF	SF	EA	EA	EA	EA	EA	EA	EA	FT					FILE NAME: Stamford.xls	PLOT DATE: 8/5/2009					
																					PROJECT MANAGER: N. Avery	DRAWN BY: T. Guazzoni						
																					DESIGNED BY: J. Kelly	CHECKED BY: T. Guazzoni						
																					STAMFORD SHEET 7	SHEET 15	OF 198					

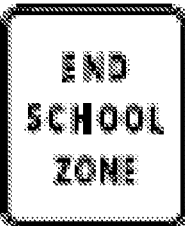

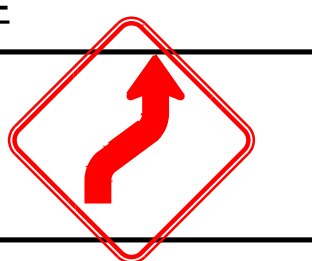DIRECTION	MILEPOINT	LOCATION CODE (SHEET 2)	SIGN CODE	WIDTH (IN)	HEIGHT (IN)	SHEETING REMARKS	SIGN LEGEND	NEW SIGNS		EXISTING SIGNS			EXIST POST		NUMBER OF NEW POSTS	SQUARE STEEL (IN)			TUBULAR STEEL Ø (IN)				SIGN FRAME REQUIRED	REMARKS	SIGN DETAIL			
								"A"	"B"	RETAIN	SALVAGE FROM	SALVAGE TO	REMOVE	RETAIN		REMOVE	1.75	2.00	2.50	3.00	3.50	4.00			5.00	DETAIL IN SHS	DETAIL ON SHEET NUMBER	DETAIL ON STD SHEET NUMBER
																	(LB / FT)			(LB / FT)								
STAMFORD VT 100							FY-FLUORESCENT YELLOW FYG-FLUORESCENT YELLOW GREEN															"SHS"-STANDARD HIGHWAY SIGNS						
SB	2.840	F	R2-1	24	30							1																
		F	R2-1	24	30			5.00																X				
SB	2.713	G	VR-017	24	30							1																
		G	VR-017	24	30			5.00																		E-141		
SB	2.705	H	R1-1	30	30							1																
		H	R1-1	30	30			6.25																X				
SB	2.590	H	R1-1	24	24		STOP					1														TH-7, LINCOLN RD		
SB	2.490	F	VW-054R	30	30							1																
		F	S3-1	30	30							1																
		F	VW-054R	30	30			6.25																		E-154		
		F	S3-1	30	30			6.25																X				
SB	1.980	F	R2-5A	24	30		REDUCED SPEED AHEAD					1																
SB	1.870	F	R2-1	24	30							1																
		F	R2-1	30	36			7.50																		6		
SB	1.827	F	W11-2	30	30		PEDESTRIAN					1																
SIGN SUMMARY SHEET							SHEET TOTALS	36.25	0.00	0	0	0	9	0	0	6	90					PROJECT NAME: Stamford-Andover VT100						
VERMONT AGENCY OF TRANSPORTATION							TOWN TOTALS	455.0	0.0	16.0	5.0	5.0	75	0.0	0.0	83	1245.0					PROJECT NUMBER: STPG SIGN(20)						
								SF	SF	EA	EA	EA	EA	EA	EA	EA	FT					FILE NAME: Stamford.xls	PLOT DATE: 8/5/2009					
																						PROJECT MANAGER: N. Avery	DRAWN BY: T. Guazzoni					
																						DESIGNED BY: J. Kelly	CHECKED BY: T. Guazzoni					
																						STAMFORD SHEET 8	SHEET 16 OF 198					

DIRECTION	MILEPOINT	LOCATION CODE (SHEET 2)	SIGN CODE	WIDTH (IN)	HEIGHT (IN)	SHEETING REMARKS	SIGN LEGEND	NEW SIGNS		EXISTING SIGNS			EXIST POST		NUMBER OF NEW POSTS	SQUARE STEEL (IN)			TUBULAR STEEL Ø (IN)				SIGN FRAME REQUIRED	REMARKS	SIGN DETAIL																														
								"A"	"B"	RETAIN	SALVAGE FROM	SALVAGE TO	REMOVE	RETAIN		REMOVE	1.75	2.00	2.50	FOUNDATION	3.00	3.50			4.00	5.00	DETAIL IN SHS	DETAIL ON SHEET NUMBER	DETAIL ON STD SHEET NUMBER																										
																	(LB / FT)				(LB / FT)																																		
STAMFORD VT 100							FY-FLUORESCENT YELLOW FYG-FLUORESCENT YELLOW GREEN															"SHS"-STANDARD HIGHWAY SIGNS																																	
			F W11-7	30	30		EQUESTRIAN						1																																										
			F W7-3A	24	30		NEXT 2 MILES						1																																										
SB	1.776	G	VR-017	24	30																																																		
		G	VR-017	24	30				5.00							1	X																																						
SB	1.768	H	R1-1	30	30																																																		
SB	1.756	F	N/A	30	30		EMPTY POST																																																
SB	1.708	F	W1-2L	30	30																																																		
		F	W13-1	18	18				6.25																																														
SB	1.505	F	R2-1	24	30																																																		
		F	R2-1	24	30				5.00																																														
SB	1.270	F	R2-5A	24	30																																																		
		F	W3-5	36	36				9.00																																														
	1.214	F	VD-018	30	18																																																		
SB	1.170	F	R2-1	24	30																																																		
		F	R2-1	30	36				7.50																																														
SIGN SUMMARY SHEET							SHEET TOTALS	45.00	0.00	0	0	0	7	0	0	8	120																																						
VERMONT AGENCY OF TRANSPORTATION							TOWN TOTALS	455.0	0.0	16.0	5.0	5.0	75	0.0	0.0	83	1245.0																																						
																					PROJECT NAME:	Stamford-Andover VT100							PROJECT NUMBER:							STPG SIGN(20)																			
																					FILE NAME:	Stamford.xls							PLOT DATE:							8/5/2009																			
																					PROJECT MANAGER:							N. Avery							DRAWN BY:							T. Guazzoni													
																					DESIGNED BY:							J. Kelly							CHECKED BY:							T. Guazzoni													
																					STAMFORD SHEET 9							SHEET							17							OF							198						



DIRECTION	MILEPOINT	LOCATION CODE (SHEET 2)	SIGN CODE	WIDTH (IN)	HEIGHT (IN)	SHEETING REMARKS	SIGN LEGEND	NEW SIGNS		EXISTING SIGNS				EXIST POST		NUMBER OF NEW POSTS	SQUARE STEEL (IN)			TUBULAR STEEL Ø (IN)				SIGN FRAME REQUIRED	REMARKS	SIGN DETAIL		
								"A"	"B"	RETAIN	SALVAGE FROM	SALVAGE TO	REMOVE	RETAIN	REMOVE		1.75	2.00	2.50	3.00	3.50	4.00	5.00			DETAIL IN SHS	DETAIL ON SHEET NUMBER	DETAIL ON STD SHEET NUMBER
																	(LB / FT)			(LB / FT)								
STAMFORD VT 100							FY-FLUORESCENT YELLOW FYG-FLUORESCENT YELLOW GREEN															"SHS"-STANDARD HIGHWAY SIGNS						
SB	1.155	F	S1-1YG	30	30		SCHOOL PENTAGON			1				X														
SB	1.155	F	W16-9YG	24	12		AHEAD			1																		
SB	1.117	F	S4-3YG	24	8		SCHOOL			I	+	+		X	+							RETAIN SIGNS AND FLASHING BEACON. REPLACE POST						
SB	1.117	F	R2-1	24	30		SPEED LIMIT 30			I	+	+										NO WORK WAS DONE AT THIS LOCATION DUE TO CONDUIT ON THE POST.						
SB	1.117	F	S4-4	24	10		WHEN FLASHING			I	+	+																
SB	1.079	F	W11-8	30	30								1	X								MAINTAIN 10' MIN FROM UTILITY POLE						
		F	W11-8	30	30			6.25							1				X				X					
SB	1.077	G	VR-017	24	30								1	X														
		G	VR-017	24	30			5.00							1				X			TH-12, MILL RD			E-141			
SB	1.069	H	R1-1	30	30								1	X								TH-12, MILL RD						
		H	R1-1	30	30			6.25							1				X				X					
SB	1.020	G	VR-017	24	30								1	X														
		G	VR-017	24	30			5.00							1				X			TH-20, STEBBINS RD			E-141			
SB	1.016	H	R1-1	30	30								1	X								TH-20, STEBBINS RD						
		H	R1-1	30	30			6.25							1				X				X					
SIGN SUMMARY SHEET							SHEET TOTALS	28.75	0.00	25	0	0	5	0	0	5	90					PROJECT NAME: Stamford-Andover VT100						
VERMONT AGENCY OF TRANSPORTATION							TOWN TOTALS	455.0	0.0	16.0	5.0	5.0	75	0.0	0.0	83	1245.0					PROJECT NUMBER: STPG SIGN(20)						
								SF	SF	EA	EA	EA	EA	EA	EA	EA	FT					FILE NAME: Stamford.xls PLOT DATE: 8/5/2009						
																						PROJECT MANAGER: N. Avery DRAWN BY: T. Guazzoni						
																						DESIGNED BY: J. Kelly CHECKED BY: T. Guazzoni						
																						STAMFORD SHEET 10 SHEET 18 OF 198						

DIRECTION	MILEPOINT	LOCATION CODE (SHEET 2)	SIGN CODE	WIDTH (IN)	HEIGHT (IN)	SHEETING REMARKS	SIGN LEGEND	NEW SIGNS		EXISTING SIGNS			EXIST POST		NUMBER OF NEW POSTS	SQUARE STEEL (IN)			TUBULAR STEEL Ø (IN)				SIGN FRAME REQUIRED	REMARKS	SIGN DETAIL				
								"A"	"B"	RETAIN	SALVAGE FROM	SALVAGE TO	REMOVE	RETAIN		REMOVE	1.75	2.00	2.50	FOUNDATION	3.00	3.50			4.00	5.00	DETAIL IN SHS	DETAIL ON SHEET NUMBER	DETAIL ON STD SHEET NUMBER
																	(LB / FT)				(LB / FT)								
STAMFORD VT 100							FY-FLUORESCENT YELLOW FYG-FLUORESCENT YELLOW GREEN															"SHS"-STANDARD HIGHWAY SIGNS							
SB	1.007	F	S1-1YG	30	30		SCHOOL PENTAGON			1			X																
SB	1.007	F	W16-7YG	24	12		DOWN LH ARROW			1																			
SB	0.965	F	S1-1YG	30	30		SCHOOL PENTAGON			1			X																
SB	0.965	F	W16-7YG	24	12		DOWN LH ARROW			1																			
SB	0.880	F	S5-2	24	30			5.00						1	X								INSTALL ACROSS ROAD FROM SCHOOL SPEED LIMIT 30 WHEN FLASHING	X					
SB	0.819	G	VR-017	24	30							1		X									TH-2, JEPSON RD						
		G	VR-017	24	30			5.00						1	X												E-141		
SB	0.811	H	R1-1	30	30							1		X									TH-2, JEPSON RD						
		H	R1-1	30	30			6.25						1	X								INSTALL SIGN CLOSER TO VT-100	X					
SB	0.795	F	W1-4L	30	30		LEFT REVERSE CURVE					1		X															
SB	0.780	F	W1-4L R	30	30		 	6.25						1	X								INSTALL 80 FEET SOUTH OF EXISTING LOCATION	X					
SB	0.560	F	R2-1	24	30							1		X															
		F	R2-1	24	30			5.00						1	X											X			
SB	0.465	F	W1-6	48	24			8.00						2	X								INSTALL BETWEEN DRIVEWAY AND EXISTING LARGE ARROW	X					
SB	0.460	E	W1-6	48	24							1		X															
SIGN SUMMARY SHEET							SHEET TOTALS	35.50	0.00	4	0	0	5	0	0	7	105							PROJECT NAME: Stamford-Andover VT100					
								SF	SF	EA	EA	EA	EA	EA	EA	EA	FT						PROJECT NUMBER: STPG SIGN(20)						
VERMONT AGENCY OF TRANSPORTATION							TOWN TOTALS	455.0	0.0	16.0	5.0	5.0	75	0.0	0.0	83	1245.0						FILE NAME: Stamford.xls	PLOT DATE: 8/5/2009					
																						PROJECT MANAGER: N. Avery	DRAWN BY: T. Guazzoni						
																					DESIGNED BY: J. Kelly	CHECKED BY: T. Guazzoni							
																					STAMFORD SHEET 11	SHEET 19 OF 198							

DIRECTION	MILEPOINT	LOCATION CODE (SHEET 2)	SIGN CODE	WIDTH (IN)	HEIGHT (IN)	SHEETING REMARKS	SIGN LEGEND	NEW SIGNS		EXISTING SIGNS				EXIST POST		NUMBER OF NEW POSTS	SQUARE STEEL (IN)			TUBULAR STEEL Ø (IN)				SIGN FRAME REQUIRED	REMARKS	SIGN DETAIL			
								"A"	"B"	RETAIN	SALVAGE FROM	SALVAGE TO	REMOVE	RETAIN	REMOVE		1.75	2.00	2.50	3.00	3.50	4.00	5.00			DETAIL IN SHS	DETAIL ON SHEET NUMBER	DETAIL ON STD SHEET NUMBER	
																	(LB / FT)			(LB / FT)									
STAMFORD VT 100							FY-FLUORESCENT YELLOW FYG-FLUORESCENT YELLOW GREEN															"SHS"-STANDARD HIGHWAY SIGNS							
		E	W1-6	48	24			8.00							2	X								X					
SB	0.420	F	R2-1	24	30							1		X															
		F	R2-1	24	30			5.00						1		X								X					
SB	0.244	F	R2-1	24	30							1		X															
		F	R2-1	24	30			5.00						1		X							X						
SB	0.060	F	M4-6S	24	12							1		X															
		F	M1-5	30	24							1																	
		F	M1-5	24	24							1																	
		F	M4-6	24	12			2.00						2		X					#1A	GREEN ON WHITE SHEETING	X	7					
		F	M1-5	30	24			5.00																	E-136B				
		F	M4-6	24	12			2.00																					
		F	M1-5	24	24			4.00																	E-136B				
SB	0.000	F	VR-038	24	18							1		X															
		F	VR-040	24	24		THROUGH WAY ENDS HERE					1																	
		E	VR-039	24	18							1																	
SIGN SUMMARY SHEET							SHEET TOTALS	31.00	0.00	0	0	0	8	0	0	6	90							PROJECT NAME: Stamford-Andover VT100					
								SF	SF	EA	EA	EA	EA	EA	EA	EA	FT							PROJECT NUMBER: STPG SIGN(20)					
VERMONT AGENCY OF TRANSPORTATION							TOWN TOTALS	455.0	0.0	16.0	5.0	5.0	75	0.0	0.0	83	1245.0							FILE NAME: Stamford.xls					
																								PLOT DATE: 8/5/2009					
																									DRAWN BY: T. Guazzoni				
																										CHECKED BY: T. Guazzoni			
																											SHEET 20 OF 198		



DIRECTION	MILEPOINT	LOCATION CODE (SHEET 2)	SIGN CODE	WIDTH (IN)	HEIGHT (IN)	SHEETING REMARKS	SIGN LEGEND	NEW SIGNS		EXISTING SIGNS				EXIST POST		NUMBER OF NEW POSTS	SQUARE STEEL (IN)			TUBULAR STEEL Ø (IN)				SIGN FRAME REQUIRED	REMARKS	SIGN DETAIL		
								"A"	"B"	RETAIN	SALVAGE FROM	SALVAGE TO	REMOVE	RETAIN	REMOVE		1.75	2.00	2.50	3.00	3.50	4.00	5.00			DETAIL IN SHS	DETAIL ON SHEET NUMBER	DETAIL ON STD SHEET NUMBER
																	(LB / FT)			(LB / FT)								
STAMFORD VT 100							FY-FLUORESCENT YELLOW FYG-FLUORESCENT YELLOW GREEN																"SHS"-STANDARD HIGHWAY SIGNS					
	E	VR-041		24	24		THROUGH WAY BEGINS HERE																					
	F	VR-038		24	18			3.00									1		X							E-141		
	E	VR-039		24	18			3.00																			E-141	
SIGN SUMMARY SHEET							SHEET TOTALS	6.00	0.00	0	0	0	1	0	0	1		15							PROJECT NAME: Stamford-Andover VT100			
VERMONT AGENCY OF TRANSPORTATION							TOWN TOTALS	SF	SF	EA	EA	EA	EA	EA	EA	EA	EA	FT							PROJECT NUMBER: STPG SIGN(20)			
								455.0	0.0	16.0	5.0	5.0	75	0.0	0.0	83		1245.0							FILE NAME: Stamford.xls	PLOT DATE: 8/5/2009		
																									PROJECT MANAGER: N. Avery	DRAWN BY: T. Guazzoni		
																									DESIGNED BY: J. Kelly	CHECKED BY: T. Guazzoni		
																									STAMFORD SHEET 13	SHEET 21 OF 198		

DIRECTION	MILEPOINT	LOCATION CODE (SHEET 2)	SIGN CODE	WIDTH (IN)	HEIGHT (IN)	SHEETING REMARKS	SIGN LEGEND	NEW SIGNS		EXISTING SIGNS			EXIST POST		NUMBER OF NEW POSTS	SQUARE STEEL (IN)			TUBULAR STEEL Ø (IN)				SIGN FRAME REQUIRED	REMARKS	SIGN DETAIL				
								"A"	"B"	RETAIN	SALVAGE FROM	SALVAGE TO	REMOVE	RETAIN		REMOVE	1.75	2.00	2.50	FOUNDATION	3.00	3.50			4.00	5.00	DETAIL IN SHS	DETAIL ON SHEET NUMBER	DETAIL ON STD SHEET NUMBER
																	(LB / FT)				(LB / FT)								
READSBORO VT 100							FY-FLUORESCENT YELLOW FYG-FLUORESCENT YELLOW GREEN															"SHS"-STANDARD HIGHWAY SIGNS							
NB	0.000	C	VD-024	72	10			5.00						2	X								AT THE REQUEST OF AOT-DIST #1 THIS SIGN WAS REMOVED AND RE-INSTALLED FARTHER AWAY FROM THE DITCHLINE. TWO NEW POSTS INSTALLED.	INSTALL 125 FEET SOUTH OF EXISTING TOWN LINE SIGN		4			
		C	VD-700	6	10			0.42																INSTALL BELOW READSBORO			E-138		
		C	VD-700	6	10			0.42																	INSTALL BELOW STAMFORD			E-138	
NB	0.024	C	VD-024	60	7.5		READSBORO/STAMFORD																						
NB	0.044	A	N/A	N/A	N/A		NEIGHBORHOOD WATCH SIGN																		REMOVE ILLEGAL SIGN. RETURN TO TOWN.				
NB	0.860	C	VM-607	24	30		43RD INF DIV			1																			
NB	1.045	C	VR-017	24	30			5.00						1		X									TH-50, RUE MADELINE RD			E-141	
NB	1.053	D	R1-1	30	30																				TH-50, RUE MADELINE RD				
		D	R1-1	30	30			6.25						1		X											X		
NB	1.829	A	VD-018	30	18																								
		A	VD-018	30	18			3.75						1		X													E-128A
NB	1.944	A	W1-2R	30	30		RIGHT CURVE																						
		A	W13-1	18	18		40 MPH PLAQUE																						
NB	1.972	A	W1-10R	30	30			6.25						1		X									INSTALL 150 FEET NORTH OF EXISTING RIGHT CURVE SIGN	X			
		A	W13-1	18	18			2.25																			X		
SIGN SUMMARY SHEET							SHEET TOTALS	29.34	0.00	1	3	3	6	0	0	6		90						PROJECT NAME: Stamford-Andover VT100					
								SF	SF	EA	EA	EA	EA	EA	EA	EA		FT					PROJECT NUMBER: STPG SIGN(20)						
VERMONT AGENCY OF TRANSPORTATION							TOWN TOTALS	408.4	0.0	34.0	3.0	3.0	84	0.0	2.0	64		960.0					FILE NAME: Readsboro.xls	PLOT DATE: 8/5/2009					
																						PROJECT MANAGER: N. Avery	DRAWN BY: T. Guazzoni						
																						DESIGNED BY: J. Kelly	CHECKED BY: T. Guazzoni						
																						READSBORO SHEET 1	SHEET 22	OF 198					


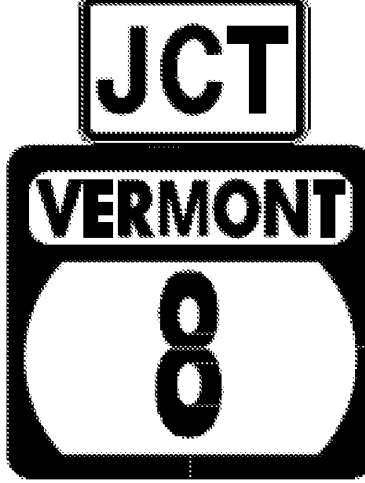




DIRECTION	MILEPOINT	LOCATION CODE (SHEET 2)	SIGN CODE	WIDTH (IN)	HEIGHT (IN)	SHEETING REMARKS	SIGN LEGEND	NEW SIGNS		EXISTING SIGNS				EXIST POST		NUMBER OF NEW POSTS	SQUARE STEEL (IN)			TUBULAR STEEL Ø (IN)				SIGN FRAME REQUIRED	REMARKS	SIGN DETAIL		
								"A"	"B"	RETAIN	SALVAGE FROM	SALVAGE TO	REMOVE	RETAIN	REMOVE		1.75	2.00	2.50	3.00	3.50	4.00	5.00			DETAIL IN SHS	DETAIL ON SHEET NUMBER	DETAIL ON STD SHEET NUMBER
																	(LB / FT)			(LB / FT)								
READSBORO VT 100							FY-FLUORESCENT YELLOW FYG-FLUORESCENT YELLOW GREEN															"SHS"-STANDARD HIGHWAY SIGNS						
NB	2.030	A	M2-1	21	15																							
		A	M1-5	24	24																							
		A	M2-1	21	15			2.19																	X			
		A	M1-5	24	24			4.00																			E-136B	
NB	2.069	A	M3-1	24	12																							
		A	M1-5	24	24																							
		A	M5-1L	21	15																							
		A	M3-1	24	12																							
		A	M1-5	24	24																							
		A	M5-1L	21	15																							
		A	M3-1	24	12			2.00																				
		A	M1-5	24	24			4.00																				
		A	M5-1L	21	15			2.19																				
		A	M4-5	24	12		2.00																					
		A	M1-5	24	24		4.00																					
SIGN SUMMARY SHEET							SHEET TOTALS	20.38	0.00	0	0	0	8	0	0	3	45											
VERMONT AGENCY OF TRANSPORTATION								SF	SF	EA	EA	EA	EA	EA	EA	EA	FT											
							TOWN TOTALS	408.4	0.0	34.0	3.0	3.0	84	0.0	2.0	64	960.0											
																					PROJECT NAME: Stamford-Andover VT100							
																					PROJECT NUMBER: STPG SIGN(20)							
																					FILE NAME: Readsboro.xls	PLOT DATE: 8/5/2009						
																					PROJECT MANAGER: N. Avery	DRAWN BY: T. Guazzoni						
																					DESIGNED BY: J. Kelly	CHECKED BY: T. Guazzoni						
																					READSBORO SHEET 2	SHEET 23 OF 198						

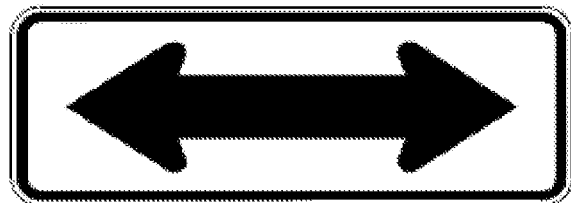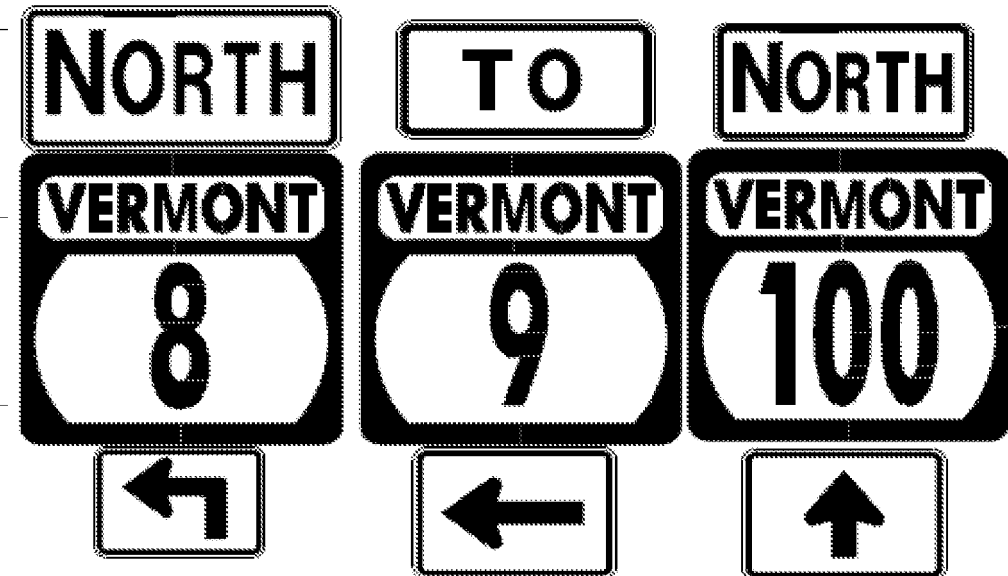

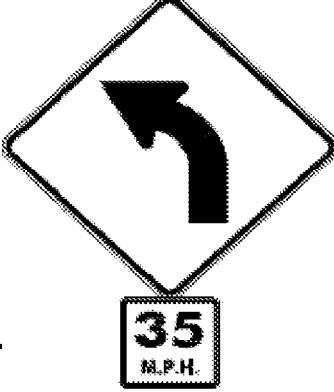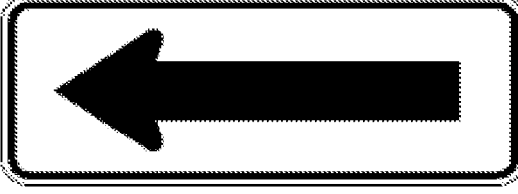

DIRECTION	MILEPOINT	LOCATION CODE (SHEET 2)	SIGN CODE	WIDTH (IN)	HEIGHT (IN)	SHEETING REMARKS	SIGN LEGEND	NEW SIGNS		EXISTING SIGNS				EXIST POST		NUMBER OF NEW POSTS	SQUARE STEEL (IN)			TUBULAR STEEL Ø (IN)				SIGN FRAME REQUIRED	REMARKS	SIGN DETAIL		
								"A"	"B"	RETAIN	SALVAGE FROM	SALVAGE TO	REMOVE	RETAIN	REMOVE		1.75	2.00	2.50	3.00	3.50	4.00	5.00			DETAIL IN SHS	DETAIL ON SHEET NUMBER	DETAIL ON STD SHEET NUMBER
																	(LB / FT)			(LB / FT)								
READSBORO VT 100							FY-FLUORESCENT YELLOW FYG-FLUORESCENT YELLOW GREEN															"SHS"-STANDARD HIGHWAY SIGNS						
			A	M5-1L	21	15		2.19															GREEN ON WHITE SHEETING	X				
NB	2.120		A	D1-1A	72	10																						
			A	D1-1A	72	10																						
			A	D1-1A	72	10																						
			A	D1-1A	72	12		6.00						2		X									5			
			A	D1-1A	72	12		6.00																	5			
			A	D1-1A	72	12		6.00																	5			
NB	2.179						A	M3-1S	24	12																		
							A	M1-5	24	24																		
							A	M5-1S	21	15																		
							A	M4-5S	24	12																		
							A	M1-5	24	24																		
							A	M6-1S	21	15																		
							A	M3-1S	24	12																		
			A	M1-5	30	24																						
SIGN SUMMARY SHEET							SHEET TOTALS		20.19	0.00	0	0	0	11	0	0	2	30										
VERMONT AGENCY OF TRANSPORTATION							SF	SF	EA	EA	EA	EA	EA	EA	EA	EA	EA	FT										
							TOWN TOTALS		408.4	0.0	34.0	3.0	3.0	84	0.0	2.0	64	960.0										
																							PROJECT NAME: Stamford-Andover VT100					
																							PROJECT NUMBER: STPG SIGN(20)					
																							FILE NAME: Readsboro.xls					
																							PLOT DATE: 8/5/2009					
																							DRAWN BY: T. Guazzoni					
																							DESIGNED BY: J. Kelly					
																							CHECKED BY: T. Guazzoni					
																							READSBORO SHEET 3					
																							SHEET 24 OF 198					


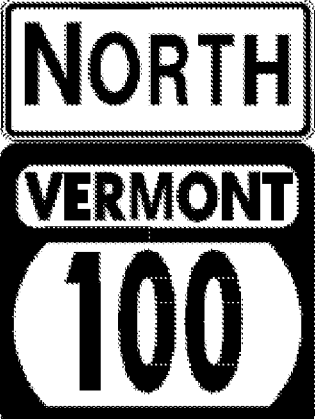
DIRECTION	MILEPOINT	LOCATION CODE (SHEET 2)	SIGN CODE	WIDTH (IN)	HEIGHT (IN)	SHEETING REMARKS	SIGN LEGEND	NEW SIGNS		EXISTING SIGNS			EXIST POST		NUMBER OF NEW POSTS	SQUARE STEEL (IN)			TUBULAR STEEL Ø (IN)				SIGN FRAME REQUIRED	REMARKS	SIGN DETAIL			
								"A"	"B"	RETAIN	SALVAGE FROM	SALVAGE TO	REMOVE	RETAIN		REMOVE	1.75	2.00	2.50	3.00	3.50	4.00			5.00	DETAIL IN SHS	DETAIL ON SHEET NUMBER	DETAIL ON STD SHEET NUMBER
																	(LB / FT)			(LB / FT)								
READSBORO VT 100							FY-FLUORESCENT YELLOW FYG-FLUORESCENT YELLOW GREEN															"SHS"-STANDARD HIGHWAY SIGNS						
NB	2.179	A	M6-3S	21	15						1											#3A	INSTALL NEW SIGNS AND FRAME ON EXISTING POSTS. GREEN ON WHITE SHEETING	X	7			
		A	M3-1	24	12																							
		A	M1-5	24	24																						E-136B	
		A	M5-1L	21	15																		GREEN ON WHITE SHEETING	X				
		A	M4-5	24	12																		GREEN ON WHITE SHEETING	X				
		A	M1-5	24	24																						E-136B	
		A	M6-1L	21	15																		GREEN ON WHITE SHEETING	X				
		A	M3-1	24	12																		GREEN ON WHITE SHEETING	X				
		A	M1-5	30	24																						E-136B	
		A	M6-3	21	15																		GREEN ON WHITE SHEETING	X				
NB	2.177	C	W1-7	48	24						1																	
		C	W1-7	48	24																			X				
NB	2.204	A	M3-1S	24	12																							
		A	M1-5	30	24																							
NB	2.224	A	D2-1	72	12																		INSTALL ASSEMBLY HALFWAY BETWEEN THE EXISTING ROUTE MARKER AND DESTINATION SIGNS		5			
SIGN SUMMARY SHEET							SHEET TOTALS		39.57	0.00	0	0	0	3	0	0	4	60	PROJECT NAME: Stamford-Andover VT100									
VERMONT AGENCY OF TRANSPORTATION							SF	SF	EA	EA	EA	EA	EA	EA	EA	EA	EA	FT	PROJECT NUMBER: STPG SIGN(20)									
							TOWN TOTALS		408.4	0.0	34.0	3.0	3.0	84	0.0	2.0	64	960.0	FILE NAME: Readsboro.xls PLOT DATE: 8/5/2009									
															DESIGNED BY: J. Kelly CHECKED BY: T. Guazzoni													
															READSBORO SHEET 4 SHEET 25 OF 198													












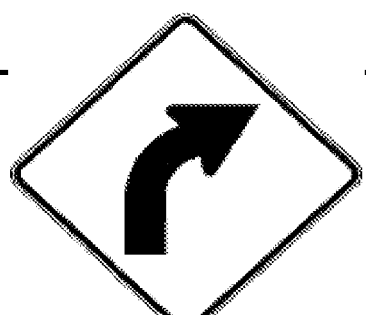



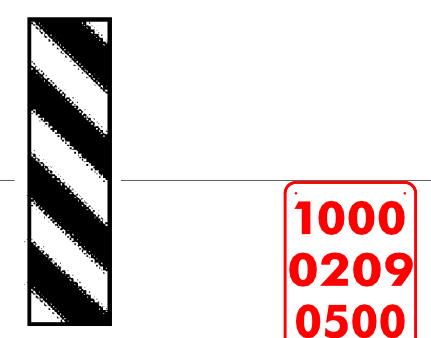



DIRECTION	MILEPOINT	LOCATION CODE (SHEET 2)	SIGN CODE	WIDTH (IN)	HEIGHT (IN)	SHEETING REMARKS	SIGN LEGEND	NEW SIGNS		EXISTING SIGNS			EXIST POST		NUMBER OF NEW POSTS	SQUARE STEEL (IN)			TUBULAR STEEL Ø (IN)				SIGN FRAME REQUIRED	REMARKS	SIGN DETAIL				
								"A"	"B"	RETAIN	SALVAGE FROM	SALVAGE TO	REMOVE	RETAIN		REMOVE	1.75	2.00	2.50	FOUNDATION	3.00	3.50			4.00	5.00	DETAIL IN SHS	DETAIL ON SHEET NUMBER	DETAIL ON STD SHEET NUMBER
																	(LB / FT)				(LB / FT)								
READSBORO VT 100							FY-FLUORESCENT YELLOW FYG-FLUORESCENT YELLOW GREEN															"SHS"-STANDARD HIGHWAY SIGNS							
NB	2.224	A	D2-1	72	12			6.00																5					
		A	M3-1	24	12			2.00															X						
		A	M1-5	30	24			5.00																	E-136B				
NB	2.244	A	D2-1	72	10		READSBORO 5					1																	
		A	D2-1	72	10		JACKSONVILLE 14					1																	
NB	4.020	A	N/A	N/A	N/A		EMPTY POST																						
		A	VD-018	30	18			3.75						1		X									E-128A				
NB	4.260	D	R1-1	30	30		STOP					1												HOWE POND RD TH-4					
NB	4.930	C	VM-607	24	30		MEMORIAL HIGHWAY			1																			
NB	5.002	A	OM-3R	12	36							1																	
		A	OM-3R	12	36			3.00						1		X							X						
NB	5.032	B	OM-3L	12	36							1																	
		B	OM-3L	12	36			3.00						1		X								X					
NB	5.757	A	W1-2L	30	30		LEFT CURVE					1																	
		A	W13-1	18	18		35 MPH PLAQUE					1																	
SIGN SUMMARY SHEET							SHEET TOTALS	22.75	0.00	1	0	0	7	0	0	3	45					PROJECT NAME: Stamford-Andover VT100							
								SF	SF	EA	EA	EA	EA	EA	EA	EA	FT					PROJECT NUMBER: STPG SIGN(20)							
VERMONT AGENCY OF TRANSPORTATION							TOWN TOTALS	408.4	0.0	34.0	3.0	3.0	84	0.0	2.0	64	960.0					FILE NAME: Readsboro.xls	PLOT DATE: 8/5/2009						
																					PROJECT MANAGER: N. Averb	DRAWN BY: T. Guazzoni							
																					DESIGNED BY: J. Kelly	CHECKED BY: T. Guazzoni							
																					READSBORO SHEET 5	SHEET 26 OF 198							




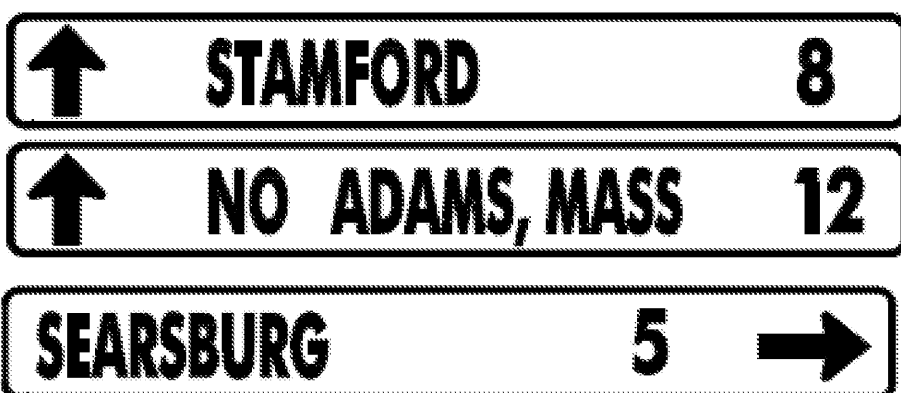
DIRECTION	MILEPOINT	LOCATION CODE (SHEET 2)	SIGN CODE	WIDTH (IN)	HEIGHT (IN)	SHEETING REMARKS	SIGN LEGEND	NEW SIGNS		EXISTING SIGNS			EXIST POST		NUMBER OF NEW POSTS	SQUARE STEEL (IN)			TUBULAR STEEL Ø (IN)				SIGN FRAME REQUIRED	REMARKS	SIGN DETAIL				
								"A"	"B"	RETAIN	SALVAGE FROM	SALVAGE TO	REMOVE	RETAIN		REMOVE	1.75	2.00	2.50	FOUNDATION	3.00	3.50			4.00	5.00	DETAIL IN SHS	DETAIL ON SHEET NUMBER	DETAIL ON STD SHEET NUMBER
																	(LB / FT)				(LB / FT)								
READSBORO VT 100							FY-FLUORESCENT YELLOW FYG-FLUORESCENT YELLOW GREEN															"SHS"-STANDARD HIGHWAY SIGNS							
NB	5.809	A	W1-2L	30	30	FY		6.25							1	X							INSTALL 275 FEET NORTH OF EXISTING SIGNS	X					
		A	W13-1	18	18	FY		2.25																X					
NB	5.872	A	W1-6	48	24						1																		
		A	OM1-1	18	18			9 BALL CLUSTER				1																	
		A	W1-6	48	24	FY		8.00								2	X							X					
NB	5.874	B	W1-6	48	24						1		X																
		B	OM1-1	18	18			9 BALL CLUSTER				1																	
		B	W1-6	48	24	FY		8.00								2	X							FACES SB TRAFFIC	X				
NB	5.905	A	W1-6	48	24	FY	 BR #23	8.00							2	X							BRIDGE PLAQUE SALVAGED TO NEW POST	X					
NB	5.907	B	W1-6	48	24						1		X																
		B	W1-6	48	24	FY		8.00								2	X							FACES SB TRAFFIC	X				
NB	6.210	A	W3-5	36	36		SPEED REDUCTION (40)			1			X																
NB	6.302	A	S3-1	30	30						1		X																
		A	S3-1	30	30			6.25								1	X							X					
NB	6.350	A	R2-1	24	30		SPEED LIMIT 40				1		X																
SIGN SUMMARY SHEET							SHEET TOTALS	46.75	0.00	1	0	0	7	0	0	10	150					PROJECT NAME: Stamford-Andover VT100							
VERMONT AGENCY OF TRANSPORTATION							TOWN TOTALS	408.4	0.0	34.0	3.0	3.0	84	0.0	2.0	64	960.0					PROJECT NUMBER: STPG SIGN(20)	FILE NAME: Readsboro.xls	PLOT DATE: 8/5/2009					
								SF	SF	EA	EA	EA	EA	EA	EA	EA	FT					DESIGNED BY: J. Kelly	DRAWN BY: T. Guazzoni	CHECKED BY: T. Guazzoni					
																						READSBORO SHEET 6	SHEET 27	OF 198					

DIRECTION	MILEPOINT	LOCATION CODE (SHEET 2)	SIGN CODE	WIDTH (IN)	HEIGHT (IN)	SHEETING REMARKS	SIGN LEGEND	NEW SIGNS		EXISTING SIGNS			EXIST POST		NUMBER OF NEW POSTS	SQUARE STEEL (IN)			TUBULAR STEEL Ø (IN)				SIGN FRAME REQUIRED	REMARKS	SIGN DETAIL				
								"A"	"B"	RETAIN	SALVAGE FROM	SALVAGE TO	REMOVE	RETAIN		REMOVE	1.75	2.00	2.50	FOUNDATION	3.00	3.50			4.00	5.00	DETAIL IN SHS	DETAIL ON SHEET NUMBER	DETAIL ON STD SHEET NUMBER
																	(LB / FT)				(LB / FT)								
READSBORO VT 100							FY-FLUORESCENT YELLOW FYG-FLUORESCENT YELLOW GREEN															"SHS"-STANDARD HIGHWAY SIGNS							
NB	6.350	A	R2-1	30	36			7.50						1	X										6				
NB	6.440	A	W3-5	36	36		SPEED REDUCTION (25)			1																			
NB	6.500	A	VD-018	30	18		VILLAGE SIGN			1																			
NB	6.550	A	VR-038	24	12		STATE HIGHWAY ENDS			1																			
		A	R2-1	30	36		SPEED LIMIT 25			1																			
CLASS 1 PORTION OF HIGHWAY																													
NB	7.072	C	VR-017	24	30			5.00						1	X											TUNNEL ST TH-2	E-141		
NB	7.080	D	R1-1	30	30					1	2	2															TUNNEL ST TH-2		
NB	7.090	A	VR-039	24	12		STATE HIGHWAY BEGINS			1																			
		B	VR--038	24	12		STATE HIGHWAY ENDS			1																			
NB	7.123	A	S1-1YG	30	30		SCHOOL PENTAGON			1																			
		A	W16-7YG	24	12		DOWN LEFT HAND ARROW			1																			
NB	7.150	A	R2-1	24	30		SPEED LIMIT 40			1																			
NB	7.221	C	VR-017	24	30			5.00						1	X												TH-4, DEPOT ST	E-141	
NB	7.226	D	R1-1	30	30		STOP				1	1															TH-4, DEPOT ST. RETAIN SIGN AND REPLACE POST		
SIGN SUMMARY SHEET							SHEET TOTALS	17.50	0.00	10	3	3	0	0	0	4	60						PROJECT NAME: Stamford-Andover VT100						
VERMONT AGENCY OF TRANSPORTATION							TOWN TOTALS	408.4	0.0	34.0	3.0	3.0	84	0.0	2.0	64	960.0						PROJECT NUMBER: STPG SIGN(20)						
								SF	SF	EA	EA	EA	EA	EA	EA	EA	FT					FILE NAME: Readsboro.xls	PLOT DATE: 8/5/2009						
																					PROJECT MANAGER: N. Averb	DRAWN BY: T. Guazzoni							
																					DESIGNED BY: J. Kelly	CHECKED BY: T. Guazzoni							
																					READSBORO SHEET 7	SHEET 28 OF 198							

DIRECTION	MILEPOINT	LOCATION CODE (SHEET 2)	SIGN CODE	WIDTH (IN)	HEIGHT (IN)	SHEETING REMARKS	SIGN LEGEND	NEW SIGNS		EXISTING SIGNS			EXIST POST		NUMBER OF NEW POSTS	SQUARE STEEL (IN)			TUBULAR STEEL Ø (IN)				SIGN FRAME REQUIRED	REMARKS	SIGN DETAIL			
								"A"	"B"	RETAIN	SALVAGE FROM	SALVAGE TO	REMOVE	RETAIN		REMOVE	1.75	2.00	2.50	3.00	3.50	4.00			5.00	DETAIL IN SHS	DETAIL ON SHEET NUMBER	DETAIL ON STD SHEET NUMBER
																	(LB / FT)			(LB / FT)								
READSBORO VT 100							FY-FLUORESCENT YELLOW FYG-FLUORESCENT YELLOW GREEN															"SHS"-STANDARD HIGHWAY SIGNS						
NB	7.236	C	VR-017	24	30			5.00						1	X								TH-46, JARVIS HILL			E-141		
NB	7.244	D	R1-1	30	30	STOP	 JARVIS HILL RD VERMONT ROUTE 100		1	2	2												STREET SIGNS SALVAGED ONTO THE NEW POST.	TH-46, JARVIS HILL				
NB	7.270	A	M3-1	24	12			2.00						1	X								INSTALL ACROSS FROM SOUTH BOUND VILLAGE SIGN. GREEN ON WHITE SHEETING	X				
		A	M1-5	30	24			5.00																		E-136B		
NB	7.350	A	R2-1	24	30	SPEED LIMIT 50			1																			
NB	7.820	A	W3-5	36	36	SPEED REDUCTION (40)			1																			
NB	7.900	A	R2-1	30	36	SPEED LIMIT 40			1																			
SB	7.900	F	R2-1	24	30	SPEED LIMIT 50			1																			
SB	7.450	F	W3-5	36	36	SPEED REDUCTION (40)			1																			
SB	7.350	F	R2-1	30	36	SPEED LIMIT 40				1	1					1	X											
SB	7.310	F	W3-5	36	36	SPEED REDUCTION (25)			1																			
SB	7.270	F	VD-018	30	18	VILLAGE SIGN				1	1					1	1	X										
SB	7.226	F	S1-1YG	30	30	SCHOOL PENTAGON			1																			
		F	W16-9YG	24	12	AHEAD			1																			
SB	7.150	F	R2-1	30	36	SPEED LIMIT 25			1																			
SIGN SUMMARY SHEET							SHEET TOTALS	12.00	0.00	10	4	4	0	0	2	4	60						PROJECT NAME: Stamford-Andover VT100					
VERMONT AGENCY OF TRANSPORTATION							TOWN TOTALS	408.4	0.0	34.0	3.0	3.0	84	0.0	2.0	64	960.0					PROJECT NUMBER: STPG SIGN(20)	FILE NAME: Readsboro.xls	PLOT DATE: 8/5/2009				
								SF	SF	EA	EA	EA	EA	EA	EA	EA	FT					PROJECT MANAGER: N. Avery	DRAWN BY: T. Guazzoni					
																					DESIGNED BY: J. Kelly	CHECKED BY: T. Guazzoni						
																						READSBORO SHEET 8	SHEET 29 OF 198					



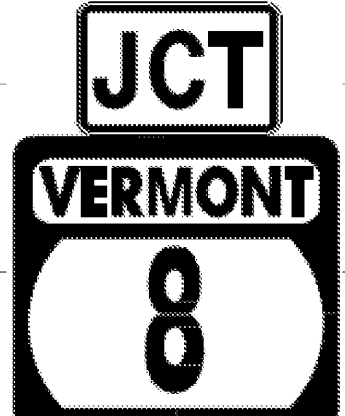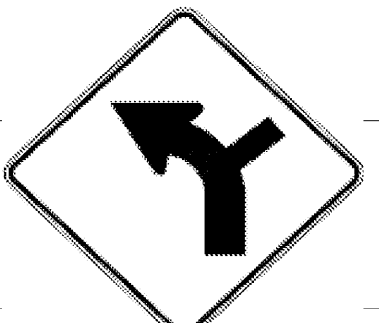




DIRECTION	MILEPOINT	LOCATION CODE (SHEET 2)	SIGN CODE	WIDTH (IN)	HEIGHT (IN)	SHEETING REMARKS	SIGN LEGEND	NEW SIGNS		EXISTING SIGNS				EXIST POST		NUMBER OF NEW POSTS	SQUARE STEEL (IN)			TUBULAR STEEL Ø (IN)				SIGN FRAME REQUIRED	REMARKS	SIGN DETAIL		
								"A"	"B"	RETAIN	SALVAGE FROM	SALVAGE TO	REMOVE	RETAIN	REMOVE		1.75	2.00	2.50	3.00	3.50	4.00	5.00			DETAIL IN SHS	DETAIL ON SHEET NUMBER	DETAIL ON STD SHEET NUMBER
																	(LB / FT)			(LB / FT)								
READSBORO VT 100							FY-FLUORESCENT YELLOW FYG-FLUORESCENT YELLOW GREEN															"SHS"-STANDARD HIGHWAY SIGNS						
SB	7.138	G	VR-017	24	30																							
		G	VR-017	24	30			5.00		2	2															E-141		
SB	7.130	H	R1-1	30	30																							
		H	R1-1	30	30			6.25		1	1	1												X				
SB	7.126	F	S1-1YG	30	30		SCHOOL PENTAGON																					
		F	W16-7YG	24	12		LEFT HAND DOWN ARROW																					
SB	7.080	G	VR-017	24	30			5.00		1	1																	
																												
SB	7.072	H	R1-1	30	30																							
		H	R1-1	30	30			6.25		2	2	1												X				
CLASS 1 PORTION OF HIGHWAY																												
SB	6.550	F	VR-039	24	12		STATE HIGHWAY BEGINS																					
		F	R2-1	24	30		SPEED LIMIT 40																					
SB	6.529	F	S3-1	30	30																							
		F	S3-1	30	30			6.25																X				
SB	6.350	F	R2-1	24	30		SPEED LIMIT 50																					
SIGN SUMMARY SHEET							SHEET TOTALS	28.75	0.00	5	6	6	4	0	0	5	75						PROJECT NAME: Stamford-Andover VT100					
VERMONT AGENCY OF TRANSPORTATION							TOWN TOTALS	408.4	0.0	34.0	3.0	3.0	84	0.0	2.0	64	960.0						PROJECT NUMBER: STPG SIGN(20)					
								SF	SF	EA	EA	EA	EA	EA	EA	EA	FT						FILE NAME: Readsboro.xls					
																							PLOT DATE: 8/5/2009					
																							DRAWN BY: T. Guazzoni					
																							DESIGNED BY: J. Kelly					
																							CHECKED BY: T. Guazzoni					
																							SHEET 30 OF 198					




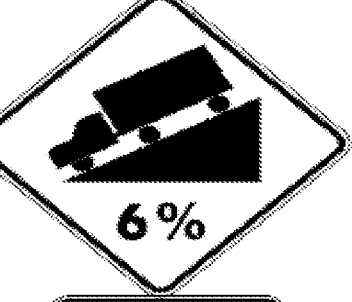

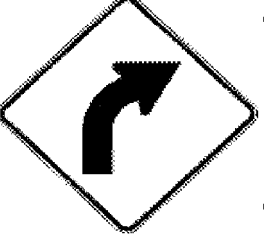
DIRECTION	MILEPOINT	LOCATION CODE (SHEET 2)	SIGN CODE	WIDTH (IN)	HEIGHT (IN)	SHEETING REMARKS	SIGN LEGEND	NEW SIGNS		EXISTING SIGNS			EXIST POST		NUMBER OF NEW POSTS	SQUARE STEEL (IN)			TUBULAR STEEL Ø (IN)				SIGN FRAME REQUIRED	REMARKS	SIGN DETAIL							
								"A"	"B"	RETAIN	SALVAGE FROM	SALVAGE TO	REMOVE	RETAIN		REMOVE	1.75	2.00	2.50	FOUNDATION	3.00	3.50			4.00	5.00	DETAIL IN SHS	DETAIL ON SHEET NUMBER	DETAIL ON STD SHEET NUMBER			
																	(LB / FT)				(LB / FT)											
READSBORO VT 100							FY-FLUORESCENT YELLOW FYG-FLUORESCENT YELLOW GREEN															"SHS"-STANDARD HIGHWAY SIGNS										
SB	6.144	F	W1-2R	30	30		RIGHT CURVE																									
		F	W13-1	18	18		35 MPH PLAQUE																									
SB	6.059	F	W1-2R	30	30	FY		6.25																				INSTALL 450 FEET SOUTH OF EXISTING RIGHT CURVE	X			
		F	W13-1	18	18	FY		2.25																						X		
SB	5.039	F	OM-3R	12	36																											
		F	OM-3R	12	36			3.00																							X	
SB	5.004	E	OM-3L	12	36																											
		E	OM-3L	12	36			3.00																								X
SB	4.359	F	VD-018	30	18																											
		F	VD-018	30	18			3.75																							E-128A	
SB	3.710	F	S3-1	30	30																											SIGN ALREADY REMOVED PRIOR TO PROJECT.
		F	S3-1	30	30			6.25																								INSTALL 500 FEET NORTH OF BAILEY HILL ROAD INTERSECTION
SB	3.624	G	VR-017	24	30		LEGAL LOAD LIMIT 24,000 LBS																									TH-29, BAILEY HILL RD
SB	3.616	H	R1-1	30	30		STOP 																									TH-29, BAILEY HILL RD
SB	2.338	F	W1-2L	30	30		LEFT CURVE																									
SIGN SUMMARY SHEET							SHEET TOTALS	24.50	0.00	2	0	0	6	0	0	5	75					PROJECT NAME: Stamford-Andover VT100										
								SF	SF	EA	EA	EA	EA	EA	EA	EA	FT					PROJECT NUMBER: STPG SIGN(20)										
VERMONT AGENCY OF TRANSPORTATION							TOWN TOTALS	408.4	0.0	34.0	3.0	3.0	84	0.0	2.0	64	960.0					FILE NAME: Readsboro.xls	PLOT DATE: 8/5/2009									
																						PROJECT MANAGER: N. Avery	DRAWN BY: T. Guazzoni									
																						DESIGNED BY: J. Kelly	CHECKED BY: T. Guazzoni									
																						READSBORO SHEET 10	SHEET 31 OF 198									



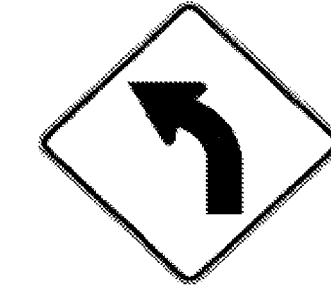
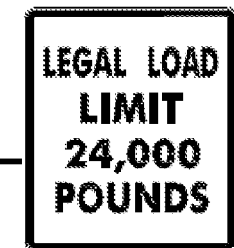



DIRECTION	MILEPOINT	LOCATION CODE (SHEET 2)	SIGN CODE	WIDTH (IN)	HEIGHT (IN)	SHEETING REMARKS	SIGN LEGEND	NEW SIGNS		EXISTING SIGNS				EXIST POST		NUMBER OF NEW POSTS	SQUARE STEEL (IN)			TUBULAR STEEL Ø (IN)				SIGN FRAME REQUIRED	REMARKS	SIGN DETAIL		
								"A"	"B"	RETAIN	SALVAGE FROM	SALVAGE TO	REMOVE	RETAIN	REMOVE		1.75	2.00	2.50	3.00	3.50	4.00	5.00			DETAIL IN SHS	DETAIL ON SHEET NUMBER	DETAIL ON STD SHEET NUMBER
																	(LB / FT)			(LB / FT)								
READSBORO VT 100							FY-FLUORESCENT YELLOW FYG-FLUORESCENT YELLOW GREEN															"SHS"-STANDARD HIGHWAY SIGNS						
			F W13-1	18	18		40 MPH PLAQUE 					1																
			F M2-1	21	15			2.19						1		X							GREEN ON WHITE SHEETING	X				
			F M1-5	24	24			4.00																		E-136B		
SB	2.294		F M2-1S	21	15		JCT					1			X													
			F M1-5	24	24		VT 8 					1																
			F W1-10L	30	30			6.25						1		X								X				
			F W13-1	18	18			2.25																X				
SB	2.242		F D1-1A	72	10							1																
			F D1-1M	72	10							1																
			F D1-1A	72	10							1																
			F D1-1A	72	12			6.00						2		X										5		
			F D1-1A	72	12			6.00																		5		
			F D1-1A	72	12			6.00																		5		
SB	2.207		F M3-3S	24	12							1			X													
			F M1-5	30	24							1																
SIGN SUMMARY SHEET							SHEET TOTALS	32.69	0.00	0	0	0	8	0	0	4	60							PROJECT NAME: Stamford-Andover VT100				
								SF	SF	EA	EA	EA	EA	EA	EA	EA	FT							PROJECT NUMBER: STPG SIGN(20)				
VERMONT AGENCY OF TRANSPORTATION							TOWN TOTALS	408.4	0.0	34.0	3.0	3.0	84	0.0	2.0	64	960.0							FILE NAME: Readsboro.xls	PLOT DATE: 8/5/2009			
																								PROJECT MANAGER: N. Avery	DRAWN BY: T. Guazzoni			
																									DESIGNED BY: J. Kelly	CHECKED BY: T. Guazzoni		
																									READSBORO SHEET 11	SHEET 32 OF 198		








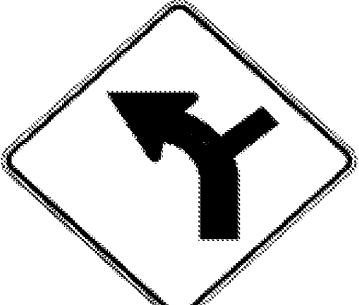
DIRECTION	MILEPOINT	LOCATION CODE (SHEET 2)	SIGN CODE	WIDTH (IN)	HEIGHT (IN)	SHEETING REMARKS	SIGN LEGEND	NEW SIGNS		EXISTING SIGNS				EXIST POST		NUMBER OF NEW POSTS	SQUARE STEEL (IN)			TUBULAR STEEL Ø (IN)				SIGN FRAME REQUIRED	REMARKS	SIGN DETAIL			
								"A"	"B"	RETAIN	SALVAGE FROM	SALVAGE TO	REMOVE	RETAIN	REMOVE		1.75	2.00	2.50	FOUNDATION	3.00	3.50	4.00			5.00	DETAIL IN SHS	DETAIL ON SHEET NUMBER	DETAIL ON STD SHEET NUMBER
																	(LB / FT)				(LB / FT)								
READSBORO VT 100							FY-FLUORESCENT YELLOW FYG-FLUORESCENT YELLOW GREEN															"SHS"-STANDARD HIGHWAY SIGNS							
			F M6-3S	21	15																								
			F M3-3S	24	12																								
			F M1-5	24	24																								
			F M4-5S	24	12																								
			F M1-5	21	15																								
			F M6-1S	21	15																								
			F M3-1S	24	12																								
			F M1-5	24	24																								
			F M6-1S	21	15																								
			F M3-3	24	12				2.00												#3A	GREEN ON WHITE SHEETING	X	7					
			F M1-5	30	24				5.00																E-136B				
			F M6-3	21	15				2.19																				
			F M3-3	24	12				2.00																				
			F M1-5	24	24				4.00																	E-136B			
			F M6-3	21	15				2.19																				
SIGN SUMMARY SHEET								SHEET TOTALS			17.38	0.00	0	0	0	9	0	0	0	0									
								SF	SF	EA	EA	EA	EA	EA	EA	EA	EA	EA	FT										
VERMONT AGENCY OF TRANSPORTATION								TOWN TOTALS			408.4	0.0	34.0	3.0	3.0	84	0.0	2.0	64	960.0									
																				PROJECT NAME: Stamford-Andover VT100									
																				PROJECT NUMBER: STPG SIGN(20)									
															FILE NAME: Readsboro.xls	PLOT DATE: 8/5/2009													
															PROJECT MANAGER: N. Avery	DRAWN BY: T. Guazzoni													
															DESIGNED BY: J. Kelly	CHECKED BY: T. Guazzoni													
															READSBORO SHEET 12	SHEET 33 OF 198													

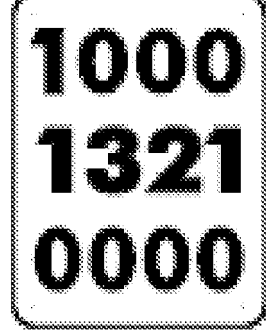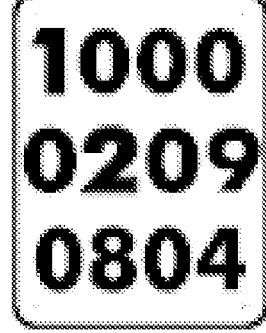



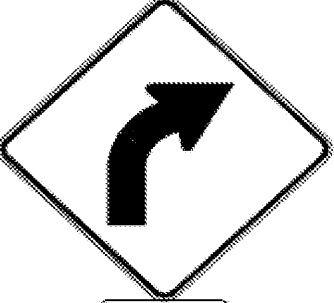


DIRECTION	MILEPOINT	LOCATION CODE (SHEET 2)	SIGN CODE	WIDTH (IN)	HEIGHT (IN)	SHEETING REMARKS	SIGN LEGEND	NEW SIGNS		EXISTING SIGNS				EXIST POST		NUMBER OF NEW POSTS	SQUARE STEEL (IN)			TUBULAR STEEL Ø (IN)				SIGN FRAME REQUIRED	REMARKS	SIGN DETAIL		
								"A"	"B"	RETAIN	SALVAGE FROM	SALVAGE TO	REMOVE	RETAIN	REMOVE		(LB / FT)			(LB / FT)						DETAIL IN SHS	DETAIL ON SHEET NUMBER	DETAIL ON STD SHEET NUMBER
																	1.75	2.00	2.50	3.00	3.50	4.00	5.00					
READSBORO VT 100							FY-FLUORESCENT YELLOW FYG-FLUORESCENT YELLOW GREEN															"SHS"-STANDARD HIGHWAY SIGNS						
			F	M4-5	24	12		2.00																GREEN ON WHITE SHEETING	X			
			F	M1-5	21	15		4.00																		E-136B		
			F	M6-1R	21	15		2.19																GREEN ON WHITE SHEETING	X			
			F	M3-1	24	12		2.00																GREEN ON WHITE SHEETING	X			
			F	M1-5	24	24		4.00																		E-136B		
			F	M6-1R	21	15		2.19																GREEN ON WHITE SHEETING	X			
SB	2.153		F	M3-3	24	12						1																
			F	M1-5	24	24						1																
			F	M3-3S	24	12						1																
			F	M1-5	30	24						1																
			F	M3-3	24	12	2.00							2		X					#1A	MAINTAIN 10 FEET CLEARANCE FROM UTILITY POLE. GREEN ON WHITE SHEETING	X	7				
			F	M1-5	24	24	4.00																		E-136B			
			F	M3-3	24	12	2.00																GREEN ON WHITE SHEETING	X				
			F	M1-5	30	24	5.00																		E-136B			
SB	2.112		F	D2-1	72	12	STAMFORD					1																
SIGN SUMMARY SHEET							SHEET TOTALS		29.38	0.00	1	0	0	4	0	0	2	30			PROJECT NAME: Stamford-Andover VT100							
							SF	SF	EA	EA	EA	EA	EA	EA	EA	EA	EA	FT			PROJECT NUMBER: STPG SIGN(20)							
VERMONT AGENCY OF TRANSPORTATION							TOWN TOTALS		408.4	0.0	34.0	3.0	3.0	84	0.0	2.0	64	960.0			FILE NAME: Readsboro.xls							
																					PLOT DATE: 8/5/2009							
																					DRAWN BY: T. Guazzoni							
																					DESIGNED BY: J. Kelly							
																					CHECKED BY: T. Guazzoni							
																					SHEET 34 OF 198							

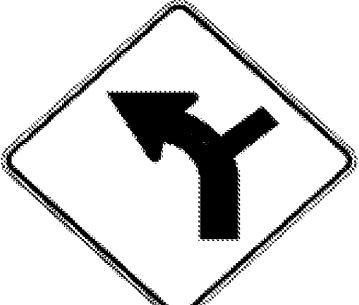

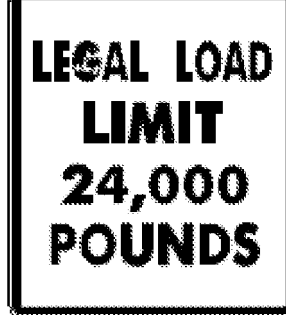
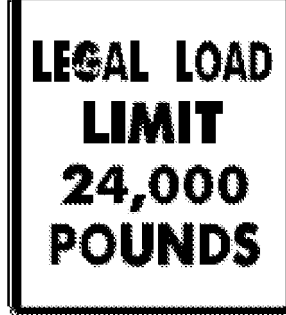







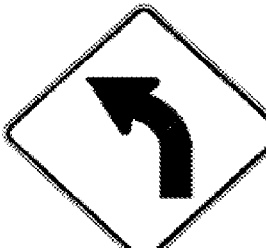
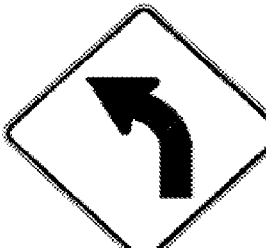
DIRECTION	MILEPOINT	LOCATION CODE (SHEET 2)	SIGN CODE	WIDTH (IN)	HEIGHT (IN)	SHEETING REMARKS	SIGN LEGEND	NEW SIGNS		EXISTING SIGNS			EXIST POST		NUMBER OF NEW POSTS	SQUARE STEEL (IN)			TUBULAR STEEL Ø (IN)				SIGN FRAME REQUIRED	REMARKS	SIGN DETAIL			
								"A"	"B"	RETAIN	SALVAGE FROM	SALVAGE TO	REMOVE	RETAIN		REMOVE	1.75	2.00	2.50	3.00	3.50	4.00			5.00	DETAIL IN SHS	DETAIL ON SHEET NUMBER	DETAIL ON STD SHEET NUMBER
																	(LB / FT)			(LB / FT)								
READSBORO VT 100							FY-FLUORESCENT YELLOW FYG-FLUORESCENT YELLOW GREEN															"SHS"-STANDARD HIGHWAY SIGNS						
			F D2-1	72	12		NO ADAMS MA			1																		
			F VD-018	30	18		ADD "E" TO WORD 					+		*										OLD SIGN WAS MISSING				
SB	2.073		F VD-018	30	18			3.75							1		X								E-128A			
SB	2.068		E W1-6	48	24										1		X											
			E W1-6	48	24			8.00							2		X						X					
SB	2.054		G VR-017	24	30										1		X							OLD COUNTY LANE TH-35, HEARTWELLVILLE RD-			E-141	
			G VR-017	24	30			5.00							1		X											
SB	2.054		H R1-1	30	30										1		X							OLD COUNTY LANE TH-35, HEARTWELLVILLE RD				
			H R1-1	30	30			6.25							1		X							X				
SB	1.573		F W1-2L	30	30										1		X											
			F W1-2L	30	30			6.25							1		X							X				
SB	1.488		G VR-017	24	30										1		X							TH-36, WILLIAMS RD (NORTH)			E-141	
			G VR-017	24	30			5.00							1		X											
SB	1.480		H R1-1	30	30										1		X							TH-36, WILLIAMS RD (NORTH)				
			H R1-1	30	30			6.25							1		X							X				
SIGN SUMMARY SHEET							SHEET TOTALS	40.50	0.00	1	0	0	6	7	0	0	8	120						PROJECT NAME: Stamford-Andover VT100				
								SF	SF	EA	EA	EA	EA	EA	EA	EA	EA	EA	EA	EA	EA	EA		PROJECT NUMBER: STPG SIGN(20)				
VERMONT AGENCY OF TRANSPORTATION							TOWN TOTALS	408.4	0.0	34.0	3.0	3.0	84	0.0	2.0	64	960.0						FILE NAME: Readsboro.xls	PLOT DATE: 8/5/2009				
																						PROJECT MANAGER: N. Averv	DRAWN BY: T. Guazzoni					
																						DESIGNED BY: J. Kelly	CHECKED BY: T. Guazzoni					
																						READSBORO SHEET 14	SHEET 35	OF	198			




DIRECTION	MILEPOINT	LOCATION CODE (SHEET 2)	SIGN CODE	WIDTH (IN)	HEIGHT (IN)	SHEETING REMARKS	SIGN LEGEND	NEW SIGNS		EXISTING SIGNS			EXIST POST		NUMBER OF NEW POSTS	SQUARE STEEL (IN)			TUBULAR STEEL Ø (IN)				SIGN FRAME REQUIRED	REMARKS	SIGN DETAIL				
								"A"	"B"	RETAIN	SALVAGE FROM	SALVAGE TO	REMOVE	RETAIN		REMOVE	1.75	2.00	2.50	FOUNDATION	3.00	3.50			4.00	5.00	DETAIL IN SHS	DETAIL ON SHEET NUMBER	DETAIL ON STD SHEET NUMBER
																	(LB / FT)				(LB / FT)								
READSBORO VT 100							FY-FLUORESCENT YELLOW FYG-FLUORESCENT YELLOW GREEN															"SHS"-STANDARD HIGHWAY SIGNS							
SB	1.386	G	VR-017	24	30																		TH-36, WILLIAMS RD (SOUTH)						
		G	VR-017	24	30			5.00										X								E-141			
SB	1.377	H	R1-1	30	30																		TH-36, WILLIAMS RD (SOUTH)						
		H	R1-1	30	30			6.25										X						X					
SB	1.176	F	VW-054R	30	30		HIDDEN DRIVE RIGHT			1																			
		F	S3-1	30	30		SCHOOL BUS STOP AHEAD			1																			
SB	0.995	F	W7-1b	30	30			6.25										X						INSTALL 50 FEET SOUTH OF END OF GUARD RAIL	X				
		F	W7-3a	24	18			3.00																X					
SB	0.737	F	W1-2R	30	30			6.25										X						INSTALL 300 FEET NORTH OF GUARD RAIL SECTION (ON INSIDE OF DOWNHILL CURVE)	X				
SIGN SUMMARY SHEET							SHEET TOTALS	26.75	0.00	2	0	0	2	0	0	4	60					PROJECT NAME: Stamford-Andover VT100							
VERMONT AGENCY OF TRANSPORTATION							TOWN TOTALS	408.4	0.0	34.0	3.0	3.0	84	0.0	2.0	64	960.0					PROJECT NUMBER: STPG SIGN(20)							
								SF	SF	EA	EA	EA	EA	EA	EA	EA	FT					FILE NAME: Readsboro.xls	PLOT DATE: 8/5/2009						
																						PROJECT MANAGER: N. Avery	DRAWN BY: T. Guazzoni						
																						DESIGNED BY: J. Kelly	CHECKED BY: T. Guazzoni						
																						READSBORO SHEET 15	SHEET 36 OF 198						

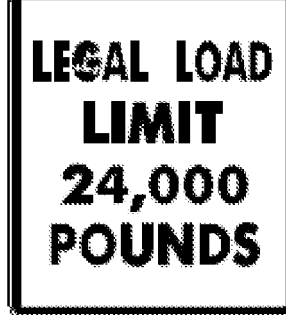
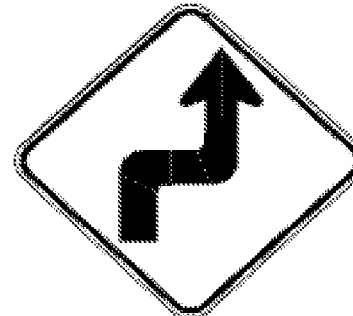


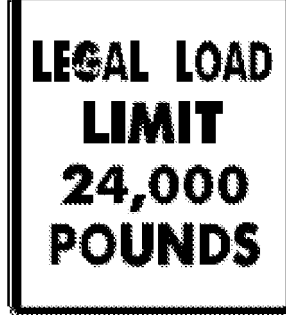

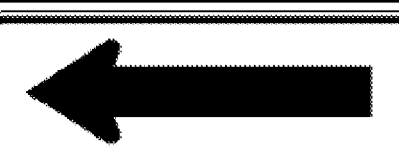
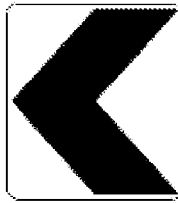
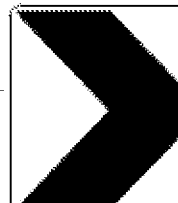
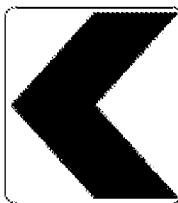
DIRECTION	MILEPOINT	LOCATION CODE (SHEET 2)	SIGN CODE	WIDTH (IN)	HEIGHT (IN)	SHEETING REMARKS	SIGN LEGEND	NEW SIGNS		EXISTING SIGNS			EXIST POST		NUMBER OF NEW POSTS	SQUARE STEEL (IN)			TUBULAR STEEL Ø (IN)				SIGN FRAME REQUIRED	REMARKS	SIGN DETAIL				
								"A"	"B"	RETAIN	SALVAGE FROM	SALVAGE TO	REMOVE	RETAIN		REMOVE	1.75	2.00	2.50	FOUNDATION	3.00	3.50			4.00	5.00	DETAIL IN SHS	DETAIL ON SHEET NUMBER	DETAIL ON STD SHEET NUMBER
																	(LB / FT)				(LB / FT)								
WHITINGHAM VT 100							FY-FLUORESCENT YELLOW FYG-FLUORESCENT YELLOW GREEN															"SHS"-STANDARD HIGHWAY SIGNS							
NB	0.000	C	VD-024	72	10			5.00						2	X								INSTALL NEW ASSEMBLY 200 FEET SOUTH OF EXISTING ASSEMBLY		4				
		C	VD-025	72	10			5.00															WHITE MARK ON PAVEMENT AT LOCATION OF NEW SIGN		4				
		C	VD-700	6	10			0.42															INSTALL BELOW WHITINGHAM			E-138			
		C	VD-700	6	10			0.42															INSTALL BELOW READSBORO			E-138			
NB	0.038	C	VD-024	60	7.5		WHITINGHAM/READSBORO TOWN LINE					1																	
		C	VD-025	60	7.5		WINDHAM CO/ BENNINGTON CO					1																	
NB	0.173	A	W1-6	48	24							1																	
		A	OM1-1	18	18		YELLOW CLUSTER					1																	
		B	W1-6	48	24							1																	
		B	OM1-1	18	18		YELLOW CLUSTER					1																	
		A	W1-6	48	24	FY		8.00						2	X									X					
		B	W1-6	48	24	FY		8.00						2	X								FACES SB TRAFFIC	X					
NB	0.193	A	R2-1	24	30		SPEED LIMIT 40					1																	
NB	0.223	A	N/A	18	24		TOWN SIGN 					1											ILLEGAL TOWN SIGN. RETURN TO TOWN						
NB	0.268	A	OM-3R	12	36			3.00						1	X									X					
SIGN SUMMARY SHEET							SHEET TOTALS	29.84	0.00	0	0	0	9	0	0	7	105					PROJECT NAME: Stamford-Andover VT100							
VERMONT AGENCY OF TRANSPORTATION							TOWN TOTALS	1058.3	0.0	40.0	13.0	13.0	220	0.0	0.0	193	2895.0					PROJECT NUMBER: STPG SIGN(20)	FILE NAME: Whitinham.xls	PLOT DATE: 8/5/2009					
								SF	SF	EA	EA	EA	EA	EA	EA	EA	FT					PROJECT MANAGER: N. Avery	DRAWN BY: I. Shea						
																						DESIGNED BY: J. Kelly	CHECKED BY: T. Guazzoni						
																						WHITINGHAM SHEET 1	SHEET 37 OF 198						

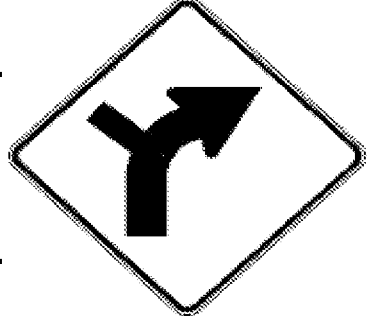

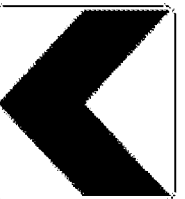

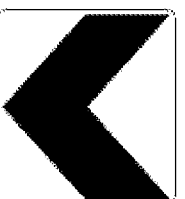
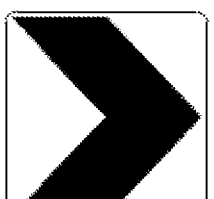
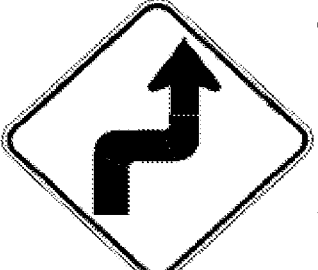

DIRECTION	MILEPOINT	LOCATION CODE (SHEET 2)	SIGN CODE	WIDTH (IN)	HEIGHT (IN)	SHEETING REMARKS	SIGN LEGEND	NEW SIGNS		EXISTING SIGNS				EXIST POST		NUMBER OF NEW POSTS	SQUARE STEEL (IN)			TUBULAR STEEL Ø (IN)				SIGN FRAME REQUIRED	REMARKS	SIGN DETAIL		
								"A"	"B"	RETAIN	SALVAGE FROM	SALVAGE TO	REMOVE	RETAIN	REMOVE		(LB / FT)			(LB / FT)						DETAIL IN SHS	DETAIL ON SHEET NUMBER	DETAIL ON STD SHEET NUMBER
																	1.75	2.00	2.50	3.00	3.50	4.00	5.00					
WHITINGHAM VT 100							FY-FLUORESCENT YELLOW FYG-FLUORESCENT YELLOW GREEN															"SHS"-STANDARD HIGHWAY SIGNS						
NB	0.273	B	OM-3L	12	36			3.00							1		X							X				
NB	0.313	A	R2-1	24	30		SPEED LIMIT 40 						1															
NB	0.408	A	R2-1	24	30			5.00						1		X								INSTALL 500 FEET NORTH OF EXISTING SPEED LIMIT 40 SIGN	X			
NB	0.600	A	W1-1R	30	30		RIGHT TURN 						1			X												
		A	W13-1	18	18		30 MPH PLAQUE 						1															
NB	0.648	A	W1-2R	30	30			6.25						1		X								INSTALL 250 FEET NORTH OF EXISTING RIGHT TURN SIGN	X			
		A	W13-1	18	18			2.25																X				
NB	0.920	A	S3-1	30	30		SCHOOL BUS STOP AHEAD 						1			X												
NB	0.970	A	R2-1	24	30								1			X												
		A	R2-1	24	30			5.00						1		X								X				
NB	1.098	A	W1-2L	30	30		LEFT CURVE 						1			X												
		A	W13-1	18	18		35 MPH PLAQUE 						1															
NB	1.114	A	W1-10L	30	30		LEFT CURVE W/RH SIDE ROAD 						1			X												
NB	1.196	A	W1-10L	30	30			6.25						1		X								INSTALL ASSEMBLY 250 FEET SOUTH OF INTERSECTION AND SOUTH OF UTILITY POLE	X			
		A	W13-1	18	18			2.25																X				
SIGN SUMMARY SHEET							SHEET TOTALS	30.00	0.00	0	0	0	8	0	0	5		75										
VERMONT AGENCY OF TRANSPORTATION								SF	SF	EA	EA	EA	EA	EA	EA	EA		FT										
							TOWN TOTALS	1058.3	0.0	40.0	13.0	13.0	220	0.0	0.0	193		2895.0										
																		PROJECT NAME:	Stamford-Andover VT100									
																		PROJECT NUMBER:	STPG SIGN(20)									
																		FILE NAME:	Whitingham.xls			PLOT DATE:	8/5/2009					
																		PROJECT MANAGER:	N. Avery			DRAWN BY:	I. Shea					
																		DESIGNED BY:	J. Kelly			CHECKED BY:	T. Guazzoni					
																		WHITINGHAM SHEET 2						SHEET	38	OF	198	







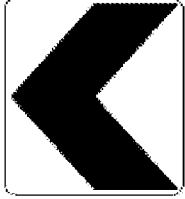




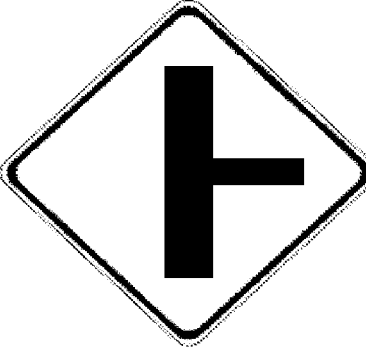
DIRECTION	MILEPOINT	LOCATION CODE (SHEET 2)	SIGN CODE	WIDTH (IN)	HEIGHT (IN)	SHEETING REMARKS	SIGN LEGEND	NEW SIGNS		EXISTING SIGNS			EXIST POST		NUMBER OF NEW POSTS	SQUARE STEEL (IN)			TUBULAR STEEL Ø (IN)				SIGN FRAME REQUIRED	REMARKS	SIGN DETAIL			
								"A"	"B"	RETAIN	SALVAGE FROM	SALVAGE TO	REMOVE	RETAIN		REMOVE	1.75	2.00	2.50	3.00	3.50	4.00			5.00	DETAIL IN SHS	DETAIL ON SHEET NUMBER	DETAIL ON STD SHEET NUMBER
																	(LB / FT)			(LB / FT)								
WHITINGHAM VT 100							FY-FLUORESCENT YELLOW FYG-FLUORESCENT YELLOW GREEN															"SHS"-STANDARD HIGHWAY SIGNS						
NB	1.235	B	W1-6	48	24			8.00							2		X							INSTALL ON SOUTH SIDE OF TH-38 FACING SOUTH BOUND TRAFFIC	X			
NB	1.237	C	VR-017	24	30							1			X									TH-38, MERRIFIELD RD				
		C	VR-017	24	30			5.00						1		X											E-141	
NB	1.245	D	N/A				EMPTY POST   																	OLD POST WAS REMOVED PRIOR TO THE PROJECT				
		D	R1-1	30	30			6.25						1		X							TH-38, MERRIFIELD RD	X				
NB	1.250	A	W1-6	48	24			8.00				1			X										X			
		A	W1-6	48	24									2		X												
NB	1.250	B	W1-6	48	24		RIGHT ARROW					1			X													
NB	1.710	A	W1-2L	30	30		LEFT CURVE					1			X													
		A	W13-1	18	18		35 MPH PLAQUE					1																
NB	1.793	A	W1-1ML	30	30		LEFT TURN W/SIDE ROAD					1			X													
		A	W13-1	18	18		30 MPH PLAQUE					1																
NB	1.853	A	S3-1	30	30		SCHOOL BUS STOP AHEAD 	6.25				1			X									THE OLD SIGN WAS REMOVED AND A NEW SIGN WAS INSTALLED SINCE IT IS A SCHOOL BUS STOP.				
		A	W1-1MdL	30	30			6.25						1		X								THESE TWO SIGNS WERE MOVED TO ANOTHER LOCATION DUE TO THE VISIBILITY PROBLEMS WITH UTILITY POLES.		6		
NB	1.836	A	W13-1	18	18			2.25																	X			
SIGN SUMMARY SHEET							SHEET TOTALS	42.00 35.75	0.00	0	1	1	9	0	0	7	105							PROJECT NAME: Stamford-Andover VT100				
VERMONT AGENCY OF TRANSPORTATION							TOWN TOTALS	1058.3	0.0	40.0	13.0	13.0	220	0.0	0.0	193	2895.0							PROJECT NUMBER: STPG SIGN(20)				
										EA	EA	EA	EA	EA	EA	EA	FT							FILE NAME: Whitinham.xls	PLOT DATE: 8/5/2009			
																								PROJECT MANAGER: N. Avery	DRAWN BY: I. Shea			
																								DESIGNED BY: J. Kelly	CHECKED BY: T. Guazzoni			
																								WHITINGHAM SHEET 3	SHEET 39 OF 198			






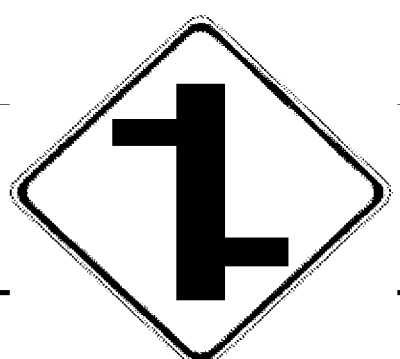



DIRECTION	MILEPOINT	LOCATION CODE (SHEET 2)	SIGN CODE	WIDTH (IN)	HEIGHT (IN)	SHEETING REMARKS	SIGN LEGEND	NEW SIGNS		EXISTING SIGNS			EXIST POST		NUMBER OF NEW POSTS	SQUARE STEEL (IN)			TUBULAR STEEL Ø (IN)				SIGN FRAME REQUIRED	REMARKS	SIGN DETAIL				
								"A"	"B"	RETAIN	SALVAGE FROM	SALVAGE TO	REMOVE	RETAIN		REMOVE	1.75	2.00	2.50	FOUNDATION	3.00	3.50			4.00	5.00	DETAIL IN SHS	DETAIL ON SHEET NUMBER	DETAIL ON STD SHEET NUMBER
																	(LB / FT)				(LB / FT)								
WHITINGHAM VT 100							FY-FLUORESCENT YELLOW FYG-FLUORESCENT YELLOW GREEN															"SHS"-STANDARD HIGHWAY SIGNS							
NB	1.943	B	W1-6	48	24		 	8.00							2		X							INSTALL ON SOUTH SIDE OF TH-39 FACING SB TRAFFIC	X				
NB	1.945	C	VR-017	24	30			5.00							1		X							TH-39, SHIPPEE RD			E-141		
NB	1.956	D	R1-1	30	30		  																						
NB	1.956	D	R1-1	30	30		  	6.25								1		X							TH-39, SHIPPEE RD	X			
NB	1.958	A	W1-6	48	24			8.00							2		X							INSTALL ON NORTH SIDE OF TH-39 FACING NB TRAFFIC	X				
NB	1.958	B	W1-6	48	24																								
		B	W1-6	48	24			8.00							2		X							FACES SB TRAFFIC	X				
NB	2.089	A	W1-2L	30	30		LEFT CURVE 																						
NB	2.108	A	W1-2L	30	30			6.25							1		X							INSTALL 100 FEET NORTH OF EXISTING LOCATION	X				
NB	2.178	A	W1-8	18	24		CHEVRON																						
NB	2.185	B	W1-8	18	24		CHEVRON																						
NB	2.213	B	W1-8	18	24		CHEVRON																						
NB	2.219	A	W1-8	18	24		CHEVRON																						
NB	2.14-2.22	A/B	N/A	6	8		WHITE DELINEATORS	3.33							5		X							INSTALL BACK TO BACK AT 100 FEET SPACING. START 50' NORTH OF BARN.		5			
NB	2.750	A	W7-1	30	30		HILL SYMBOL																						
SIGN SUMMARY SHEET							SHEET TOTALS	44.83	0.00	0	1	1	10	0	0	14		210						PROJECT NAME: Stamford-Andover VT100					
								SF	SF	EA	EA	EA	EA	EA	EA	EA	FT							PROJECT NUMBER: STPG SIGN(20)					
VERMONT AGENCY OF TRANSPORTATION							TOWN TOTALS	1058.3	0.0	40.0	13.0	13.0	220	0.0	0.0	193		2895.0						FILE NAME: Whitinham.xls	PLOT DATE: 8/5/2009				
																								PROJECT MANAGER: N. Avery	DRAWN BY: I. Shea				
																									DESIGNED BY: J. Kelly	CHECKED BY: T. Guazzoni			
																										WHITINGHAM SHEET 4	SHEET 40 OF 198		

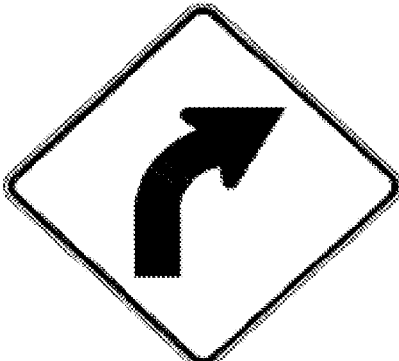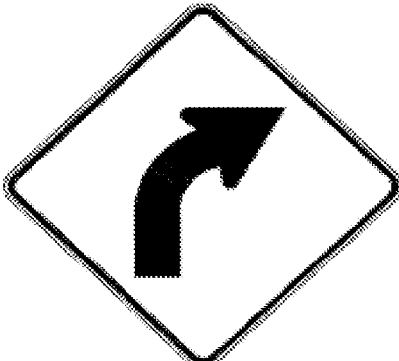DIRECTION	MILEPOINT	LOCATION CODE (SHEET 2)	SIGN CODE	WIDTH (IN)	HEIGHT (IN)	SHEETING REMARKS	SIGN LEGEND	NEW SIGNS		EXISTING SIGNS			EXIST POST		NUMBER OF NEW POSTS	SQUARE STEEL (IN)			TUBULAR STEEL Ø (IN)				SIGN FRAME REQUIRED	REMARKS	SIGN DETAIL			
								"A"	"B"	RETAIN	SALVAGE FROM	SALVAGE TO	REMOVE	RETAIN		REMOVE	1.75	2.00	2.50	3.00	3.50	4.00			5.00	DETAIL IN SHS	DETAIL ON SHEET NUMBER	DETAIL ON STD SHEET NUMBER
																	(LB / FT)			(LB / FT)								
WHITINGHAM VT 100							FY-FLUORESCENT YELLOW FYG-FLUORESCENT YELLOW GREEN															"SHS"-STANDARD HIGHWAY SIGNS						
NB	2.788	A	S3-1	30	30		SCHOOL BUS STOP AHEAD																SIGN NOT REMOVED. SCHOOL BUS STOPS AT THIS LOCATION					
NB	2.846 2.870	A	W1-10R	30	30			6.25						1		X								INSTALL 425 ³⁰⁷ FEET NORTH OF EXISTING SCHOOL BUS STOP AHEAD SIGN	X			
NB	3.365	A	W3-5	36	36		SPEED REDUCTION (40)			1																		
NB	3.477	A	R2-1	24	30		SPEED LIMIT 40			1																		
NB	3.634	A	W1-2R	30	30		RIGHT CURVE				1	1												RETAIN SIGN AND REPLACE POST.				
NB	3.767	A	W3-5	36	36		SPEED REDUCTION (30)			1																		
NB	3.824	A	VD-018	30	18								1			X												
		A	VD-018	30	18			3.75						1		X											E-128A	
		A	VD-701	6	8		BRIDGE 29			1	1													REINSTALL BRIDGE 29 PLAQUE BELOW NEW SIGN				
NB	3.861	A	R2-1	24	30		SPEED LIMIT 30			1																		
NB	3.947	A	M3-1S	24	12								1			X												
		A	M1-5	30	24																							
		A	M3-1	24	12			2.00																GREEN ON WHITE SHEETING	X			
		A	M1-5	30	24			5.00																			E-136B	
NB	3.991	A	S3-1	30	30		SCHOOL BUS STOP AHEAD																					
SIGN SUMMARY SHEET							SHEET TOTALS	17.00	0.00	4	2	2	4	5	0	0	4	60						PROJECT NAME: Stamford-Andover VT100				
VERMONT AGENCY OF TRANSPORTATION							TOWN TOTALS	1058.3	0.0	40.0	13.0	13.0	220	0.0	0.0	193	2895.0						PROJECT NUMBER: STPG SIGN(20)	FILE NAME: Whitinham.xls	PLOT DATE: 8/5/2009			
								SF	SF	EA	EA	EA	EA	EA	EA	EA	EA	EA	EA	EA	EA	EA	EA	DESIGNED BY: J. Kelly	DRAWN BY: I. Shea	CHECKED BY: T. Guazzoni		
																								WHITINGHAM SHEET 5	SHEET 41	OF 198		



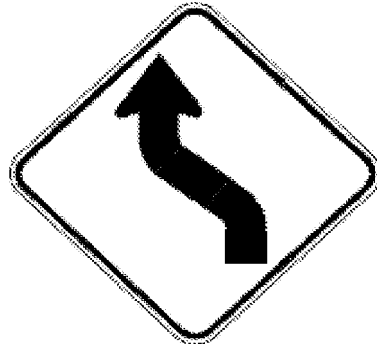
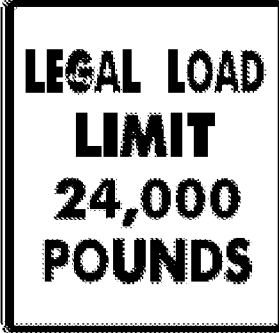




DIRECTION	MILEPOINT	LOCATION CODE (SHEET 2)	SIGN CODE	WIDTH (IN)	HEIGHT (IN)	SHEETING REMARKS	SIGN LEGEND	NEW SIGNS		EXISTING SIGNS				EXIST POST		NUMBER OF NEW POSTS	SQUARE STEEL (IN)			TUBULAR STEEL Ø (IN)				SIGN FRAME REQUIRED	REMARKS	SIGN DETAIL				
								"A"	"B"	RETAIN	SALVAGE FROM	SALVAGE TO	REMOVE	RETAIN	REMOVE		1.75	2.00	2.50	FOUNDATION	3.00	3.50	4.00			5.00	DETAIL IN SHS	DETAIL ON SHEET NUMBER	DETAIL ON STD SHEET NUMBER	
																	(LB / FT)				(LB / FT)									
WHITINGHAM VT 100							FY-FLUORESCENT YELLOW FYG-FLUORESCENT YELLOW GREEN															"SHS"-STANDARD HIGHWAY SIGNS								
		A	W1-3R	30	30		  																							
		A	W13-1	18	18																									
		A	S3-1	30	30				6.25							2		X											X	
		A	W1-3R	30	30				6.25																				X	
		A	W13-1	18	18				2.25																				X	
NB	4.009	A	W11-2YG	30	30		PEDESTRIAN			1							X													
		A	W16-4YG	24	18		NEXT 500 FEET			1																				
																														
NB	4.078	C	VR-017	24	30			5.00							1		X									REMOVED OLD SIGN TH-33, STIMPSON HILL RD			E-141	
NB	4.083	D	R1-1	30	30		  										1		X							SALVAGE DEAD END SIGN AND MILE MARKER ONTO NEW POST. ALSO STREET SIGN.				
		D	R1-1	30	30			6.25		2	2				1		X											X		
NB	4.102	A	W1-8	18	24												1		X											
		A	W1-8	18	24	FY		3.00							1		X											X		
NB	4.102	B	W1-8	18	24												1		X											
		B	W1-8	18	24	FY		3.00							1		X									FACES SB TRAFFIC			X	
NB	4.116	A	W1-8	18	24												1		X											
SIGN SUMMARY SHEET							SHEET TOTALS	32.00	0.00	2	2	2	7	0	0	6		90								PROJECT NAME: Stamford-Andover VT100 PROJECT NUMBER: STPG SIGN(20)				
VERMONT AGENCY OF TRANSPORTATION							TOWN TOTALS	1058.3	0.0	40.0	13.0	13.0	220	0.0	0.0	193		2895.0								FILE NAME: Whitingham.xls PROJECT MANAGER: N. Avery DESIGNED BY: J. Kelly WHITINGHAM SHEET 6	PLOT DATE: 8/5/2009 DRAWN BY: I. Shea CHECKED BY: T. Guazzoni SHEET 42 OF 198			





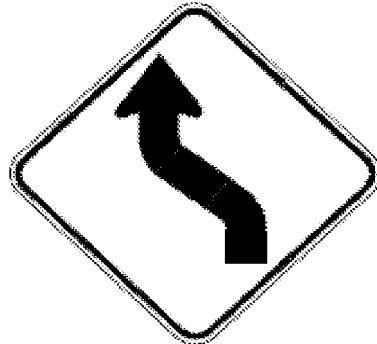

DIRECTION	MILEPOINT	LOCATION CODE (SHEET 2)	SIGN CODE	WIDTH (IN)	HEIGHT (IN)	SHEETING REMARKS	SIGN LEGEND	NEW SIGNS		EXISTING SIGNS			EXIST POST		NUMBER OF NEW POSTS	SQUARE STEEL (IN)			TUBULAR STEEL Ø (IN)				SIGN FRAME REQUIRED	REMARKS	SIGN DETAIL				
								"A"	"B"	RETAIN	SALVAGE FROM	SALVAGE TO	REMOVE	RETAIN		REMOVE	1.75	2.00	2.50	FOUNDATION	3.00	3.50			4.00	5.00	DETAIL IN SHS	DETAIL ON SHEET NUMBER	DETAIL ON STD SHEET NUMBER
																	(LB / FT)				(LB / FT)								
WHITINGHAM VT 100							FY-FLUORESCENT YELLOW FYG-FLUORESCENT YELLOW															"SHS"-STANDARD HIGHWAY SIGNS							
NB	4.116	A	W1-8	18	24	FY		3.00						1	X									X					
NB	4.116	B	W1-8	18	24							1	X																
		B	W1-8	18	24	FY		3.00						1	X									X					
NB	4.132	A	W1-8	18	24							1	X																
		A	W1-8	18	24	FY		3.00						1	X									X					
NB	4.132	B	W1-8	18	24							1	X																
		B	W1-8	18	24	FY		3.00						1	X									X					
NB	4.145	A	W1-8	18	24							1	X																
		A	W1-8	18	24	FY		3.00						1	X									X					
NB	4.145	B	W1-8	18	24							1	X																
		B	W1-8	18	24	FY		3.00						1	X									X					
NB	4.210	B	W1-3R	30	30	FY		6.25						1	X									X					
		B	W13-1	18	18	FY		2.25																X					
NB	4.232	B	W1-3R	30	30		RIGHT REVERSE CURVE					1	X																
		B	W13-1	18	18		20 MPH PLAQUE					1																	
SIGN SUMMARY SHEET							SHEET TOTALS	26.50	0.00	0	0	0	0	0	0	7	105						PROJECT NAME: Stamford-Andover VT100						
								SF	SF	EA	EA	EA	EA	EA	EA	EA	FT					PROJECT NUMBER: STPG SIGN(20)							
VERMONT AGENCY OF TRANSPORTATION							TOWN TOTALS	1058.3	0.0	40.0	13.0	13.0	220	0.0	0.0	193	2895.0					FILE NAME: Whitingham.xls	PLOT DATE: 8/5/2009						
																					PROJECT MANAGER: N. Avery	DRAWN BY: I. Shea							
																					DESIGNED BY: J. Kelly	CHECKED BY: T. Guazzoni							
																					WHITINGHAM SHEET 7	SHEET 43	OF 198						




DIRECTION	MILEPOINT	LOCATION CODE (SHEET 2)	SIGN CODE	WIDTH (IN)	HEIGHT (IN)	SHEETING REMARKS	SIGN LEGEND	NEW SIGNS		EXISTING SIGNS			EXIST POST		NUMBER OF NEW POSTS	SQUARE STEEL (IN)			TUBULAR STEEL Ø (IN)				SIGN FRAME REQUIRED	REMARKS	SIGN DETAIL				
								"A"	"B"	RETAIN	SALVAGE FROM	SALVAGE TO	REMOVE	RETAIN		REMOVE	1.75	2.00	2.50	FOUNDATION	3.00	3.50			4.00	5.00	DETAIL IN SHS	DETAIL ON SHEET NUMBER	DETAIL ON STD SHEET NUMBER
																	(LB / FT)				(LB / FT)								
WHITINGHAM VT 100							FY-FLUORESCENT YELLOW FYG-FLUORESCENT YELLOW GREEN															"SHS"-STANDARD HIGHWAY SIGNS							
NB	4.270	A	OM-3R	12	36			3.00															INSTALL ON SOUTH SIDE OF LEDGE/CONCRETE OUTCROPPING	X					
NB	4.286	B	OM-3L	12	36		LEFT OBJECT MARKER					1																	
NB	4.322	A	R2-1	24	30							1																	
		A	R2-1	24	30			5.00																	X				
NB	4.409	C	VR-017	24	30			5.00																		E-141			
NB	4.417	D	R1-1	30	30		 					1																	
		D	R1-1	30	30		 	6.25		2	2														X	SALVAGED TWO STREET SIGNS ONTO NEW POSTS. ALSO MM.			
NB	4.600	A	R2-1	24	30							1																	
		A	R2-1	24	30			5.00																		X			
NB	4.757	A	W1-2R	30	30		RIGHT CURVE					1																	
		A	W13-1	18	18		40 MPH PLAQUE 					1																	
NB	4.780	A	W1-2R	30	30	FY	 	6.25																					
		A	W13-1	18	18	FY		2.25																		X			
NB	4.846	A	S3-1	30	30		SCHOOL BUS STOP AHEAD 					1																	
NB	4.906 4.900	A	W2-2MaR	30	30			6.25																		INSTALL ³¹⁵ 285 FEET NORTH OF EXISTING SCHOOL BUS STOP AHEAD			
SIGN SUMMARY SHEET							SHEET TOTALS	39.00	0.00	0	2	2	7	0	0	8	120						PROJECT NAME: Stamford-Andover VT100						
								SF	SF	EA	EA	EA	EA	EA	EA	EA	FT					PROJECT NUMBER: STPG SIGN(20)							
VERMONT AGENCY OF TRANSPORTATION							TOWN TOTALS	1058.3	0.0	40.0	13.0	13.0	220	0.0	0.0	193	2895.0					FILE NAME: Whitingham.xls	PLOT DATE: 8/5/2009						
																					PROJECT MANAGER: N. Avery	DRAWN BY: I. Shea							
																					DESIGNED BY: J. Kelly	CHECKED BY: T. Guazzoni							
																					WHITINGHAM SHEET 8	SHEET 44 OF 198							




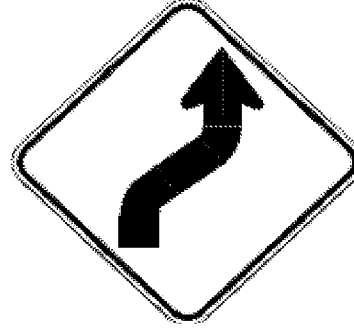
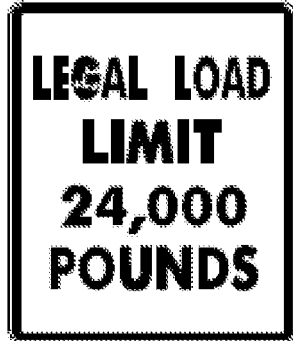

DIRECTION	MILEPOINT	LOCATION CODE (SHEET 2)	SIGN CODE	WIDTH (IN)	HEIGHT (IN)	SHEETING REMARKS	SIGN LEGEND	NEW SIGNS		EXISTING SIGNS			EXIST POST		NUMBER OF NEW POSTS	SQUARE STEEL (IN)			TUBULAR STEEL Ø (IN)				SIGN FRAME REQUIRED	REMARKS	SIGN DETAIL			
								"A"	"B"	RETAIN	SALVAGE FROM	SALVAGE TO	REMOVE	RETAIN		REMOVE	1.75	2.00	2.50	3.00	3.50	4.00			5.00	DETAIL IN SHS	DETAIL ON SHEET NUMBER	DETAIL ON STD SHEET NUMBER
																	(LB / FT)			(LB / FT)								
WHITINGHAM VT 100							FY-FLUORESCENT YELLOW FYG-FLUORESCENT YELLOW GREEN															"SHS"-STANDARD HIGHWAY SIGNS						
			A S3-1	30	30			6.25																X				
NB	4.976		C VR-017	24	30							1																
			C VR-017	24	30			5.00						1		X									PLUMB RD TH-59		E-141	
NB	4.984		D R1-1	30	30		 					1													SALVAGED STREET SIGN ONTO NEW POST. ALSO MM.			
			D R1-1	30	30			6.25						1		X								X		PLUMB RD TH-59		
NB	5.729		A W2-1M	30	30		MODIFIED CROSSROADS					1																
			A W2-1Md	30	30			6.25						1		X											6	
NB	5.788		A W7-1	30	30		HILL SYMBOL					1																
			A W1-4L	30	30		LEFT REVERSE CURVE					1																
			A W13-1	18	18		40 MPH PLAQUE						1															
			A W7-1B	30	30			6.25						1		X								X				
			A W7-3a	24	18			3.00																X				
NB	5.792		C VR-017	24	30							1																
			C VR-017	24	30			5.00						1		X									TH-3, GOODNOW RD (SOUTH)		E-141	
NB	5.802		D R1-1	30	30							1																
SIGN SUMMARY SHEET							SHEET TOTALS	38.00	0.00	0	0	0	8	0	0	5	75											
VERMONT AGENCY OF TRANSPORTATION							TOWN TOTALS	1058.3	0.0	40.0	13.0	13.0	220	0.0	0.0	193	2895.0											
																					PROJECT NAME:	Stamford-Andover VT100						
																					PROJECT NUMBER:	STPG SIGN(20)						
											FILE NAME:	Whitingham.xls					PLOT DATE:	8/5/2009										
											PROJECT MANAGER:	N. Avery					DRAWN BY:	I. Shea										
											DESIGNED BY:	J. Kelly					CHECKED BY:	T. Guazzoni										
											WHITINGHAM SHEET	9					SHEET	45 OF 198										





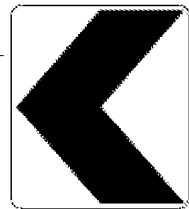


DIRECTION	MILEPOINT	LOCATION CODE (SHEET 2)	SIGN CODE	WIDTH (IN)	HEIGHT (IN)	SHEETING REMARKS	SIGN LEGEND	NEW SIGNS		EXISTING SIGNS			EXIST POST		NUMBER OF NEW POSTS	SQUARE STEEL (IN)			TUBULAR STEEL Ø (IN)				SIGN FRAME REQUIRED	REMARKS	SIGN DETAIL				
								"A"	"B"	RETAIN	SALVAGE FROM	SALVAGE TO	REMOVE	RETAIN		REMOVE	1.75	2.00	2.50	FOUNDATION	3.00	3.50			4.00	5.00	DETAIL IN SHS	DETAIL ON SHEET NUMBER	DETAIL ON STD SHEET NUMBER
																	(LB / FT)				(LB / FT)								
WHITINGHAM VT 100							FY-FLUORESCENT YELLOW FYG-FLUORESCENT YELLOW GREEN															"SHS"-STANDARD HIGHWAY SIGNS							
NB	5.802	D	R1-1	30	30			6.25						1	X								SALVAGED MM ONTO NEW POST. TH-3, GOODNOW RD (SOUTH)	X					
NB	5.839	A	W1-4L	30	30			6.25						1	X								INSTALL MIDSPAN OF TH-3 LEGS	X					
NB	5.861	B	W1-6R	48	24			8.00						2	X								INSTALL NEXT TO LEGAL LOAD ASSEMBLY FACING SB TRAFFIC	X					
NB	5.861	C	VR-017	24	30							1		X															
		C	VR-017	24	30			5.00						1	X								TH-3, GOODNOW RD (NORTH)			E-141			
		C	R2-1	24	30		TOWN'S SPEED LIMIT 30			1	1												INSTALL TOWN'S SPEED LIMIT 30 SIGN BELOW NEW LEGAL LOAD SIGN						
NB	5.877	D	R1-1	30	30							1		X									SALVAGED MM ONTO NEW POST.						
		D	R1-1	30	30			6.25						1	X								TH-3, GOODNOW RD (NORTH)	X					
NB	5.893	A	W1-8	18	24		CHEVRON					1		X															
		A	W1-6L	48	24			8.00						2	X										X				
NB	5.945	A	M3-1	24	12							1		X															
		A	M1-5A	24	24							1																	
		A	M3-1	24	12			2.00						1	X								GREEN ON WHITE SHEETING	X					
		A	M1-5	30	24			5.00																		E-136B			
NB	5.985	A	R2-1	24	30		SPEED LIMIT 50								X								SIGN NOT REMOVED PER R.E.						
SIGN SUMMARY SHEET							SHEET TOTALS	46.75	0.00	0	1	1	5	0	0	9	135							PROJECT NAME: Stamford-Andover VT100					
								SF	SF	EA	EA	EA	EA	EA	EA	EA	FT						PROJECT NUMBER: STPG SIGN(20)						
VERMONT AGENCY OF TRANSPORTATION							TOWN TOTALS	1058.3	0.0	40.0	13.0	13.0	220	0.0	0.0	193	2895.0						FILE NAME: Whitingham.xls	PLOT DATE: 8/5/2009					
																					DESIGNED BY: J. Kelly	CHECKED BY: T. Guazzoni							
																					WHITINGHAM SHEET 10	SHEET 46	OF 198						

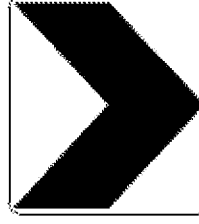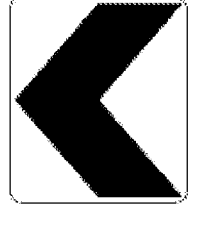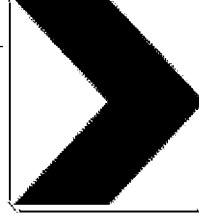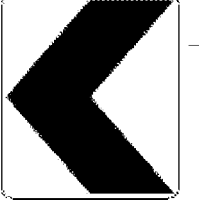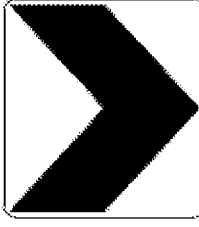
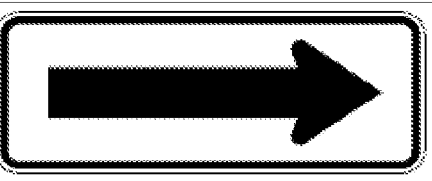


DIRECTION	MILEPOINT	LOCATION CODE (SHEET 2)	SIGN CODE	WIDTH (IN)	HEIGHT (IN)	SHEETING REMARKS	SIGN LEGEND	NEW SIGNS		EXISTING SIGNS			EXIST POST		NUMBER OF NEW POSTS	SQUARE STEEL (IN) (LB / FT)			TUBULAR STEEL Ø (IN) (LB / FT)				SIGN FRAME REQUIRED	REMARKS	SIGN DETAIL							
								"A"	"B"	RETAIN	SALVAGE FROM	SALVAGE TO	REMOVE	RETAIN		REMOVE	1.75	2.00	2.50	FOUNDATION	3.00	3.50			4.00	5.00	DETAIL IN SHS	DETAIL ON SHEET NUMBER	DETAIL ON STD SHEET NUMBER			
																														1.88	2.42	3.35
WHITINGHAM VT 100							FY-FLUORESCENT YELLOW FYG-FLUORESCENT YELLOW GREEN															"SHS"-STANDARD HIGHWAY SIGNS										
NB	6.037	A	W1-4L	30	30		LEFT REVERSE CURVE																									
NB	6.113	A	VW-054L	30	30		HIDDEN DRIVE LEFT																									
NB	6.144	A	VW-054L	30	30		 	6.25																								
NB	6.182 6.168	A	W1-4L	30	30			6.25																								
NB	6.269	A	W1-2R	30	30		RIGHT CURVE																									
NB	6.291	A	S1-1YG	36	36		SCHOOL PENTAGON			1																						
		A	W16-9YG	24	12		AHEAD			1																						
NB	6.381	C	VR-017	24	30																											
		C	VR-017	24	30			5.00																								
		C	R2-1				SPEED LIMIT 30				1	1																				
NB	6.389	D	R1-1	30	30		 																									
		D	R1-1	30	30			6.25																								
NB	6.401	A	VW-202	30	30		TRUCKS ENTERING																									
																																
NB	6.429	A	VW-202	30	30			6.25																								
NB	6.535	A	OM-3R	12	36		RIGHT OBJECT MARKER																									
SIGN SUMMARY SHEET							SHEET TOTALS	30.00	0.00	2	2	2	7	0	0	5	75															
VERMONT AGENCY OF TRANSPORTATION							TOWN TOTALS	1058.3	0.0	40.0	13.0	13.0	220	0.0	0.0	193	2895.0															
PROJECT NAME: Stamford-Andover VT100																			PROJECT NUMBER: STPG SIGN(20)													
FILE NAME: Whitingham.xls																			PLOT DATE: 8/5/2009													
PROJECT MANAGER: N. Avery																			DRAWN BY: I. Shea													
DESIGNED BY: J. Kelly																			CHECKED BY: T. Guazzoni													
WHITINGHAM SHEET 11																			SHEET 47 OF 198													

DIRECTION	MILEPOINT	LOCATION CODE (SHEET 2)	SIGN CODE	WIDTH (IN)	HEIGHT (IN)	SHEETING REMARKS	SIGN LEGEND	NEW SIGNS		EXISTING SIGNS			EXIST POST		NUMBER OF NEW POSTS	SQUARE STEEL (IN)			TUBULAR STEEL Ø (IN)				SIGN FRAME REQUIRED	REMARKS	SIGN DETAIL															
								"A"	"B"	RETAIN	SALVAGE FROM	SALVAGE TO	REMOVE	RETAIN		REMOVE	1.75	2.00	2.50	3.00	3.50	4.00			5.00	DETAIL IN SHS	DETAIL ON SHEET NUMBER	DETAIL ON STD SHEET NUMBER												
																	(LB / FT)			(LB / FT)																				
WHITINGHAM VT 100							FY-FLUORESCENT YELLOW FYG-FLUORESCENT YELLOW GREEN														"SHS"-STANDARD HIGHWAY SIGNS																			
NB	6.540	B	OM-3L	12	36		LEFT OBJECT MARKER						1																											
		A	W1-4R	30	30			6.25																												X				
NB	6.950	B	OM-3L	12	36		LEFT OBJECT MARKER																																	
NB	6.955	A	VD-062B	72	16		BUSINESS SIGN			1																														
NB	6.999	A	W3-5	36	36		SPEED REDUCTION (40)			1																														
NB	7.060	A	W7-1B	36	36		HILL SYMBOL (11% GRADE)					1																												
		A	W7-2B	24	18		TRUCKS USE LOWER GEAR					1																												
		A	W7-3A	24	18		NEXT 1/2 MILE					1																												
NB	7.111	C	VR-017	24	30							1																												
		C	VR-017	24	30			5.00																																
		C	R2-1				SPEED LIMIT 30					1																												
NB	7.115	D	R1-1	30	30																																			
		D	R1-1	30	30		  	6.25																																
NB	7.116	A	R2-1	30	36		SPEED LIMIT 40			1																														
NB	7.148	A	W1-5R	30	30	FY		6.25																																
SIGN SUMMARY SHEET							SHEET TOTALS	23.75	0.00	4	2	5	3	0	0	4	60					PROJECT NAME: Stamford-Andover VT100																		
							TOWN TOTALS	1058.3	0.0	40.0	13.0	13.0	220	0.0	0.0	193	2895.0					PROJECT NUMBER: STPG SIGN(20)																		
								SF	SF	EA	EA	EA	EA	EA	EA	EA	FT					FILE NAME: Whitingham.xls	PLOT DATE: 8/5/2009																	
							VERMONT AGENCY OF TRANSPORTATION															PROJECT MANAGER: N. Avery	DRAWN BY: I. Shea																	
																					DESIGNED BY: J. Kelly	CHECKED BY: T. Guazzoni																		
																					WHITINGHAM SHEET 12	SHEET 48 OF 198																		

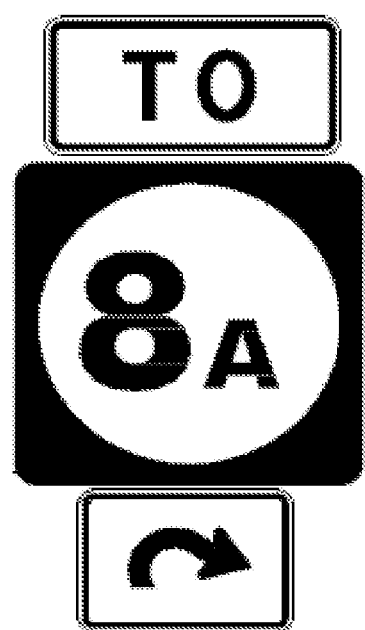







DIRECTION	MILEPOINT	LOCATION CODE (SHEET 2)	SIGN CODE	WIDTH (IN)	HEIGHT (IN)	SHEETING REMARKS	SIGN LEGEND	NEW SIGNS		EXISTING SIGNS				EXIST POST		NUMBER OF NEW POSTS	SQUARE STEEL (IN)			TUBULAR STEEL Ø (IN)				SIGN FRAME REQUIRED	REMARKS	SIGN DETAIL							
								"A"	"B"	RETAIN	SALVAGE FROM	SALVAGE TO	REMOVE	RETAIN	REMOVE		1.75	2.00	2.50	3.00	3.50	4.00	5.00			DETAIL IN SHS	DETAIL ON SHEET NUMBER	DETAIL ON STD SHEET NUMBER					
																	(LB / FT)			(LB / FT)													
WHITINGHAM VT 100							FY-FLUORESCENT YELLOW FYG-FLUORESCENT YELLOW GREEN																"SHS"-STANDARD HIGHWAY SIGNS										
		A	W7-3A	24	18	FY		3.00																			X						
NB	7.178	A	W7-1B	36	36		HILL SYMBOL (11% GRADE)				1																			RELOCATE SIGNS 625 FEET SOUTH AND INSTALL ON NEW POSTS			
		A	W7-2B	24	18		TRUCKS USE LOWER GEAR				1																			SALVAGE TO MP 7.060			
		A	W7-3A	24	18		NEXT 1/2 MILE				1																						
NB	7.249	A	W1-2R	30	30		RIGHT CURVE						1																				
NB	7.288	A	W3-5	36	36		SPEED REDUCTION (30)			1																							
NB	7.319	A	VW-054R	30	30		HIDDEN DRIVE RIGHT				1	1						X												REINSTALL SIGN ON NEW POST			
NB	7.353	A	VD-018	30	18								1																				
		A	VD-018	30	18			3.75																							E-128A		
NB	7.408	A	R2-1	24	30		SPEED LIMIT 30						1																				
		A	VR-020	24	30		NO PARKING ON TRAVELED LANE						1																				
NB	7.414	A	R2-1	30	36			7.50																							INSTALL 30 FEET NORTH OF EXISTING SPEED LIMIT 30 SIGN ASSEMBLY.		
NB	7.448	A	VR-020	24	30		NO PARKING ON TRAVELED LANE						1																				
NB	7.459	A	W1-8	18	24								1																				
		A	W1-8	18	24	FY		3.00																									
SIGN SUMMARY SHEET							SHEET TOTALS	17.25	0.00	1	4	1	6	0	0	4	60																
VERMONT AGENCY OF TRANSPORTATION								SF	SF	EA	EA	EA	EA	EA	EA	EA	EA	FT															
							TOWN TOTALS	1058.3	0.0	40.0	13.0	13.0	220	0.0	0.0	193	2895.0																
																					PROJECT NAME:	Stamford-Andover VT100											
																					PROJECT NUMBER:	STPG SIGN(20)											
																					FILE NAME:	Whitingham.xls											
																					PLOT DATE:	8/5/2009											
																					PROJECT MANAGER:	N. Avery											
																					DRAWN BY:	I. Shea											
																					DESIGNED BY:	J. Kelly											
																					CHECKED BY:	T. Guazzoni											
																					WHITINGHAM SHEET 13	SHEET 49 OF 198											



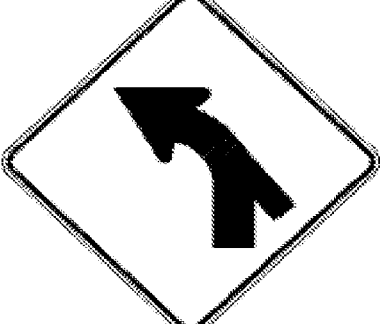


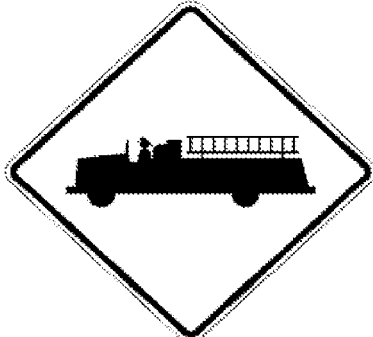
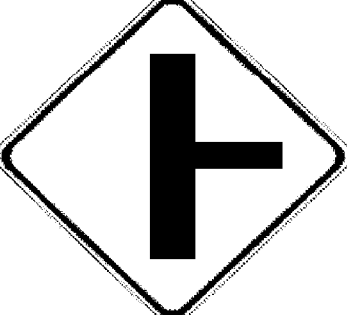
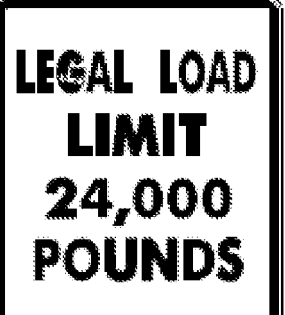

DIRECTION	MILEPOINT	LOCATION CODE (SHEET 2)	SIGN CODE	WIDTH (IN)	HEIGHT (IN)	SHEETING REMARKS	SIGN LEGEND	NEW SIGNS		EXISTING SIGNS			EXIST POST		NUMBER OF NEW POSTS	SQUARE STEEL (IN)			TUBULAR STEEL Ø (IN)				SIGN FRAME REQUIRED	REMARKS	SIGN DETAIL				
								"A"	"B"	RETAIN	SALVAGE FROM	SALVAGE TO	REMOVE	RETAIN		REMOVE	1.75	2.00	2.50	FOUNDATION	3.00	3.50			4.00	5.00	DETAIL IN SHS	DETAIL ON SHEET NUMBER	DETAIL ON STD SHEET NUMBER
																	(LB / FT)				(LB / FT)								
WHITINGHAM VT 100							FY-FLUORESCENT YELLOW FYG-FLUORESCENT YELLOW GREEN															"SHS"-STANDARD HIGHWAY SIGNS							
NB	7.459	B	W1-8	18	24						1		X																
		B	W1-8	18	24	FY		3.00						1	X									X	FACES SB TRAFFIC				
NB	7.473	A	W1-8	18	24						1		X																
		A	W1-8	18	24	FY		3.00						1	X									X					
NB	7.473	B	W1-8	18	24						1		X																
		B	W1-8	18	24	FY		3.00						1	X									X	FACES SB TRAFFIC				
NB	7.493	A	W1-8	18	24						1		X																
		A	W1-8	18	24	FY		3.00						1	X									X					
NB	7.493	B	W1-8	18	24						1		X																
		B	W1-8	18	24	FY		3.00						1	X									X	FACES SB TRAFFIC				
NB	7.503	A	M2-1	21	15						1		X																
		A	M1-5A	30	24						1																		
		A	M2-1	21	15			2.19						1	X									X	GREEN ON WHITE SHEETING				
		A	M1-5	30	24			5.00																	E-136B				
NB	7.519	A	D1-1M	72	10		UP ARROW WILMINGTON 7				1		X																
SIGN SUMMARY SHEET							SHEET TOTALS		22.19	0.00	0	0	0	8	0	0	6	90					PROJECT NAME: Stamford-Andover VT100						
VERMONT AGENCY OF TRANSPORTATION							TOWN TOTALS		1058.3	0.0	40.0	13.0	13.0	220	0.0	0.0	193	2895.0					PROJECT NUMBER: STPG SIGN(20)						
									SF	SF	EA	EA	EA	EA	EA	EA	EA	FT					FILE NAME: Whitingham.xls						
																							PLOT DATE: 8/5/2009						
																							DRAWN BY: I. Shea						
																							DESIGNED BY: J. Kelly						
																							CHECKED BY: T. Guazzoni						
																							SHEET 50 OF 198						








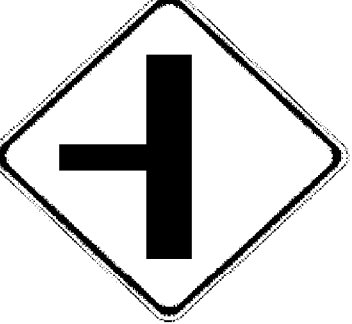



DIRECTION	MILEPOINT	LOCATION CODE (SHEET 2)	SIGN CODE	WIDTH (IN)	HEIGHT (IN)	SHEETING REMARKS	SIGN LEGEND	NEW SIGNS		EXISTING SIGNS			EXIST POST		NUMBER OF NEW POSTS	SQUARE STEEL (IN)			TUBULAR STEEL Ø (IN)				SIGN FRAME REQUIRED	REMARKS	SIGN DETAIL			
								"A"	"B"	RETAIN	SALVAGE FROM	SALVAGE TO	REMOVE	RETAIN		REMOVE	1.75	2.00	2.50	3.00	3.50	4.00			5.00	DETAIL IN SHS	DETAIL ON SHEET NUMBER	DETAIL ON STD SHEET NUMBER
																	(LB / FT)			(LB / FT)								
WHITINGHAM VT 100							FY-FLUORESCENT YELLOW FYG-FLUORESCENT YELLOW GREEN														"SHS"-STANDARD HIGHWAY SIGNS							
			A	D1-1A	72	10	GREENFIELD MASS 26 MODIFIED RIGHT ARROW						1															
NB	7.553		A	VR-020	24	30	NO PARKING ON TRAVELED LANE						1		X													
			A	D2-1	72	12	 	6.00										X										5
			A	D1-1A	72	12		6.00																				5
NB	7.598		A	M3-1	24	12		2.00											X			#3B	INSTALL ON SOUTH SIDE OF UTILITY POLE AT BEGINNING OF RETAINING WALL. GREEN ON WHITE SHEETING	X		7		
			A	M1-5	30	24		5.00																			E-136B	
			A	M6-3	21	15		2.19															GREEN ON WHITE SHEETING	X				
			A	M3-3	24	12		2.00															GREEN ON WHITE SHEETING	X				
			A	M1-5	30	24		5.00																		E-136B		
			A	VM-013R	21	15	   <p style="color:red; font-size:small;">ROUTE NUMBER CHANGE</p>	2.19																				
			A	M4-5	24	12		2.00																BLACK ON WHITE SHEETING	X		6	
			A	M1-6	24	24		4.00																			E-136C	
			A	VM-013R	21	15		2.19																BLACK ON WHITE SHEETING			6	
NB	7.604		A	OM-3R	12	36	 																					
			A	OM-3R	12	36		3.00												X				INSTALL AT EDGE OF PAVEMENT IN FRONT OF RETAINING WALL	X			
SIGN SUMMARY SHEET							SHEET TOTALS	41.57	0.00	0	0	0	3	0	0	5	75											
VERMONT AGENCY OF TRANSPORTATION							TOWN TOTALS	1058.3	0.0	40.0	13.0	13.0	220	0.0	0.0	193	2895.0											
PROJECT NAME: Stamford-Andover VT100																					PROJECT NUMBER: STPG SIGN(20)							
FILE NAME: Whitingham.xls														PLOT DATE: 8/5/2009														
PROJECT MANAGER: N. Avery														DRAWN BY: I. Shea														
DESIGNED BY: J. Kelly														CHECKED BY: T. Guazzoni														
WHITINGHAM SHEET 15														SHEET 51 OF 198														

DIRECTION	MILEPOINT	LOCATION CODE (SHEET 2)	SIGN CODE	WIDTH (IN)	HEIGHT (IN)	SHEETING REMARKS	SIGN LEGEND	NEW SIGNS		EXISTING SIGNS			EXIST POST		NUMBER OF NEW POSTS	SQUARE STEEL (IN)			TUBULAR STEEL Ø (IN)				SIGN FRAME REQUIRED	REMARKS	SIGN DETAIL			
								"A"	"B"	RETAIN	SALVAGE FROM	SALVAGE TO	REMOVE	RETAIN		REMOVE	1.75	2.00	2.50	3.00	3.50	4.00			5.00	DETAIL IN SHS	DETAIL ON SHEET NUMBER	DETAIL ON STD SHEET NUMBER
																	(LB / FT)			(LB / FT)								
WHITINGHAM VT 100							FY-FLUORESCENT YELLOW FYG-FLUORESCENT YELLOW GREEN															"SHS"-STANDARD HIGHWAY SIGNS						
NB	7.685	A	M3-1	24	12						1																	
		A	M1-5A	30	24							1																
		A	M6-1	21	15							1																
		A	M3-1	24	12				2.00					1		X								GREEN ON WHITE SHEETING	X			
		A	M1-5	30	24				5.00																	E-136B		
		A	M6-1L	21	15			2.19															GREEN ON WHITE SHEETING	X				
NB	7.685	B	W1-6	48	24						1																	
		B	W1-6	48	24				8.00					2		X								FACES SB TRAFFIC	X			
NB	7.686	C	VR-017	24	30						1																	
		C	VR-017	24	30				5.00					1		X								GATES POND TH-41, MILL HILL RD			E-141	
		C	R2-1	24	30	SPEED LIMIT 30 - TOWN SIGN					1	1												INSTALL TOWN'S SPEED LIMIT 30 SIGN BELOW NEW LEGAL LOAD				
NB	7.693	D	R1-1	30	30						1																	
		D	R1-1	30	30				6.25					1		X								GATES POND TH-41, MILL HILL RD		X		
NB	7.719	A	R2-1	24	30	SPEED LIMIT 30				1					X													
		A	VR-020	24	30	NO PARKING ON TRAVELED LANE				1																		
SIGN SUMMARY SHEET							SHEET TOTALS	28.44	0.00	2	1	1	6	0	0	5	75							PROJECT NAME: Stamford-Andover VT100				
								SF	SF	EA	EA	EA	EA	EA	EA	EA	FT							PROJECT NUMBER: STPG SIGN(20)				
VERMONT AGENCY OF TRANSPORTATION							TOWN TOTALS	1058.3	0.0	40.0	13.0	13.0	220	0.0	0.0	193	2895.0							FILE NAME: Whitingham.xls	PLOT DATE: 8/5/2009			
																							PROJECT MANAGER: N. Avery	DRAWN BY: I. Shea				
																							DESIGNED BY: J. Kelly	CHECKED BY: T. Guazzoni				
																							WHITINGHAM SHEET 16	SHEET 52	OF 198			


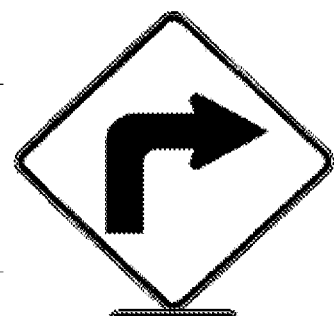

2 NEW SIGNS
SEE PAGE 70

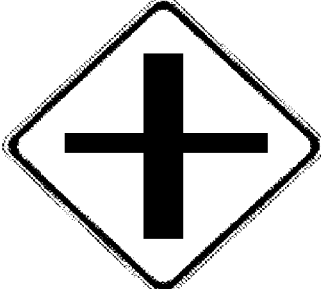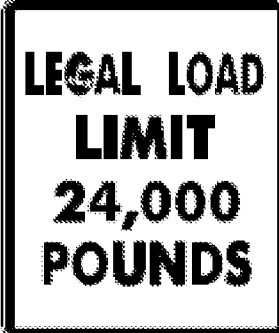DIRECTION	MILEPOINT	LOCATION CODE (SHEET 2)	SIGN CODE	WIDTH (IN)	HEIGHT (IN)	SHEETING REMARKS	SIGN LEGEND	NEW SIGNS		EXISTING SIGNS			EXIST POST		NUMBER OF NEW POSTS	SQUARE STEEL (IN)			TUBULAR STEEL Ø (IN)				SIGN FRAME REQUIRED	REMARKS	SIGN DETAIL				
								"A"	"B"	RETAIN	SALVAGE FROM	SALVAGE TO	REMOVE	RETAIN		REMOVE	1.75	2.00	2.50	FOUNDATION	3.00	3.50			4.00	5.00	DETAIL IN SHS	DETAIL ON SHEET NUMBER	DETAIL ON STD SHEET NUMBER
																	(LB / FT)				(LB / FT)								
WHITINGHAM VT 100							FY-FLUORESCENT YELLOW FYG-FLUORESCENT YELLOW GREEN															"SHS"-STANDARD HIGHWAY SIGNS							
NB	7.751	A	W11-8	30	30						1		X																
		A	W11-8	30	30			6.25						1	X								X						
NB	7.832	A	M3-1S	24	12		NORTH			+				✖	X														
		A	M1-5	30	24		VERMONT 100			+																			
																													
NB	7.890	A	R2-1	24	30			5.00						1	X								INSTALL 130 FEET SOUTH OF EXISTING SPEED LIMIT 40, BEHIND BEGINNING OF RAIL	X					
NB	7.915	A	R2-1	24	30		SPEED LIMIT 40				1		X																
NB	7.933	A	D2-1	72	12			6.00						1	X								INSTALL 150 FEET SOUTH OF EXISTING DESTINATION BOARD		5				
NB	7.961	A	D2-1	72	10		WILMINGTON 7				1		X																
NB	8.065	A	W1-4L	30	30		LEFT REVERSE CURVE				1		X																
NB	8.151	A	R2-1	24	30		SPEED LIMIT 50				1		X																
																													
NB	8.892	C	VR-017	24	30						1		X																
		C	VR-017	24	30			5.00						1	X								TH-21, BIRDVILLE RD		E-141				
NB	8.898	D	R1-1	30	30						1		X																
		D	R1-1	30	30			6.25						1	X								TH-21, BIRDVILLE RD	X					
SIGN SUMMARY SHEET							SHEET TOTALS	33.50	0.00	0 2	4 4	4 4	9 7	0	0	6	90						PROJECT NAME: Stamford-Andover VT100						
VERMONT AGENCY OF TRANSPORTATION							TOWN TOTALS	1058.3	0.0	40.0	13.0	13.0	220	0.0	0.0	193	2895.0						PROJECT NUMBER: STPG SIGN(20)						
								SF	SF	EA	EA	EA	EA	EA	EA	EA	FT						FILE NAME: Whitingham.xls	PLOT DATE: 8/5/2009					
																							PROJECT MANAGER: N. Avery	DRAWN BY: I. Shea					
																							DESIGNED BY: J. Kelly	CHECKED BY: T. Guazzoni					
																							WHITINGHAM SHEET 17	SHEET 53 OF 198					

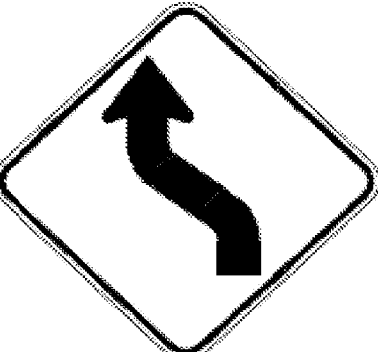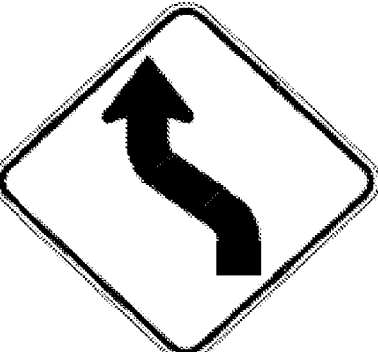


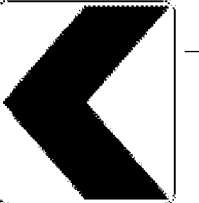
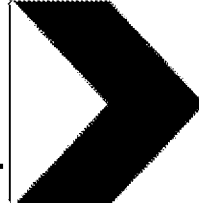

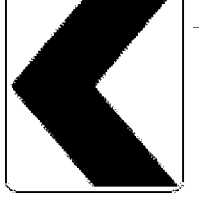
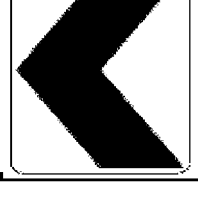
DIRECTION	MILEPOINT	LOCATION CODE (SHEET 2)	SIGN CODE	WIDTH (IN)	HEIGHT (IN)	SHEETING REMARKS	SIGN LEGEND	NEW SIGNS		EXISTING SIGNS			EXIST POST		NUMBER OF NEW POSTS	SQUARE STEEL (IN)			TUBULAR STEEL Ø (IN)				SIGN FRAME REQUIRED	REMARKS	SIGN DETAIL			
								"A"	"B"	RETAIN	SALVAGE FROM	SALVAGE TO	REMOVE	RETAIN		REMOVE	1.75	2.00	2.50	3.00	3.50	4.00			5.00	DETAIL IN SHS	DETAIL ON SHEET NUMBER	DETAIL ON STD SHEET NUMBER
																	(LB / FT)			(LB / FT)								
WHITINGHAM VT 100							FY-FLUORESCENT YELLOW FYG-FLUORESCENT YELLOW GREEN															"SHS"-STANDARD HIGHWAY SIGNS						
NB	9.410	A	W2-2MaL	30	30			6.25						1		X							INSTALL 400 FEET SOUTH OF TH-3 INTERSECTION.		6			
NB	10.353	A	VW-054R	30	30		HIDDEN DRIVE RIGHT						1			X												
		A	S3-1	30	30		SCHOOL BUS STOP AHEAD						1															
NB	10.397	A	VW-054R	30	30			6.25						1		X						• SEE NOTE FOR TOWN LINE ON SHEET 7!	INSTALL DIRECTLY ACROSS FROM FULLER HILL ROAD, 235 FEET NORTH OF EXISTING			E-154		
SB	10.570	F	W1-2L	30	30		LEFT CURVE						1			X												
		F	W13-1	18	18		40 MPH PLAQUE						1															
SB	10.505	F	W1-2MhL	30	30			6.25						1		X							INSTALL ACROSS FROM DRIVE, 350 FEET SOUTH OF EXISTING		6			
		F	W13-1	18	18			2.25																X				
SB	10.400	G	VR-017	24	30			5.00						1		X							TH-18, FULLER HILL RD			E-141		
SB	10.394	H	R1-1	24	24								1			X							TH-18, FULLER HILL RD					
		H	R1-1	30	30			6.25						1		X								X				
SB	9.580	F	W2-2R	30	30								1			X												
		F	W2-2MaR	30	30			6.25						1		X									6			
SB	9.496	G	VR-017	24	30			5.00						1		X							SPEED ZONE SIGN SALVAGED ONTO THE NEW POST. TH-3, WILMINGTON CROSS RD			E-141		
SB	9.489	H	R1-1	30	30								1			X							TH-3, WILMINGTON CROSS RD					
SIGN SUMMARY SHEET							SHEET TOTALS	43.50	0.00	0	2	2	9	0	0	7	105							PROJECT NAME: Stamford-Andover VT100				
VERMONT AGENCY OF TRANSPORTATION							TOWN TOTALS	1058.3	0.0	40.0	13.0	13.0	220	0.0	0.0	193	2895.0							PROJECT NUMBER: STPG SIGN(20)	FILE NAME: Whitingham.xls	PLOT DATE: 8/5/2009		
								SF	SF	EA	EA	EA	EA	EA	EA	EA	FT							DESIGNED BY: J. Kelly	DRAWN BY: I. Shea	CHECKED BY: T. Guazzoni		
																									WHITINGHAM SHEET 18	SHEET 54	OF 198	

DIRECTION	MILEPOINT	LOCATION CODE (SHEET 2)	SIGN CODE	WIDTH (IN)	HEIGHT (IN)	SHEETING REMARKS	SIGN LEGEND	NEW SIGNS		EXISTING SIGNS			EXIST POST		NUMBER OF NEW POSTS	SQUARE STEEL (IN)			TUBULAR STEEL Ø (IN)				SIGN FRAME REQUIRED	REMARKS	SIGN DETAIL			
								"A"	"B"	RETAIN	SALVAGE FROM	SALVAGE TO	REMOVE	RETAIN		REMOVE	1.75	2.00	2.50	3.00	3.50	4.00			5.00	DETAIL IN SHS	DETAIL ON SHEET NUMBER	DETAIL ON STD SHEET NUMBER
																	(LB / FT)			(LB / FT)								
WHITINGHAM VT 100							FY-FLUORESCENT YELLOW FYG-FLUORESCENT YELLOW GREEN															"SHS"-STANDARD HIGHWAY SIGNS						
SB	9.489	H	R1-1	30	30			6.25						1	X									X				
SB	9.374	F	N/A				EMPTY POST 																					
SB	9.005	F	W2-1M	30	30						1																	
		F	W2-1Mb	30	30			6.25						1	X										6			
SB	8.898	G	VR-017	24	30						1																	
		G	VR-017	24	30			5.00						1	X										E-141			
SB	8.892	H	R1-1	30	30						1																	
		H	R1-1	30	30			6.25						1	X									X				
SB	8.460	F	W1-4L	30	30		LEFT REVERSE CURVE 				1																	
SB	8.393	F	W1-4L	30	30			6.25						1	X									X	INSTALL 200 FEET SOUTH OF EXISTING REVERSE CURVE SIGN			
		F	W13-1	18	18			2.25																X	MAINTAIN 10 FEET TO UTILITY POLE			
SB	8.350	F	W1-8	24	30		CHEVRON			1																		
SB	8.330	F	W1-8	24	30		CHEVRON			1																		
SB	8.305	F	W3-5	36	36		SPEED REDUCTION (40) 			1																		
SB	8.180	F	R2-1	30	36			7.50						1	X										INSTALL ACROSS FROM NEW NB SPEED LIMIT 50			
SIGN SUMMARY SHEET							SHEET TOTALS	39.75	0.00	3	0	0	4	0	0	6	90										PROJECT NAME: Stamford-Andover VT100	
								SF	SF	EA	EA	EA	EA	EA	EA	EA	FT									PROJECT NUMBER: STPG SIGN(20)		
VERMONT AGENCY OF TRANSPORTATION							TOWN TOTALS	1058.3	0.0	40.0	13.0	13.0	220	0.0	0.0	193	2895.0										FILE NAME: Whitingham.xls	
																										PLOT DATE: 8/5/2009		
																											DRAWN BY: I. Shea	
																											CHECKED BY: T. Guazzoni	
																											WHITINGHAM SHEET 19	
																											SHEET 55 OF 198	







DIRECTION	MILEPOINT	LOCATION CODE (SHEET 2)	SIGN CODE	WIDTH (IN)	HEIGHT (IN)	SHEETING REMARKS	SIGN LEGEND	NEW SIGNS		EXISTING SIGNS				EXIST POST		NUMBER OF NEW POSTS	SQUARE STEEL (IN)			TUBULAR STEEL Ø (IN)				SIGN FRAME REQUIRED	REMARKS	SIGN DETAIL												
								"A"	"B"	RETAIN	SALVAGE FROM	SALVAGE TO	REMOVE	RETAIN	REMOVE		(LB / FT)			(LB / FT)						DETAIL IN SHS	DETAIL ON SHEET NUMBER	DETAIL ON STD SHEET NUMBER										
																	1.75	2.00	2.50	3.00	3.50	4.00	5.00															
WHITINGHAM VT 100							FY-FLUORESCENT YELLOW FYG-FLUORESCENT YELLOW GREEN																"SHS"-STANDARD HIGHWAY SIGNS															
SB	8.150	F	R2-1	24	30		SPEED LIMIT 40																															
SB	8.040	F	VD-062B	72	16		BUSINESS SIGN			1																												
		F	VD-062B	72	16		BUSINESS SIGN			1																												
SB	8.000	F	W3-5	36	36		SPEED REDUCTION (30)			1																												
SB	7.980	F	VD-018	30	18									1																								
		F	VD-018	30	18			3.75																				E-128A										
SB	7.960	F	W11-8	30	30																																	
		F	W11-8	30	30			6.25																				X										
SB	7.910	F	R2-1	24	30		SPEED LIMIT 30																															
		F	W11-2YG	30	30		PEDESTRIAN																															
		F	W7-3AFY	24	18		NEXT 1/4 MILE																															
SB	7.890	F	R2-1	30	36			7.50																				6										
SB	7.880	F	W11-2YG	30	30		PEDESTRIAN																															
		F	W7-3AFY	24	18		NEXT 1/4 MILE																															
SB	7.810	F	D4-2	30	36		PARK & RIDE SYMBOL			1																												
SIGN SUMMARY SHEET							SHEET TOTALS	17.50	0.00	4	2	2	4	0	0	4	60																					
VERMONT AGENCY OF TRANSPORTATION								SF	SF	EA	EA	EA	EA	EA	EA	EA	FT																					
							TOWN TOTALS	1058.3	0.0	40.0	13.0	13.0	220	0.0	0.0	193	2895.0																					
PROJECT NAME: Stamford-Andover VT100																					PROJECT NUMBER: STPG SIGN(20)						FILE NAME: Whitingham.xls						PLOT DATE: 8/5/2009					
DESIGNED BY: J. Kelly																					DRAWN BY: N. Avery						CHECKED BY: T. Guazzoni						SHEET 56 OF 198					



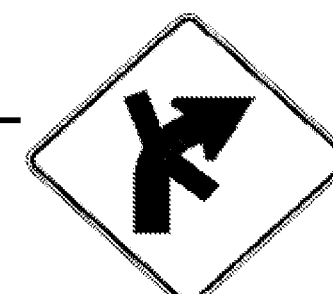
DIRECTION	MILEPOINT	LOCATION CODE (SHEET 2)	SIGN CODE	WIDTH (IN)	HEIGHT (IN)	SHEETING REMARKS	SIGN LEGEND	NEW SIGNS		EXISTING SIGNS			EXIST POST		NUMBER OF NEW POSTS	SQUARE STEEL (IN)			TUBULAR STEEL Ø (IN)				SIGN FRAME REQUIRED	REMARKS	SIGN DETAIL							
								"A"	"B"	RETAIN	SALVAGE FROM	SALVAGE TO	REMOVE	RETAIN		REMOVE	1.75	2.00	2.50	3.00	3.50	4.00			5.00	DETAIL IN SHS	DETAIL ON SHEET NUMBER	DETAIL ON STD SHEET NUMBER				
																	(LB / FT)			(LB / FT)												
WHITINGHAM VT 100							FY-FLUORESCENT YELLOW FYG-FLUORESCENT YELLOW GREEN															"SHS"-STANDARD HIGHWAY SIGNS										
		F	VD-365	30	6		PARK & RIDE PHONE NUMBER																									
SB	7.770	F	M2-1S	21	15																											
		F	M1-5	30	24																											
		F	M2-1	21	15			2.19																								
		F	M1-5	30	24			5.00																					E-136B			
		E	D4-2	30	36		PARK & RIDE SYMBOL			1	1																					
		E	VD-365	30	6		PARK & RIDE PHONE NUMBER																									
SB	7.740	F	W1-1R	30	30																											
		F	W13-1	18	18																											
		F	W1-1R	30	30			6.25																								
		F	W13-1	18	18			2.25																								
SB	7.648	F	D1-1A	72	10																											
		F	D1-1A	72	10																											
		F	D1-1M	72	10																											
		F	N/A				BRIGHAM YOUNG DESTINATION BOARD																						SIGN ALREADY REMOVED PRIOR TO PROJECT. ILLEGAL TOWN SIGN. RETURN TO TOWN			
SIGN SUMMARY SHEET							SHEET TOTALS		15.69	0.00	0	1	1	9	0	0	2	30														
VERMONT AGENCY OF TRANSPORTATION							SF	SF	EA	EA	EA	EA	EA	EA	EA	EA	EA	EA	FT													
							TOWN TOTALS		1058.3	0.0	40.0	13.0	13.0	220	0.0	0.0	193	2895.0														
							PROJECT NAME: Stamford-Andover VT100															PROJECT NUMBER: STPG SIGN(20)										
							FILE NAME: Whitingham.xls															PLOT DATE: 8/5/2009										
							PROJECT MANAGER: N. Avery															DRAWN BY: I. Shea										
							DESIGNED BY: J. Kelly															CHECKED BY: T. Guazzoni										
							WHITINGHAM SHEET 21															SHEET 57 OF 198										




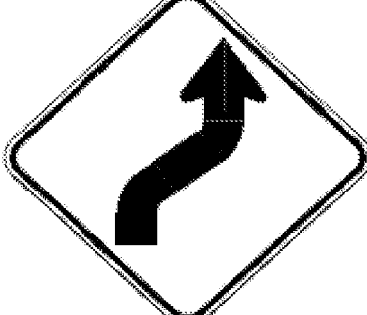



DIRECTION	MILEPOINT	LOCATION CODE (SHEET 2)	SIGN CODE	WIDTH (IN)	HEIGHT (IN)	SHEETING REMARKS	SIGN LEGEND	NEW SIGNS		EXISTING SIGNS				EXIST POST		NUMBER OF NEW POSTS	SQUARE STEEL (IN)			TUBULAR STEEL Ø (IN)				SIGN FRAME REQUIRED	REMARKS	SIGN DETAIL		
								"A"	"B"	RETAIN	SALVAGE FROM	SALVAGE TO	REMOVE	RETAIN	REMOVE		(LB / FT)			(LB / FT)						DETAIL IN SHS	DETAIL ON SHEET NUMBER	DETAIL ON STD SHEET NUMBER
																	1.75	2.00	2.50	3.00	3.50	4.00	5.00					
WHITINGHAM VT 100							FY-FLUORESCENT YELLOW FYG-FLUORESCENT YELLOW GREEN															"SHS"-STANDARD HIGHWAY SIGNS						
		F	D1-1A	72	12			6.00							2		X								5			
		F	D1-1A	72	12			6.00																	5			
		F	D1-1A	72	12			6.00																	5			
SB	7.648	E	M3-1	24	12		NORTH																					
		E	M1-5	24	24		VT 100																					
		E	M6-3	21	15		UP ARROW																					
		E	M4-5	24	12		TO																					
		E	M1-5	24	24		VT 8A																					
		E	VM-013	21	15		MODIFIED RIGHT ARROW																					
		E	M3-3	24	12		SOUTH																					
		E	M1-5	24	24		VT 112																					
		E	VM-013	21	15		MODIFIED RIGHT ARROW																					
SB	7.628	F	M3-3	24	12																							
		F	M1-5	24	24																							
		F	M3-3	24	12			2.00										X						GREEN ON WHITE SHEETING	X			
SIGN SUMMARY SHEET							SHEET TOTALS	20.00	0.00	0	0	0	11	0	0	3	45											
VERMONT AGENCY OF TRANSPORTATION							TOWN TOTALS	1058.3	0.0	40.0	13.0	13.0	220	0.0	0.0	193	2895.0											
PROJECT NAME: Stamford-Andover VT100																				PROJECT NUMBER: STPG SIGN(20)								
FILE NAME: Whitingham.xls										PLOT DATE: 8/5/2009																		
PROJECT MANAGER: N. Avery										DRAWN BY: I. Shea																		
DESIGNED BY: J. Kelly										CHECKED BY: T. Guazzoni																		
WHITINGHAM SHEET 22																				SHEET	58	OF	198					


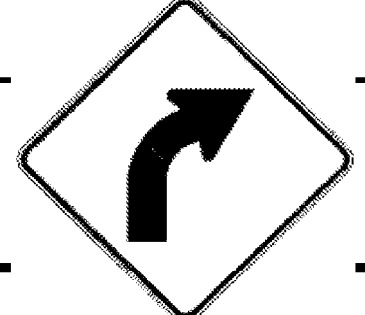


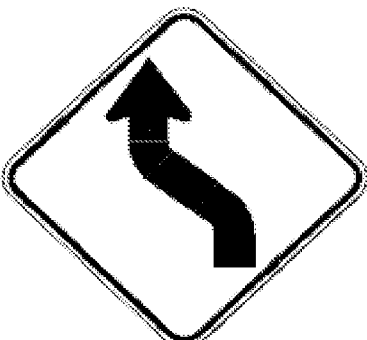

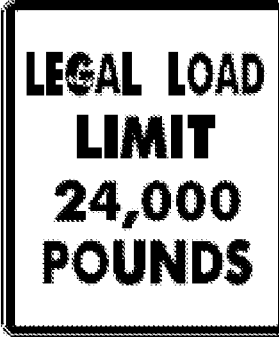
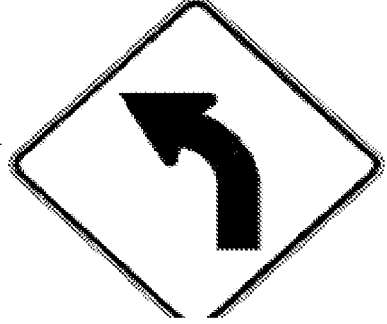


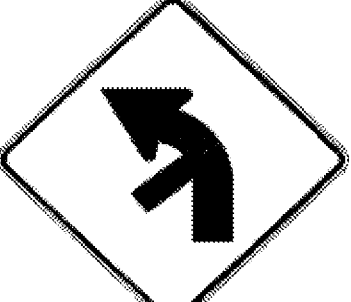DIRECTION	MILEPOINT	LOCATION CODE (SHEET 2)	SIGN CODE	WIDTH (IN)	HEIGHT (IN)	SHEETING REMARKS	SIGN LEGEND	NEW SIGNS		EXISTING SIGNS			EXIST POST		NUMBER OF NEW POSTS	SQUARE STEEL (IN)			TUBULAR STEEL Ø (IN)				SIGN FRAME REQUIRED	REMARKS	SIGN DETAIL			
								"A"	"B"	RETAIN	SALVAGE FROM	SALVAGE TO	REMOVE	RETAIN		REMOVE	1.75	2.00	2.50	3.00	3.50	4.00			5.00	DETAIL IN SHS	DETAIL ON SHEET NUMBER	DETAIL ON STD SHEET NUMBER
																	(LB / FT)			(LB / FT)								
WHITINGHAM VT 100							FY-FLUORESCENT YELLOW FYG-FLUORESCENT YELLOW GREEN															"SHS"-STANDARD HIGHWAY SIGNS						
SB	7.410	H	R1-1	30	30						1		X															
		H	R1-1	30	30			6.25						1		X										X		
SB	7.405	F	R2-1	24	30						1		X															
		F	R2-1	24	30			5.00						1		X										X		
SB	7.383	F	W1-8	18	24							1		X														
		F	W1-8	18	24	FY		3.00						1		X										X		
SB	7.383	E	W1-8	18	24						1		X															
		E	W1-8	18	24	FY		3.00						1		X										X		
SB	7.368	F	W1-8	18	24		CHEVRON				1		X															
SB	7.368	E	W1-8	18	24		CHEVRON				1		X															
SB	7.358	F	W1-8	18	24						1		X															
		F	W1-8	18	24	FY		3.00						1		X										X		
SB	7.358	E	W1-8	18	24						1		X															
		E	W1-8	18	24	FY		3.00			-			1		X										X		
SB	7.333	F	W1-8	18	24			3.00						1		X										X		
SIGN SUMMARY SHEET							SHEET TOTALS	26.25	0.00	0	0	0	8	0	0	7	105							PROJECT NAME: Stamford-Andover VT100				
VERMONT AGENCY OF TRANSPORTATION							TOWN TOTALS	1058.3	0.0	40.0	13.0	13.0	220	0.0	0.0	193	2895.0							PROJECT NUMBER: STPG SIGN(20)				
								SF	SF	EA	EA	EA	EA	EA	EA	EA	FT							FILE NAME: Whitingham.xls				
																								PLOT DATE: 8/5/2009				
																								DRAWN BY: I. Shea				
																								DESIGNED BY: J. Kelly				
																								CHECKED BY: T. Guazzoni				
																								SHEET 60 OF 198				

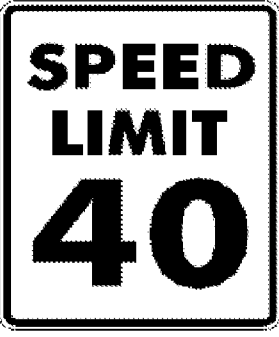DIRECTION	MILEPOINT	LOCATION CODE (SHEET 2)	SIGN CODE	WIDTH (IN)	HEIGHT (IN)	SHEETING REMARKS	SIGN LEGEND	NEW SIGNS		EXISTING SIGNS			EXIST POST		NUMBER OF NEW POSTS	SQUARE STEEL (IN)			TUBULAR STEEL Ø (IN)				SIGN FRAME REQUIRED	REMARKS	SIGN DETAIL				
								"A"	"B"	RETAIN	SALVAGE FROM	SALVAGE TO	REMOVE	RETAIN		REMOVE	1.75	2.00	2.50	FOUNDATION	3.00	3.50			4.00	5.00	DETAIL IN SHS	DETAIL ON SHEET NUMBER	DETAIL ON STD SHEET NUMBER
																	(LB / FT)				(LB / FT)								
WHITINGHAM VT 100							FY-FLUORESCENT YELLOW FYG-FLUORESCENT YELLOW GREEN															"SHS"-STANDARD HIGHWAY SIGNS							
SB	7.410	H	R1-1	30	30						1		X																
		H	R1-1	30	30			6.25						1		X									TH-42, ACADEMY RD	X			
SB	7.405	F	R2-1	24	30						1		X																
		F	R2-1	24	30			5.00						1		X										X			
SB	7.383	F	W1-8	18	24						1		X																
		F	W1-8	18	24	FY		3.00						1		X										X			
SB	7.383	E	W1-8	18	24						1		X																
		E	W1-8	18	24	FY		3.00						1		X										X			
SB	7.368	F	W1-8	18	24		CHEVRON				1		X																
SB	7.368	E	W1-8	18	24		CHEVRON				1		X																
SB	7.358	F	W1-8	18	24						1		X																
		F	W1-8	18	24	FY		3.00						1		X										X			
SB	7.358	E	W1-8	18	24						1		X																
		E	W1-8	18	24	FY		3.00			-			1		X										X			
SB	7.333	F	W1-8	18	24									1		X													
		F	W1-8	18	24			3.00						1		X										X			
SIGN SUMMARY SHEET							SHEET TOTALS	26.25	0.00	0	0	0	8	0	0	7	105							PROJECT NAME: Stamford-Andover VT100					
								SF	SF	EA	EA	EA	EA	EA	EA	EA	FT							PROJECT NUMBER: STPG SIGN(20)					
VERMONT AGENCY OF TRANSPORTATION							TOWN TOTALS	1058.3	0.0	40.0	13.0	13.0	220	0.0	0.0	193	2895.0							FILE NAME: Whitingham.xls					
																							PLOT DATE: 8/5/2009						
																							DRAWN BY: I. Shea						
																							DESIGNED BY: J. Kelly						
																							CHECKED BY: T. Guazzoni						
																							WHITINGHAM SHEET 24						
																							SHEET 60 OF 198						

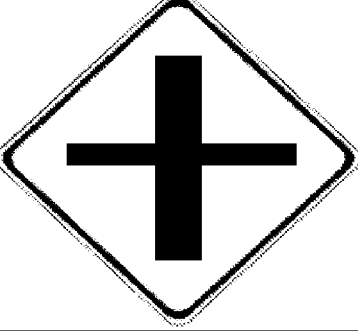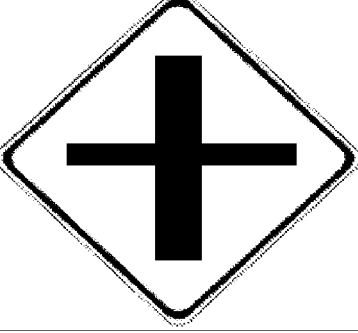






DIRECTION	MILEPOINT	LOCATION CODE (SHEET 2)	SIGN CODE	WIDTH (IN)	HEIGHT (IN)	SHEETING REMARKS	SIGN LEGEND	NEW SIGNS		EXISTING SIGNS			EXIST POST		NUMBER OF NEW POSTS	SQUARE STEEL (IN)			TUBULAR STEEL Ø (IN)				SIGN FRAME REQUIRED	REMARKS	SIGN DETAIL										
								"A"	"B"	RETAIN	SALVAGE FROM	SALVAGE TO	REMOVE	RETAIN		REMOVE	1.75	2.00	2.50	FOUNDATION	3.00	3.50			4.00	5.00	DETAIL IN SHS	DETAIL ON SHEET NUMBER	DETAIL ON STD SHEET NUMBER						
																	(LB / FT)				(LB / FT)														
WHITINGHAM VT 100							FY-FLUORESCENT YELLOW FYG-FLUORESCENT YELLOW GREEN															"SHS"-STANDARD HIGHWAY SIGNS													
SB	7.333	E	W1-8	18	24	FY		3.00						1		X								X											
SB	7.128	F	R2-1	24	30		SPEED LIMIT 50 				1																								
SB	7.103	F	R2-1	24	30			5.00						1		X											INSTALL ¹⁵⁰ 125 FEET SOUTH OF EXISTING SPEED LIMIT 50 SIGN	X							
SB	7.098	F	W1-5L	30	30		LEFT WINDING ROAD 				1																								
SB	7.065	F	W1-4R	30	30			6.25						1		X																			
SB	6.964	F	OM-3R	12	36		OBJECT MARKER (RIGHT)					+																							
SB	6.955	E	OM-3L	12	36		OBJECT MARKER (LEFT)					+																							
SB	6.774	F	VW-202	30	30		TRUCKS ENTERING 					1																							
SB	6.645	F	VW-202	30	30			6.25						1		X																			
SB	6.607	F	S1-1YG	36	36		SCHOOL PENTAGON			1																									
		F	W16-9YG	24	12		AHEAD			1																									
SB	6.542	F	OM-3R	12	36		RIGHT OBJECT MARKER					1																							
SB	6.538	F	OM-3L	12	36		LEFT OBJECT MARKER					1																							
SB	6.525	F	W11-6(H)	30	30			6.25						1		X																			
SB	6.355	F	W1-2R	30	30			6.25						1		X																			
SIGN SUMMARY SHEET							SHEET TOTALS	33.00	0.00	4	2	0	0	5	7	0	0	6	90																
VERMONT AGENCY OF TRANSPORTATION							TOWN TOTALS	1058.3	0.0	40.0	13.0	13.0	220	0.0	0.0	193	2895.0																		
																					PROJECT NAME:	Stamford-Andover VT100													
																					PROJECT NUMBER:	STPG SIGN(20)													
											FILE NAME:	Whitingham.xls						PLOT DATE:	8/5/2009																
											PROJECT MANAGER:	N. Avery						DRAWN BY:	I. Shea																
											DESIGNED BY:	J. Kelly						CHECKED BY:	T. Guazzoni																
																					WHITINGHAM SHEET 25							SHEET	61		OF	198			



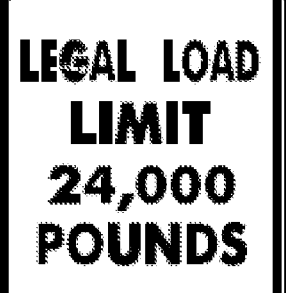

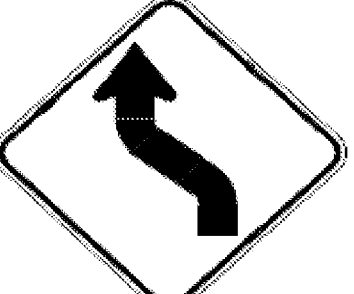



DIRECTION	MILEPOINT	LOCATION CODE (SHEET 2)	SIGN CODE	WIDTH (IN)	HEIGHT (IN)	SHEETING REMARKS	SIGN LEGEND	NEW SIGNS		EXISTING SIGNS			EXIST POST		NUMBER OF NEW POSTS	SQUARE STEEL (IN)			TUBULAR STEEL Ø (IN)				SIGN FRAME REQUIRED	REMARKS	SIGN DETAIL				
								"A"	"B"	RETAIN	SALVAGE FROM	SALVAGE TO	REMOVE	RETAIN		REMOVE	1.75	2.00	2.50	FOUNDATION	3.00	3.50			4.00	5.00	DETAIL IN SHS	DETAIL ON SHEET NUMBER	DETAIL ON STD SHEET NUMBER
																	(LB / FT)				(LB / FT)								
WHITINGHAM VT 100							FY-FLUORESCENT YELLOW FYG-FLUORESCENT YELLOW GREEN															"SHS"-STANDARD HIGHWAY SIGNS							
SB	6.133	F	W1-4L	30	30		LEFT REVERSE CURVE																						
		F	W13-1	18	18		40 MPH PLAQUE																						
																													
																													
SB	6.068	F	W1-4L	30	30			6.25																					
		F	W13-1	18	18			2.25																					
SB	6.018	F	W2-1M	30	30		CROSSROAD MODIFIED																						
																													
SB	5.970	F	W1-2MmR	30	30			6.25																		7			
SB	5.883	G	VR-017	24	30		LEGAL LOAD LIMIT 24,000 POUNDS																						
		G	VR-017	24	30			5.00																		E-141			
SB	5.875	H	R1-1	30	30		STOP WILMINGTON CROSS RD																						
		H	R1-1	30	30		1000 1321 0588	6.25																					
SB	5.786	F	M3-3	24	12																								
		F	M1-5A	24	24																								
		F	M3-3	24	12		SOUTH VERMONT	2.00																					
		F	M1-5	30	24		100	5.00																		E-136B			
SB	5.140	F	S3-1	30	30		SCHOOL BUS STOP AHEAD																						
SIGN SUMMARY SHEET							SHEET TOTALS	33.00	0.00	0	0	0	8	0	0	5	75	PROJECT NAME: Stamford-Andover VT100											
								SF	SF	EA	EA	EA	EA	EA	EA	EA	FT	PROJECT NUMBER: STPG SIGN(20)											
																		FILE NAME: Whitingham.xls PLOT DATE: 8/5/2009											
																		PROJECT MANAGER: N. Avery DRAWN BY: I. Shea											
VERMONT AGENCY OF TRANSPORTATION							TOWN TOTALS	1058.3	0.0	40.0	13.0	13.0	220	0.0	0.0	193	2895.0	DESIGNED BY: J. Kelly CHECKED BY: T. Guazzoni											
																		WHITINGHAM SHEET 26 SHEET 62 OF 198											



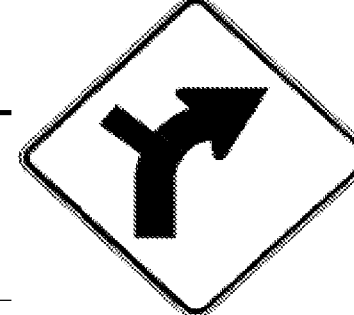


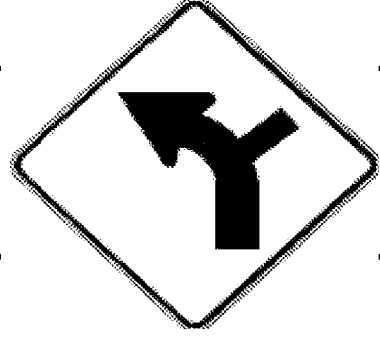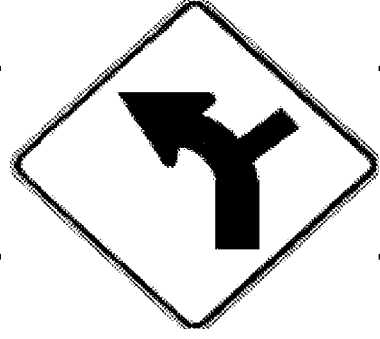
DIRECTION	MILEPOINT	LOCATION CODE (SHEET 2)	SIGN CODE	WIDTH (IN)	HEIGHT (IN)	SHEETING REMARKS	SIGN LEGEND	NEW SIGNS		EXISTING SIGNS			EXIST POST		NUMBER OF NEW POSTS	SQUARE STEEL (IN)			TUBULAR STEEL Ø (IN)				SIGN FRAME REQUIRED	REMARKS	SIGN DETAIL				
								"A"	"B"	RETAIN	SALVAGE FROM	SALVAGE TO	REMOVE	RETAIN		REMOVE	1.75	2.00	2.50	3.00	3.50	4.00			5.00	DETAIL IN SHS	DETAIL ON SHEET NUMBER	DETAIL ON STD SHEET NUMBER	
																	(LB / FT)			(LB / FT)									
WHITINGHAM VT 100							FY-FLUORESCENT YELLOW FYG-FLUORESCENT YELLOW GREEN														"SHS"-STANDARD HIGHWAY SIGNS								
SB	5.102	F	W1-2L	30	30		LEFT CURVE																						
		F	W13-1	18	18		40 MPH PLAQUE																						
SB	5.090	G	VR-017	24	30																								
		G	VR-017	24	30			5.00											X						TH-15, CORSE RD			E-141	
SB	5.084	H	R1-1	30	30																					SALVAGED STREET SIGN AND MM ONTO NEW POST.			
		H	R1-1	30	30			6.25																	X	TH-15, CORSE RD		X	
SB	5.056 5.065	F	W1-2MbL	30	30			6.25																					
		F	S3-1	30	30			6.25																					
SB	4.740	F	W3-5	36	36		SPEED REDUCTION (40)			1																			
SB	4.675	F	VD-062B	72	16		BUSINESS SIGN			1																			
SB	4.640	F	VW-054R	30	30																								
		F	VW-054R	30	30			6.25																					
SB	4.600	F	R2-1	24	30																								
		F	R2-1	30	36			7.50																					
SB	4.549	F	W2-1	30	30																								
SIGN SUMMARY SHEET							SHEET TOTALS	37.50	0.00	2	0	0	7	0	0	6	90										PROJECT NAME: Stamford-Andover VT100		
								SF	SF	EA	EA	EA	EA	EA	EA	EA	FT									PROJECT NUMBER: STPG SIGN(20)			
VERMONT AGENCY OF TRANSPORTATION							TOWN TOTALS	1058.3	0.0	40.0	13.0	13.0	220	0.0	0.0	193	2895.0									FILE NAME: Whitingham.xls	PLOT DATE: 8/5/2009		
																										PROJECT MANAGER: N. Avery	DRAWN BY: I. Shea		
																										DESIGNED BY: J. Kelly	CHECKED BY: T. Guazzoni		
																										WHITINGHAM SHEET 27	SHEET 63 OF 198		




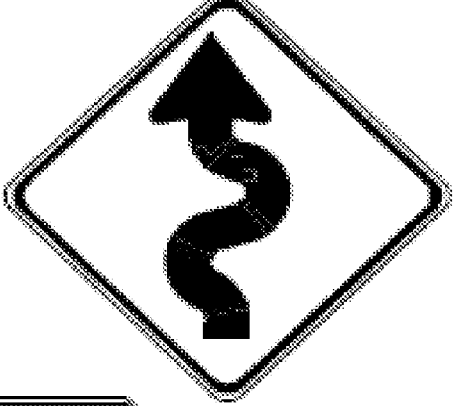
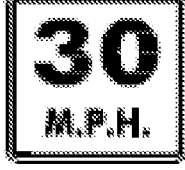

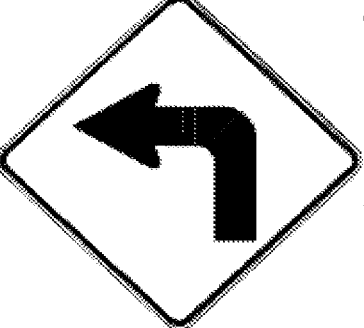


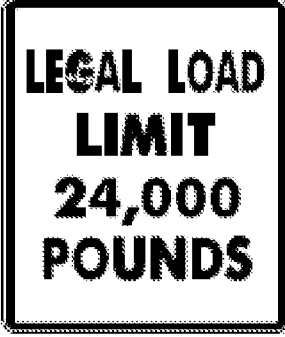
DIRECTION	MILEPOINT	LOCATION CODE (SHEET 2)	SIGN CODE	WIDTH (IN)	HEIGHT (IN)	SHEETING REMARKS	SIGN LEGEND	NEW SIGNS		EXISTING SIGNS			EXIST POST		NUMBER OF NEW POSTS	SQUARE STEEL (IN)			TUBULAR STEEL Ø (IN)				SIGN FRAME REQUIRED	REMARKS	SIGN DETAIL					
								"A"	"B"	RETAIN	SALVAGE FROM	SALVAGE TO	REMOVE	RETAIN		REMOVE	1.75	2.00	2.50	FOUNDATION	3.00	3.50			4.00	5.00	DETAIL IN SHS	DETAIL ON SHEET NUMBER	DETAIL ON STD SHEET NUMBER	
																	(LB / FT)				(LB / FT)									
WHITINGHAM VT 100							FY-FLUORESCENT YELLOW FYG-FLUORESCENT YELLOW GREEN															"SHS"-STANDARD HIGHWAY SIGNS								
			F W2-1Mb	30	30			6.25						1	X										6					
SB	4.432		F W3-5	36	36		SPEED REDUCTION (30) 			1				X																
SB	4.415		G VR-017	24	30		 	5.00						1	X											SALVAGED SPEED LIMIT 30MPH. RE-INSTALLED UNDER LL24 TH-17, MAPLE DR			E-141	
SB	4.411		H R1-1	30	30		 				1			X												SALVAGED STREET SIGN ONTO NEW POST.				
			H R1-1	30	30			6.25						1	X											TH-17, MAPLE DR	X			
SB	4.385		F VD-018	30	18							1		X												INSTALL APPROX 20 FEET NORTH OF EXISTING AND 10 FEET AWAY FROM POLE			E-128A	
			F VD-018	30	18			3.75						1	X															
SB	4.360		F VW-054L	30	30							1		X																
			F W1-2L	30	30							1		X																
			F W1-2L	30	30			6.25						2	X												INSTALL LEFT CURVE SIGN ON TOP	X		
			F VW-054L	30	30			6.25																						
SB	4.320		F R2-1	24	30							1		X													SHOULD BE INSTALLED DIRECTLY ACROSS FROM NB SPEED LIMIT 40 SIGN			6
			F R2-1	30	36			7.50						1	X															
SB	4.281		E OM-3L	12	36		VERTICAL OBJECT MARKER (LEFT)					1		X																
SB	4.231		F S3-1	30	30		SCHOOL BUS STOP AHEAD					1		X																
SIGN SUMMARY SHEET							SHEET TOTALS	41.25	0.00	1	2	2	7	0	0	7	105											PROJECT NAME: Stamford-Andover VT100		
								SF	SF	EA	EA	EA	EA	EA	EA	EA	FT											PROJECT NUMBER: STPG SIGN(20)		
VERMONT AGENCY OF TRANSPORTATION							TOWN TOTALS	1058.3	0.0	40.0	13.0	13.0	220	0.0	0.0	193	2895.0											FILE NAME: Whitingham.xls		
																											PLOT DATE: 8/5/2009			
																												DRAWN BY: I. Shea		
																												DESIGNED BY: J. Kelly		
																												CHECKED BY: T. Guazzoni		
																												WHITINGHAM SHEET 28		
																												SHEET 64 OF 198		



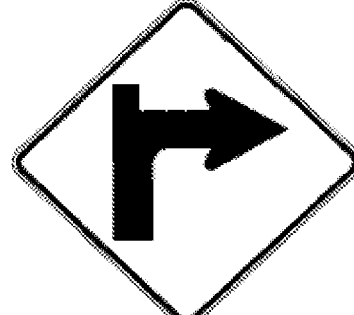


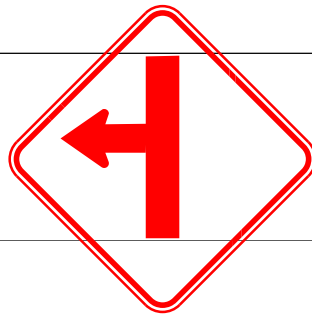

DIRECTION	MILEPOINT	LOCATION CODE (SHEET 2)	SIGN CODE	WIDTH (IN)	HEIGHT (IN)	SHEETING REMARKS	SIGN LEGEND	NEW SIGNS		EXISTING SIGNS			EXIST POST		NUMBER OF NEW POSTS	SQUARE STEEL (IN)			TUBULAR STEEL Ø (IN)				SIGN FRAME REQUIRED	REMARKS	SIGN DETAIL					
								"A"	"B"	RETAIN	SALVAGE FROM	SALVAGE TO	REMOVE	RETAIN		REMOVE	1.75	2.00	2.50	FOUNDATION	3.00	3.50			4.00	5.00	DETAIL IN SHS	DETAIL ON SHEET NUMBER	DETAIL ON STD SHEET NUMBER	
																	(LB / FT)				(LB / FT)									
WHITINGHAM VT 100							FY-FLUORESCENT YELLOW FYG-FLUORESCENT YELLOW GREEN															"SHS"-STANDARD HIGHWAY SIGNS								
			F W1-3R	30	30		RIGHT REVERSE CURVE																							
			F W13-1	18	18		20 MPH PLAQUE																							
SB	4.210		F S3-1	30	30	FY		6.25							2		X													
			F W1-3R	30	30	FY			6.25																					
			F W13-1	18	18	FY			2.25																					
SB	4.168		F W11-2YG	30	30		PEDESTRIAN SYMBOL			1				X																
			F W16-4YG	24	18		NEXT 500 FEET			1																				
SB	4.044		G VR-017	24	30																									
			G VR-017	24	30				5.00						1		X													
			G N/A					TOWN SIGN - SLOW CHILDREN																						
SB	4.038		H R1-1	30	30																									
			H R1-1	30	30			6.25							1		X													
SB	3.991		G VR-017	24	30			5.00									X													
			G N/A				SLOW CHILDREN																							
SB	3.986		H R1-1	30	30																									
SIGN SUMMARY SHEET							SHEET TOTALS	31.00	0.00	2	2	2	7	0	0	5		75												
VERMONT AGENCY OF TRANSPORTATION							TOWN TOTALS	1058.3	0.0	40.0	13.0	13.0	220	0.0	0.0	193		2895.0												
							PROJECT NAME:	Stamford-Andover VT100																						
							PROJECT NUMBER:	STPG SIGN(20)																						
							FILE NAME:	Whitingham.xls											PLOT DATE:	8/5/2009										
							PROJECT MANAGER:	N. Avery											DRAWN BY:	I. Shea										
							DESIGNED BY:	J. Kelly											CHECKED BY:	T. Guazzoni										
							WHITINGHAM SHEET 29	SHEET 65 OF 198																						

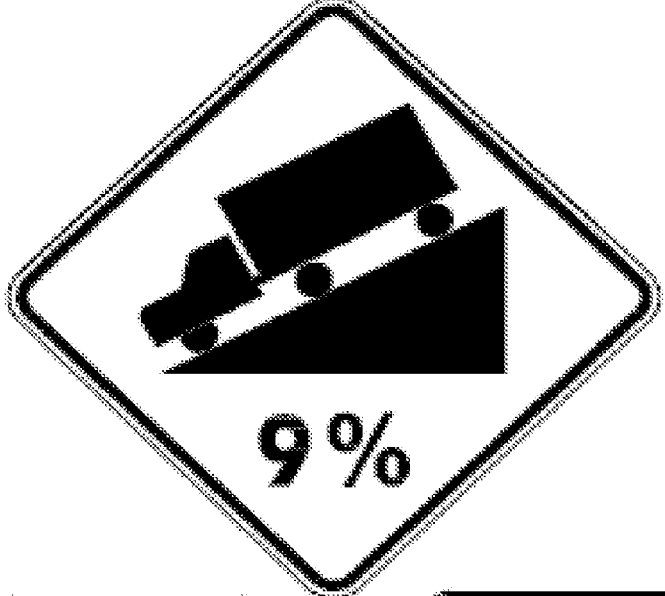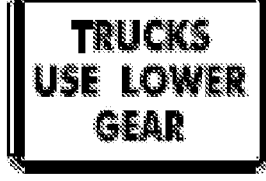DIRECTION	MILEPOINT	LOCATION CODE (SHEET 2)	SIGN CODE	WIDTH (IN)	HEIGHT (IN)	SHEETING REMARKS	SIGN LEGEND	NEW SIGNS		EXISTING SIGNS			EXIST POST		NUMBER OF NEW POSTS	SQUARE STEEL (IN)			TUBULAR STEEL Ø (IN)				SIGN FRAME REQUIRED	REMARKS	SIGN DETAIL			
								"A"	"B"	RETAIN	SALVAGE FROM	SALVAGE TO	REMOVE	RETAIN		REMOVE	1.75	2.00	2.50	3.00	3.50	4.00			5.00	DETAIL IN SHS	DETAIL ON SHEET NUMBER	DETAIL ON STD SHEET NUMBER
																	(LB / FT)			(LB / FT)								
WHITINGHAM VT 100							FY-FLUORESCENT YELLOW FYG-FLUORESCENT YELLOW GREEN															"SHS"-STANDARD HIGHWAY SIGNS						
SB	3.986	H	R1-1	30	30		 	6.25						1		X							TH-11, BROOK ST	X				
SB	3.984	F	R2-1	24	30		SPEED LIMIT 30 				1																	
SB	3.900	F	W1-10L	30	30			6.25						1		X							INSTALL 200 FEET NORTH OF EXISTING SPEED LIMIT 40 SIGN	X				
SB	3.861	F	R2-1	24	30		SPEED LIMIT 40			1																		
SB	3.822	G	VR-017	24	30							1																
		G	VR-017	24	30			5.00						1		X							TH-12, BRICKHOUSE RD			E-141		
SB	3.817	H	R1-1	30	30																							
		H	R1-1	30	30			6.25						1		X							TH-12, BRICKHOUSE RD	X				
SB	3.811	F	VR-020	24	30		NO PARKING ON TRAVELED LANES			1																		
SB	3.786	F	M3-3S	24	12		SOUTH			1																		
		F	M1-5	30	24		VERMONT 100			1																		
SB	3.771	F	VR-020	24	30		NO PARKING ON TRAVELED LANES			1																		
SB	3.732	F	R2-1	24	30		SPEED LIMIT 40			1																		
SB	3.480	G	VM-607	24	30		43RD INF DIV MEMORIAL HIGHWAY			1																		
SB	3.477	F	R2-1	24	30		SPEED LIMIT 50			1																		
SIGN SUMMARY SHEET							SHEET TOTALS	23.75	0.00	8	0	0	3	0	0	4	60						PROJECT NAME: Stamford-Andover VT100					
								SF	SF	EA	EA	EA	EA	EA	EA	EA	FT					PROJECT NUMBER: STPG SIGN(20)						
VERMONT AGENCY OF TRANSPORTATION							TOWN TOTALS	1058.3	0.0	40.0	13.0	13.0	220	0.0	0.0	193	2895.0					FILE NAME: Whitingham.xls	PLOT DATE: 8/5/2009					
																					PROJECT MANAGER: N. Avery	DRAWN BY: I. Shea						
																					DESIGNED BY: J. Kelly	CHECKED BY: T. Guazzoni						
																					WHITINGHAM SHEET 30	SHEET 66	OF 198					


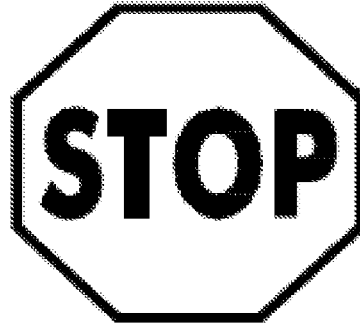
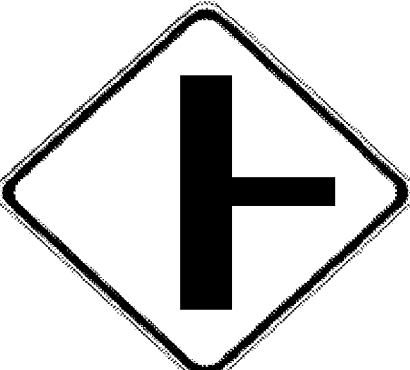








DIRECTION	MILEPOINT	LOCATION CODE (SHEET 2)	SIGN CODE	WIDTH (IN)	HEIGHT (IN)	SHEETING REMARKS	SIGN LEGEND	NEW SIGNS		EXISTING SIGNS			EXIST POST		NUMBER OF NEW POSTS	SQUARE STEEL (IN)			TUBULAR STEEL Ø (IN)				SIGN FRAME REQUIRED	REMARKS	SIGN DETAIL				
								"A"	"B"	RETAIN	SALVAGE FROM	SALVAGE TO	REMOVE	RETAIN		REMOVE	1.75	2.00	2.50	FOUNDATION	3.00	3.50			4.00	5.00	DETAIL IN SHS	DETAIL ON SHEET NUMBER	DETAIL ON STD SHEET NUMBER
																	(LB / FT)				(LB / FT)								
WHITINGHAM VT 100							FY-FLUORESCENT YELLOW FYG-FLUORESCENT YELLOW GREEN															"SHS"-STANDARD HIGHWAY SIGNS							
SB	3.063	G	VR-017	24	30						1		X																
		G	VR-017	24	30			5.00						1		X									E-141				
SB	3.058	H	R1-1	30	30						1		X																
		H	R1-1	30	30			6.25						1		X								X					
SB	2.932	G	VR-017	24	30																								
		G	VR-017	24	30			5.00						1		X									TH-32, PIKE RD				
SB	2.927	H	R1-1	30	30						1		X																
		H	R1-1	30	30			6.25						1		X								X					
SB	2.575	F	N/A				EMPTY POST						X																
		F	W1-4L	30	30																			X					
SB	2.309	F	W1-4R	30	30		RIGHT REVERSE CURVE				1		X																
SB	2.275	F	VW-054R	30	30		HIDDEN DRIVE RIGHT				1		X																
		F	W1-4R	30	30																			X					
		F	W13-1	18	18																			X					
SB	2.237	F	VW-054R	30	30																				E-154				
SB	2.211 2-130	F	S3-1	30	30		SCHOOL BUS STOP AHEAD				1		X																
SIGN SUMMARY SHEET							SHEET TOTALS	49.75 43.50	0.00	0	0	0	6	0	0	7	105						PROJECT NAME: Stamford-Andover VT100						
VERMONT AGENCY OF TRANSPORTATION							TOWN TOTALS	1058.3	0.0	40.0	13.0	13.0	220	0.0	0.0	193	2895.0						PROJECT NUMBER: STPG SIGN(20)						
																						FILE NAME: Whitingham.xls		PLOT DATE: 8/5/2009					
																						PROJECT MANAGER: N. Avery		DRAWN BY: I. Shea					
																						DESIGNED BY: J. Kelly		CHECKED BY: T. Guazzoni					
																						WHITINGHAM SHEET 31		SHEET 67 OF 198					




DIRECTION	MILEPOINT	LOCATION CODE (SHEET 2)	SIGN CODE	WIDTH (IN)	HEIGHT (IN)	SHEETING REMARKS	SIGN LEGEND	NEW SIGNS		EXISTING SIGNS			EXIST POST		NUMBER OF NEW POSTS	SQUARE STEEL (IN)			TUBULAR STEEL Ø (IN)				SIGN FRAME REQUIRED	REMARKS	SIGN DETAIL			
								"A"	"B"	RETAIN	SALVAGE FROM	SALVAGE TO	REMOVE	RETAIN		REMOVE	1.75	2.00	2.50	3.00	3.50	4.00			5.00	DETAIL IN SHS	DETAIL ON SHEET NUMBER	DETAIL ON STD SHEET NUMBER
																	(LB / FT)			(LB / FT)								
WHITINGHAM VT 100							FY-FLUORESCENT YELLOW FYG-FLUORESCENT YELLOW GREEN															"SHS"-STANDARD HIGHWAY SIGNS						
SB	2.085	F	W1-1MR	30	30		RIGHT TURN WITH LEFT SIDE ROAD																					
		F	W13-1	18	18		30 MPH PLAQUE																					
SB	2.028	F	W1-1MbR	30	30			6.25															INSTALL 300 FEET SOUTH OF EXISTING RIGHT TURN ASSEMBLY		6			
			W13-1	18	18			2.25																X				
SB	1.635	F	N/A				EMPTY POST																					
SB	1.400	F	W1-2R	30	30		RIGHT CURVE																					
		F	W13-1	18	18		35 MPH PLAQUE																					
SB	1.353	F	W1-10R	30	30			6.25															INSTALL 250 FEET SOUTH OF EXISTING RH CURVE ASSEMBLY	X				
		F	W13-1	18	18			2.25																X				
SB	1.027	F	W3-5	36	36			9.00															INSTALL 300 FEET NORTH OF SPEED LIMIT 40 ASSEMBLY	X				
SB	0.970	F	R2-1	24	30																							
		F	R2-1	30	36			7.50																	6			
SB	0.900	F	W7-1	30	30		TRUCK HILL SYMBOL																					
		F	W1-5L	30	30		WINDING ROAD LEFT																					
		F	W7-2B	24	18																							
SIGN SUMMARY SHEET							SHEET TOTALS	33.50	0.00	0	0	0	8	0	0	5	75							PROJECT NAME: Stamford-Andover VT100				
VERMONT AGENCY OF TRANSPORTATION							TOWN TOTALS	1058.3	0.0	40.0	13.0	13.0	220	0.0	0.0	193	2895.0							PROJECT NUMBER: STPG SIGN(20)				
								SF	SF	EA	EA	EA	EA	EA	EA	EA	FT							FILE NAME: Whitingham.xls	PLOT DATE: 8/5/2009			
																								PROJECT MANAGER: N. Avery	DRAWN BY: I. Shea			
																								DESIGNED BY: J. Kelly	CHECKED BY: T. Guazzoni			
																								WHITINGHAM SHEET 32	SHEET 68 OF 198			


DIRECTION	MILEPOINT	LOCATION CODE (SHEET 2)	SIGN CODE	WIDTH (IN)	HEIGHT (IN)	SHEETING REMARKS	SIGN LEGEND	NEW SIGNS		EXISTING SIGNS			EXIST POST		NUMBER OF NEW POSTS	SQUARE STEEL (IN)			TUBULAR STEEL Ø (IN)				SIGN FRAME REQUIRED	REMARKS	SIGN DETAIL					
								"A"	"B"	RETAIN	SALVAGE FROM	SALVAGE TO	REMOVE	RETAIN		REMOVE	1.75	2.00	2.50	FOUNDATION	3.00	3.50			4.00	5.00	DETAIL IN SHS	DETAIL ON SHEET NUMBER	DETAIL ON STD SHEET NUMBER	
																	(LB / FT)				(LB / FT)									
WHITINGHAM VT 100							FY-FLUORESCENT YELLOW FYG-FLUORESCENT YELLOW GREEN															"SHS"-STANDARD HIGHWAY SIGNS								
			F W7-1B	30	30			6.25						2	X										X					
			F W7-2B	24	18			3.00																		X	INSTALL ON LEFT HAND POST			
			F W7-3a	24	18			3.00																		X	INSTALL ON RIGHT HAND POST			
SB	0.860		F W1-1L	30	30	LEFT TURN	 					1	X																	
			F W13-1	18	18	30 MPH PLAQUE						1																		
			F W1-5L	30	30		  	6.25							2	X												X		
			F W13-1	18	18			2.25																						
			F W7-3a	24	18			3.00																		X	INSTALL ON RIGHT HAND POST			
SB	0.788		F W1-1L	30	30		 	6.25																			X	INSTALL 100 FEET NORTH OF DRIVE ON CORNER		
			F W13-1	18	18			2.25																		X				
SB	0.683		F R2-1	24	30							1	X																	
			F R2-1	24	30			5.00							1	X										X				
SB	0.268		F OM-3R	12	36							1	X																	
			F OM-3R	12	36			3.00							1	X										X				
SB	0.264		E OM-3L	12	36							1	X																	
SIGN SUMMARY SHEET							SHEET TOTALS	40.25	0.00	0	0	0	6	0	0	7	90													
VERMONT AGENCY OF TRANSPORTATION							TOWN TOTALS	1058.3	0.0	40.0	13.0	13.0	220	0.0	0.0	193	2895.0													
															PROJECT NAME:	Stamford-Andover VT100														
															PROJECT NUMBER:	STPG SIGN(20)														
															FILE NAME:	Whitingham.xls					PLOT DATE:	8/5/2009								
															PROJECT MANAGER:	N. Avery					DRAWN BY:	I. Shea								
															DESIGNED BY:	J. Kelly					CHECKED BY:	T. Guazzoni								
															WHITINGHAM SHEET	33					SHEET	69 OF 198								

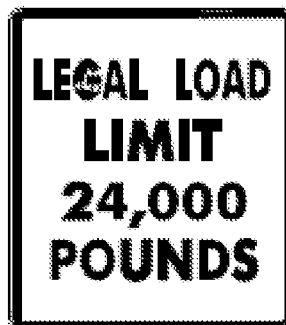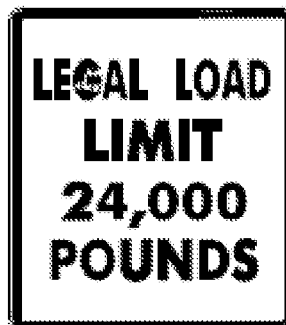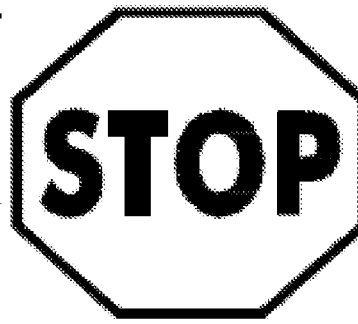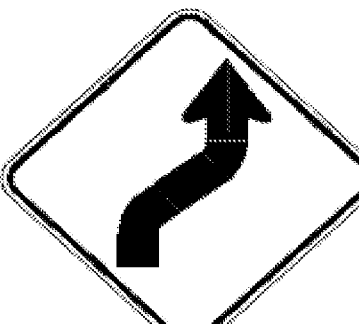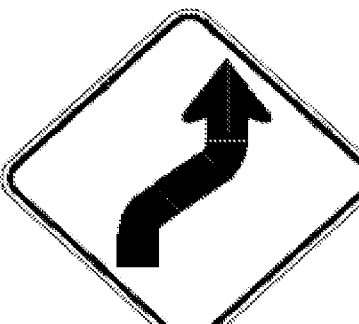


DIRECTION	MILEPOINT	LOCATION CODE (SHEET 2)	SIGN CODE	WIDTH (IN)	HEIGHT (IN)	SHEETING REMARKS	SIGN LEGEND	NEW SIGNS		EXISTING SIGNS			EXIST POST		NUMBER OF NEW POSTS	SQUARE STEEL (IN)			TUBULAR STEEL Ø (IN)				SIGN FRAME REQUIRED	REMARKS	SIGN DETAIL			
								"A"	"B"	RETAIN	SALVAGE FROM	SALVAGE TO	REMOVE	RETAIN		REMOVE	1.75	2.00	2.50	3.00	3.50	4.00			5.00	DETAIL IN SHS	DETAIL ON SHEET NUMBER	DETAIL ON STD SHEET NUMBER
																	(LB / FT)			(LB / FT)								
WHITINGHAM VT 100							FY-FLUORESCENT YELLOW FYG-FLUORESCENT YELLOW GREEN															"SHS"-STANDARD HIGHWAY SIGNS						
SB	0.264	E	OM-3L	12	36			3.00						1	X									X				
NB	0.191	A	W5-2	30	30			6.25															NEW SIGNS INSTALLED BY THE CONTRACTOR PER RECOMMENDATION OF M. MILLER, TRAFFIC OPS.					
SB	0.358	A	W5-2	30	30			6.25																				
NB	6.868	A	W5-2	36	36			—															THESE TWO LARGER NEW SIGNS WERE INSTALLED IN LATE 2011. THEY WERE INSTALLED BY STATE FORCES AS PART OF A WORK ORDER SUBMITTED BY TRAFFIC OPS.					
SB	7.026	A	W5-2	36	36			—																				
NB	7.650	A	WI-IMBL	30	30			6.25															THESE TWO NEW SIGNS WERE MISTAKENLY OMITTED FROM THE PROJECT PLANS.					
		A	WI3-1	18	18			2.25																				
SIGN SUMMARY SHEET							SHEET TOTALS	24.00 3.00	0.00	0	0	0	2 0	0	0	1	15						PROJECT NAME: Stamford-Andover VT100					
VERMONT AGENCY OF TRANSPORTATION							TOWN TOTALS	1058.3	0.0	40.0	13.0	13.0	220	0.0	0.0	193	2895.0						PROJECT NUMBER: STPG SIGN(20)					
								SF	SF	EA	EA	EA	EA	EA	EA	EA	FT						FILE NAME: Whitingham.xls	PLOT DATE: 8/5/2009				
																							PROJECT MANAGER: N. Avery	DRAWN BY: I. Shea				
																							DESIGNED BY: J. Kelly	CHECKED BY: T. Guazzoni				
																							WHITINGHAM SHEET 34	SHEET 70 OF 198				


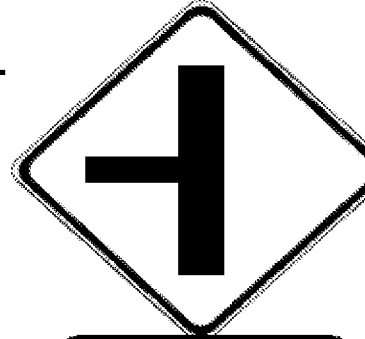



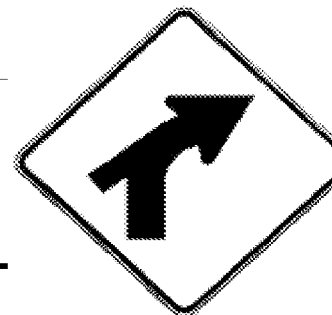
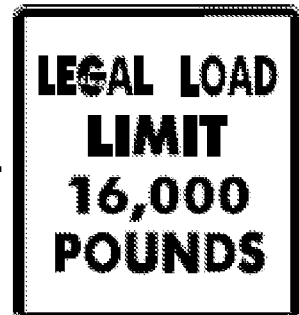
DIRECTION	MILEPOINT	LOCATION CODE (SHEET 2)	SIGN CODE	WIDTH (IN)	HEIGHT (IN)	SHEETING REMARKS	SIGN LEGEND	NEW SIGNS		EXISTING SIGNS				EXIST POST		NUMBER OF NEW POSTS	SQUARE STEEL (IN)			TUBULAR STEEL Ø (IN)				SIGN FRAME REQUIRED	REMARKS	SIGN DETAIL			
								"A"	"B"	RETAIN	SALVAGE FROM	SALVAGE TO	REMOVE	RETAIN	REMOVE		1.75	2.00	2.50	FOUNDATION	3.00	3.50	4.00			5.00	DETAIL IN SHS	DETAIL ON SHEET NUMBER	DETAIL ON STD SHEET NUMBER
																	(LB / FT)				(LB / FT)								
WILMINGTON VT 100							FY-FLUORESCENT YELLOW FYG-FLUORESCENT YELLOW GREEN															"SHS"-STANDARD HIGHWAY SIGNS							
NB	0.000	C	VD-024	60	7.5																	AT THE REQUEST OF AOT-DIST. *1 THIS SET OF SIGNS WAS MOVED OUT OF THE DITCHLINE.	TOWN LINE SIGN IS MISSING. EMPTY POST IS 171 FT ± SOUTH OF THE JCT WITH HEBARD RD (TH-39).						
		C	VD-024	72	10			5.00											X				INSTALL IN SAME POSITION AS EMPTY POST REMOVAL, IN "C" POSITION.		4				
		C	VD-700	6	10			0.42															WILMINGTON MILE MARKER. INSTALL ON LEFT POST UNDER WILMINGTON.			E-138			
		C	VD-700	6	10			0.42															WHITINGHAM MILE MARKER. INSTALL ON RIGHT POST UNDER WHITINGHAM..			E-138			
NB	0.032	C	VR-017	24	30			5.00											X				HEBARD HILL RD (TH-39)			E-141			
NB	0.040	D	R1-1	24	24																								
		D	R1-1	30	30			6.25											X				HEBARD HILL RD (TH-39)	X					
NB	0.345	A	W1-2L	30	30			6.25											X			* SEE NOTE ON SHEET #76	INSTALL BEHIND GUARD RAIL, 315 FT ± SOUTH OF THE GRAVEL ROAD TO BE REOPENED (SEE NEXT 2 ENTRIES)	X					
NB	0.394	C	VR-017	24	30			5.00											X				RADER RD (TH-70). THIS CLASS III ROAD TO BE REOPENED (EDGE LINE AND CENTERLINE MAY STILL BE CLOSED)			E-141			
NB	0.400	D	R1-1	30	30			6.25											X				RADER RD (TH-70); GRAVEL ROAD w/ A GUARDRAIL BREAK, JUST BEYOND LEFT CURVE BEGIN / ON SLIGHT UPHILL	X					
NB	0.638	C	VR-017	24	30			5.00											X				(TH-36)			E-141			
NB	0.644	D	R1-1	30	30			6.25											X				(TH-36)	X					
NB	0.941	C	VR-017	24	24																		RADER ROAD (TH-69), SOUTHERLY APPROACH.						
		C	VR-017	24	30			5.00											X				INSTALL AT A POINT ON TH-69 JUST BEYOND THE CONVERGANCE OF THE TWO APPROACHES.			E-141			
NB	0.949	D	R1-1	24	24																		RADER ROAD (TH-69), SOUTHERLY APPROACH.						
SIGN SUMMARY SHEET							SHEET TOTALS	57.09 50.84	0.00	0	3 0	3 0	7 3	0	0	10	150					PROJECT NAME: Stamford-Andover VT100							
VERMONT AGENCY OF TRANSPORTATION							TOWN TOTALS	825.4	0.0	64.0	15.0	15.0	145	0.0	0.0	145	2175.0					PROJECT NUMBER: STPG SIGN(20)							
								SF	SF	EA	EA	EA	EA	EA	EA	EA	FT					FILE NAME: Wilmington.xls	PLOT DATE: 8/6/2009						
																						PROJECT MANAGER: N. Avery	DRAWN BY: T. Guazzoni						
																						DESIGNED BY: M. Miller	CHECKED BY: T. Guazzoni						
																						WILMINGTON SHEET 1	SHEET 71 OF 198						

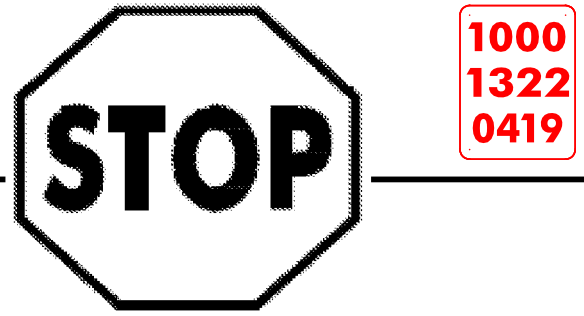



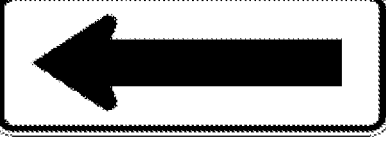


DIRECTION	MILEPOINT	LOCATION CODE (SHEET 2)	SIGN CODE	WIDTH (IN)	HEIGHT (IN)	SHEETING REMARKS	SIGN LEGEND	NEW SIGNS		EXISTING SIGNS			EXIST POST		NUMBER OF NEW POSTS	SQUARE STEEL (IN)			TUBULAR STEEL Ø (IN)				SIGN FRAME REQUIRED	REMARKS	SIGN DETAIL				
								"A"	"B"	RETAIN	SALVAGE FROM	SALVAGE TO	REMOVE	RETAIN		REMOVE	1.75	2.00	2.50	FOUNDATION	3.00	3.50			4.00	5.00	DETAIL IN SHS	DETAIL ON SHEET NUMBER	DETAIL ON STD SHEET NUMBER
																	(LB / FT)				(LB / FT)								
WILMINGTON VT 100							FY-FLUORESCENT YELLOW FYG-FLUORESCENT YELLOW GREEN															"SHS"-STANDARD HIGHWAY SIGNS							
NB	0.949	D	R1-1	30	30			6.25						1	X									X					
NB	0.984	D	R1-1	24	24		STOP (INSTALLED BACK-TO-BACK WITH THE LEGAL LOAD LIMIT SIGN)					1			X									RADER ROAD (TH-69), NORTHERLY APPROACH.					
		C	VR-017	24	24		LEGAL LOAD LIMIT 24,000 LBS 					1												INSTALLED BACK-TO-BACK WITH THE STOP SIGN					
		D	R1-1	30	30			6.25						1	X									X					
NB	1.366	A	W2-2R	30	30		SIDE ROAD RIGHT (SYMBOL) 					1			X														
NB	1.396	A	W2-2MaR	30	30			6.25						1	X										INSTALL 160 FT ± NORTH OF PREVIOUS LOCATION.		6		
		A	W16-8	24	8			1.33																			8		
NB	1.480	C	VR-017	24	24							1			X										DIX ROAD (TH-35)				
		C	N/A	18	24		DEAD END ROAD 				1																		
		C	VR-017	24	30			5.00						1	X													E-141	
		C	N/A	18	24		DEAD END ROAD 				1																		
NB	1.488	D	R1-1	24	24							1			X										DIX ROAD (TH-35)				
		D	R1-1	30	30			6.25						1	X									X					
NB	1.540	A	VD-062AS	72	16		BUSINESS SIGN 					1			X														
NB	1.772	A	W1-4R	30	30	FY		6.25						1	X										INSTALL 25 FT ± IN ADVANCE OF EXISTING ASSEMBLY (TO BE REMOVED), BEHIND RAIL.	X			
SIGN SUMMARY SHEET							SHEET TOTALS	37.58	0.00	1	1	1	5	0	0	6	90								PROJECT NAME: Stamford-Andover VT100				
VERMONT AGENCY OF TRANSPORTATION							TOWN TOTALS	825.4	0.0	64.0	15.0	15.0	145	0.0	0.0	145	2175.0								PROJECT NUMBER: STPG SIGN(20)				
								SF	SF	EA	EA	EA	EA	EA	EA	EA	FT							FILE NAME: Wilmington.xls	PLOT DATE: 8/6/2009				
																								PROJECT MANAGER: N. Avery	DRAWN BY: T. Guazzoni				
																								DESIGNED BY: M. Miller	CHECKED BY: T. Guazzoni				
																								WILMINGTON SHEET 2	SHEET 72 OF 198				







DIRECTION	MILEPOINT	LOCATION CODE (SHEET 2)	SIGN CODE	WIDTH (IN)	HEIGHT (IN)	SHEETING REMARKS	SIGN LEGEND	NEW SIGNS		EXISTING SIGNS				EXIST POST		NUMBER OF NEW POSTS	SQUARE STEEL (IN)			TUBULAR STEEL Ø (IN)				SIGN FRAME REQUIRED	REMARKS	SIGN DETAIL		
								"A"	"B"	RETAIN	SALVAGE FROM	SALVAGE TO	REMOVE	RETAIN	REMOVE		(LB / FT)			(LB / FT)						DETAIL IN SHS	DETAIL ON SHEET NUMBER	DETAIL ON STD SHEET NUMBER
																	1.75	2.00	2.50	3.00	3.50	4.00	5.00					
WILMINGTON VT 100							FY-FLUORESCENT YELLOW FYG-FLUORESCENT YELLOW GREEN																"SHS"-STANDARD HIGHWAY SIGNS					
		A	W13-1	24	24	FY		4.00																NOTE UPSIZED ADVISORY SPEED PLAQUE.	X			
NB	1.777	A	W1-4R	30	30		REVERSE CURVE RIGHT						1															
		A	W13-1	18	18		35 MPH (PLAQUE)							1														
NB	1.980	A	VW-168L	30	30		HIDDEN SIDE ROAD LEFT (TEXT)							1														
																												
NB	2.000	A	VW-054L	30	30			6.25						1				X									E-154	
NB	2.155	A	VD-062BC	74.75	16		TRAVEL INFO SYMBOLS						1															
		A	VD-062C	74.75	16		TRAVEL INFO						1															
NB	2.180	A	VW-544	36	36																							
																												
		A	VW-544	36	36			9.00																			E-154	
NB	2.275	A	W11-2	30	30		PEDESTRIAN SYMBOL						1															
		A	W16-9P	24	12	FYG			2.00																			
NB	2.310	A	W3-1	36	36		STOP AHEAD						1															
NB	2.348	A	M2-1	21	15		JCT						1															
		A	M1-5	24	24		VERMONT ROUTE 9						1															
NB	2.391	A	D1-1A	72	12		<--- WILMINGTON 1						1															
SIGN SUMMARY SHEET							SHEET TOTALS		21.25	0.00	7	0	0	4	0	0	3	45							PROJECT NAME: Stamford-Andover VT100			
							SF	SF	EA	EA	EA	EA	EA	EA	EA	EA	EA	FT							PROJECT NUMBER: STPG SIGN(20)			
VERMONT AGENCY OF TRANSPORTATION							TOWN TOTALS		825.4	0.0	64.0	15.0	15.0	145	0.0	0.0	145	2175.0							FILE NAME: Wilmington.xls			
																									PLOT DATE: 8/6/2009			
																									DRAWN BY: T. Guazzoni			
																									CHECKED BY: T. Guazzoni			
																									DESIGNED BY: M. Miller			
																									WILMINGTON SHEET 3			
																									SHEET 73 OF 198			



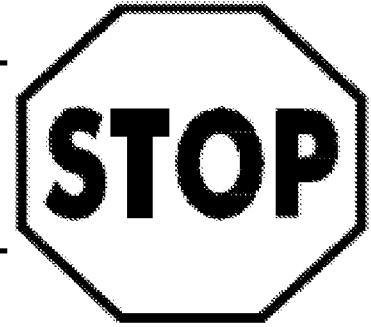
DIRECTION	MILEPOINT	LOCATION CODE (SHEET 2)	SIGN CODE	WIDTH (IN)	HEIGHT (IN)	SHEETING REMARKS	SIGN LEGEND	NEW SIGNS		EXISTING SIGNS			EXIST POST		NUMBER OF NEW POSTS	SQUARE STEEL (IN)			TUBULAR STEEL Ø (IN)				SIGN FRAME REQUIRED	REMARKS	SIGN DETAIL													
								"A"	"B"	RETAIN	SALVAGE FROM	SALVAGE TO	REMOVE	RETAIN		REMOVE	1.75	2.00	2.50	FOUNDATION	3.00	3.50			4.00	5.00	DETAIL IN SHS	DETAIL ON SHEET NUMBER	DETAIL ON STD SHEET NUMBER									
																	(LB / FT)				(LB / FT)																	
WILMINGTON VT 100							FY-FLUORESCENT YELLOW FYG-FLUORESCENT YELLOW GREEN																"SHS"-STANDARD HIGHWAY SIGNS															
			A D1-1A	72	12		<--- BENNINGTON 22			1																												
			A D1-1A	72	12		MARLBORO 8 --->			1																												
			A D1-1A	72	12		BRATTLEBORO 18 --->			1																												
NB	2.424		A M3-4	24	12		WEST			1																												
			A M1-5	24	24		VERMONT ROUTE 9			1																												
			A M6-1	21	15		<--- LEFT			1																												
			A M3-1	24	12		NORTH			1																												
			A M1-5	30	24		VERMONT ROUTE 100			1																												
			A M6-1	21	15		<--- LEFT			1																												
			A M3-2	24	12		EAST			1																												
			A M1-5	24	24		VERMONT ROUTE 9			1																												
			A M6-1	21	15		RIGHT --->			1																												
NB	2.464		A R1-1	36	36			9.00							2		X																		INSTALL THE NEW UPSIZED STOP ON 2 POSTS, 25 FT ± IN ADVANCE OF THE EXISTING SIGN	X		
NB	2.469		A R1-1	30	30		STOP						1				X																					
							BECOMES VT ROUTE 9																															
SIGN SUMMARY SHEET							SHEET TOTALS	9.00	0.00	12	0	0	1	0	0	2	30																					
VERMONT AGENCY OF TRANSPORTATION							TOWN TOTALS	825.4	0.0	64.0	15.0	15.0	145	0.0	0.0	145	2175.0																					
																					PROJECT NAME:	Stamford-Andover VT100																
																					PROJECT NUMBER:	STPG SIGN(20)																
																					FILE NAME:	Wilmington.xls					PLOT DATE:	8/6/2009										
																					PROJECT MANAGER:	N. Avery					DRAWN BY:	T. Guazzoni										
																					DESIGNED BY:	M. Miller					CHECKED BY:	T. Guazzoni										
																					WILMINGTON SHEET	4					SHEET	74					OF	198				







DIRECTION	MILEPOINT	LOCATION CODE (SHEET 2)	SIGN CODE	WIDTH (IN)	HEIGHT (IN)	SHEETING REMARKS	SIGN LEGEND	NEW SIGNS		EXISTING SIGNS			EXIST POST		NUMBER OF NEW POSTS	SQUARE STEEL (IN)			TUBULAR STEEL Ø (IN)				SIGN FRAME REQUIRED	REMARKS	SIGN DETAIL				
								"A"	"B"	RETAIN	SALVAGE FROM	SALVAGE TO	REMOVE	RETAIN		REMOVE	1.75	2.00	2.50	FOUNDATION	3.00	3.50			4.00	5.00	DETAIL IN SHS	DETAIL ON SHEET NUMBER	DETAIL ON STD SHEET NUMBER
																	(LB / FT)				(LB / FT)								
WILMINGTON VT 100							FY-FLUORESCENT YELLOW FYG-FLUORESCENT YELLOW GREEN															"SHS"-STANDARD HIGHWAY SIGNS							
SB	2.469	E	R1-1	30	30		STOP			1														RETAIN THE "GATEPOSTED" LEFT-SIDE 30" STOP SIGN FOR NB VT-100.					
SB	2.429	F	M3-3	24	12		SOUTH			1																			
		F	M1-5	30	24		VERMONT ROUTE 100			1																			
SB	2.392	F	R2-1	24	30		SPEED LIMIT 50			1																			
SB	2.354	F	D2-1	72	12		JACKSONVILLE 6			1																			
		F	D2-1	72	12		WHITINGHAM 9			1																			
SB	2.319	F	W11-1	30	30	FYG	BICYCLE SYMBOL			1																			
		F	W16-1	24	30	FYG	SHARE THE ROAD (TEXT)			1																			
SB	2.210	F	VW-168R	30	30		HIDDEN SIDE ROAD RIGHT					1																	
SB	2.160	F	VW-054R	30	30		HIDDEN DRIVE RIGHT	6.25						1		X							*SEE NOTE ON NEXT SHEET	INSTALL 260 FT ± SOUTH OF EXISTING HIDDEN SIDE ROAD SIGN BEHIND GUARD RAIL.			E-154		
SB	1.925	F	W1-6	48	24			8.00						2		X							INSTALL 175 FT IN ADVANCE OF EXISTING (NORTH OF) THE LARGE ARROW/CLUSTER FACING NB TRAFFIC, AT M.P. 1.890.	X					
SB	1.923	E	W1-6	48	24			8.00						2		X							INSTALL FACING NB TRAFFIC, 5 FT ± SOUTH OF THE SB FACING ARROW. MAINTAIN 10 FT MIN TO POLE.	X					
SB	1.892	F	W1-6	48	24			8.00						2		X							INSTALL FACING SB TRAFFIC, 10 FT NORTH OF THE NB FACING ARROW (WHICH WILL BE REPLACED).	X					
SB	1.890	E	W1-6	48	24							1																	
		E	OM1-1	18	18		OBJECT MARKER					1				X													
SIGN SUMMARY SHEET							SHEET TOTALS	36.50 30.25	0.00	8	0	0	3	0	0	7	105						PROJECT NAME: Stamford-Andover VT100						
VERMONT AGENCY OF TRANSPORTATION							TOWN TOTALS	825.4	0.0	64.0	15.0	15.0	145	0.0	0.0	145	2175.0						PROJECT NUMBER: STPG SIGN(20)	FILE NAME: Wilmington.xls	PLOT DATE: 8/6/2009				
								SF	SF	EA	EA	EA	EA	EA	EA	EA	FT						PROJECT MANAGER: N. Avery	DRAWN BY: T. Guazzoni					
																							DESIGNED BY: M. Miller	CHECKED BY: T. Guazzoni					
																							WILMINGTON SHEET 5	SHEET 75	OF 198				

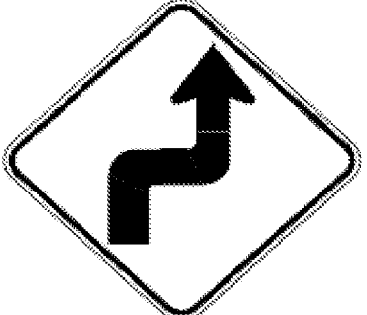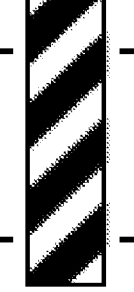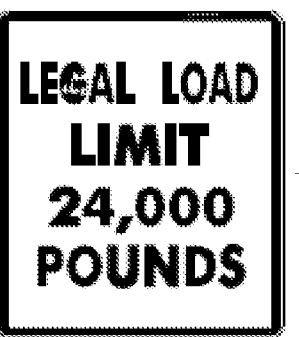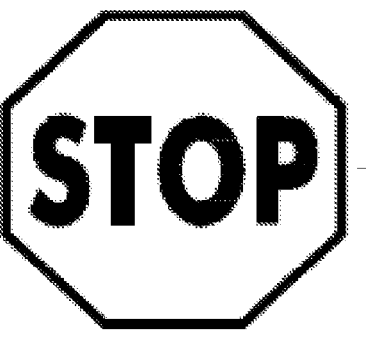
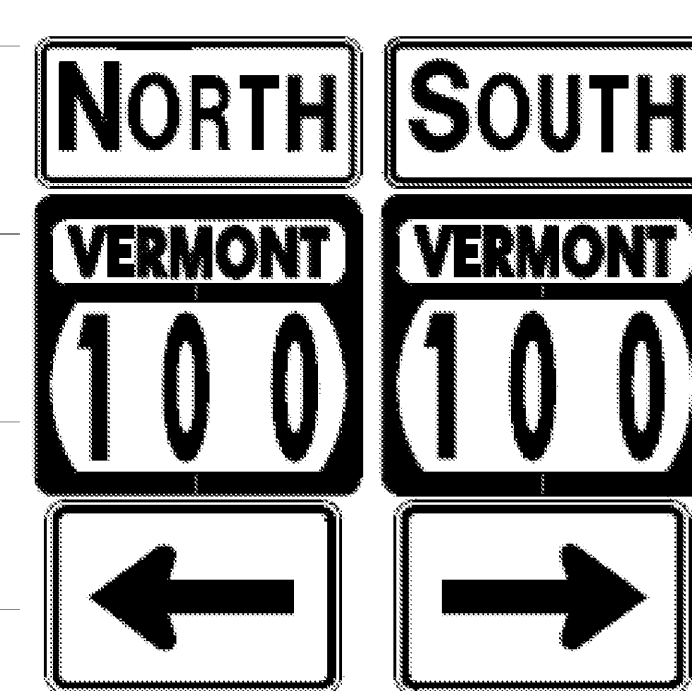
DIRECTION	MILEPOINT	LOCATION CODE (SHEET 2)	SIGN CODE	WIDTH (IN)	HEIGHT (IN)	SHEETING REMARKS	SIGN LEGEND	NEW SIGNS		EXISTING SIGNS			EXIST POST		NUMBER OF NEW POSTS	SQUARE STEEL (IN)			TUBULAR STEEL Ø (IN)				SIGN FRAME REQUIRED	REMARKS	SIGN DETAIL			
								"A"	"B"	RETAIN	SALVAGE FROM	SALVAGE TO	REMOVE	RETAIN		REMOVE	1.75	2.00	2.50	3.00	3.50	4.00			5.00	DETAIL IN SHS	DETAIL ON SHEET NUMBER	DETAIL ON STD SHEET NUMBER
																	(LB / FT)			(LB / FT)								
WILMINGTON VT 100							FY-FLUORESCENT YELLOW FYG-FLUORESCENT YELLOW GREEN															"SHS"-STANDARD HIGHWAY SIGNS						
			E W1-6	48	24			8.00							2		X							X				
SB	1.615	F	W2-2	30	30		HIDDEN SIDE ROAD LEFT SYMBOL					1		X														
SB	1.570	F	W2-2Ma	30	30			*6.25 6.25							1		X								6			
		F	W16-8	24	8			1.33																	8			
SB	1.270	G	VR-017	24	24		LEGAL LOAD LIMIT 24,000 LBS					1		X														
		H	R1-1	24	24		STOP (ON BACK)					1																
		G	VR-017	24	30			5.00							1		X								E-141			
SB	1.257	H	R1-1	30	30			6.25							1		X								X			
SB	0.705	F	N/A				REMOVE EMPTY POST										X											
SB	0.560	F	S3-1	30	30		SCHOOL BUS STOP AHEAD					1		X														
		F	W1-2R	30	30		CURVE RIGHT					1																
		F	W1-2Mh R	30	30			*6.25 6.25							1		X								6			
SB	0.040	G	VR-017	24	24							1		X														
		G	VR-017	24	30			5.00							1		X								E-141			
SB	0.032	H	R1-1	24	24							1		X														
SIGN SUMMARY SHEET							SHEET TOTALS	50.58 38.08	0.00	0	0	0	10 7	0	0	7	105											
VERMONT AGENCY OF TRANSPORTATION							TOWN TOTALS	825.4	0.0	64.0	15.0	15.0	145	0.0	0.0	145	2175.0											
PROJECT NAME: Stamford-Andover VT100																					PROJECT NUMBER: STPG SIGN(20)							
FILE NAME: Wilmington.xls												PLOT DATE: 8/6/2009																
PROJECT MANAGER: N. Avery												DRAWN BY: T. Guazzoni																
DESIGNED BY: M. Miller												CHECKED BY: T. Guazzoni																
WILMINGTON SHEET 6												SHEET 76 OF 198																



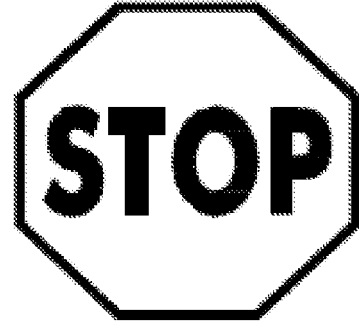


DIRECTION	MILEPOINT	LOCATION CODE (SHEET 2)	SIGN CODE	WIDTH (IN)	HEIGHT (IN)	SHEETING REMARKS	SIGN LEGEND	NEW SIGNS		EXISTING SIGNS			EXIST POST		NUMBER OF NEW POSTS	SQUARE STEEL (IN)			TUBULAR STEEL Ø (IN)				SIGN FRAME REQUIRED	REMARKS	SIGN DETAIL				
								"A"	"B"	RETAIN	SALVAGE FROM	SALVAGE TO	REMOVE	RETAIN		REMOVE	1.75	2.00	2.50	FOUNDATION	3.00	3.50			4.00	5.00	DETAIL IN SHS	DETAIL ON SHEET NUMBER	DETAIL ON STD SHEET NUMBER
																	(LB / FT)				(LB / FT)								
WILMINGTON VT 100							FY-FLUORESCENT YELLOW FYG-FLUORESCENT YELLOW GREEN															"SHS"-STANDARD HIGHWAY SIGNS							
SB	0.032	H	R1-1	30	30			6.25			I	I		3	X								AT THE REQUEST OF THE TOWN, THIS SIGN WAS RELOCATED FARTHER FROM THE INTERSECTION.	INSTALL AS CLOSE TO ACTUAL STOPPING POINT AS POSSIBLE.	X				
VT ROUTE 100 RESUMES AT BREAK IN CENTERLINE OF VT ROUTE 9																													
NB	2.556	C	VR-017	24	30							1		X															
		C	VR-017	24	30			5.00					1	X													E-141		
NB	2.564	D	R1-1	30	30							1		X															
		D	R1-1	30	30			6.25					1	X											X				
NB	2.585	A	M3-1	24	12							1		X															
		A	M1-5	30	24							1		X															
		A	M3-1	24	12			2.00					1	X											X				
		A	M1-5	30	24			5.00						X														E-136B	
NB	2.600	A	R2-1	24	30							1		X															
		A	R2-1	24	30			5.00					1	X											X				
NB	2.650	A	D1-1S	72	10							1		X															
		A	D2-1	72	10							1		X															
		A	D2-1	72	12			6.00					2	X													5		
SIGN SUMMARY SHEET							SHEET TOTALS	35.50	0.00	0	0	0	9	0	0	7	105							PROJECT NAME: Stamford-Andover VT100					
VERMONT AGENCY OF TRANSPORTATION							TOWN TOTALS	825.4	0.0	64.0	15.0	15.0	145	0.0	0.0	145	2175.0							PROJECT NUMBER: STPG SIGN(20)	FILE NAME: Wilminaton.xls	PLOT DATE: 8/6/2009			
								SF	SF	EA	EA	EA	EA	EA	EA	EA	FT						DESIGNED BY: M. Miller	CHECKED BY: T. Guazzoni	SHEET 77 OF 198				

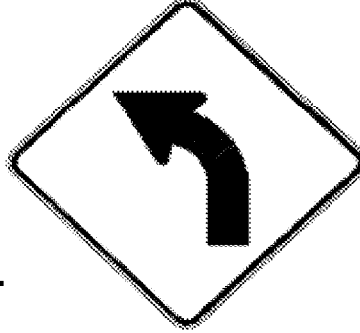
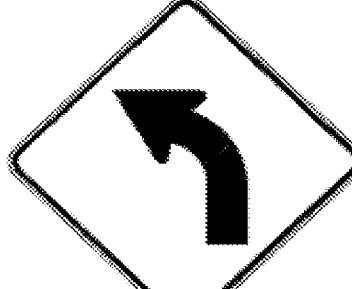
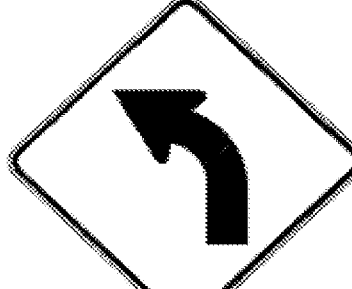

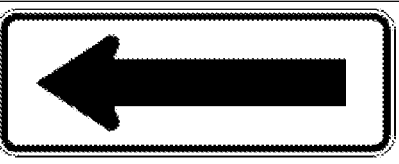
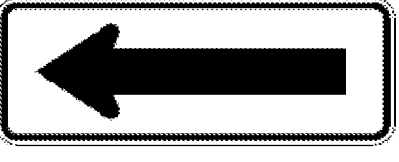


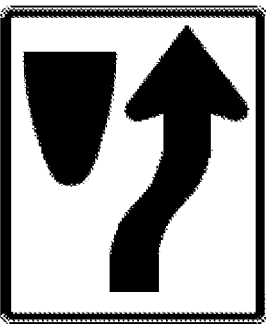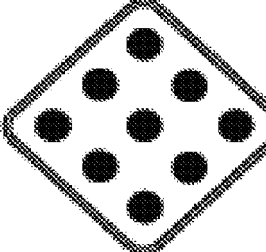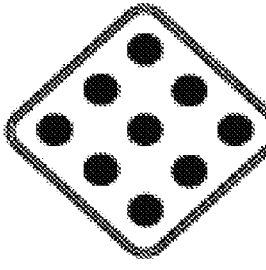DIRECTION	MILEPOINT	LOCATION CODE (SHEET 2)	SIGN CODE	WIDTH (IN)	HEIGHT (IN)	SHEETING REMARKS	SIGN LEGEND	NEW SIGNS		EXISTING SIGNS			EXIST POST		NUMBER OF NEW POSTS	SQUARE STEEL (IN)			TUBULAR STEEL Ø (IN)				SIGN FRAME REQUIRED	REMARKS	SIGN DETAIL								
								"A"	"B"	RETAIN	SALVAGE FROM	SALVAGE TO	REMOVE	RETAIN		REMOVE	1.75	2.00	2.50	3.00	3.50	4.00			5.00	DETAIL IN SHS	DETAIL ON SHEET NUMBER	DETAIL ON STD SHEET NUMBER					
																	(LB / FT)			(LB / FT)													
WILMINGTON VT 100							FY-FLUORESCENT YELLOW FYG-FLUORESCENT YELLOW GREEN															"SHS"-STANDARD HIGHWAY SIGNS											
		A	D2-1	72	12			6.00																			5						
NB	2.715	A	W1-3R	30	30		RIGHT REVERSE TURN SYMBOL					1		X																			
NB	2.758	A	R2-1	24	30		SPEED LIMIT 25			1				X																			
NB	2.780	A	VW-054R	30	30		HIDDEN DRIVE RIGHT					1		X																			
NB	2.785	A	W1-3R	30	30			6.25							1		X											INSTALL 25 FT ± NORTH OF HIDDEN DRIVE RIGHT SIGN JUST-REMOVED.	X				
NB	2.830	A	OM-3R	12	36			3.00																				INSTALL 250 FT ± NORTH OF HIDDEN DRIVE RIGHT SIGN JUST-REMOVED.	X				
NB	2.832	A	N/A				EMPTY POST							X																			
NB	2.903	A	R2-1	24	30		SPEED LIMIT 25			1				X																			
NB	2.987	C	VR-017	24	30							1		X														STOWE HILL RD (TH-21)					
		C	VR-017	24	30			5.00							1		X													E-141			
NB	2.995	D	R1-1	30	30							1		X														STOWE HILL RD (TH-21)					
		D	R1-1	30	30			6.25							1		X												X				
NB	3.080	A	R2-1	24	30							1		X																			
		A	R2-1	24	30			5.00							1		X												X				
NB	3.233	C	VR-017	24	30		LEGAL LOAD LIMIT 24,000 LBS			1				X														ADAMS DR (TH-22)					
SIGN SUMMARY SHEET							SHEET TOTALS	31.50	0.00	3	0	0	5	0	0	4		60															
VERMONT AGENCY OF TRANSPORTATION							TOWN TOTALS	825.4	0.0	64.0	15.0	15.0	145	0.0	0.0	145		2175.0															
																						PROJECT NAME:	Stamford-Andover VT100										
																						PROJECT NUMBER:	STPG SIGN(20)										
												FILE NAME:	Wilmington.xls						PLOT DATE:	8/6/2009													
												PROJECT MANAGER:	N. Avery						DRAWN BY:	T. Guazzoni													
												DESIGNED BY:	M. Miller						CHECKED BY:	T. Guazzoni													
												WILMINGTON SHEET	8						SHEET	78						OF	198						



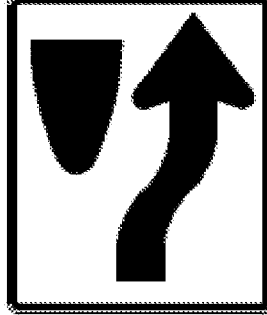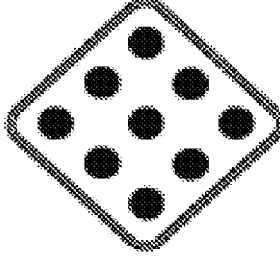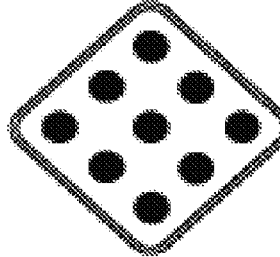


DIRECTION	MILEPOINT	LOCATION CODE (SHEET 2)	SIGN CODE	WIDTH (IN)	HEIGHT (IN)	SHEETING REMARKS	SIGN LEGEND	NEW SIGNS		EXISTING SIGNS			EXIST POST		NUMBER OF NEW POSTS	SQUARE STEEL (IN)			TUBULAR STEEL Ø (IN)				SIGN FRAME REQUIRED	REMARKS	SIGN DETAIL				
								"A"	"B"	RETAIN	SALVAGE FROM	SALVAGE TO	REMOVE	RETAIN		REMOVE	1.75	2.00	2.50	FOUNDATION	3.00	3.50			4.00	5.00	DETAIL IN SHS	DETAIL ON SHEET NUMBER	DETAIL ON STD SHEET NUMBER
																	(LB / FT)				(LB / FT)								
WILMINGTON VT 100							FY-FLUORESCENT YELLOW FYG-FLUORESCENT YELLOW GREEN															"SHS"-STANDARD HIGHWAY SIGNS							
NB	3.241	D	R1-1	30	30																		ADAMS DR (TH-22)						
		D	R1-1	30	30			6.25						1		X								X					
NB	3.467	A	R2-1	24	30		SPEED LIMIT 40			1					X														
NB	3.507	A	VW-133R	30	30		HIDDEN DRIVES RIGHT			1					X														
NB	3.565	A	VW-133R	30	30		HIDDEN DRIVES RIGHT				1						1		X				SALVAGE THE SIGN TO A NEW POSITION 300 340 FT ± AHEAD OF PREVIOUS LOCATION.						
NB	3.815	A	S3-1	30	30							1			X														
		A	S3-1	30	30			6.25																X					
NB	3.858	A	R2-1	24	30		SPEED LIMIT 40			1					X														
NB	3.950	A	W1-2R	30	30		RIGHT CURVE				1	1																	
		A	W13-1	18	18		35 MPH PLAQUE				1	1																	
NB	3.978	D	R1-1	30	30			6.25															HAPPY HAVEN ROAD - PRIVATE	JUST SOUTH OF WOFFENDED ROAD ON LEFT. RIGHT	X				
NB	4.085	A	S1-1YG	36	36		PENTAGONAL SCHOOL SYMBOL			1					X														
		A	W16-9YG	36	20		AHEAD (PLAQUE)			1																			
NB	4.212	A	W1-2L	30	30		LEFT CURVE					1			X														
		A	R2-1	24	30		SPEED LIMIT 40					1							X							SALVAGED FROM M.P. 4.275			
SIGN SUMMARY SHEET							SHEET TOTALS		18.75	0.00	4	3	4	3	2	0	0	6	90				PROJECT NAME: Stamford-Andover VT100						
VERMONT AGENCY OF TRANSPORTATION							TOWN TOTALS		825.4	0.0	64.0	15.0	15.0	145	0.0	0.0	145	2175.0				PROJECT NUMBER: STPG SIGN(20)							
							SF	SF	EA	EA	EA	EA	EA	EA	EA	EA	EA	EA	EA	EA	EA	EA	FILE NAME: Wilmington.xls	PLOT DATE: 8/6/2009					
																							PROJECT MANAGER: N. Avery	DRAWN BY: T. Guazzoni					
																							DESIGNED BY: M. Miller	CHECKED BY: T. Guazzoni					
																							WILMINGTON SHEET 9	SHEET 79 OF 198					








DIRECTION	MILEPOINT	LOCATION CODE (SHEET 2)	SIGN CODE	WIDTH (IN)	HEIGHT (IN)	SHEETING REMARKS	SIGN LEGEND	NEW SIGNS		EXISTING SIGNS			EXIST POST		NUMBER OF NEW POSTS	SQUARE STEEL (IN)			TUBULAR STEEL Ø (IN)				SIGN FRAME REQUIRED	REMARKS	SIGN DETAIL				
								"A"	"B"	RETAIN	SALVAGE FROM	SALVAGE TO	REMOVE	RETAIN		REMOVE	1.75	2.00	2.50	FOUNDATION	3.00	3.50			4.00	5.00	DETAIL IN SHS	DETAIL ON SHEET NUMBER	DETAIL ON STD SHEET NUMBER
																	(LB / FT)				(LB / FT)								
WILMINGTON VT 100							FY-FLUORESCENT YELLOW FYG-FLUORESCENT YELLOW GREEN															"SHS"-STANDARD HIGHWAY SIGNS							
NB	4.275	A	R2-1	24	30		SPEED LIMIT 40			1			X										SALVAGE TO M.P. 4.212						
		A	W1-2L	30	30			6.25						1		X								X					
NB	4.380	A	VD-062AS	72	16		BUSINESS SIGN			1			X																
NB	4.501	A	R2-1	24	30		SPEED LIMIT 50			1			X																
NB	4.709	A	VD-062AS	72	16		BUSINESS SIGN			1			X																
		A	VD-062AS	72	16		BUSINESS SIGN			1																			
		A	VD-062AS	72	16		BUSINESS SIGN			1																			
NB	4.826	A	D1-1S	72	10							1		X															
		A	D1-1S	72	10							1																	
		A	D1-1	72	12			6.00						2		X							BEHIND RAIL		5				
		A	D1-1	72	12			6.00																	5				
NB	4.860	J	R4-7	24	30							1		X															
		J	OM1-1	18	18							1																	
		K	OM1-1	18	18							1																	
		J	R4-7	24	30			5.00						1		X							INSTALL AT 7 FT VERTICAL CLEARANCE	X		E-121			
SIGN SUMMARY SHEET							SHEET TOTALS	23.25	0.00	5	1	0	5	0	0	4		60					PROJECT NAME: Stamford-Andover VT100						
VERMONT AGENCY OF TRANSPORTATION							TOWN TOTALS	825.4	0.0	64.0	15.0	15.0	145	0.0	0.0	145		2175.0					PROJECT NUMBER: STPG SIGN(20)						
								SF	SF	EA	EA	EA	EA	EA	EA	EA		FT					FILE NAME: Wilmington.xls						
																							PLOT DATE: 8/6/2009						
																							DESIGNED BY: M. Miller						
																							CHECKED BY: T. Guazzoni						
																							WILMINGTON SHEET 10	SHEET 80	OF 198				





DIRECTION	MILEPOINT	LOCATION CODE (SHEET 2)	SIGN CODE	WIDTH (IN)	HEIGHT (IN)	SHEETING REMARKS	SIGN LEGEND	NEW SIGNS		EXISTING SIGNS				EXIST POST		NUMBER OF NEW POSTS	SQUARE STEEL (IN)			TUBULAR STEEL Ø (IN)				SIGN FRAME REQUIRED	REMARKS	SIGN DETAIL		
								"A"	"B"	RETAIN	SALVAGE FROM	SALVAGE TO	REMOVE	RETAIN	REMOVE		1.75	2.00	2.50	3.00	3.50	4.00	5.00			DETAIL IN SHS	DETAIL ON SHEET NUMBER	DETAIL ON STD SHEET NUMBER
																	(LB / FT)			(LB / FT)								
WILMINGTON VT 100							FY-FLUORESCENT YELLOW FYG-FLUORESCENT YELLOW GREEN															"SHS"-STANDARD HIGHWAY SIGNS						
			J OM1-1	18	18			2.25																YELLOW ON YELLOW; INSTALL AT 4 FT VERTICAL CLEARANCE	X			
			K OM1-1	18	18			2.25																INSTALL BACK-TO-BACK WITH THE NB FACING YELLOW CLUSTER	X			
NB	4.921		A VR-921L	30	30			6.25							1	X								INSTALL 35 FT IN ADVANCE OF EXISTING SIGN (TO BE REMOVED); ASSEMBLY BEHIND RAIL.			E-145A	
NB	4.928		A VR-921L	30	30	LEFT "ONLY" THRU UP (SYMBOL)								1		X												
NB	4.985		C M3-1	24	12																							
			C M1-5	30	24																							
			C M6-1	21	15																							
			C M3-3	24	12																							
			C M1-5	30	24																							
			C M6-1	21	15																							
			C M3-1	24	12			2.00							1		X							#2B BEHIND GUARD RAIL. GREEN ON WHITE SHEETING.	X	7		
			C M1-5	30	24			5.00																			E-136B	
			C M6-1L	21	15			2.19																GREEN ON WHITE SHEETING	X			
			C M3-3	24	12			2.00																GREEN ON WHITE SHEETING	X			
			C M1-5	30	24			5.00																			E-136B	
SIGN SUMMARY SHEET							SHEET TOTALS		26.94	0.00	0	0	0	7	0	0	2	30						PROJECT NAME: Stamford-Andover VT100				
VERMONT AGENCY OF TRANSPORTATION							SF	SF	EA	EA	EA	EA	EA	EA	EA	EA	EA	EA	FT						PROJECT NUMBER: STPG SIGN(20)			
TOWN TOTALS							825.4	0.0	64.0	15.0	15.0	145	0.0	0.0	145	2175.0									FILE NAME: Wilmington.xls	PLOT DATE: 8/6/2009		
																								PROJECT MANAGER: N. Avery	DRAWN BY: T. Guazzoni			
																									DESIGNED BY: M. Miller	CHECKED BY: T. Guazzoni		
																									WILMINGTON SHEET 11	SHEET 81	OF 198	




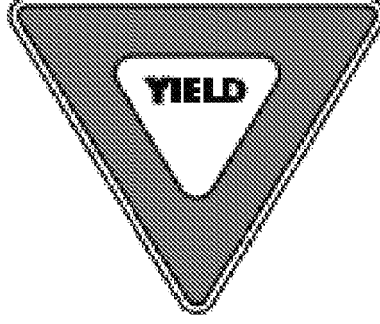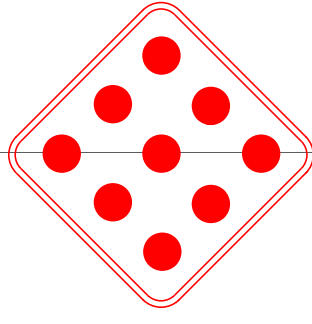



DIRECTION	MILEPOINT	LOCATION CODE (SHEET 2)	SIGN CODE	WIDTH (IN)	HEIGHT (IN)	SHEETING REMARKS	SIGN LEGEND	NEW SIGNS		EXISTING SIGNS			EXIST POST		NUMBER OF NEW POSTS	SQUARE STEEL (IN)			TUBULAR STEEL Ø (IN)				SIGN FRAME REQUIRED	REMARKS	SIGN DETAIL			
								"A"	"B"	RETAIN	SALVAGE FROM	SALVAGE TO	REMOVE	RETAIN		REMOVE	1.75	2.00	2.50	3.00	3.50	4.00			5.00	DETAIL IN SHS	DETAIL ON SHEET NUMBER	DETAIL ON STD SHEET NUMBER
																	(LB / FT)			(LB / FT)								
WILMINGTON VT 100							FY-FLUORESCENT YELLOW FYG-FLUORESCENT YELLOW GREEN															"SHS"-STANDARD HIGHWAY SIGNS						
			C M6-1R	21	15			2.19															GREEN ON WHITE SHEETING	X				
NB	4.990		J R4-7	24	30							1																
			J OM1-1	18	18							1																
			K OM1-1	18	18							1																
			J R4-7	24	30			5.00						1									INSTALL AT 7 FT VERTICAL CLEARANCE.	X		E-121		
			J OM1-1	18	18			2.25															YELLOW ON YELLOW; INSTALL AT 4 FT VERTICAL CLEARANCE	X				
			K OM1-1	18	18			2.25															BACK TO BACK WITH THE OTHER YELLOW CLUSTER	X				
NB	5.004		A M3-1	24	12							1																
			A M1-5	30	24							1																
			A M3-1	24	12			2.00															GREEN ON WHITE SHEETING. INSTALL 100 FT BEYOND INTERSECTION w/ COLDBROOK RD (TH 1) ON LEFT.	X				
			A M1-5	30	24			5.00						1												E-136B		
NB	5.040		A R2-1	24	30			5.00															INSTALL 190' NORTH OF ROUTE MARKER	X				
NB	5.220		A W11-7	30	30		EQUESTRIAN SYMBOL					1																
			A W16-4	24	18		NEXT 1000 FT (PLAQUE)					1																
NB	5.370		A W1-2R	30	30		CURVE RIGHT					1																
SIGN SUMMARY SHEET							SHEET TOTALS	23.69	0.00	0	0	0	8	0	0	3	30							PROJECT NAME: Stamford-Andover VT100				
VERMONT AGENCY OF TRANSPORTATION							TOWN TOTALS	825.4	0.0	64.0	15.0	15.0	145	0.0	0.0	145	2175.0							PROJECT NUMBER: STPG SIGN(20)	FILE NAME: Wilmington.xls	PLOT DATE: 8/6/2009		
								SF	SF	EA	EA	EA	EA	EA	EA	EA	EA	EA	EA	EA	EA	EA	EA	EA	DESIGNED BY: M. Miller	CHECKED BY: T. Guazzoni	PROJECT MANAGER: N. Avery	DRAWN BY: T. Guazzoni
																								WILMINGTON SHEET 12	SHEET 82	OF 198		

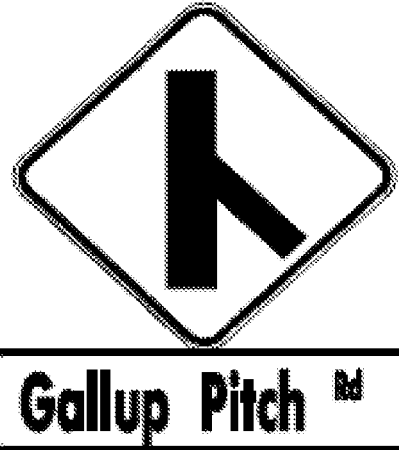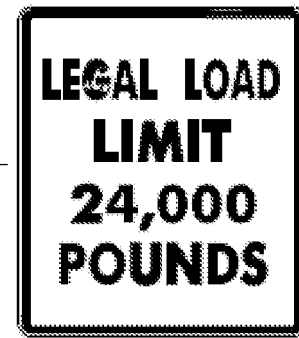

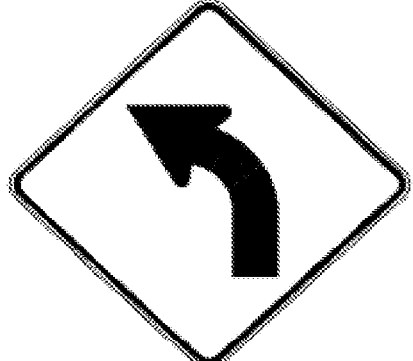


DIRECTION	MILEPOINT	LOCATION CODE (SHEET 2)	SIGN CODE	WIDTH (IN)	HEIGHT (IN)	SHEETING REMARKS	SIGN LEGEND	NEW SIGNS		EXISTING SIGNS			EXIST POST		NUMBER OF NEW POSTS	SQUARE STEEL (IN)			TUBULAR STEEL Ø (IN)				SIGN FRAME REQUIRED	REMARKS	SIGN DETAIL				
								"A"	"B"	RETAIN	SALVAGE FROM	SALVAGE TO	REMOVE	RETAIN		REMOVE	1.75	2.00	2.50	FOUNDATION	3.00	3.50			4.00	5.00	DETAIL IN SHS	DETAIL ON SHEET NUMBER	DETAIL ON STD SHEET NUMBER
																	(LB / FT)				(LB / FT)								
WILMINGTON VT 100							FY-FLUORESCENT YELLOW FYG-FLUORESCENT YELLOW GREEN															"SHS"-STANDARD HIGHWAY SIGNS							
NB	6.050	A	W11-7	30	30						1		X																
		A	W11-7P	24	18	XING PLAQUE					+																		
		A	W11-7	30	30			6.25						1		X							X						
NB	6.120	A	VD-062AS	72	16	BUSINESS SIGN				1			X																
		A	VD-062AS	72	16	BUSINESS SIGN				1																			
NB	6.155	A	W1-2L	30	30			6.25						1		X						INSTALL 200 FT ± NORTH OF THE BUSINESS SIGN ASSEMBLY; MAINTAIN 10 FT MIN TO UTILITY POLE.	X						
		A	W13-1	18	18			2.25															X						
NB	6.200	A	W1-6	48	24						1		X																
		A	W1-6	48	24			8.00						2		X							X						
NB	6.215	A	W1-6	48	24						1		X																
		A	W1-6	48	24			8.00						2		X							X						
NB	6.225	B	W1-6	48	24						1		X																
		B	W1-6	48	24			8.00						2		X							X						
NB	6.240	B	W1-6	48	24						1		X																
		B	W1-6	48	24			8.00						2		X							X						
SIGN SUMMARY SHEET							SHEET TOTALS	46.75	0.00	2	0	0	7	0	0	10	150					PROJECT NAME: Stamford-Andover VT100							
VERMONT AGENCY OF TRANSPORTATION							TOWN TOTALS	825.4	0.0	64.0	15.0	15.0	145	0.0	0.0	145	2175.0					PROJECT NUMBER: STPG SIGN(20)							
								SF	SF	EA	EA	EA	EA	EA	EA	EA	FT					FILE NAME: Wilmington.xls	PLOT DATE: 8/6/2009						
																						PROJECT MANAGER: N. Avery	DRAWN BY: T. Guazzoni						
																						DESIGNED BY: M. Miller	CHECKED BY: T. Guazzoni						
																						WILMINGTON SHEET 14	SHEET 84 OF 198						

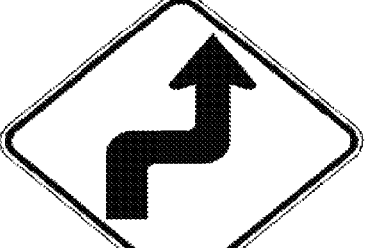DIRECTION	MILEPOINT	LOCATION CODE (SHEET 2)	SIGN CODE	WIDTH (IN)	HEIGHT (IN)	SHEETING REMARKS	SIGN LEGEND	NEW SIGNS		EXISTING SIGNS				EXIST POST		NUMBER OF NEW POSTS	SQUARE STEEL (IN)			TUBULAR STEEL Ø (IN)				SIGN FRAME REQUIRED	REMARKS	SIGN DETAIL			
								"A"	"B"	RETAIN	SALVAGE FROM	SALVAGE TO	REMOVE	RETAIN	REMOVE		(LB / FT)			(LB / FT)						DETAIL IN SHS	DETAIL ON SHEET NUMBER	DETAIL ON STD SHEET NUMBER	
																	1.75	2.00	2.50	3.00	3.50	4.00	5.00						
WILMINGTON VT 100							FY-FLUORESCENT YELLOW FYG-FLUORESCENT YELLOW GREEN																"SHS"-STANDARD HIGHWAY SIGNS						
NB	6.293	A	VD-062AS	72	16		BUSINESS SIGN			1																			
		A	VD-062B	72	16		BUSINESS SIGN			1																			
NB	6.375	A	W1-10L	30	30		LEFT CURVE w/ MINOR SIDE ROAD RIGHT			1																			
		A	W16-8A	24	18		E. DOVER RD (PLAQUE)			1																			
NB	6.395	A	D1-1S	72	10																								
		A	D1-1A	72	10																								
		A	D1-1A	72	10																								
		A	D1-1A	72	10																								
		A	D1-1A	72	10																								
		A	D1-1	72	12			6.00							2												5		
		A	D1-1A	72	12			6.00																			5		
		A	D1-1A	72	12			6.00																			5		
		A	D1-1A	72	12			6.00																			5		
		A	D1-1A	72	12			6.00																			5		
		A	D1-1A	72	12			6.00																					
NB	6.440	C	VR-017	24	30																						EAST DOVER RD (TH-2) SOUTHERLY APPROACH TO TH-2		
SIGN SUMMARY SHEET							SHEET TOTALS	30.00	0.00	4	0	0	6	0	0	2	30												PROJECT NAME: Stamford-Andover VT100
								SF	SF	EA	EA	EA	EA	EA	EA	EA	FT											PROJECT NUMBER: STPG SIGN(20)	
VERMONT AGENCY OF TRANSPORTATION							TOWN TOTALS	825.4	0.0	64.0	15.0	15.0	145	0.0	0.0	145	2175.0												FILE NAME: Wilmington.xls
																												PLOT DATE: 8/6/2009	
																												DRAWN BY: T. Guazzoni	
																												CHECKED BY: T. Guazzoni	
																												SHEET 85 OF 198	

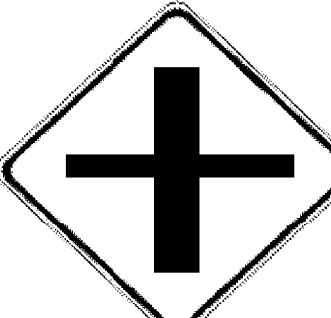






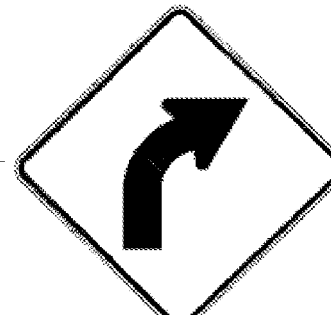
DIRECTION	MILEPOINT	LOCATION CODE (SHEET 2)	SIGN CODE	WIDTH (IN)	HEIGHT (IN)	SHEETING REMARKS	SIGN LEGEND	NEW SIGNS		EXISTING SIGNS			EXIST POST		NUMBER OF NEW POSTS	SQUARE STEEL (IN)			TUBULAR STEEL Ø (IN)				SIGN FRAME REQUIRED	REMARKS	SIGN DETAIL				
								"A"	"B"	RETAIN	SALVAGE FROM	SALVAGE TO	REMOVE	RETAIN		REMOVE	1.75	2.00	2.50	FOUNDATION	3.00	3.50			4.00	5.00	DETAIL IN SHS	DETAIL ON SHEET NUMBER	DETAIL ON STD SHEET NUMBER
																	(LB / FT)				(LB / FT)								
WILMINGTON VT 100							FY-FLUORESCENT YELLOW FYG-FLUORESCENT YELLOW GREEN															"SHS"-STANDARD HIGHWAY SIGNS							
		C	VR-017	24	30			5.00						1		X							INSTALL AT A POINT JUST BEYOND THE CONVERGENCE OF THE TWO APPROACHES TO TH-2.			E-141			
NB	6.448	D	R1-1	30	30							1											SOUTHERLY APPROACH TO TH-2						
		D	R1-1	30	30			6.25						1		X							INSTALL IN THE SMALL TRIANGULAR ISLAND FOR THE SOUTHERLY APPROACH	X					
NB	6.449	C	R1-2	36	36		 				1												FACES EB TH-2 TRAFFIC AT THE NORTHERLY APPROACH						
		C	R1-2	36	36			3.89						1		X							INSTALL IN THE SMALL TRIANGULAR ISLAND FOR THE NORTHERLY APPROACH	X					
NB	6.457	D	R1-1	30	30							1											NORTHERLY APPROACH TO TH-2						
		D	R1-1	30	30			6.25						1		X								X					
NB	6.510	A	M3-1	24	12							1																	
		A	M1-5	30	24							1																	
		A	M3-1	24	12			2.00						1		X							GREEN ON WHITE SHEETING	X					
		A	M1-5	30	24			5.00																		E-136B			
NB	7.130	A	W1-4L	30	30		REVERSE CURVE LEFT					1																	
		A	W13-1	18	18		40-MPH (PLAQUE) 					1																	
NB	7.215	A	W1-4L	30	30			6.25						1		X							INSTALL 450 FT ± NORTH OF PREVIOUS POSITION	X					
		A	W13-1	18	18			2.25																X					
SIGN SUMMARY SHEET							SHEET TOTALS	36.89	0.00	0	0	0	7	0	0	6	90							PROJECT NAME: Stamford-Andover VT100					
								SF	SF	EA	EA	EA	EA	EA	EA	EA	FT							PROJECT NUMBER: STPG SIGN(20)					
VERMONT AGENCY OF TRANSPORTATION							TOWN TOTALS	825.4	0.0	64.0	15.0	15.0	145	0.0	0.0	145	2175.0							FILE NAME: Wilmington.xls	PLOT DATE: 8/6/2009				
																							PROJECT MANAGER: N. Avery	DRAWN BY: T. Guazzoni					
																							DESIGNED BY: M. Miller	CHECKED BY: T. Guazzoni					
																							WILMINGTON SHEET 16	SHEET 86 OF 198					

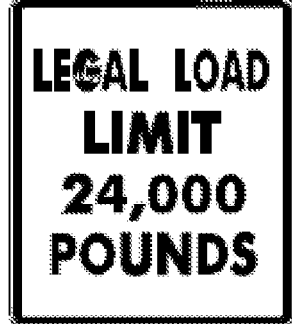








DIRECTION	MILEPOINT	LOCATION CODE (SHEET 2)	SIGN CODE	WIDTH (IN)	HEIGHT (IN)	SHEETING REMARKS	SIGN LEGEND	NEW SIGNS		EXISTING SIGNS			EXIST POST		NUMBER OF NEW POSTS	SQUARE STEEL (IN)			TUBULAR STEEL Ø (IN)				SIGN FRAME REQUIRED	REMARKS	SIGN DETAIL			
								"A"	"B"	RETAIN	SALVAGE FROM	SALVAGE TO	REMOVE	RETAIN		REMOVE	1.75	2.00	2.50	3.00	3.50	4.00			5.00	DETAIL IN SHS	DETAIL ON SHEET NUMBER	DETAIL ON STD SHEET NUMBER
																	(LB / FT)			(LB / FT)								
WILMINGTON VT 100							FY-FLUORESCENT YELLOW FYG-FLUORESCENT YELLOW GREEN															"SHS"-STANDARD HIGHWAY SIGNS						
SB	7.040	F	W2-3MR	30	30						1		X															
		F	W16-8A	24	18							1																
		F	W2-3MaL	30	30	FY		6.25							1	X								INSTALL SIGN AS SHOWN		6		
		F	W16-8	30	18	FY		3.75 3.00																	8			
SB	6.972	G	VR-017	24	30						1		X											GALLUP PITCH RD (TH-50)				
		G	VR-017	24	30			5.00							1	X										E-141		
SB	6.964	H	R1-1	30	30						1		X											GALLUP PITCH RD (TH-50)				
		H	R1-1	30	30			6.25							1	X								INSTALL AS CLOSE TO STOPPING POINT AS POSSIBLE	X			
SB	6.690	F	VD-062AS	72	16		BUSINESS SIGN			1			X															
SB	6.634	F	W1-2R	30	30		CURVE RIGHT			1			X															
SB	6.410	F	M3-3	24	12						1		X															
		F	M1-5	30	24							1																
		F	M3-3	24	12			2.00							1	X								GREEN ON WHITE SHEETING	X			
		F	M1-5	30	24			5.00																		E-136B		
SB	6.330	F	W1-4R	30	30		REVERSE TURN RIGHT				1		X															
SIGN SUMMARY SHEET							SHEET TOTALS	28.25 27.50	0.00	2	0	0	7	0	0	4	60						PROJECT NAME: Stamford-Andover VT100					
VERMONT AGENCY OF TRANSPORTATION							TOWN TOTALS	825.4	0.0	64.0	15.0	15.0	145	0.0	0.0	145	2175.0						PROJECT NUMBER: STPG SIGN(20)					
								SF	SF	EA	EA	EA	EA	EA	EA	EA	FT						FILE NAME: Wilmington.xls					
																							PLOT DATE: 8/6/2009					
																							DRAWN BY: T. Guazzoni					
																							DESIGNED BY: M. Miller					
																							CHECKED BY: T. Guazzoni					
																							SHEET 87 OF 198					

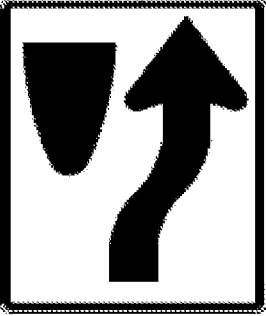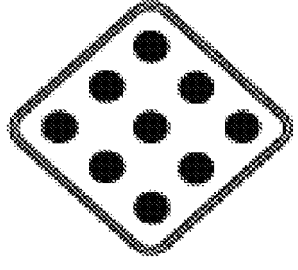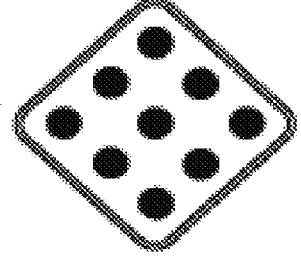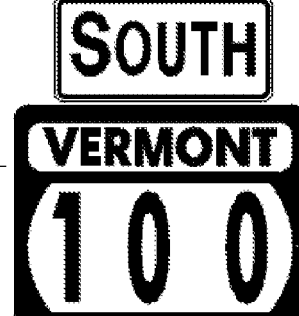





DIRECTION	MILEPOINT	LOCATION CODE (SHEET 2)	SIGN CODE	WIDTH (IN)	HEIGHT (IN)	SHEETING REMARKS	SIGN LEGEND	NEW SIGNS		EXISTING SIGNS			EXIST POST		NUMBER OF NEW POSTS	SQUARE STEEL (IN) (LB / FT)			TUBULAR STEEL Ø (IN) (LB / FT)				SIGN FRAME REQUIRED	REMARKS	SIGN DETAIL				
								"A"	"B"	RETAIN	SALVAGE FROM	SALVAGE TO	REMOVE	RETAIN		REMOVE	1.75	2.00	2.50	FOUNDATION	3.00	3.50			4.00	5.00	DETAIL IN SHS	DETAIL ON SHEET NUMBER	DETAIL ON STD SHEET NUMBER
WILMINGTON VT 100							FY-FLUORESCENT YELLOW FYG-FLUORESCENT YELLOW GREEN															"SHS"-STANDARD HIGHWAY SIGNS							
			F W13-1	18	18		30-MPH (PLAQUE)						1																
SB	6.320		F W1-3R	30	30			6.25							1		X					INSTALL TO A NEW POSITION 50 FT ± SOUTH OF PREVIOUS LOCATION.	X						
			F W13-1	18	18			2.25															X						
SB	6.275		F W11-7	30	30							1		X															
			F W11-7P	24	18		CROSSING PLAQUE						1																
			F W11-7	30	30			6.25						1		X							X						
SB	5.870		G VR-017	24	30							1		X								OLD ARK RD (TH-14)							
			G VR-017	24	30			5.00					1		X										E-141				
SB	5.862		H R1-1	30	30							1		X								OLD ARK RD (TH-14)							
			H R1-1	30	30			6.25					1		X								X						
SB	5.720		F VD-062AS	72	16		BUSINESS SIGN							X								SIGN REMOVED - BUSINESS IS SALVAGED TO M.P. 5.695 - CLOSED							
			F W2-1Mb	36	36	FY		9.00						2		X									6				
			F W16-8a	48	15	FY		5.00																	8				
SB	5.695		F VD-062AS	72	16		BUSINESS SIGN							2		X						BUSINESS IS CLOSED SALVAGED FROM M.P. 5.720 - INSTALL 130 SOUTH OF EXISTING LOCATION							
SB	5.640		G VR-017	24	30							1		X								HASKELL HILL RD (TH-80)							
SIGN SUMMARY SHEET							SHEET TOTALS	40.00	0.00	0	0	0	7	0	0	8		120					PROJECT NAME: Stamford-Andover VT100						
								SF	SF	EA	EA	EA	EA	EA	EA	EA		FT					PROJECT NUMBER: STPG SIGN(20)						
VERMONT AGENCY OF TRANSPORTATION							TOWN TOTALS	825.4	0.0	64.0	15.0	15.0	145	0.0	0.0	145		2175.0					FILE NAME: Wilmington.xls	PLOT DATE: 8/6/2009					
																						PROJECT MANAGER: N. Avery	DRAWN BY: T. Guazzoni						
																						DESIGNED BY: M. Miller	CHECKED BY: T. Guazzoni						
																						WILMINGTON SHEET 18	SHEET 88 OF 198						

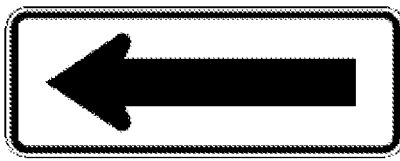

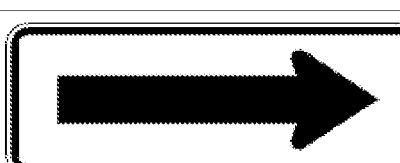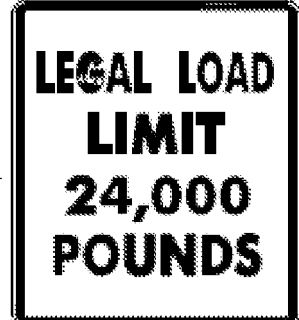
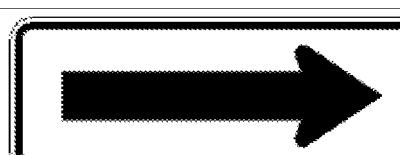
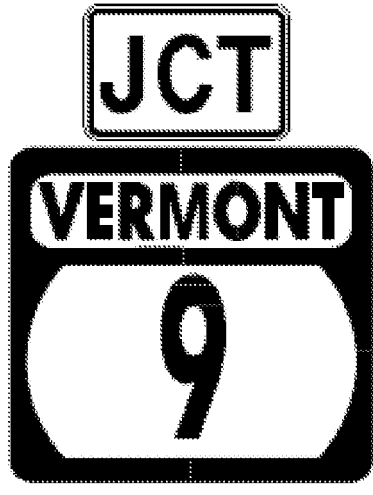
DIRECTION	MILEPOINT	LOCATION CODE (SHEET 2)	SIGN CODE	WIDTH (IN)	HEIGHT (IN)	SHEETING REMARKS	SIGN LEGEND	NEW SIGNS		EXISTING SIGNS			EXIST POST		NUMBER OF NEW POSTS	SQUARE STEEL (IN)			TUBULAR STEEL Ø (IN)				SIGN FRAME REQUIRED	REMARKS	SIGN DETAIL				
								"A"	"B"	RETAIN	SALVAGE FROM	SALVAGE TO	REMOVE	RETAIN		REMOVE	1.75	2.00	2.50	3.00	3.50	4.00			5.00	DETAIL IN SHS	DETAIL ON SHEET NUMBER	DETAIL ON STD SHEET NUMBER	
																	(LB / FT)			(LB / FT)									
WILMINGTON VT 100							FY-FLUORESCENT YELLOW FYG-FLUORESCENT YELLOW GREEN															"SHS"-STANDARD HIGHWAY SIGNS							
			G VR-017	24	30			5.00						1	X											E-141			
SB	5.632		H R1-1	30	30							1		X											HASKELL HILL RD (TH-80)				
			H R1-1	30	30			6.25						1	X										X				
SB	5.560		F W1-2L	30	30		CURVE LEFT					1		X															
			F W13-1	18	18		35 MPH					1																	
SB	5.508		F W11-7	30	30		EQUESTRIAN SYMBOL					1		X															
			F W16-4	24	18		NEXT 1000 FT (PLAQUE)					1																	
			F W1-2L	30	30			6.25						1	X										X				
			F W13-1	18	18			2.25																	X				
SB	5.425		F VW-619	30	30							1		X															
			F VW-619	30	30			6.25						1	X											SALVAGED MM ONTO NEW POST.		7	
SB	5.185		F VD-062B	72	16		BUSINESS SIGN				1			X															
			F VD-062AS	72	16		BUSINESS SIGN				1																		
SB	5.045		K R4-7	24	30							1		X															
			K OM1-1	18	18							1																	
SIGN SUMMARY SHEET							SHEET TOTALS	26.00	0.00	2	0	0	8	0	0	4	60												
VERMONT AGENCY OF TRANSPORTATION							TOWN TOTALS	825.4	0.0	64.0	15.0	15.0	145	0.0	0.0	145	2175.0												
PROJECT NAME: Stamford-Andover VT100																					PROJECT NUMBER: STPG SIGN(20)								
FILE NAME: Wilmington.xls												PLOT DATE: 8/6/2009																	
PROJECT MANAGER: N. Avery												DRAWN BY: T. Guazzoni																	
DESIGNED BY: M. Miller												CHECKED BY: T. Guazzoni																	
WILMINGTON SHEET 19												SHEET 89 OF 198																	

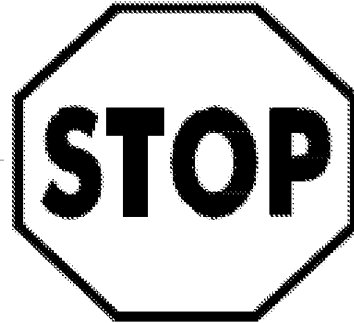DIRECTION	MILEPOINT	LOCATION CODE (SHEET 2)	SIGN CODE	WIDTH (IN)	HEIGHT (IN)	SHEETING REMARKS	SIGN LEGEND	NEW SIGNS		EXISTING SIGNS			EXIST POST		NUMBER OF NEW POSTS	SQUARE STEEL (IN)			TUBULAR STEEL Ø (IN)				SIGN FRAME REQUIRED	REMARKS	SIGN DETAIL				
								"A"	"B"	RETAIN	SALVAGE FROM	SALVAGE TO	REMOVE	RETAIN		REMOVE	1.75	2.00	2.50	FOUNDATION	3.00	3.50			4.00	5.00	DETAIL IN SHS	DETAIL ON SHEET NUMBER	DETAIL ON STD SHEET NUMBER
																	(LB / FT)				(LB / FT)								
WILMINGTON VT 100							FY-FLUORESCENT YELLOW FYG-FLUORESCENT YELLOW GREEN															"SHS"-STANDARD HIGHWAY SIGNS							
			J OM1-1	18	18							1																	
			K R4-7	24 34	30			5.00						1	X									INSTALLED IN THE RAISED MEDIAN	X				
			K OM1-1	18	18			2.25																INSTALL THE TWO OBJECT MARKERS BACK TO BACK.	X				
			J OM1-1	18	18			2.25																PROVIDE 4 FT OF CLEARANCE TO THE BOTTOM OF THE OBJECT MARKERS.	X				
SB	5.043	F	D1-1S	72	10							1		X															
		F	D1-1	72	12			6.00						2	X											6			
SB	4.984	G	VR-017	24	30			5.00					1	X										COLDBROOK RD (TH-1)			E-141		
SB	4.980	H	R1-1	30	30	STOP						1		X									COLDBROOK RD (TH-1).						
		G	R4-7	24	30	"BULLNOSE" SYMBOL						2											<p>ANOTHER SET OF SIGNS WERE REMOVED AT THE WEST END OF THIS ISLAND ON THE T.H. THREE NEW SIGNS WERE INSTALLED. LATER THE POST WAS REPLACED SEE SHEET *97.</p>						
		H	OM1-1	18	18	OBJECT MARKER						2																	
		G	OM1-1	18	18	OBJECT MARKER						2																	
		G	R4-7	24	30		5.00																		X				
		G	OM1-1	18	18		5.00																INSTALL OBJECT MARKERS BACK-TO-BACK.	X					
		H	OM1-1	18	18		2.25																PROVIDE 4 FT CLEARANCE TO OBJECT MARKERS.	X					
SB	4.976	H	R1-1	30	30							1		X									COLDBROOK RD (TH-1)						
SIGN SUMMARY SHEET							SHEET TOTALS	39.50 30.00	0.00	0	0	0	10 7	0	0	4	60						PROJECT NAME: Stamford-Andover VT100						
VERMONT AGENCY OF TRANSPORTATION							TOWN TOTALS	825.4	0.0	64.0	15.0	15.0	145	0.0	0.0	145	2175.0						PROJECT NUMBER: STPG SIGN(20)						
								SF	SF	EA	EA	EA	EA	EA	EA	EA	FT						FILE NAME: Wilmington.xls	PLOT DATE: 8/6/2009					
																							PROJECT MANAGER: N. Avery	DRAWN BY: T. Guazzoni					
																							DESIGNED BY: M. Miller	CHECKED BY: T. Guazzoni					
																							WILMINGTON SHEET 20	SHEET 90	OF 198				




DIRECTION	MILEPOINT	LOCATION CODE (SHEET 2)	SIGN CODE	WIDTH (IN)	HEIGHT (IN)	SHEETING REMARKS	SIGN LEGEND	NEW SIGNS		EXISTING SIGNS			EXIST POST		NUMBER OF NEW POSTS	SQUARE STEEL (IN)			TUBULAR STEEL Ø (IN)				SIGN FRAME REQUIRED	REMARKS	SIGN DETAIL				
								"A"	"B"	RETAIN	SALVAGE FROM	SALVAGE TO	REMOVE	RETAIN		REMOVE	1.75	2.00	2.50	FOUNDATION	3.00	3.50			4.00	5.00	DETAIL IN SHS	DETAIL ON SHEET NUMBER	DETAIL ON STD SHEET NUMBER
																	(LB / FT)				(LB / FT)								
WILMINGTON VT 100							FY-FLUORESCENT YELLOW FYG-FLUORESCENT YELLOW GREEN															"SHS"-STANDARD HIGHWAY SIGNS							
			H R1-1	36	36			9.00		1	1			2	X								SALVAGED STREET SIGN ONTO NEW POST.	INSTALL THE UPSIZED STOP SIGN ON TWO NEW POSTS.	X				
SB	4.975		K R4-7	24	38							1												SEE NOTE FOR NB MM 4.860 - PAGE 80					
			K OM1-1	18	18							1																	
			J OM1-1	18	18							1																	
			K R4-7	24	38 30			5.00						1	X									INSTALLED IN THE RAISED MEDIAN ACROSS FROM ± THE TH-1 RIGHT-SIDE STOP SIGN.	X				
			K OM1-1	18	18			2.25																INSTALL OBJECT MARKERS BACK-TO-BACK.	X				
			J OM1-1	18	18			2.25																PROVIDE 4 FT CLEARANCE TO OBJECT MARKERS.	X				
SB	4.930		F M3-3	24	12			2.00				1			X								GREEN ON WHITE SHEETING. INSTALL 250 FT SOUTH OF JCT w/ COLDBROOK RD (TH-1)	X					
			F M1-5	30	24			5.00				1														E-136B			
SB	4.618		F W3-5	36	36		SPEED REDUCTION 40 MPH AHEAD (SYMBOL)			1					X														
SB	4.522		F R2-1	24	30		SPEED LIMIT 40					1			X												6		
			F R2-1	30	36			7.50						1	X														
SB	4.480		F W1-2R	30	30							1			X														
			F W1-2R	30	30			6.25						1	X										X				
SB	4.400		F S1-1YG	36	36		PENTAGONAL SCHOOL SYMBOL			1					X														
SIGN SUMMARY SHEET							SHEET TOTALS	39.25	0.00	2	0	0	7	0	0	6	90							PROJECT NAME: Stamford-Andover VT100					
VERMONT AGENCY OF TRANSPORTATION							TOWN TOTALS	825.4	0.0	64.0	15.0	15.0	145	0.0	0.0	145	2175.0							PROJECT NUMBER: STPG SIGN(20)	FILE NAME: Wilmington.xls	PLOT DATE: 8/6/2009			
								SF	SF	EA	EA	EA	EA	EA	EA	EA	FT							DESIGNED BY: M. Miller	DRAWN BY: T. Guazzoni				
																								CHECKED BY: T. Guazzoni	WILMINGTON SHEET 21	SHEET 91	OF 198		

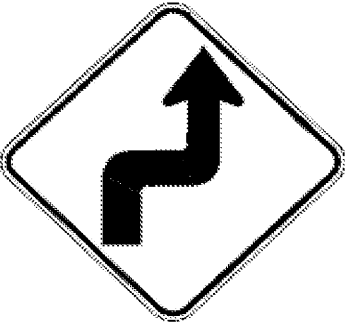




DIRECTION	MILEPOINT	LOCATION CODE (SHEET 2)	SIGN CODE	WIDTH (IN)	HEIGHT (IN)	SHEETING REMARKS	SIGN LEGEND	NEW SIGNS		EXISTING SIGNS			EXIST POST		NUMBER OF NEW POSTS	SQUARE STEEL (IN)			TUBULAR STEEL Ø (IN)				SIGN FRAME REQUIRED	REMARKS	SIGN DETAIL																				
								"A"	"B"	RETAIN	SALVAGE FROM	SALVAGE TO	REMOVE	RETAIN		REMOVE	1.75	2.00	2.50	FOUNDATION	3.00	3.50			4.00	5.00	DETAIL IN SHS	DETAIL ON SHEET NUMBER	DETAIL ON STD SHEET NUMBER																
																	(LB / FT)				(LB / FT)																								
WILMINGTON VT 100							FY-FLUORESCENT YELLOW FYG-FLUORESCENT YELLOW GREEN															"SHS"-STANDARD HIGHWAY SIGNS																							
			F R8-3A	24	24			4.00						1	X									X																					
			F M4-6P	24	12			2.00																X		RED ON WHITE SHEETING																			
SB	4.115		F W1-6	48	24						1		X																																
			F W1-6	48	24				8.00					2	X									X																					
SB	4.108		E W1-6	48	24						1		X																																
			E W1-6	48	24				8.00					2	X									X		PROVIDE 10 FT MINIMUM DISTANCE TO UTILITY POLE																			
SB	4.093		F S3-1	30	30		SCHOOL BUS STOP AHEAD				+		X													SCHOOL BUS STOPS HERE.																			
SB	4.075		F W1-6	48	24			8.00						2	X											INSTALL MIDWAY ± BETWEEN THE OTHER TWO SETS OF LARGE ARROWS																			
SB	4.074		E W1-6	48	24			8.00						2	X											IN SB LANE FACING NB TRAFFIC. INSTALL 5 FT ± FROM SB FACING ARROW.																			
SB	4.035		F W1-6	48	24						1		X																																
			F W1-6	48	24				8.00					2	X																														
SB	4.034		E W1-6	48	24						1		X																																
			E W1-6	48	24				8.00					2	X																														
SB	3.993		G VR-017	24	30						1		X																																
			G VR-017	24	30				5.00					1	X																														
SIGN SUMMARY SHEET							SHEET TOTALS	59.00	0.00	0	0	5	0	0	14	210																													
VERMONT AGENCY OF TRANSPORTATION							TOWN TOTALS	825.4	0.0	64.0	15.0	15.0	145	0.0	0.0	145	2175.0																												
																					PROJECT NAME:	Stamford-Andover VT100					PROJECT NUMBER:	STPG SIGN(20)					FILE NAME:	Wilmington.xls					PLOT DATE:	8/6/2009					
																					DESIGNED BY:	M. Miller					CHECKED BY:	T. Guazzoni					PROJECT MANAGER:	N. Avery					DRAWN BY:	T. Guazzoni					
																					WILMINGTON SHEET	23																							SHEET 93 OF 198



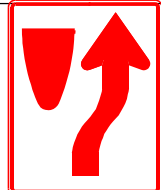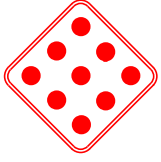




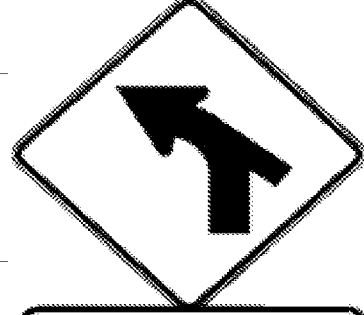


DIRECTION	MILEPOINT	LOCATION CODE (SHEET 2)	SIGN CODE	WIDTH (IN)	HEIGHT (IN)	SHEETING REMARKS	SIGN LEGEND	NEW SIGNS		EXISTING SIGNS				EXIST POST		NUMBER OF NEW POSTS	SQUARE STEEL (IN)			TUBULAR STEEL Ø (IN)				SIGN FRAME REQUIRED	REMARKS	SIGN DETAIL		
								"A"	"B"	RETAIN	SALVAGE FROM	SALVAGE TO	REMOVE	RETAIN	REMOVE		1.75	2.00	2.50	3.00	3.50	4.00	5.00			DETAIL IN SHS	DETAIL ON SHEET NUMBER	DETAIL ON STD SHEET NUMBER
																	(LB / FT)			(LB / FT)								
WILMINGTON VT 100							FY-FLUORESCENT YELLOW FYG-FLUORESCENT YELLOW GREEN															"SHS"-STANDARD HIGHWAY SIGNS						
SB	4.001	H	R1-1	30	30																							
		H	R1-1	30	30			6.25																X				
SB	3.952	F	R2-1	24	30		SPEED LIMIT 40			1																		
		F	R2-1	24	30							1																
		F	R2-1	24	30			5.00																X				
SB	3.345	F	VD-062C	74.75	16		TRAVEL INFO SYMBOLS			1																		
		F	VD-062BC	74.75	16		TRAVEL INFO TEXT			1																		
SB	3.215	F	W3-5	36	36		SPEED REDUCTION 25 MPH AHEAD			1																		
SB	3.125	F	VD-062B	72	16		BUSINESS SIGN			1																		
		F	VD-062B	72	16		BUSINESS SIGN			1																		
SB	3.090	F	R2-1	24	30																							
		F	R2-1	30	36			7.50																	6			
SB	2.970	F	R2-1	24	30			5.00																X				
SB	2.945	F	W1-3R	30	30		RIGHT REVERSE TURN 																					
SB	2.935	F	W1-3R	30	30			6.25																X				
SIGN SUMMARY SHEET							SHEET TOTALS	30.00	0.00	6	0	0	4	0	0	5	75					PROJECT NAME: Stamford-Andover VT100						
								SF	SF	EA	EA	EA	EA	EA	EA	EA	FT					PROJECT NUMBER: STPG SIGN(20)						
VERMONT AGENCY OF TRANSPORTATION							TOWN TOTALS	825.4	0.0	64.0	15.0	15.0	145	0.0	0.0	145	2175.0					FILE NAME: Wilmington.xls	PLOT DATE: 8/6/2009					
																						PROJECT MANAGER: N. Avery	DRAWN BY: T. Guazzoni					
																						DESIGNED BY: M. Miller	CHECKED BY: T. Guazzoni					
																						WILMINGTON SHEET 24	SHEET 94	OF 198				






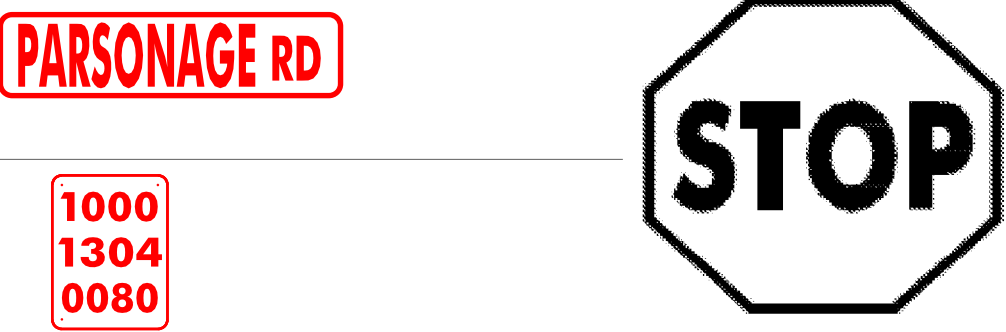

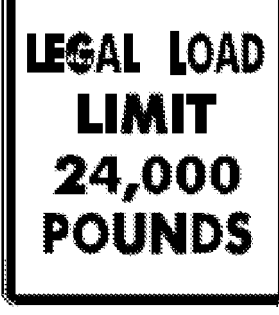
DIRECTION	MILEPOINT	LOCATION CODE (SHEET 2)	SIGN CODE	WIDTH (IN)	HEIGHT (IN)	SHEETING REMARKS	SIGN LEGEND	NEW SIGNS		EXISTING SIGNS			EXIST POST		NUMBER OF NEW POSTS	SQUARE STEEL (IN)			TUBULAR STEEL Ø (IN)				SIGN FRAME REQUIRED	REMARKS	SIGN DETAIL														
								"A"	"B"	RETAIN	SALVAGE FROM	SALVAGE TO	REMOVE	RETAIN		REMOVE	1.75	2.00	2.50	FOUNDATION	3.00	3.50			4.00	5.00	DETAIL IN SHS	DETAIL ON SHEET NUMBER	DETAIL ON STD SHEET NUMBER										
																	(LB / FT)				(LB / FT)																		
WILMINGTON VT 100							FY-FLUORESCENT YELLOW FYG-FLUORESCENT YELLOW GREEN																"SHS"-STANDARD HIGHWAY SIGNS																
SB	2.890	F	R2-1	24	30		SPEED LIMIT 25						1		X																								
SB	2.885	F	N/A				EMPTY POST								X																								
SB	2.845	F	W1-6	48	24								1		X																								
		F	W1-6	48	24				8.00								2		X																	X			
SB	2.844	E	W1-6	48	24								1		X																								
		E	W1-6	48	24				8.00								2		X																		X		
SB	2.836	F	W1-6	48	24		 1000 1322 0280						1		X																								
		F	W1-6	48	24				8.00								2		X																		X		
SB	2.835	E	W1-6	48	24								1		X																								
		E	W1-6	48	24				8.00								2		X																		X		
SB	2.785	F	M2-1	21	15								1		X																								
		F	M1-5	24	24									1																									
		F	M2-1	21	15				2.19								1		X																				
		F	M1-5	24	24				4.00																														
SB	2.725	F	D1-1A	72	10								1		X																								
SIGN SUMMARY SHEET							SHEET TOTALS	38.19	0.00	0	0	0	8	0	0	9	135																						
VERMONT AGENCY OF TRANSPORTATION							TOWN TOTALS	825.4	0.0	64.0	15.0	15.0	145	0.0	0.0	145	2175.0																						
																						PROJECT NAME:	Stamford-Andover VT100																
																						PROJECT NUMBER:	STPG SIGN(20)																
											FILE NAME:	Wilmington.xls						PLOT DATE:	8/6/2009																				
											PROJECT MANAGER:	N. Avery						DRAWN BY:	T. Guazzoni																				
											DESIGNED BY:	M. Miller						CHECKED BY:	T. Guazzoni																				
											WILMINGTON SHEET 25							SHEET	95		OF	198																	






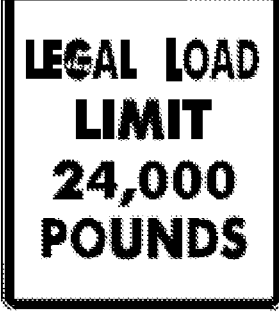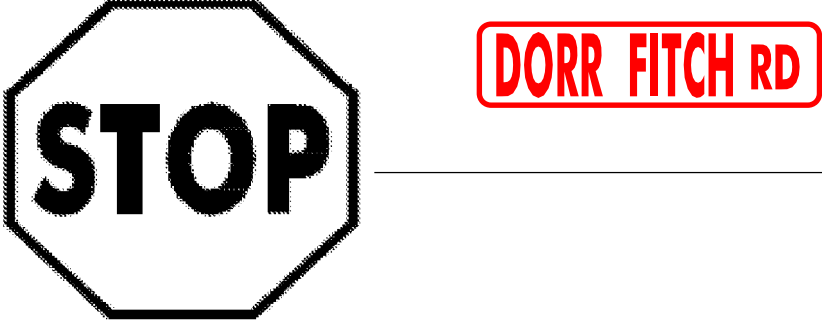



DIRECTION	MILEPOINT	LOCATION CODE (SHEET 2)	SIGN CODE	WIDTH (IN)	HEIGHT (IN)	SHEETING REMARKS	SIGN LEGEND	NEW SIGNS		EXISTING SIGNS			EXIST POST		NUMBER OF NEW POSTS	SQUARE STEEL (IN)			TUBULAR STEEL Ø (IN)				SIGN FRAME REQUIRED	REMARKS	SIGN DETAIL				
								"A"	"B"	RETAIN	SALVAGE FROM	SALVAGE TO	REMOVE	RETAIN		REMOVE	1.75	2.00	2.50	FOUNDATION	3.00	3.50			4.00	5.00	DETAIL IN SHS	DETAIL ON SHEET NUMBER	DETAIL ON STD SHEET NUMBER
																	(LB / FT)				(LB / FT)								
WILMINGTON VT 100							FY-FLUORESCENT YELLOW FYG-FLUORESCENT YELLOW GREEN															"SHS"-STANDARD HIGHWAY SIGNS							
			F D1-1A	72	10																								
			F D1-1A	72	10																								
			F D1-1A	72	10																								
			F D1-1A	72	12			6.00								2			X										5
			F D1-1A	72	12			6.00																					5
			F D1-1A	72	12			6.00																					5
			F D1-1A	72	12			6.00																					5
SB	2.720		F W1-3R	30	30		RIGHT REVERSE TURN						1																
SB	2.630		F VR-020	24	30																								
			F VR-020	24	30			5.00								1		X											E-146
SB	2.570		F M3-2	24	12		EAST				1	1		*	X														
			F M1-5	24	24		VERMONT 9				1	1																	
			F M6-1	21	15		<--- LEFT				1	1																	
			F M3-3	24	12		SOUTH				1	1																	
			F M1-5	30	24		VERMONT 100				1	1																	
SIGN SUMMARY SHEET							SHEET TOTALS		29.00	0.00	0	5	5	4	0	0	4 5	75						PROJECT NAME: Stamford-Andover VT100					
							SF	SF	EA	EA	EA	EA	EA	EA	EA	EA	EA	FT							PROJECT NUMBER: STPG SIGN(20)				
VERMONT AGENCY OF TRANSPORTATION							TOWN TOTALS		825.4	0.0	64.0	15.0	15.0	145	0.0	0.0	145	2175.0						FILE NAME: Wilmington.xls	PLOT DATE: 8/6/2009				
																							PROJECT MANAGER: N. Avery	DRAWN BY: T. Guazzoni					
																							DESIGNED BY: M. Miller	CHECKED BY: T. Guazzoni					
																							WILMINGTON SHEET 26	SHEET 96	OF	198			





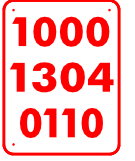

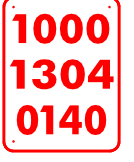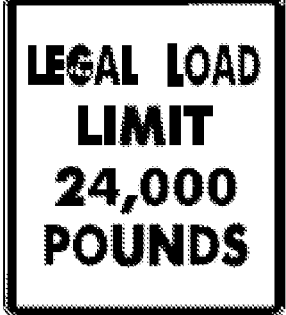


DIRECTION	MILEPOINT	LOCATION CODE (SHEET 2)	SIGN CODE	WIDTH (IN)	HEIGHT (IN)	SHEETING REMARKS	SIGN LEGEND	NEW SIGNS		EXISTING SIGNS			EXIST POST		NUMBER OF NEW POSTS	SQUARE STEEL (IN)			TUBULAR STEEL Ø (IN)				SIGN FRAME REQUIRED	REMARKS	SIGN DETAIL					
								"A"	"B"	RETAIN	SALVAGE FROM	SALVAGE TO	REMOVE	RETAIN		REMOVE	1.75	2.00	2.50	FOUNDATION	3.00	3.50			4.00	5.00	DETAIL IN SHS	DETAIL ON SHEET NUMBER	DETAIL ON STD SHEET NUMBER	
																	(LB / FT)				(LB / FT)									
WILMINGTON VT 100							FY-FLUORESCENT YELLOW FYG-FLUORESCENT YELLOW GREEN															"SHS"-STANDARD HIGHWAY SIGNS								
SB	2.570	F	M6-1	21	15		<--- LEFT			1	1																			
		F	M3-4	24	12		WEST			1	1																			
		F	M1-5	24	24		VERMONT 9			1	1																			
		F	M6-1	21	15		RIGHT --->			1	1																			
SB	4.975	H	R4-7	24	30																						THIS ASSEMBLY IS ON THE WEST END OF THE ISLAND ON T/H/ #1			
		G	OMI-1	18	18																									
		G	OMI-1	18	18																						POST WAS REMOVED AND REPLACED. SIGNS WERE SALVAGED. SEE SHEET *90			
SIGN SUMMARY SHEET							SHEET TOTALS	0.00	0.00	0	7	7	3	0	0	0	0													
VERMONT AGENCY OF TRANSPORTATION							TOWN TOTALS	825.4	0.0	64.0	15.0	15.0	145	0.0	0.0	145	2175.0													
															PROJECT NAME:	Stamford-Andover VT100														
															PROJECT NUMBER:	STPG SIGN(20)														
															FILE NAME:	Wilminaton.xls						PLOT DATE:	8/6/2009							
															PROJECT MANAGER:	N. Avery						DRAWN BY:	T. Guazzoni							
															DESIGNED BY:	M. Miller						CHECKED BY:	T. Guazzoni							
															WILMINGTON SHEET	27						SHEET	97 OF 198							





DIRECTION	MILEPOINT	LOCATION CODE (SHEET 2)	SIGN CODE	WIDTH (IN)	HEIGHT (IN)	SHEETING REMARKS	SIGN LEGEND	NEW SIGNS		EXISTING SIGNS			EXIST POST		NUMBER OF NEW POSTS	SQUARE STEEL (IN)			TUBULAR STEEL Ø (IN)				SIGN FRAME REQUIRED	REMARKS	SIGN DETAIL			
								"A"	"B"	RETAIN	SALVAGE FROM	SALVAGE TO	REMOVE	RETAIN		REMOVE	1.75	2.00	2.50	3.00	3.50	4.00			5.00	DETAIL IN SHS	DETAIL ON SHEET NUMBER	DETAIL ON STD SHEET NUMBER
																	(LB / FT)			(LB / FT)								
DOVER VT 100							FY-FLUORESCENT YELLOW FYG-FLUORESCENT YELLOW GREEN															"SHS"-STANDARD HIGHWAY SIGNS						
NB	0.000	C	VD-024	72	10		DOVER							2		X							INSTALL BEHIND RAIL DIRECTLY ACROSS FROM THE REMOVED SOUTHBOUND SIGN.		4			
		C	VD-700	6	10		1000 1304 0000	5.00 6.00															DOVER MILE MARKER. INSTALL ON THE LEFT SIDE POST UNDER DOVER.			E-138		
		C	VD-700	6	10		1000 1322 0736	0.42															WILMINGTON MILE MARKER. INSTALL ON THE RIGHT SIDE POST UNDER WILMINGTON.			E-138		
NB	0.270	A	R2-5A	24	30		REDUCED SPEED AHEAD					1		X														
		A	W3-5	36	36			9.00						2		X								X				
NB	0.360	A	W1-2L	30	30		CURVE LEFT					1		X														
NB	0.400	A	R2-1	24	30							1		X														
		A	R4-1	24	30							1																
		A	R2-1	24	30		DO NOT PASS	5.00						1		X							SPEED LIMIT SIGN ON TOP.	X				
		A	R4-1	24	30		1000 1304 0040	5.00															SALVAGED MM ONTO NEW POST.	X				
NB	0.450	A	W1-3L	30	30							1		X														
		A	W13-1	18	18							1																
		A	W1-3L	30	30			6.25						1		X								X				
		A	W13-1	18	18			2.25																X				
NB	0.510	A	W1-6	48	24							1		X														
SIGN SUMMARY SHEET							SHEET TOTALS	33.34 34.34	0.00	0	0	0	7	0	0	6	90						PROJECT NAME: Stamford-Andover VT100					
VERMONT AGENCY OF TRANSPORTATION							TOWN TOTALS	648.1	0.0	30.0	3.0	1.0	116	0.0	0.0	112	1680.0						PROJECT NUMBER: STPG SIGN(20)					
								SF	SF	EA	EA	EA	EA	EA	EA	EA	FT						FILE NAME: Dover.xls	PLOT DATE: 8/6/2009				
																							PROJECT MANAGER: N. Avery	DRAWN BY: I. Shea				
																							DESIGNED BY: M. Miller	CHECKED BY: T. Guazzoni				
																							DOVER SHEET 1	SHEET 98	OF 198			








DIRECTION	MILEPOINT	LOCATION CODE (SHEET 2)	SIGN CODE	WIDTH (IN)	HEIGHT (IN)	SHEETING REMARKS	SIGN LEGEND	NEW SIGNS		EXISTING SIGNS			EXIST POST		NUMBER OF NEW POSTS	SQUARE STEEL (IN)			TUBULAR STEEL Ø (IN)				SIGN FRAME REQUIRED	REMARKS	SIGN DETAIL			
								"A"	"B"	RETAIN	SALVAGE FROM	SALVAGE TO	REMOVE	RETAIN		REMOVE	1.75	2.00	2.50	3.00	3.50	4.00			5.00	DETAIL IN SHS	DETAIL ON SHEET NUMBER	DETAIL ON STD SHEET NUMBER
																	(LB / FT)			(LB / FT)								
DOVER VT 100							FY-FLUORESCENT YELLOW FYG-FLUORESCENT YELLOW GREEN															"SHS"-STANDARD HIGHWAY SIGNS						
				48	24			8.00						2		X								X				
NB	0.520	A	S3-1	30	30							1		X														
		A	VW-133L	30	30							1																
		A	S3-1	30	30			6.25						2		X								X				
		A	VW-054L	30	30			6.25																	E-154			
NB	0.525	B	W1-6	48	24							1		X														
		B	W1-6	48	24	FY		8.00						2		X								X				
NB	0.590	A	R2-1	24	30							1		X														
		A	R4-1	24	30							1																
		A	R2-1	24	30			5.00						1		X								X				
		A	R4-1	24	30			5.00																X				
NB	0.810	A	W2-3MR	30	30		SIDE ROAD RIGHT (DOWN 45°) SYMBOL					1		X														
		A	W1-2Mh L	30	30			6.25						1		X									6			
		A	W16-8	30	8		 	1.67																	8			
NB	0.830	A	R2-1	24	30		SPEED LIMIT 35					1		X														
SIGN SUMMARY SHEET							SHEET TOTALS	46.42	0.00	0	0	0	7	0	0	8	120											
VERMONT AGENCY OF TRANSPORTATION							TOWN TOTALS	648.1	0.0	30.0	3.0	1.0	116	0.0	0.0	112	1680.0											
PROJECT NAME: Stamford-Andover VT100																					PROJECT NUMBER: STPG SIGN(20)							
FILE NAME: Dover.xls												PLOT DATE: 8/6/2009																
PROJECT MANAGER: N. Avery												DRAWN BY: I. Shea																
DESIGNED BY: M. Miller												CHECKED BY: T. Guazzoni																
DOVER SHEET 2												SHEET 99 OF 198																



DIRECTION	MILEPOINT	LOCATION CODE (SHEET 2)	SIGN CODE	WIDTH (IN)	HEIGHT (IN)	SHEETING REMARKS	SIGN LEGEND	NEW SIGNS		EXISTING SIGNS			EXIST POST		NUMBER OF NEW POSTS	SQUARE STEEL (IN)			TUBULAR STEEL Ø (IN)				SIGN FRAME REQUIRED	REMARKS	SIGN DETAIL				
								"A"	"B"	RETAIN	SALVAGE FROM	SALVAGE TO	REMOVE	RETAIN		REMOVE	1.75	2.00	2.50	FOUNDATION	3.00	3.50			4.00	5.00	DETAIL IN SHS	DETAIL ON SHEET NUMBER	DETAIL ON STD SHEET NUMBER
																	(LB / FT)				(LB / FT)								
DOVER VT 100							FY-FLUORESCENT YELLOW FYG-FLUORESCENT YELLOW GREEN															"SHS"-STANDARD HIGHWAY SIGNS							
NB	0.850	A	VD-062AS	72	16		BUSINESS SIGN			1																			
		A	VD-062AS	72	16		BUSINESS SIGN			1																			
NB	0.890	C	VR-017	24	30						1												DORR FITCH RD (TH-4)			E-141			
		C	VR-017	24	30			5.00						1		X													
NB	0.900	D	R1-1	30	30						1												DORR FITCH RD (TH-4)						
		D	R1-1	30	30			6.25						1		X							SALVAGED STREED SIGN AND MM ONTO NEW POST.	X					
NB	0.925	A	R2-1	24	30						1																		
		A	R2-1	24	30			5.00						1		X								X					
NB	0.983	C	VR-017	24	30						1												PARSONAGE RD (TH-35)						
		C	VR-017	24	30			5.00						1		X										E-141			
NB	0.991	D	R1-1	30	30						1												PARSONAGE RD (TH-35)						
		D	R1-1	30	30			6.25						1		X							SALVAGED STREED SIGN AND MM ONTO NEW POST.	X					
NB	1.096	C	VR-017	24	30						1												VALLEY VIEW RD (TH-15)						
		C	VR-017	24	30			5.00						1		X										E-141			
NB	1.104	D	R1-1	30	30						1					X							VALLEY VIEW RD (TH-15)						
SIGN SUMMARY SHEET							SHEET TOTALS	32.50	0.00	2	0	0	7	0	0	6	90						PROJECT NAME: Stamford-Andover VT100						
VERMONT AGENCY OF TRANSPORTATION							TOWN TOTALS	648.1	0.0	30.0	3.0	1.0	116	0.0	0.0	112	1680.0						PROJECT NUMBER: STPG SIGN(20)						
								SF	SF	EA	EA	EA	EA	EA	EA	EA	FT						FILE NAME: Dover.xls	PLOT DATE: 8/6/2009					
																							PROJECT MANAGER: N. Avery	DRAWN BY: I. Shea					
																							DESIGNED BY: M. Miller	CHECKED BY: T. Guazzoni					
																							DOVER SHEET 3	SHEET 100 OF 198					

DIRECTION	MILEPOINT	LOCATION CODE (SHEET 2)	SIGN CODE	WIDTH (IN)	HEIGHT (IN)	SHEETING REMARKS	SIGN LEGEND	NEW SIGNS		EXISTING SIGNS			EXIST POST		NUMBER OF NEW POSTS	SQUARE STEEL (IN)			TUBULAR STEEL Ø (IN)				SIGN FRAME REQUIRED	REMARKS	SIGN DETAIL			
								"A"	"B"	RETAIN	SALVAGE FROM	SALVAGE TO	REMOVE	RETAIN		REMOVE	1.75	2.00	2.50	3.00	3.50	4.00			5.00	DETAIL IN SHS	DETAIL ON SHEET NUMBER	DETAIL ON STD SHEET NUMBER
																	(LB / FT)			(LB / FT)								
DOVER VT 100							FY-FLUORESCENT YELLOW FYG-FLUORESCENT YELLOW GREEN															"SHS"-STANDARD HIGHWAY SIGNS						
			D R1-1	30	30		  	6.25						1		X							SALVAGED STREET SIGN AND MM ONTO NEW POST.	INSTALL IN POSITION OF BUS STOP SIGN. SEE NB 1.106 BELOW. SALVAGE SIGN TO M.P. 1.106	X			
			D N/A				BUS STOP SIGN			+																		
NB	1.106		A N/A				BUS STOP SIGN				+			1		X							NO WORK WAS DONE. SALVAGED SIGN FROM M.P. 1.104					
NB	1.200		A R2-1	24	30							1				X												
			B W14-3	48	36							1																
			A R2-1	24	30		 	5.00						1		X									X			
			B W14-3	40	30			3.86															INSTALL ON BACK	X				
NB	1.314 1.235		A M3-1	24	12			2.00						1		X							THIS SIGN WAS MOVED FOR BETTER VISIBILITY	GREEN ON WHITE SHEETING. 600 INSTALL 200 FT ± NORTH OF SPEED LIMIT 40. MAINTAIN 10 FT MIN TO UTILITY POLE.	X			
			A M1-5	30	24			5.00																	E-136B			
NB	1.410		A R2-1	24	30		 	5.00				1		X									SALVAGED MM ONTO NEW POST.		X			
			A R2-1	24	30									1		X												
NB	1.500		A VD-062AS	72	16		BUSINESS SIGN				1			X														
			A VD-062AS	72	16		BUSINESS SIGN				1																	
NB	1.581		C VR-017	24	30							1		X										WINDY HILL RD (TH-14)				
			C VR-017	24	30			5.00						1		X									E-141			
SIGN SUMMARY SHEET							SHEET TOTALS	32.11	0.00	2	1	1	4	0	0	6	90							PROJECT NAME: Stamford-Andover VT100				
								SF	SF	EA	EA	EA	EA	EA	EA	EA	FT							PROJECT NUMBER: STPG SIGN(20)				
VERMONT AGENCY OF TRANSPORTATION							TOWN TOTALS	648.1	0.0	30.0	3.0	1.0	116	0.0	0.0	112	1680.0							FILE NAME: Dover.xls	PLOT DATE: 8/6/2009			
																							PROJECT MANAGER: N. Avery	DRAWN BY: I. Shea				
																							DESIGNED BY: M. Miller	CHECKED BY: T. Guazzoni				
																							DOVER SHEET 4	SHEET 101 OF 198				

DIRECTION	MILEPOINT	LOCATION CODE (SHEET 2)	SIGN CODE	WIDTH (IN)	HEIGHT (IN)	SHEETING REMARKS	SIGN LEGEND	NEW SIGNS		EXISTING SIGNS			EXIST POST		NUMBER OF NEW POSTS	SQUARE STEEL (IN)			TUBULAR STEEL Ø (IN)				SIGN FRAME REQUIRED	REMARKS	SIGN DETAIL			
								"A"	"B"	RETAIN	SALVAGE FROM	SALVAGE TO	REMOVE	RETAIN		REMOVE	1.75	2.00	2.50	3.00	3.50	4.00			5.00	DETAIL IN SHS	DETAIL ON SHEET NUMBER	DETAIL ON STD SHEET NUMBER
																	(LB / FT)			(LB / FT)								
DOVER VT 100							FY-FLUORESCENT YELLOW FYG-FLUORESCENT YELLOW GREEN															"SHS"-STANDARD HIGHWAY SIGNS						
NB	1.589	D	R1-1	30	30		 WINDY HILL RD																					
		D	R1-1	30	30			6.25									X							X				
NB	1.600	A	R2-1	24	30		SPEED LIMIT 40 																					
NB	1.640	A	R2-1	24	30			5.00										X							X			
NB	1.930	A	R2-1	24	30																							
		A	R2-1	24	30			5.00										X							X			
NB	2.070	A	VD-062B	72	16		BUSINESS SIGN			1																		
NB	2.145	A	M3-1	24	12																							
		A	M1-5	30	24																							
		A	M6-2	21	15																							
		A	M3-1	24	12			2.00																X				
		A	M1-5	30	24			5.00																	E-136B			
		A	M6-2L	21	15			2.19																X				
NB	2.170	C	VR-017	24	30																							
		C	VR-017	24	30			5.00																	E-141			
SIGN SUMMARY SHEET							SHEET TOTALS	30.44	0.00	1	0	0	7	0	0	5	75					PROJECT NAME: Stamford-Andover VT100						
VERMONT AGENCY OF TRANSPORTATION							TOWN TOTALS	648.1	0.0	30.0	3.0	1.0	116	0.0	0.0	112	1680.0					PROJECT NUMBER: STPG SIGN(20)						
								SF	SF	EA	EA	EA	EA	EA	EA	EA	FT					FILE NAME: Dover.xls PLOT DATE: 8/6/2009						
																					PROJECT MANAGER: N. Avery DRAWN BY: I. Shea							
																					DESIGNED BY: M. Miller CHECKED BY: T. Guazzoni							
																					DOVER SHEET 5 SHEET 102 OF 198							


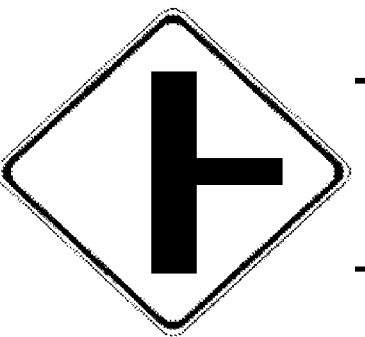
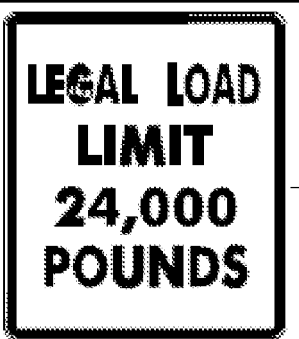





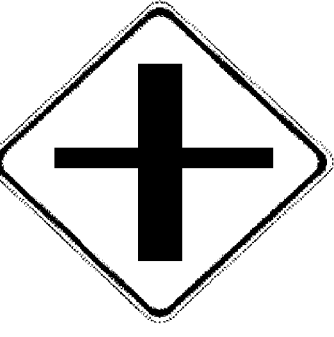
DIRECTION	MILEPOINT	LOCATION CODE (SHEET 2)	SIGN CODE	WIDTH (IN)	HEIGHT (IN)	SHEETING REMARKS	SIGN LEGEND	NEW SIGNS		EXISTING SIGNS			EXIST POST		NUMBER OF NEW POSTS	SQUARE STEEL (IN)			TUBULAR STEEL Ø (IN)				SIGN FRAME REQUIRED	REMARKS	SIGN DETAIL			
								"A"	"B"	RETAIN	SALVAGE FROM	SALVAGE TO	REMOVE	RETAIN		REMOVE	1.75	2.00	2.50	3.00	3.50	4.00			5.00	DETAIL IN SHS	DETAIL ON SHEET NUMBER	DETAIL ON STD SHEET NUMBER
																	(LB / FT)			(LB / FT)								
DOVER VT 100							FY-FLUORESCENT YELLOW FYG-FLUORESCENT YELLOW GREEN															"SHS"-STANDARD HIGHWAY SIGNS						
NB	2.180	D	R1-1	30	30																							
		D	R1-1	30	30			6.25											X					X				
NB	2.210	A	R2-1	24	30		SPEED LIMIT 40																					
NB	2.212	C	VR-017	24	30																							
		C	VR-017	24	30			5.00											X						E-141			
NB	2.220	D	R1-1	30	30																							
		D	R1-1	30	30			6.25											X					X				
NB	2.295	A	R2-1	24	30																							
		A	VD-062B	72	16		BUSINESS SIGN			1																		
		A	VD-062AL	72	16		BUSINESS SIGN			1																		
		A	VD-062AS	72	16		BUSINESS SIGN			1																		
NB	2.810	A	M3-1	24	12																							
		A	M1-5	30	24																							
		A	M6-2	21	15																							
		A	M3-1	24	12																							
SIGN SUMMARY SHEET							SHEET TOTALS	24.50	0.00	3	0	0	7	0	0	5	75						PROJECT NAME: Stamford-Andover VT100					
								SF	SF	EA	EA	EA	EA	EA	EA	EA	FT						PROJECT NUMBER: STPG SIGN(20)					
VERMONT AGENCY OF TRANSPORTATION							TOWN TOTALS	648.1	0.0	30.0	3.0	1.0	116	0.0	0.0	112	1680.0						FILE NAME: Dover.xls PLOT DATE: 8/6/2009					
																							PROJECT MANAGER: N. Avery DRAWN BY: I. Shea					
																							DESIGNED BY: M. Miller CHECKED BY: T. Guazzoni					
																							DOVER SHEET 6 SHEET 103 OF 198					

DIRECTION	MILEPOINT	LOCATION CODE (SHEET 2)	SIGN CODE	WIDTH (IN)	HEIGHT (IN)	SHEETING REMARKS	SIGN LEGEND	NEW SIGNS		EXISTING SIGNS			EXIST POST		NUMBER OF NEW POSTS	SQUARE STEEL (IN)			TUBULAR STEEL Ø (IN)				SIGN FRAME REQUIRED	REMARKS	SIGN DETAIL			
								"A"	"B"	RETAIN	SALVAGE FROM	SALVAGE TO	REMOVE	RETAIN		REMOVE	1.75	2.00	2.50	3.00	3.50	4.00			5.00	DETAIL IN SHS	DETAIL ON SHEET NUMBER	DETAIL ON STD SHEET NUMBER
																	(LB / FT)			(LB / FT)								
DOVER VT 100							FY-FLUORESCENT YELLOW FYG-FLUORESCENT YELLOW GREEN															"SHS"-STANDARD HIGHWAY SIGNS						
			A M1-5	30	24			5.00																		E-136B		
			A M6-2R	21	15			2.19															GREEN ON WHITE SHEETING	X				
NB	2.890		A R2-1	24	30							1																
			A R2-1	24	30			5.00										X							X			
NB	3.006		C VR-017	24	30							1											MOUNTAINVIEW LOOP (SOUTH) (TH-45)					
			C VR-017	24	30			5.00																			E-141	
NB	3.014		D R1-1	30	30							1														MOUNTAINVIEW LOOP (SOUTH) (TH-45)		
			D R1-1	30	30			6.25																	X			
NB	3.069		C VR-017	24	30		LEGAL LOAD LIMIT 24,000 LBS				1															MOUNTAINVIEW LOOP (NORTH) (TH-45)		
NB	3.077		D R1-1	30	30							1														MOUNTAINVIEW LOOP (NORTH) (TH-45)		
			D R1-1	30	30			6.25																	X			
NB	3.290		A VD-062AS	72	16		BUSINESS SIGN				1																	
NB	3.320		A VD-062B	72	16		BUSINESS SIGN				1																	
			A VD-062AL	72	16		BUSINESS SIGN				1																	
			A VD-062B	72	16		BUSINESS SIGN				1																	
SIGN SUMMARY SHEET							SHEET TOTALS	29.69	0.00	5	0	0	4	0	0	4	60							PROJECT NAME: Stamford-Andover VT100				
VERMONT AGENCY OF TRANSPORTATION							TOWN TOTALS	648.1	0.0	30.0	3.0	1.0	116	0.0	0.0	112	1680.0							PROJECT NUMBER: STPG SIGN(20)				
								SF	SF	EA	EA	EA	EA	EA	EA	EA	FT								FILE NAME: Dover.xls	PLOT DATE: 8/6/2009		
																									PROJECT MANAGER: N. Avery	DRAWN BY: I. Shea		
																									DESIGNED BY: M. Miller	CHECKED BY: T. Guazzoni		
																									DOVER SHEET 7	SHEET 104 OF 198		





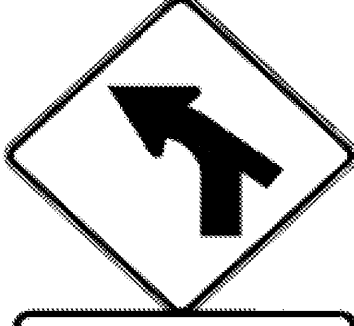

DIRECTION	MILEPOINT	LOCATION CODE (SHEET 2)	SIGN CODE	WIDTH (IN)	HEIGHT (IN)	SHEETING REMARKS	SIGN LEGEND	NEW SIGNS		EXISTING SIGNS				EXIST POST		NUMBER OF NEW POSTS	SQUARE STEEL (IN)			TUBULAR STEEL Ø (IN)				SIGN FRAME REQUIRED	REMARKS	SIGN DETAIL				
								"A"	"B"	RETAIN	SALVAGE FROM	SALVAGE TO	REMOVE	RETAIN	REMOVE		1.75	2.00	2.50	3.00	3.50	4.00	5.00			DETAIL IN SHS	DETAIL ON SHEET NUMBER	DETAIL ON STD SHEET NUMBER		
																	(LB / FT)			(LB / FT)										
DOVER VT 100							FY-FLUORESCENT YELLOW FYG-FLUORESCENT YELLOW GREEN															"SHS"-STANDARD HIGHWAY SIGNS								
NB	3.360	A	VD-062AS	72	16		BUSINESS SIGN			1																				
		A	VD-062AS	72	16		BUSINESS SIGN			1																				
NB	3.400	A	VD-062AL	72	16		BUSINESS SIGN			1																				
		A	VD-062AS	72	16		BUSINESS SIGN			1																				
NB	3.440	A	D4-1	30	24																									
		A	VR-731	30	15																									
		A	D4-1	30	24			5.00							1				X						X					
		A	VR-731	24	8			1.33																						
NB	3.480	A	VW-205	30	30		WATCH FOR TURNING VEHICLES																							
NB	3.605	C	M3-1	24	12		NORTH																							
		C	M1-5	30	24		VT 100																							
		C	M6-1	21	15		LEFT																							
		C	M3-3	24	12		SOUTH																							
		C	M1-5	30	24		VT 100																							
		C	M6-1	21	15		RIGHT																							
SIGN SUMMARY SHEET							SHEET TOTALS	6.33	0.00	4	0	0	9	0	0	1	15													
								SF	SF	EA	EA	EA	EA	EA	EA	EA	FT													
							TOWN TOTALS	648.1	0.0	32.0	1.0	1.0	116	0.0	0.0	112	1680.0													
VERMONT AGENCY OF TRANSPORTATION																							PROJECT NAME:	Stamford-Andover VT100						
																							PROJECT NUMBER:	STPG SIGN(20)						
																							FILE NAME:	Dover.xls			PLOT DATE:	8/10/2009		
																							PROJECT MANAGER:	N. Avery			DRAWN BY:	I. Shea		
																							DESIGNED BY:	M. Miller			CHECKED BY:	T. Guazzoni		
																							DOVER SHEET 8				SHEET	105 OF 198		




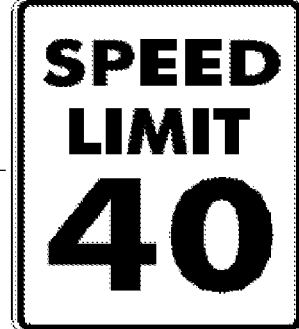

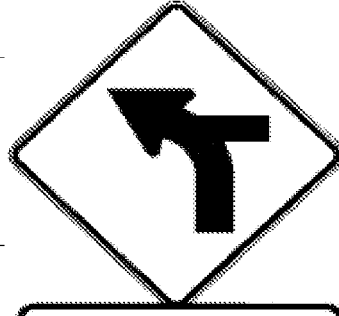

DIRECTION	MILEPOINT	LOCATION CODE (SHEET 2)	SIGN CODE	WIDTH (IN)	HEIGHT (IN)	SHEETING REMARKS	SIGN LEGEND	NEW SIGNS		EXISTING SIGNS			EXIST POST		NUMBER OF NEW POSTS	SQUARE STEEL (IN)			TUBULAR STEEL Ø (IN)				SIGN FRAME REQUIRED	REMARKS	SIGN DETAIL				
								"A"	"B"	RETAIN	SALVAGE FROM	SALVAGE TO	REMOVE	RETAIN		REMOVE	1.75	2.00	2.50	FOUNDATION	3.00	3.50			4.00	5.00	DETAIL IN SHS	DETAIL ON SHEET NUMBER	DETAIL ON STD SHEET NUMBER
																	(LB / FT)				(LB / FT)								
DOVER VT 100							FY-FLUORESCENT YELLOW FYG-FLUORESCENT YELLOW GREEN															"SHS"-STANDARD HIGHWAY SIGNS							
NB	3.610	C	M3-1	24	12			2.00						2	X							#2B	GREEN ON WHITE SHEETING; INSTALL ASSEMBLY 25 FT +/- NORTH OF PREVIOUS POSITION	X	7				
		C	M1-5	30	24			5.00																		E-136B			
		C	M6-1L	21	15			2.19															GREEN ON WHITE SHEETING	X					
		C	M3-3	24	12			2.00															GREEN ON WHITE SHEETING	X					
		C	M1-5	30	24			5.00																			E-136B		
		C	M6-1R	21	15			2.19															GREEN ON WHITE SHEETING	X					
NB	3.640	A	M3-1S	24	12						1		X																
		A	M1-5	24	24							1																	
		A	M3-1	24	12			2.00						1	X								GREEN ON WHITE SHEETING	X					
		A	M1-5	30	24			5.00																			E-136B		
NB	3.960	A	D1-1S	72	10						1		X																
		A	D1-1	72	12			6.00						2	X										5				
NB	4.035	A	VD-062B	72	16		BUSINESS SIGN			1			X																
NB	4.060	A	N/A				TWO EMPTY POSTS						X									MISSING							
NB	4.150	A	M3-1	24	12						1		X																
SIGN SUMMARY SHEET							SHEET TOTALS	31.38	0.00	1	0	0	4	0	0	5	75						PROJECT NAME: Stamford-Andover VT100						
VERMONT AGENCY OF TRANSPORTATION							TOWN TOTALS	648.1	0.0	30.0	3.0	1.0	116	0.0	0.0	112	1680.0						PROJECT NUMBER: STPG SIGN(20)	FILE NAME: Dover.xls	PLOT DATE: 8/6/2009				
								SF	SF	EA	EA	EA	EA	EA	EA	EA	FT					PROJECT MANAGER: N. Avery	DRAWN BY: I. Shea						
																					DESIGNED BY: M. Miller	CHECKED BY: T. Guazzoni							
																					DOVER SHEET 9	SHEET 106 OF 198							



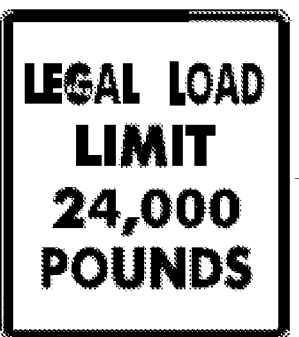


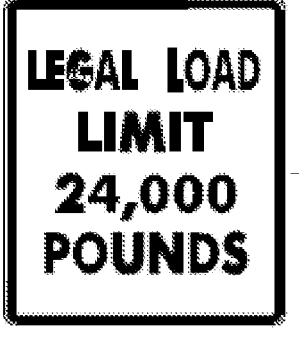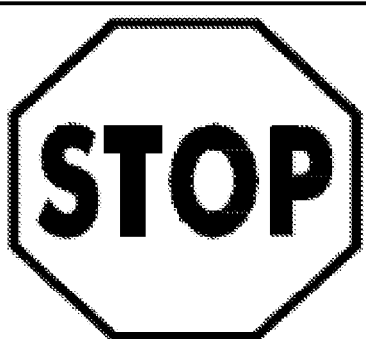
DIRECTION	MILEPOINT	LOCATION CODE (SHEET 2)	SIGN CODE	WIDTH (IN)	HEIGHT (IN)	SHEETING REMARKS	SIGN LEGEND	NEW SIGNS		EXISTING SIGNS			EXIST POST		NUMBER OF NEW POSTS	SQUARE STEEL (IN)			TUBULAR STEEL Ø (IN)				SIGN FRAME REQUIRED	REMARKS	SIGN DETAIL			
								"A"	"B"	RETAIN	SALVAGE FROM	SALVAGE TO	REMOVE	RETAIN		REMOVE	1.75	2.00	2.50	3.00	3.50	4.00			5.00	DETAIL IN SHS	DETAIL ON SHEET NUMBER	DETAIL ON STD SHEET NUMBER
DOVER VT 100							FY-FLUORESCENT YELLOW FYG-FLUORESCENT YELLOW GREEN															"SHS"-STANDARD HIGHWAY SIGNS						
		A	M1-5	24	24																							
		A	M3-1	24	12										1		X										X	
		A	M1-5	30	24																							E-136B
NB	4.190	A	R2-1	24	30																						X	
NB	4.821	C	VR-017	24	30																							
		C	VR-017	24	30								1		X													
		C	VR-017	24	30			5.00										X										E-141
NB	4.829	D	R1-1	30	30																							
		D	R1-1	30	30			6.25											X								X	
NB	5.270	A	W11-6H	30	30		SNOWMOBILE SYMBOL						+		X													
NB	5.300	C	VR-017	24	30																							
		C	VR-017	24	30								1		X													
		C	VR-017	24	30			5.00										X										E-141
NB	5.308	D	R1-1	30	30																							
		D	R1-1	30	30								1		X													
		D	R1-1	30	30														X								X	
NB	5.453	C	VR-017	24	30																							
		C	VR-017	24	30			5.00										X										E-141
SIGN SUMMARY SHEET							SHEET TOTALS	39.50	0.00	0	3	3	8	0	0	7	105							PROJECT NAME: Stamford-Andover VT100				
								SF	SF	EA	EA	EA	EA	EA	EA	EA	FT							PROJECT NUMBER: STPG SIGN(20)				
VERMONT AGENCY OF TRANSPORTATION							TOWN TOTALS	648.1	0.0	30.0	3.0	1.0	116	0.0	0.0	112	1680.0							FILE NAME: Dover.xls	PLOT DATE: 8/6/2009			
																							DESIGNED BY: M. Miller	CHECKED BY: T. Guazzoni				
																							DOVER SHEET 10	SHEET 107 OF 198				




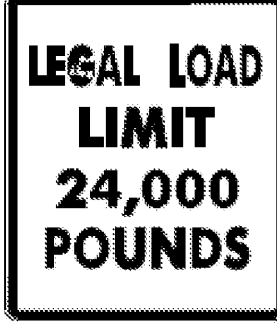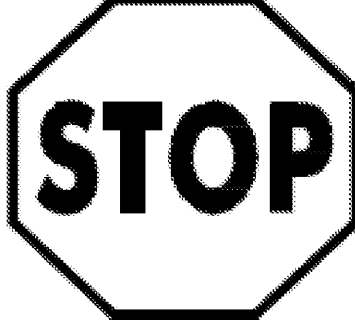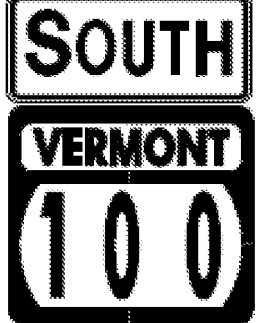

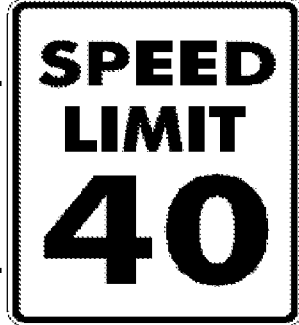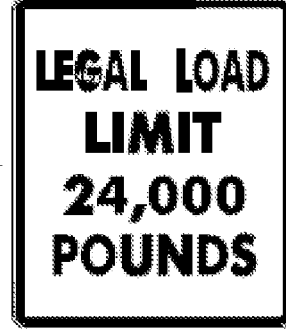
DIRECTION	MILEPOINT	LOCATION CODE (SHEET 2)	SIGN CODE	WIDTH (IN)	HEIGHT (IN)	SHEETING REMARKS	SIGN LEGEND	NEW SIGNS		EXISTING SIGNS			EXIST POST		NUMBER OF NEW POSTS	SQUARE STEEL (IN)			TUBULAR STEEL Ø (IN)				SIGN FRAME REQUIRED	REMARKS	SIGN DETAIL			
								"A"	"B"	RETAIN	SALVAGE FROM	SALVAGE TO	REMOVE	RETAIN		REMOVE	1.75	2.00	2.50	3.00	3.50	4.00			5.00	DETAIL IN SHS	DETAIL ON SHEET NUMBER	DETAIL ON STD SHEET NUMBER
																	(LB / FT)			(LB / FT)								
DOVER VT 100							FY-FLUORESCENT YELLOW FYG-FLUORESCENT YELLOW GREEN															"SHS"-STANDARD HIGHWAY SIGNS						
NB	5.461	D	R1-1	30	30						1												DUNCAN RD (TH-33)					
		D	R1-1	30	30			6.25										X						X				
SB	5.470	F	W11-6H	30	30		SNOWMOBILE SYMBOL			1													SNOWMOBILES USE THIS CROSSING. NO WORK WAS DONE.					
SB	4.570	F	W2-2Ma R	30	30			6.25															INSTALL 500 FT ± IN ADVANCE OF TH-50.		6			
SB	4.474	G	VR-017	24	30						1												UPPER HIGHLANDS LOOP (TH-50)					
		G	VR-017	24	30			5.00																		E-141		
SB	4.466	H	R1-1	30	30						1												UPPER HIGHLANDS LOOP (TH-50)					
		H	R1-1	30	30			6.25																X				
SB	4.390	G	VR-017	24	30						1												LOWER HIGHLANDS RD (TH-53)					
		G	VR-017	24	30			5.00																		E-141		
SB	4.380	H	R1-1	30	30						1												LOWER HIGHLANDS RD (TH-53)					
		H	R1-1	30	30			6.25																X				
SB	4.360	F	VD-062AS	72	16		BUSINESS SIGN			1																		
SB	4.240	F	W2-1M	30	30						1																	
		F	W2-1Mb	30	30			6.25																		6		
SIGN SUMMARY SHEET							SHEET TOTALS	41.25	0.00	2	2	2	7	0	0	7	105						PROJECT NAME: Stamford-Andover VT100					
VERMONT AGENCY OF TRANSPORTATION							TOWN TOTALS	648.1	0.0	30.0	3.0	1.0	116	0.0	0.0	112	1680.0						PROJECT NUMBER: STPG SIGN(20)					
								SF	SF	EA	EA	EA	EA	EA	EA	EA	FT						FILE NAME: Dover.xls	PLOT DATE: 8/6/2009				
																							PROJECT MANAGER: N. Avery	DRAWN BY: I. Shea				
																							DESIGNED BY: M. Miller	CHECKED BY: T. Guazzoni				
																							DOVER SHEET 11	SHEET 108 OF 198				

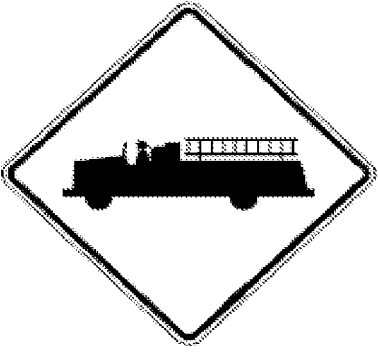




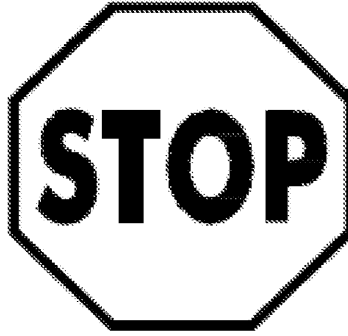



DIRECTION	MILEPOINT	LOCATION CODE (SHEET 2)	SIGN CODE	WIDTH (IN)	HEIGHT (IN)	SHEETING REMARKS	SIGN LEGEND	NEW SIGNS		EXISTING SIGNS			EXIST POST		NUMBER OF NEW POSTS	SQUARE STEEL (IN)			TUBULAR STEEL Ø (IN)				SIGN FRAME REQUIRED	REMARKS	SIGN DETAIL			
								"A"	"B"	RETAIN	SALVAGE FROM	SALVAGE TO	REMOVE	RETAIN		REMOVE	1.75	2.00	2.50	3.00	3.50	4.00			5.00	DETAIL IN SHS	DETAIL ON SHEET NUMBER	DETAIL ON STD SHEET NUMBER
																	(LB / FT)			(LB / FT)								
DOVER VT 100							FY-FLUORESCENT YELLOW FYG-FLUORESCENT YELLOW GREEN															"SHS"-STANDARD HIGHWAY SIGNS						
SB	4.202	F	D1-1	72	12			6.00						2	X									INSTALL 200 FT ± SOUTH OF THE CROSSROAD WARNING SIGN		5		
SB	4.130	G	VR-017	24	30							1		X										MOUNT SNOW NORTH ACCESS ROAD				
		G	VR-017	24	30			5.00					1	X													E-141	
SB	4.120	H	R1-1	30	30									1	X									MOUNT SNOW NORTH ACCESS ROAD				
		H	R1-1	30	30			6.25						1	X									INSTALL AS CLOSE TO STOPPING POINT AS POSSIBLE	X			
SB	4.103	F	M3-3	24	12							1		X														
		F	M1-5	30	24							1		X														
		F	M3-3	24	12			2.00						1	X									GREEN ON WHITE SHEETING	X			
		F	M1-5	30	24			5.00						1	X													E-136B
SB	4.046	F	R2-1	24	30			5.00						1	X									INSTALL 300 FT SOUTH OF THE ROUTE MARKER ASSEMBLY	X			
SB	3.940	F	VD-062AL	72	16		BUSINESS SIGN			1				X														
		F	VD-062B	72	16		BUSINESS SIGN			1				X														
		F	VD-062AS	72	16		BUSINESS SIGN			1				X														
SB	3.720	F	W2-2Ma R	30	30			6.25						1	X										INSTALL 25 FEET IN NORTH OF THE EXISTING SIGN.		6	
SB	3.715	F	W2-2R	30	30		SIDE ROAD RIGHT SYMBOL					1		X														
SIGN SUMMARY SHEET							SHEET TOTALS	35.50	0.00	3	0	0	5	0	0	7	120								PROJECT NAME: Stamford-Andover VT100			
VERMONT AGENCY OF TRANSPORTATION							TOWN TOTALS	648.1	0.0	30.0	3.0	1.0	116	0.0	0.0	112	1680.0								PROJECT NUMBER: STPG SIGN(20)			
								SF	SF	EA	EA	EA	EA	EA	EA	EA	FT							FILE NAME: Dover.xls	PLOT DATE: 8/6/2009			
																								PROJECT MANAGER: N. Avery	DRAWN BY: I. Shea			
																								DESIGNED BY: M. Miller	CHECKED BY: T. Guazzoni			
																								DOVER SHEET 12	SHEET 109 OF 198			

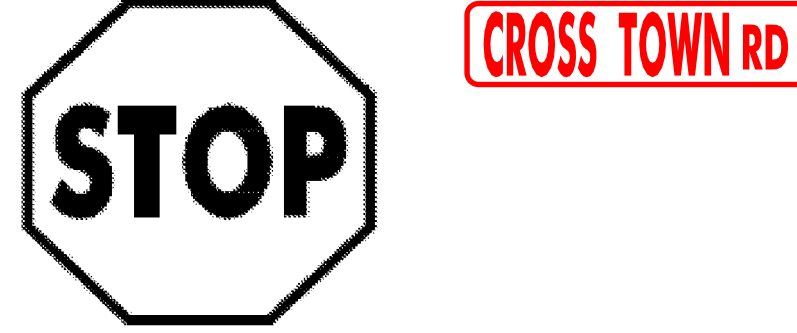




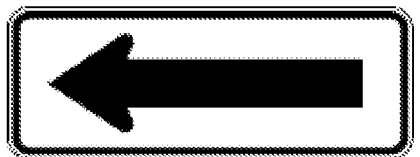
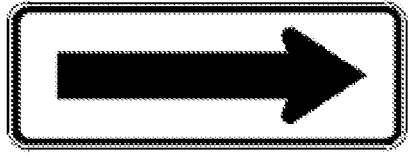
DIRECTION	MILEPOINT	LOCATION CODE (SHEET 2)	SIGN CODE	WIDTH (IN)	HEIGHT (IN)	SHEETING REMARKS	SIGN LEGEND	NEW SIGNS		EXISTING SIGNS				EXIST POST		NUMBER OF NEW POSTS	SQUARE STEEL (IN)			TUBULAR STEEL Ø (IN)				SIGN FRAME REQUIRED	REMARKS	SIGN DETAIL		
								"A"	"B"	RETAIN	SALVAGE FROM	SALVAGE TO	REMOVE	RETAIN	REMOVE		(LB / FT)			(LB / FT)						DETAIL IN SHS	DETAIL ON SHEET NUMBER	DETAIL ON STD SHEET NUMBER
																	1.75	2.00	2.50	3.00	3.50	4.00	5.00					
DOVER VT 100							FY-FLUORESCENT YELLOW FYG-FLUORESCENT YELLOW GREEN															"SHS"-STANDARD HIGHWAY SIGNS						
SB	3.620	G	VR-017	24	30																							
		G	VR-017	24	30			5.00																	E-141			
SB	3.610	H	R1-1	30	30																							
		H	R1-1	30	30			6.25																X				
SB	3.555	F	M3-3	24	12																							
		F	M1-5	24	24																							
		F	M3-3	24	12			2.00																X				
		F	M1-5	30	24			5.00																	E-136B			
SB	3.155	F	VD-062AS	72	16		BUSINESS SIGN			1																		
SB	3.025	F	R2-5A	24	30		REDUCED SPEED AHEAD																					
		F	W3-5	36	36			9.00																X				
SB	2.965	F	W1-10L	30	30		CURVE LEFT w/ SIDE ROAD RIGHT																					
		F	W1-2Mh L	30	30			6.25																	6			
		F	W16-8	24	8			1.33																	8			
SB	2.915	F	VD-062AS	72	16		BUSINESS SIGN			1																		
SIGN SUMMARY SHEET							SHEET TOTALS	34.83	0.00	2	0	0	6	0	0	6	90							PROJECT NAME: Stamford-Andover VT100				
VERMONT AGENCY OF TRANSPORTATION								SF	SF	EA	EA	EA	EA	EA	EA	EA	FT							PROJECT NUMBER: STPG SIGN(20)				
TOWN TOTALS							648.1	0.0	30.0	3.0	1.0	116	0.0	0.0	112	1680.0							FILE NAME: Dover.xls	PLOT DATE: 8/6/2009				
																						PROJECT MANAGER: N. Averv	DRAWN BY: I. Shea					
																						DESIGNED BY: M. Miller	CHECKED BY: T. Guazzoni					
																						DOVER SHEET 13	SHEET 110 OF 198					

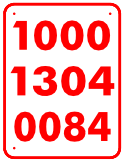



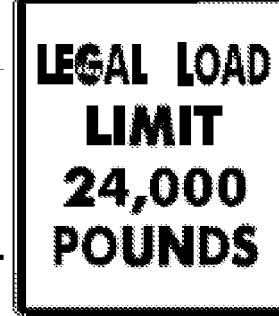
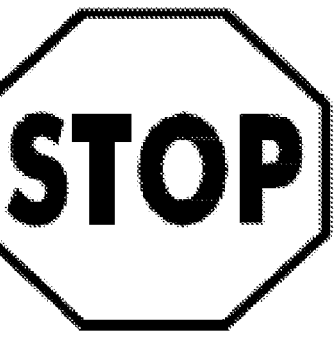

DIRECTION	MILEPOINT	LOCATION CODE (SHEET 2)	SIGN CODE	WIDTH (IN)	HEIGHT (IN)	SHEETING REMARKS	SIGN LEGEND	NEW SIGNS		EXISTING SIGNS			EXIST POST		NUMBER OF NEW POSTS	SQUARE STEEL (IN)			TUBULAR STEEL Ø (IN)				SIGN FRAME REQUIRED	REMARKS	SIGN DETAIL					
								"A"	"B"	RETAIN	SALVAGE FROM	SALVAGE TO	REMOVE	RETAIN		REMOVE	1.75	2.00	2.50	FOUNDATION	3.00	3.50			4.00	5.00	DETAIL IN SHS	DETAIL ON SHEET NUMBER	DETAIL ON STD SHEET NUMBER	
																	(LB / FT)				(LB / FT)									
DOVER VT 100							FY-FLUORESCENT YELLOW FYG-FLUORESCENT YELLOW GREEN																"SHS"-STANDARD HIGHWAY SIGNS							
			F VD-062B	72	16		BUSINESS SIGN			1																				
SB	2.890		F R2-1	30	36			7.50						1	X									INSTALL 25 FT± IN NORTH OF EXISTING SIGN (TO BE REMOVED)	X					
SB	2.885		F R2-1	24	30		SPEED LIMIT 40					1		X																
SB	2.850		G VR-017	24	24							1		X										TANNERY RD (TH-3)			E-141			
			G VR-017	24	30			5.00						1	X															
SB	2.830		H R1-1	30	30							1		X										TANNERY RD (TH-3)						
			H R1-1	30	30			6.25						1	X									INSTALL CLOSER TO ACTUAL STOPPING POINT	X					
SB	2.770		F S3-1	30	30		SCHOOL BUS STOP AHEAD					1		X																
			F R2-1	24	30			5.00						1	X										X					
SB	2.635		F R2-1	24	30		SPEED LIMIT 40					1		X																
SB	2.595		F VW-205	30	30							2		X										SNOWMOBILE SYMBOL SIGN REMOVED - SEE NEXT SHEET.			E-154			
			F VW-205	36	36			9.00						2	X															
SB	2.510		F W11-8	30	30		FIRE ENGINE SYMBOL					1		X																
			F W1-2Md L	30	30			6.25						1	X											6				
			F W16-8	24	8			1.33																		8				
SIGN SUMMARY SHEET							SHEET TOTALS	40.33	0.00	1	0	0	8	0	0	7	105								PROJECT NAME: Stamford-Andover VT100					
							SF	SF	EA	EA	EA	EA	EA	EA	EA	EA	EA	EA	EA	EA	EA	EA	EA	EA	EA	PROJECT NUMBER: STPG SIGN(20)				
VERMONT AGENCY OF TRANSPORTATION							TOWN TOTALS	648.1	0.0	30.0	3.0	1.0	116	0.0	0.0	112	1680.0									FILE NAME: Dover.xls	PLOT DATE: 8/6/2009			
																										PROJECT MANAGER: N. Avery	DRAWN BY: I. Shea			
																											DESIGNED BY: M. Miller	CHECKED BY: T. Guazzoni		
																											DOVER SHEET 14	SHEET 111 OF 198		


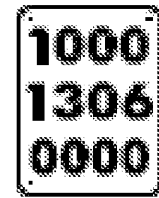
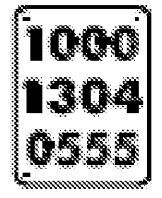
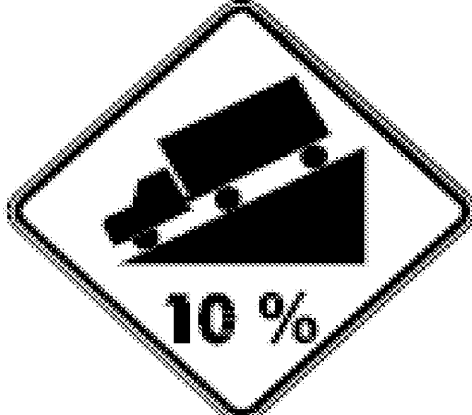


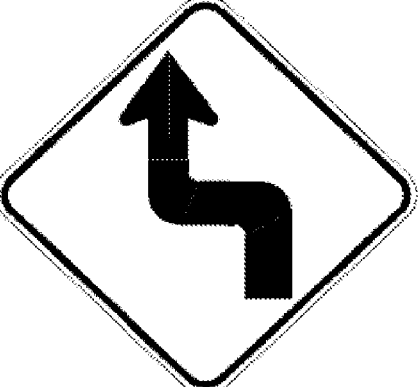DIRECTION	MILEPOINT	LOCATION CODE (SHEET 2)	SIGN CODE	WIDTH (IN)	HEIGHT (IN)	SHEETING REMARKS	SIGN LEGEND	NEW SIGNS		EXISTING SIGNS			EXIST POST		NUMBER OF NEW POSTS	SQUARE STEEL (IN)			TUBULAR STEEL Ø (IN)				SIGN FRAME REQUIRED	REMARKS	SIGN DETAIL			
								"A"	"B"	RETAIN	SALVAGE FROM	SALVAGE TO	REMOVE	RETAIN		REMOVE	1.75	2.00	2.50	3.00	3.50	4.00			5.00	DETAIL IN SHS	DETAIL ON SHEET NUMBER	DETAIL ON STD SHEET NUMBER
																	(LB / FT)			(LB / FT)								
DOVER VT 100							FY-FLUORESCENT YELLOW FYG-FLUORESCENT YELLOW GREEN															"SHS"-STANDARD HIGHWAY SIGNS						
SB	2.482	F	W11-8	30	30			6.25						1	X								SNOWMOBILES SIGN ATTACHED TO LONGER, NEW POST. SEE SHEET #116	INSTALL 150 FT ± SOUTH OF THE ORIGINAL LOCATION.	X			
SB	2.430	G	VR-017	30 24	30							1		X										STUGGER RD, NORTH (TH-66)				
		G	VR-017	30 24	30			6.25 5.00						1	X												E-141	
SB	2.422	H	R1-1	24 30	30							1		X										STUGGER RD, NORTH (TH-66)				
		H	R1-1	24 30	30			5.00 6.25						1	X											X		
SB	2.330	G	VR-017	24	30							1		X										STUGGER RD, SOUTH (TH-66)				
		G	VR-017	24	30			6.25 5.00						1	X												E-141	
SB	2.322	H	R1-1	30	30							1		X										STUGGER RD, SOUTH (TH-66)				
		H	R1-1	30	30			6.25						1	X											X		
SB	2.215	F	R2-1	24	30		SPEED LIMIT 40					1		X														
		F	R2-1	24	30			5.00						1	X									340 FT ± SOUTH OF ORIGINAL LOCATION	X			
SB	1.940	F	R2-1	24	30		SPEED LIMIT 40					1		X														
SB	1.880	F	VD-062AS	72	16		BUSINESS SIGN			1				X														
		F	VD-062AS	72	16		BUSINESS SIGN			1																		
SB	1.789	G	VR-017	24	30		LEGAL LOAD LIMIT 24,000 LBS			1				X										COUNTRY CLUB RD (TH-9)				
SIGN SUMMARY SHEET							SHEET TOTALS	33.75	0.00	3	0	0	6	0	0	6	90							PROJECT NAME: Stamford-Andover VT100				
VERMONT AGENCY OF TRANSPORTATION							TOWN TOTALS	648.1	0.0	30.0	3.0	1.0	116	0.0	0.0	112	1680.0							PROJECT NUMBER: STPG SIGN(20)				
								SF	SF	EA	EA	EA	EA	EA	EA	EA	FT						FILE NAME: Dover.xls	PLOT DATE: 8/6/2009				
																							PROJECT MANAGER: N. Avery	DRAWN BY: I. Shea				
																							DESIGNED BY: M. Miller	CHECKED BY: T. Guazzoni				
																							DOVER SHEET 15	SHEET 112 OF 198				

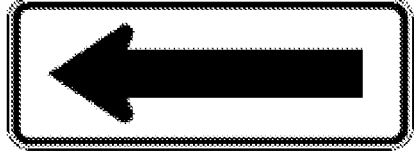DIRECTION	MILEPOINT	LOCATION CODE (SHEET 2)	SIGN CODE	WIDTH (IN)	HEIGHT (IN)	SHEETING REMARKS	SIGN LEGEND	NEW SIGNS		EXISTING SIGNS				EXIST POST		NUMBER OF NEW POSTS	SQUARE STEEL (IN)			TUBULAR STEEL Ø (IN)				SIGN FRAME REQUIRED	REMARKS	SIGN DETAIL		
								"A"	"B"	RETAIN	SALVAGE FROM	SALVAGE TO	REMOVE	RETAIN	REMOVE		1.75	2.00	2.50	3.00	3.50	4.00	5.00			DETAIL IN SHS	DETAIL ON SHEET NUMBER	DETAIL ON STD SHEET NUMBER
																	(LB / FT)			(LB / FT)								
DOVER VT 100							FY-FLUORESCENT YELLOW FYG-FLUORESCENT YELLOW GREEN															"SHS"-STANDARD HIGHWAY SIGNS						
SB	1.781	H	R1-1	30	30																							
		H	R1-1	30	30			6.25																X				
SB	1.762	F	R2-1	24	30																							
		F	R2-1	24	30			5.00																X				
SB	1.685	F	VD-062AS	72	16		BUSINESS SIGN			1																		
SB	1.420	F	R2-1	24	30		SPEED LIMIT 40																					
SB	1.340	F	VD-018	30	18																							
		F	VD-018	30	18			3.75																		E-128B		
SB	1.300	F	VD-062B	72	16		BUSINESS SIGN			1																		
		F	VD-062AS	72	16		BUSINESS SIGN			1																		
		F	VD-062AS	72	16		BUSINESS SIGN			1																		
SB	1.200	F	R2-1	24	30		 																					
		F	R2-1	24	30			5.00																		INSTALL ON TOP		
		F	R4-1	24	30			5.00																		INSTALL ON BOTTOM		
SB	1.108	G	VR-017	24	24																							
		G	VR-017	24	30			5.00																		CROSSTOWN RD (TH-9)		
SIGN SUMMARY SHEET							SHEET TOTALS	30.00	0.00	4	0	0	5	0	0	5	75					PROJECT NAME: Stamford-Andover VT100						
								SF	SF	EA	EA	EA	EA	EA	EA	EA	FT					PROJECT NUMBER: STPG SIGN(20)						
VERMONT AGENCY OF TRANSPORTATION							TOWN TOTALS	648.1	0.0	30.0	3.0	1.0	116	0.0	0.0	112	1680.0					FILE NAME: Dover.xls	PLOT DATE: 8/6/2009					
																						PROJECT MANAGER: N. Avery	DRAWN BY: I. Shea					
																						DESIGNED BY: M. Miller	CHECKED BY: T. Guazzoni					
																						DOVER SHEET 16	SHEET 113 OF 198					




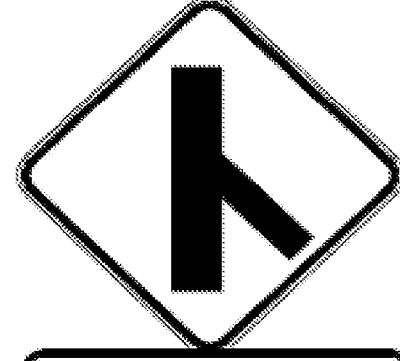


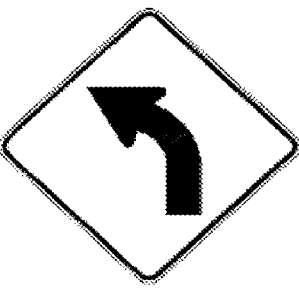

DIRECTION	MILEPOINT	LOCATION CODE (SHEET 2)	SIGN CODE	WIDTH (IN)	HEIGHT (IN)	SHEETING REMARKS	SIGN LEGEND	NEW SIGNS		EXISTING SIGNS			EXIST POST		NUMBER OF NEW POSTS	SQUARE STEEL (IN)			TUBULAR STEEL Ø (IN)				SIGN FRAME REQUIRED	REMARKS	SIGN DETAIL				
								"A"	"B"	RETAIN	SALVAGE FROM	SALVAGE TO	REMOVE	RETAIN		REMOVE	1.75	2.00	2.50	FOUNDATION	3.00	3.50			4.00	5.00	DETAIL IN SHS	DETAIL ON SHEET NUMBER	DETAIL ON STD SHEET NUMBER
																	(LB / FT)				(LB / FT)								
DOVER VT 100							FY-FLUORESCENT YELLOW FYG-FLUORESCENT YELLOW GREEN															"SHS"-STANDARD HIGHWAY SIGNS							
SB	1.104	H	R1-1	30	30						1		X																
		H	R1-1	30	30			6.25						1	X								X						
SB	1.095	F	R4-1	24	30		DO NOT PASS				1		X																
		F	M3-3	24	12			2.00						1	X								X						
		F	M1-5	30	24			5.00																	E-136B				
SB	1.033	F	R2-1	24	30			5.00						1	X								X						
		F	R4-1	24	30			5.00															X						
SB	1.031	F	R2-1	24	30		SPEED LIMIT 35				1		X																
																													
SB	0.843	G	VR-017	24	30			5.00						1	X										E-141				
SB	0.835	H	R1-1	30	30						1		X																
		H	R1-1	30	30			6.25						1	X									X					
SB	0.825	F	R2-1	24	30						1		X																
		F	R4-1	24	30						1																		
		F	R2-1	24	30			5.00						1	X								X						
		F	R4-1	24	30			5.00															X						
SIGN SUMMARY SHEET							SHEET TOTALS	44.50	0.00	0	0	0	6	0	0	6	90						PROJECT NAME: Stamford-Andover VT100						
VERMONT AGENCY OF TRANSPORTATION							TOWN TOTALS	648.1	0.0	30.0	3.0	1.0	116	0.0	0.0	112	1680.0						PROJECT NUMBER: STPG SIGN(20)						
								SF	SF	EA	EA	EA	EA	EA	EA	EA	FT						FILE NAME: Dover.xls						
																							PLOT DATE: 8/6/2009						
																							DRAWN BY: I. Shea						
																							DESIGNED BY: M. Miller						
																							CHECKED BY: T. Guazzoni						
																							SHEET 114 OF 198						




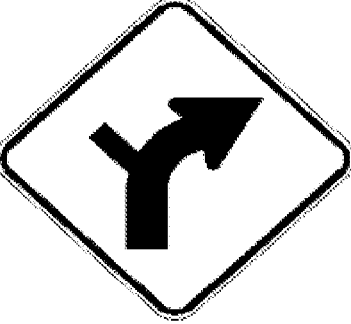


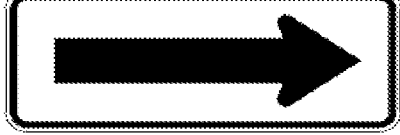DIRECTION	MILEPOINT	LOCATION CODE (SHEET 2)	SIGN CODE	WIDTH (IN)	HEIGHT (IN)	SHEETING REMARKS	SIGN LEGEND	NEW SIGNS		EXISTING SIGNS			EXIST POST		NUMBER OF NEW POSTS	SQUARE STEEL (IN)			TUBULAR STEEL Ø (IN)				SIGN FRAME REQUIRED	REMARKS	SIGN DETAIL				
								"A"	"B"	RETAIN	SALVAGE FROM	SALVAGE TO	REMOVE	RETAIN		REMOVE	1.75	2.00	2.50	FOUNDATION	3.00	3.50			4.00	5.00	DETAIL IN SHS	DETAIL ON SHEET NUMBER	DETAIL ON STD SHEET NUMBER
																	(LB / FT)				(LB / FT)								
DOVER VT 100							FY-FLUORESCENT YELLOW FYG-FLUORESCENT YELLOW GREEN															"SHS"-STANDARD HIGHWAY SIGNS							
SB	0.755	F	W1-3L	30	30		REVERSE TURN LEFT				1																		
		F	W13-1	18	18		30 MPH (PLAQUE)				1																		
		F	W1-3L	30	30	FY		6.25															X						
		F	W13-1	18	18	FY		2.25															X						
																													
SB	0.720	F	S3-1	30	30			6.25			1												X						
SB	0.650	F	W1-6	48	24						1																		
		F	W1-6	48	24	FY		8.00															X						
SB	0.645	E	W1-6	48	24						1																		
		E	W1-6	48	24	FY		8.00															X						
SB	0.635	F	W1-6	48	24						1																		
		F	W1-6	48	24	FY		8.00															X						
SB	0.630	E	W1-6	48	24						1																		
		E	W1-6	48	24	FY		8.00															X						
SB	0.410	F	R2-1	24	30						1																		
		F	VR-417	30	30						1																		
SIGN SUMMARY SHEET							SHEET TOTALS	46.75	0.00	0	0	0	8	0	0	10	150						PROJECT NAME: Stamford-Andover VT100						
VERMONT AGENCY OF TRANSPORTATION							TOWN TOTALS	648.1	0.0	30.0	3.0	1.0	116	0.0	0.0	112	1680.0						PROJECT NUMBER: STPG SIGN(20)						
								SF	SF	EA	EA	EA	EA	EA	EA	EA	FT						FILE NAME: Dover.xls						
																							PLOT DATE: 8/6/2009						
																								PROJECT MANAGER: N. Avery					
																								DRAWN BY: I. Shea					
																									DESIGNED BY: M. Miller				
																									CHECKED BY: T. Guazzoni				
																									DOVER SHEET 18				
																									SHEET 115 OF 198				









DIRECTION	MILEPOINT	LOCATION CODE (SHEET 2)	SIGN CODE	WIDTH (IN)	HEIGHT (IN)	SHEETING REMARKS	SIGN LEGEND	NEW SIGNS		EXISTING SIGNS			EXIST POST		NUMBER OF NEW POSTS	SQUARE STEEL (IN)			TUBULAR STEEL Ø (IN)				SIGN FRAME REQUIRED	REMARKS	SIGN DETAIL					
								"A"	"B"	RETAIN	SALVAGE FROM	SALVAGE TO	REMOVE	RETAIN		REMOVE	1.75	2.00	2.50	FOUNDATION	3.00	3.50			4.00	5.00	DETAIL IN SHS	DETAIL ON SHEET NUMBER	DETAIL ON STD SHEET NUMBER	
																	(LB / FT)				(LB / FT)									
DOVER VT 100							FY-FLUORESCENT YELLOW FYG-FLUORESCENT YELLOW GREEN															"SHS"-STANDARD HIGHWAY SIGNS								
			E W14-3	48	36		 				1																			
			F R2-1	24	30				5.00															X						
			F VR-417	30	30				6.25																	E-141				
			E W14-3	40	30	FY			3.86																X	PENNANT INSTALLED ON BACK OF SPEED LIMIT 50 SIGN				
SB	0.260 0.245		F W2-3Ma L	30	30			6.25						1												INSTALL ¹⁶⁰ 80 FT ± NORTH OF THE CONCRETE BLOCK RETAINING WALL. INSTALL SIGN AS SHOWN		6		
			F W16-8	24	8				1.33																X					
SB	0.145		G VR-017	24	30		 				1															ABROAD RD (TH-11)				
			G VR-017	24	30				5.00																		E-141			
SB	0.135		H R1-1	30	30						1															ABROAD RD (TH-11)				
			H R1-1	30	30	1000 1304 0014			6.25																	X				
SB	0.000		G VD-024	60	7.5						1															WILMINGTON I DOVER				
SB	2.482	A	W11-6	30	30			6.25																			NEW FOLDING SNOWMOBILE SIGN WAS INSTALLED. FIRE ENGINE SIGN WAS SALVAGED ONTO POST.			
SIGN SUMMARY SHEET							SHEET TOTALS	40.19 33.94	0.00	0	1 0	1 0	5 4	0	0	4	60									PROJECT NAME: Stamford-Andover VT100				
VERMONT AGENCY OF TRANSPORTATION							TOWN TOTALS	648.1	0.0	30.0	3.0	1.0	116	0.0	0.0	112	1680.0									PROJECT NUMBER: STPG SIGN(20)				
								SF	SF	EA	EA	EA	EA	EA	EA	EA	FT									FILE NAME: Dover.xls			PLOT DATE: 8/6/2009	
																										PROJECT MANAGER: N. Avery			DRAWN BY: I. Shea	
																										DESIGNED BY: M. Miller			CHECKED BY: T. Guazzoni	
																										DOVER SHEET 19			SHEET 116 OF 198	

DIRECTION	MILEPOINT	LOCATION CODE (SHEET 2)	SIGN CODE	WIDTH (IN)	HEIGHT (IN)	SHEETING REMARKS	SIGN LEGEND	NEW SIGNS		EXISTING SIGNS				EXIST POST		NUMBER OF NEW POSTS	SQUARE STEEL (IN)			TUBULAR STEEL Ø (IN)				SIGN FRAME REQUIRED	REMARKS	SIGN DETAIL		
								"A"	"B"	RETAIN	SALVAGE FROM	SALVAGE TO	REMOVE	RETAIN	REMOVE		(LB / FT)			(LB / FT)						DETAIL IN SHS	DETAIL ON SHEET NUMBER	DETAIL ON STD SHEET NUMBER
																	1.75	2.00	2.50	3.00	3.50	4.00	5.00					
STRATTON VT 100							FY-FLUORESCENT YELLOW FYG-FLUORESCENT YELLOW GREEN																"SHS"-STANDARD HIGHWAY SIGNS					
NB	0.000	C	VD-024	60	7.5																							
		C	VD-024	72	10			5.00										X								4		
		C	VD-700	6	10			0.42																			E-138	
		C	VD-700	6	10			0.42																			E-138	
NB	0.335	A	W1-4L	30	30		LEFT REVERSE CURVE				1																	
		A	W13-1	18	18		40 MPH PLAQUE				1																	
NB	0.415	A	W1-4L	30	30		LEFT REVERSE CURVE					1						X									INSTALL BETWEEN DRIVES, 425 FEET NORTH OF EXISTING ASSEMBLY	
		A	W13-1	18	18		40 MPH PLAQUE					1																
NB	0.460	C	VM-607	24	30		43RD INFANTRY DIV.																					
		C	VR-023B	24	30		\$500 FINE FOR THROWING TRASH																					
NB	0.500	A	W7-1b	30	30																							
		A	W7-2b	24	18																							
		A	W7-1b	36	36			9.00																			X	
		A	W7-2b	24	18			3.00																			X	
		A	W7-3a	24	18			3.00																			X	
SIGN SUMMARY SHEET							SHEET TOTALS	20.84	0.00	0	2	2	5	0	0	5	75											
VERMONT AGENCY OF TRANSPORTATION								SF	SF	EA	EA	EA	EA	EA	EA	EA	FT											
							TOWN TOTALS	53.1	0.0	0.0	3.0	3.0	12	0.0	0.0	10	150.0											
																												PROJECT NAME: Stamford-Andover VT100 PROJECT NUMBER: STPG SIGN(20) FILE NAME: Stratton.xls PROJECT MANAGER: N. Avery DESIGNED BY: J. Kelly STRATTON SHEET 1
																												PLOT DATE: 8/6/2009 DRAWN BY: T. Guazzoni CHECKED BY: T. Guazzoni SHEET 117 OF 198

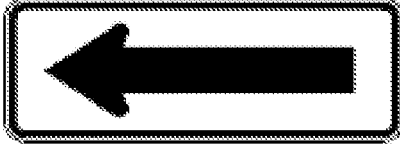
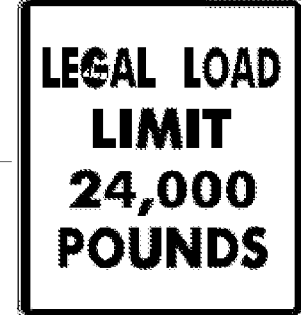





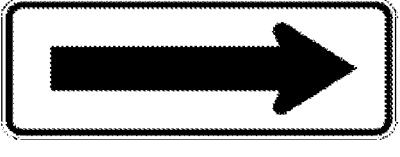
DIRECTION	MILEPOINT	LOCATION CODE (SHEET 2)	SIGN CODE	WIDTH (IN)	HEIGHT (IN)	SHEETING REMARKS	SIGN LEGEND	NEW SIGNS		EXISTING SIGNS				EXIST POST		NUMBER OF NEW POSTS	SQUARE STEEL (IN)			TUBULAR STEEL Ø (IN)				SIGN FRAME REQUIRED	REMARKS	SIGN DETAIL			
								"A"	"B"	RETAIN	SALVAGE FROM	SALVAGE TO	REMOVE	RETAIN	REMOVE		1.75	2.00	2.50	3.00	3.50	4.00	5.00			DETAIL IN SHS	DETAIL ON SHEET NUMBER	DETAIL ON STD SHEET NUMBER	
																	(LB / FT)			(LB / FT)									
WARDSBORO VT 100							FY-FLUORESCENT YELLOW FYG-FLUORESCENT YELLOW GREEN															"SHS"-STANDARD HIGHWAY SIGNS							
NB	0.000	C	VD-024	60	7.5							1			X											INSTALL THE NEW SIGN ON 2 POSTS IN THE SAME POSITION AS THE PREVIOUS SIGN.			
		C	VD-024	72	10			5.00								2		X								WARDSBORO MILE MARKER PLAQUE; INSTALL UNDER WARDSBORO			E-138
		C	VD-700	6	10			0.42																		STRATTON MILE MARKER PLAQUE; INSTALL UNDER STRATTON			E-138
		C	VD-700	6	10			0.42																					
NB	0.565	A	W7-1B	30	30		HILL SYMBOL 11%					1			X														
		A	W7-3A	24	18							1																	
NB	0.617	A	W7-1B	30	30			6.25							1		X									INSTALL 275 FEET NORTH OF EXISTING LOCATION	X		
		A	W7-3A	24	18			3.00																			X		
NB	0.695	A	VW-054	30	30		HIDDEN DRIVE RIGHT					1			X														
NB	0.735	A	W1-2L	30	30		LEFT CURVE					1			X														
		A	W13-1	18	18		35 MPH PLAQUE					1																	
NB	0.825	A	W1-2L	30	30	FY		6.25							1		X									INSTALL 475 FEET NORTH OF EXISTING LEFT CURVE ASSEMBLY	X		
		A	W13-1	18	18	FY		2.25																			X		
NB	0.860	A	W1-6	48	24							1			X														
		A	W1-6	48	24	FY		8.00							2		X										X		
SIGN SUMMARY SHEET							SHEET TOTALS	31.59	0.00	0	0	0	7	0	0	6	90						PROJECT NAME: Stamford-Andover VT100						
VERMONT AGENCY OF TRANSPORTATION							TOWN TOTALS	633.3	0.0	24.0	12.0	12.0	108	0.0	0.0	129	1935.0						PROJECT NUMBER: STPG SIGN(20)						
								SF	SF	EA	EA	EA	EA	EA	EA	EA	FT						FILE NAME: Wardsboro.xls	PLOT DATE: 8/6/2009					
																								PROJECT MANAGER: N. Avery	DRAWN BY: T. Guazzoni				
																								DESIGNED BY: J. Kelly	CHECKED BY: T. Guazzoni				
																								WARDSBORO SHEET 1	SHEET 119 OF 198				


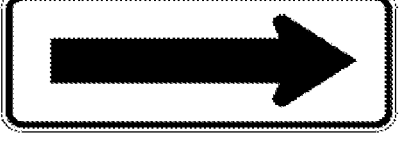






DIRECTION	MILEPOINT	LOCATION CODE (SHEET 2)	SIGN CODE	WIDTH (IN)	HEIGHT (IN)	SHEETING REMARKS	SIGN LEGEND	NEW SIGNS		EXISTING SIGNS			EXIST POST		NUMBER OF NEW POSTS	SQUARE STEEL (IN)			TUBULAR STEEL Ø (IN)				SIGN FRAME REQUIRED	REMARKS	SIGN DETAIL				
								"A"	"B"	RETAIN	SALVAGE FROM	SALVAGE TO	REMOVE	RETAIN		REMOVE	1.75	2.00	2.50	FOUNDATION	3.00	3.50			4.00	5.00	DETAIL IN SHS	DETAIL ON SHEET NUMBER	DETAIL ON STD SHEET NUMBER
																	(LB / FT)				(LB / FT)								
WARDSBORO VT 100							FY-FLUORESCENT YELLOW FYG-FLUORESCENT YELLOW GREEN															"SHS"-STANDARD HIGHWAY SIGNS							
NB	0.861	B	W1-6	48	24						1												FACES SB TRAFFIC						
		B	W1-6	48	24	FY		8.00										X					X						
NB	0.900	A	W1-6	48	24						1																		
		A	W1-6	48	24	FY		8.00										X					X						
NB	0.901	B	W1-6	48	24						1												FACES SB TRAFFIC						
		B	W1-6	48	24	FY		8.00										X					X						
NB	0.928	C	VR-017	24	30		LEGAL LOAD LIMIT 24,000 LBS				1											TH-30, UPPER PODUNK RD							
		C	n/a	18	24		CHILDREN AT PLAY				1											REMOVE THE NON-COMPLIANT TOWN-INSTALLED SIGN. RETURN TO TOWN							
		C	VR-017	24	30													X								E-141			
								5.00																					
NB	0.933	D	R1-1	30	30		STOP 			1												TH-30, UPPER PODUNK RD							
NB	1.479	A	VW-133	30	30		HIDDEN DRIVE LEFT				1																		
																													
NB	1.526	A	VW-054L	30	30			6.25										X						INSTALL 250 FEET NORTH OF EXISTING HIDDEN DRIVE LEFT		E-154			
NB	1.720	A	W1-2L	30	30		LEFT CURVE				1																		
																													
		A	W13-1	18	18			35 MPH PLAQUE				1																	
NB	1.777	A	W1-2L	30	30	FY												X						INSTALL 300 FEET NORTH OF EXISTING LEFT CURVE ASSEMBLY	X				
SIGN SUMMARY SHEET							SHEET TOTALS	41.50	0.00	1	0	0	8	0	0	9	135					PROJECT NAME: Stamford-Andover VT100							
								SF	SF	EA	EA	EA	EA	EA	EA	EA	FT					PROJECT NUMBER: STPG SIGN(20)							
VERMONT AGENCY OF TRANSPORTATION							TOWN TOTALS	633.3	0.0	24.0	12.0	12.0	108	0.0	0.0	129	1935.0					FILE NAME: Wardsboro.xls	PLOT DATE: 8/6/2009						
																						PROJECT MANAGER: N. Avery	DRAWN BY: T. Guazzoni						
																						DESIGNED BY: J. Kelly	CHECKED BY: T. Guazzoni						
																						WARDSBORO SHEET 2	SHEET 120 OF 198						


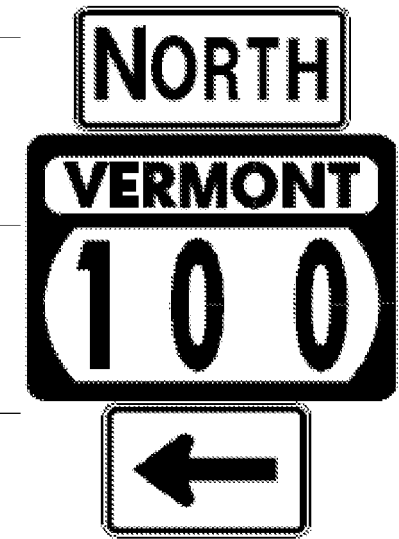



DIRECTION	MILEPOINT	LOCATION CODE (SHEET 2)	SIGN CODE	WIDTH (IN)	HEIGHT (IN)	SHEETING REMARKS	SIGN LEGEND	NEW SIGNS		EXISTING SIGNS			EXIST POST		NUMBER OF NEW POSTS	SQUARE STEEL (IN)			TUBULAR STEEL Ø (IN)				SIGN FRAME REQUIRED	REMARKS	SIGN DETAIL						
								"A"	"B"	RETAIN	SALVAGE FROM	SALVAGE TO	REMOVE	RETAIN		REMOVE	1.75	2.00	2.50	FOUNDATION	3.00	3.50			4.00	5.00	DETAIL IN SHS	DETAIL ON SHEET NUMBER	DETAIL ON STD SHEET NUMBER		
																	(LB / FT)				(LB / FT)										
WARDSBORO VT 100							FY-FLUORESCENT YELLOW FYG-FLUORESCENT YELLOW GREEN															"SHS"-STANDARD HIGHWAY SIGNS									
		A	W13-1	18	18	FY		2.25																		X					
NB	1.830	A	W1-6L	48	24	FY		8.00						2		X											X	INSTALL SOUTH SIDE OF UTILITY POLE			
NB	1.840	B	W1-6R	48	24	FY		8.00						2		X											X	INSTALL NORTH SIDE OF UTILITY POLE FACES SB TRAFFIC			
NB	1.970	A	W3-5	36	36		SPEED REDUCTION (30)				1	1		X	2		X														
NB	2.020	A	W1-10R	30	30		RIGHT CURVE WITH SIDEROAD LEFT						1		X																
		A	VD-018	30	18			3.75						1		X													E-128A		
NB	2.060	A	VD-018	30	18		WEST WARDSBORO WARDSBORO 4						1		X																
		A	W1-10R	30	30			6.25						1		X											X				
NB	2.100	A	D1-1A	72	10								1		X																
		A	D1-1S	72	10								1																		
		A	D1-1A	72	12			6.00						2		X												5			
		A	D1-1	72	12			6.00																				5			
NB	2.156	A	R2-1	30	36		SPEED LIMIT 30					1			1		X											SALVAGE FROM M.P. 2.158.			
NB	2.158	A	R2-1	30	36		SPEED LIMIT 30					1			X													SIGN IS BLOCKING ENTRANCE TO THE GARAGE, SALVAGE TO M.P. 2.156.			
NB	2.186	A	W1-3L	36	36		LEFT REVERSE TURN				1			X																	
SIGN SUMMARY SHEET							SHEET TOTALS	40.25	0.00	1	2	2	4	0	0	11	165														
VERMONT AGENCY OF TRANSPORTATION							TOWN TOTALS	633.3	0.0	24.0	12.0	12.0	108	0.0	0.0	129	1935.0														
																					PROJECT NAME:	Stamford-Andover VT100									
																					PROJECT NUMBER:	STPG SIGN(20)									
																					FILE NAME:	Wardsboro.xls									
																					PLOT DATE:	8/6/2009									
																					PROJECT MANAGER:	N. Avery									
																					DRAWN BY:	T. Guazzoni									
																					DESIGNED BY:	J. Kelly									
																					CHECKED BY:	T. Guazzoni									
																					WARDSBORO SHEET 3	SHEET 121 OF 198									



DIRECTION	MILEPOINT	LOCATION CODE (SHEET 2)	SIGN CODE	WIDTH (IN)	HEIGHT (IN)	SHEETING REMARKS	SIGN LEGEND	NEW SIGNS		EXISTING SIGNS			EXIST POST		NUMBER OF NEW POSTS	SQUARE STEEL (IN)			TUBULAR STEEL Ø (IN)				SIGN FRAME REQUIRED	REMARKS	SIGN DETAIL			
								"A"	"B"	RETAIN	SALVAGE FROM	SALVAGE TO	REMOVE	RETAIN		REMOVE	1.75	2.00	2.50	3.00	3.50	4.00			5.00	DETAIL IN SHS	DETAIL ON SHEET NUMBER	DETAIL ON STD SHEET NUMBER
																	(LB / FT)			(LB / FT)								
WARDSBORO VT 100							FY-FLUORESCENT YELLOW FYG-FLUORESCENT YELLOW GREEN															"SHS"-STANDARD HIGHWAY SIGNS						
			A W1-6	60	30	FY		12.50						2		X									X			
NB	2.310		A OM-3R	12	36							1		X														
			A OM-3R	12	36			3.00						1		X										X		
NB	2.325		B OM-3L	12	36							1		X														
			B OM-3L	12	36			3.00						1		X										X		
NB	2.390		A R2-1	24	30							1		X														
			A R2-1	24	30			5.00						1		X										X		
NB	2.555		A R2-1	24	30							1		X														
			A R2-1	24	30			5.00						1		X										X		
NB	2.785 2.765		A R2-1	24	30							1		X														
			A R2-1	24	30			5.00						1		X										X		
NB	2.800		A M3-3	24	12																							
			A M1-5	30	24			2.00						1		X												
NB	3.802		C VR-017	24	30							1		X														
			C VR-017	24	30			5.00						1		X										E-141		
SIGN SUMMARY SHEET							SHEET TOTALS	45.50	0.00	0	0	0	6	0	0	9	135											
VERMONT AGENCY OF TRANSPORTATION							TOWN TOTALS	633.3	0.0	24.0	12.0	12.0	108	0.0	0.0	129	1935.0											
PROJECT NAME: Stamford-Andover VT100																					PROJECT NUMBER: STPG SIGN(20)							
FILE NAME: Wardsboro.xls												PLOT DATE: 8/6/2009																
PROJECT MANAGER: N. Avery												DRAWN BY: T. Guazzoni																
DESIGNED BY: J. Kelly												CHECKED BY: T. Guazzoni																
WARDSBORO SHEET 5												SHEET 123 OF 198																


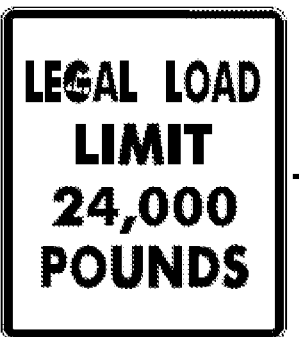

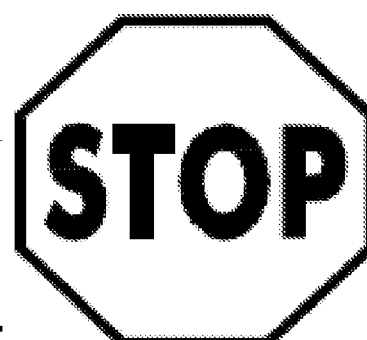




DIRECTION	MILEPOINT	LOCATION CODE (SHEET 2)	SIGN CODE	WIDTH (IN)	HEIGHT (IN)	SHEETING REMARKS	SIGN LEGEND	NEW SIGNS		EXISTING SIGNS			EXIST POST		NUMBER OF NEW POSTS	SQUARE STEEL (IN)			TUBULAR STEEL Ø (IN)				SIGN FRAME REQUIRED	REMARKS	SIGN DETAIL			
								"A"	"B"	RETAIN	SALVAGE FROM	SALVAGE TO	REMOVE	RETAIN		REMOVE	1.75	2.00	2.50	3.00	3.50	4.00			5.00	DETAIL IN SHS	DETAIL ON SHEET NUMBER	DETAIL ON STD SHEET NUMBER
																	(LB / FT)			(LB / FT)								
WARDSBORO VT 100							FY-FLUORESCENT YELLOW FYG-FLUORESCENT YELLOW GREEN															"SHS"-STANDARD HIGHWAY SIGNS						
NB	3.807	D	R1-1	30	30						1												TH-6, LOWER PODUNK RD					
		D	R1-1	30	30			6.25					1		X								MM SALVAGED ONTO NEW POST	X				
NB	4.095 4.055	A	W1-2L	30	30						1																	
		A	W13-1	18	18							1																
		A	W1-2L	30	30	FY			6.25					1		X							THIS WAS MOVED 225' NORTH FOR BETTER VISIBILITY	X				
		A	W13-1	18	18	FY			2.25															X				
NB	4.140	A	W1-6	48	24						1																	
		A	W1-6	48	24	FY			8.00					2		X								X				
NB	4.141	B	W1-6	48	24	FY		8.00					2		X							FACES SB TRAFFIC	X					
NB	4.190	A	W1-6	48	24						1																	
		A	W1-6	48	24	FY			8.00					2		X								X				
NB	4.191	B	W1-6	48	24						1																	
		B	W1-6	48	24				8.00					2		X							FACES SB TRAFFIC	X				
NB	4.207	A	W1-6	48	24	FY		8.00					2		X								X					
NB	4.208	B	W1-6	48	24						1																	
SIGN SUMMARY SHEET							SHEET TOTALS	54.75	0.00	0	0	0	7	0	0	12	180						PROJECT NAME: Stamford-Andover VT100					
VERMONT AGENCY OF TRANSPORTATION							TOWN TOTALS	633.3	0.0	24.0	12.0	12.0	108	0.0	0.0	129	1935.0						PROJECT NUMBER: STPG SIGN(20)					
								SF	SF	EA	EA	EA	EA	EA	EA	EA	FT						FILE NAME: Wardsboro.xls					
																						PLOT DATE: 8/6/2009						
																						PROJECT MANAGER: N. Avery						
																						DRAWN BY: T. Guazzoni						
																						DESIGNED BY: J. Kelly						
																						CHECKED BY: T. Guazzoni						
																						WARDSBORO SHEET 6						
																						SHEET 124 OF 198						


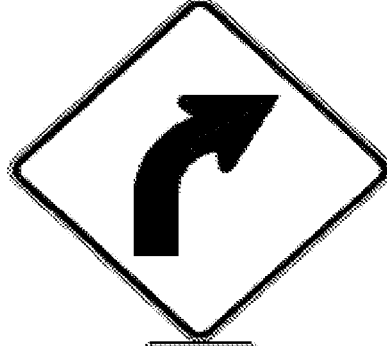





DIRECTION	MILEPOINT	LOCATION CODE (SHEET 2)	SIGN CODE	WIDTH (IN)	HEIGHT (IN)	SHEETING REMARKS	SIGN LEGEND	NEW SIGNS		EXISTING SIGNS			EXIST POST		NUMBER OF NEW POSTS	SQUARE STEEL (IN)			TUBULAR STEEL Ø (IN)				SIGN FRAME REQUIRED	REMARKS	SIGN DETAIL			
								"A"	"B"	RETAIN	SALVAGE FROM	SALVAGE TO	REMOVE	RETAIN		REMOVE	1.75	2.00	2.50	3.00	3.50	4.00			5.00	DETAIL IN SHS	DETAIL ON SHEET NUMBER	DETAIL ON STD SHEET NUMBER
																	(LB / FT)			(LB / FT)								
WARDSBORO VT 100							FY-FLUORESCENT YELLOW FYG-FLUORESCENT YELLOW GREEN															"SHS"-STANDARD HIGHWAY SIGNS						
			B W1-6	48	24	FY		8.00							2		X						FACES SB TRAFFIC	X				
NB	5.187		C VR-017	24	30							1		X									TH-26, GILFEATHER RD					
			C VR-017	24	30			5.00						1		X									E-141			
NB	5.192		D R1-1	30	30							1		X									STREET SIGN + MM SALVAGED ONTO NEW POST, TH-26, GILFEATHER RD					
			D R1-1	30	30			6.25						1		X									X			
NB	5.710		A W1-2L	30	30		LEFT CURVE					1		X														
			A W13-1	18	18		35 MPH PLAQUE					1																
NB	5.748		A W1-2L	30	30			6.25						1		X								INSTALL 175' 200 FEET NORTH OF EXISTING LEFT CURVE ASSEMBLY	X			
			A W13-1	18	18			2.25																	X			
NB	5.785		A W1-6	48	24							1		X														
			A W1-6	48	24			8.00						2		X								MM SALVAGED ONTO NEW POST	X			
NB	5.815		A W1-6	48	24							1		X														
			A W1-6	48	24			8.00						2		X										X		
NB	5.816		B W1-6	48	24			8.00						2		X								FACES SB TRAFFIC	X			
NB	5.850		B W1-6	48	24							1		X														
SIGN SUMMARY SHEET							SHEET TOTALS	51.75	0.00	0	0	0	7	0	0	11	165							PROJECT NAME: Stamford-Andover VT100				
VERMONT AGENCY OF TRANSPORTATION							TOWN TOTALS	633.3	0.0	24.0	12.0	12.0	108	0.0	0.0	129	1935.0							PROJECT NUMBER: STPG SIGN(20)	FILE NAME: Wardsboro.xls	PLOT DATE: 8/6/2009		
								SF	SF	EA	EA	EA	EA	EA	EA	EA	FT							DESIGNED BY: J. Kelly	DRAWN BY: N. Avery	CHECKED BY: T. Guazzoni		
																								WARDSBORO SHEET 7	SHEET 125	OF 198		




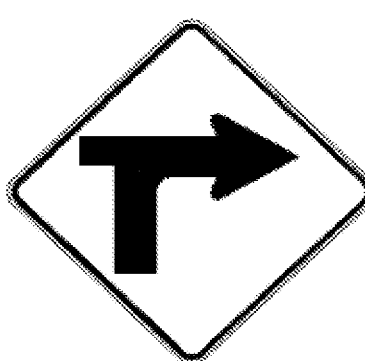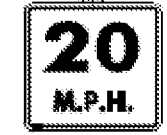


DIRECTION	MILEPOINT	LOCATION CODE (SHEET 2)	SIGN CODE	WIDTH (IN)	HEIGHT (IN)	SHEETING REMARKS	SIGN LEGEND	NEW SIGNS		EXISTING SIGNS			EXIST POST		NUMBER OF NEW POSTS	SQUARE STEEL (IN)			TUBULAR STEEL Ø (IN)				SIGN FRAME REQUIRED	REMARKS	SIGN DETAIL			
								"A"	"B"	RETAIN	SALVAGE FROM	SALVAGE TO	REMOVE	RETAIN		REMOVE	1.75	2.00	2.50	3.00	3.50	4.00			5.00	DETAIL IN SHS	DETAIL ON SHEET NUMBER	DETAIL ON STD SHEET NUMBER
																	(LB / FT)			(LB / FT)								
WARDSBORO VT 100							FY-FLUORESCENT YELLOW FYG-FLUORESCENT YELLOW GREEN															"SHS"-STANDARD HIGHWAY SIGNS						
			B	W1-6	48	24		8.00							2		X						FACES SB TRAFFIC	X				
NB	5.930		B	W1-6	48	24		8.00							2		X						FACES SB TRAFFIC	X				
NB	6.045		A	R2-5A	24	30	REDUCED SPEED AHEAD						1			X												
NB	6.092		A	W3-5	36	36		9.00							2		X							INSTALL 250 FEET NORTH OF EXISTING REDUCED SPEED AHEAD SIGN	X			
NB	6.105		A	VD-018	30	18	WARDSBORO E JAMAICA 5						1			X												
NB	6.133		A	VD-018	30	18		3.75							1		X							INSTALL 150 FEET NORTH OF EXISTING VILLAGE SIGN			E-128A	
NB	6.190		A	R2-1	24	30							1			X							MM SALVAGED ONTO NEW POST					
			A	R2-1	30	36		7.50							1		X									6		
NB	6.320		A	VD-062B	72	16	BUSINESS SIGN			1							X											
			A	VD-062B	72	16	BUSINESS SIGN			1																		
NB	6.360		A	VD-062B	72	16	BUSINESS SIGN			1							X											
			A	VD-062B	72	16	BUSINESS SIGN			1																		
NB	6.395		A	R2-1	24	30							1			X												
			A	R2-1	24	30		5.00							1		X						MM SALVAGED ONTO NEW POST	X				
NB	6.520		A	R2-1	24	30	SPEED LIMIT 35						1			X												
SIGN SUMMARY SHEET							SHEET TOTALS	41.25	0.00	4	0	0	5	0	0	9	135							PROJECT NAME: Stamford-Andover VT100				
								SF	SF	EA	EA	EA	EA	EA	EA	EA	FT						PROJECT NUMBER: STPG SIGN(20)					
VERMONT AGENCY OF TRANSPORTATION							TOWN TOTALS	633.3	0.0	24.0	12.0	12.0	108	0.0	0.0	129	1935.0						FILE NAME: Wardsboro.xls	PLOT DATE: 8/6/2009				
																						PROJECT MANAGER: N. Avery	DRAWN BY: T. Guazzoni					
																					DESIGNED BY: J. Kelly	CHECKED BY: T. Guazzoni						
																					WARDSBORO SHEET 8	SHEET 126 OF 198						




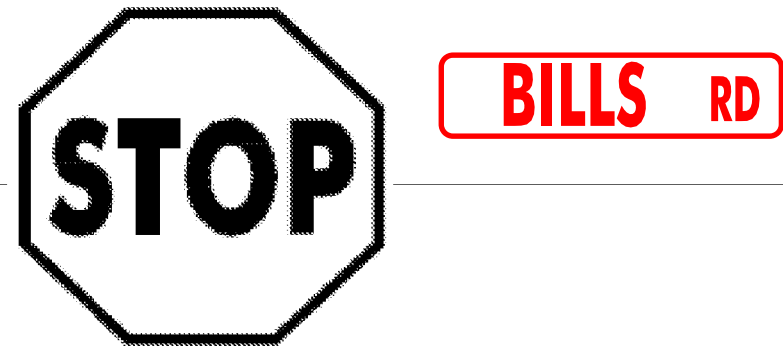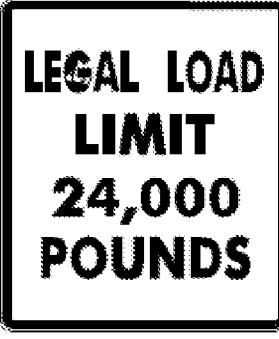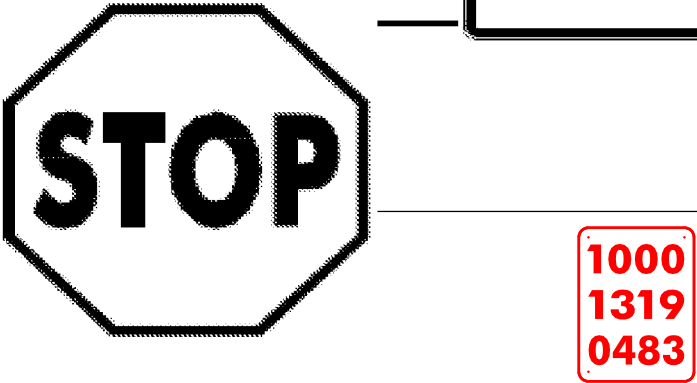

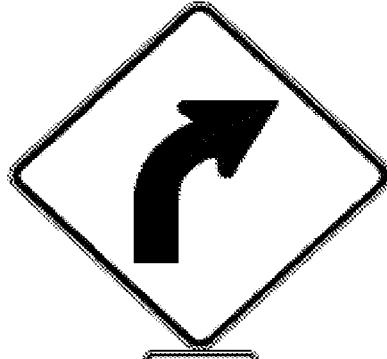DIRECTION	MILEPOINT	LOCATION CODE (SHEET 2)	SIGN CODE	WIDTH (IN)	HEIGHT (IN)	SHEETING REMARKS	SIGN LEGEND	NEW SIGNS		EXISTING SIGNS			EXIST POST		NUMBER OF NEW POSTS	SQUARE STEEL (IN)			TUBULAR STEEL Ø (IN)				SIGN FRAME REQUIRED	REMARKS	SIGN DETAIL			
								"A"	"B"	RETAIN	SALVAGE FROM	SALVAGE TO	REMOVE	RETAIN		REMOVE	1.75	2.00	2.50	3.00	3.50	4.00			5.00	DETAIL IN SHS	DETAIL ON SHEET NUMBER	DETAIL ON STD SHEET NUMBER
																	(LB / FT)			(LB / FT)								
WARDSBORO VT 100							FY-FLUORESCENT YELLOW FYG-FLUORESCENT YELLOW GREEN															"SHS"-STANDARD HIGHWAY SIGNS						
NB	6.535	A	W1-1MbL	30	30						1																	
		A	W13-1	18	18							1																
		A	W1-1MbL	30	30	FY								1		X									6			
		A	W13-1	18	18	FY																		X				
NB	6.560	A	M1-5	30	24						1																	
		A	M6-1	21	15	<---LEFT						1																
		A	M3-1	24	12									1		X												
		A	M1-5	30	24																				E-136B			
		A	M6-1L	21	15																		X					
NB	6.575	A	W1-6	48	24		<=== LARGE ARROW LEFT				1																	
NB	6.576	B	W1-6	48	24						1																	
		B	W1-6	48	24	FY								2		X								X				
NB	6.577	C	VR-017	24	30						1																	
		C	VR-017	24	30									1		X									E-141			
NB	6.582	D	R1-1	30	30						1																	
SIGN SUMMARY SHEET							SHEET TOTALS	30.69	0.00	1	0	0	7	0	0	5	75					PROJECT NAME: Stamford-Andover VT100						
								SF	SF	EA	EA	EA	EA	EA	EA	EA	FT					PROJECT NUMBER: STPG SIGN(20)						
VERMONT AGENCY OF TRANSPORTATION							TOWN TOTALS	633.3	0.0	24.0	12.0	12.0	108	0.0	0.0	129	1935.0					FILE NAME: Wardsboro.xls	PLOT DATE: 8/6/2009					
																						PROJECT MANAGER: N. Avery	DRAWN BY: T. Guazzoni					
																						DESIGNED BY: J. Kelly	CHECKED BY: T. Guazzoni					
																						WARDSBORO SHEET 9	SHEET 127 OF 198					




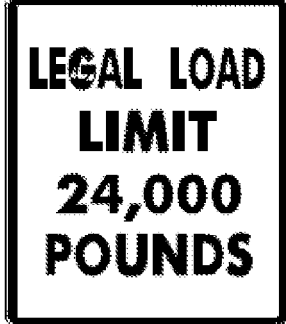


DIRECTION	MILEPOINT	LOCATION CODE (SHEET 2)	SIGN CODE	WIDTH (IN)	HEIGHT (IN)	SHEETING REMARKS	SIGN LEGEND	NEW SIGNS		EXISTING SIGNS			EXIST POST		NUMBER OF NEW POSTS	SQUARE STEEL (IN)			TUBULAR STEEL Ø (IN)				SIGN FRAME REQUIRED	REMARKS	SIGN DETAIL				
								"A"	"B"	RETAIN	SALVAGE FROM	SALVAGE TO	REMOVE	RETAIN		REMOVE	1.75	2.00	2.50	FOUNDATION	3.00	3.50			4.00	5.00	DETAIL IN SHS	DETAIL ON SHEET NUMBER	DETAIL ON STD SHEET NUMBER
																	(LB / FT)				(LB / FT)								
WARDSBORO VT 100							FY-FLUORESCENT YELLOW FYG-FLUORESCENT YELLOW GREEN															"SHS"-STANDARD HIGHWAY SIGNS							
NB	6.584	C	W1-6	48	24	FY		8.00						2	X								ARROW FACES NB TRAFFIC, BUT INSTALL PARALLEL TO VT-100 , BEHIND RAIL 10 FT± NORTH OF STOP SIGN.	X					
NB	6.596	A	M3-1	24	12		NORTH			1																			
		A	M1-5	30	24		VERMONT 100			1																			
NB	6.675	A	R2-1	24	30							1		X															
		A	R2-1	24	30			5.00						1	X									X					
NB	6.880	A	R2-1	24	30		SPEED LIMIT 40			1																			
NB	6.960	A	S1-1YG	36	36		SCHOOL PENTAGON			1																			
		A	W16-9YG	24	10		AHEAD			1																			
NB	7.093	A	D1-2L	72	20		<--- WARDSBORO ELEMENTARY SCHOOL			1																			
		B	D1-2R	72	20		WARDSBORO ELEMENTARY SCHOOL --->			1																			
NB	7.280	A	R2-1	24	30		SPEED LIMIT 50			1																			
SB	7.280	F	R2-1	24	30		SPEED LIMIT 40			1																			
SB	7.215	F	S1-1YG	36	36		SCHOOL PENTAGON			1																			
		F	W16-9YG	24	10		AHEAD			1																			
SB	7.095	G	VR-017	24	30							1		X									SALVAGED SEAT BELT SIGN ONTO NEW POST TH-45, SCHOOL DRRD						
SIGN SUMMARY SHEET							SHEET TOTALS	13.00	0.00	11	0	0	3	0	0	3	45						PROJECT NAME: Stamford-Andover VT100						
VERMONT AGENCY OF TRANSPORTATION							TOWN TOTALS	633.3	0.0	24.0	12.0	12.0	108	0.0	0.0	129	1935.0						PROJECT NUMBER: STPG SIGN(20)						
								SF	SF	EA	EA	EA	EA	EA	EA	EA	FT						FILE NAME: Wardsboro.xls	PLOT DATE: 8/6/2009					
																						PROJECT MANAGER: N. Avery	DRAWN BY: T. Guazzoni						
																						DESIGNED BY: J. Kelly	CHECKED BY: T. Guazzoni						
																						WARDSBORO SHEET 10	SHEET 128 OF 198						



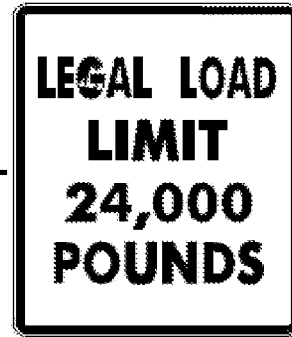


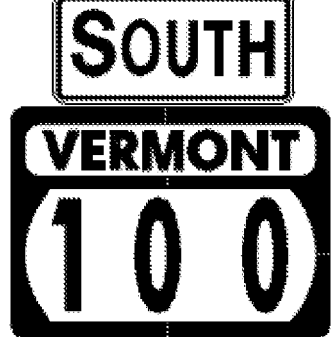
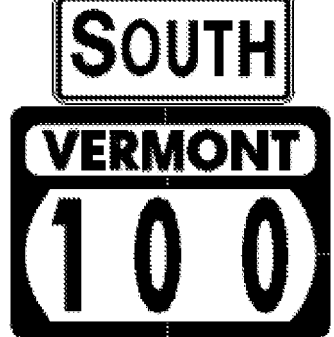
DIRECTION	MILEPOINT	LOCATION CODE (SHEET 2)	SIGN CODE	WIDTH (IN)	HEIGHT (IN)	SHEETING REMARKS	SIGN LEGEND	NEW SIGNS		EXISTING SIGNS			EXIST POST		NUMBER OF NEW POSTS	SQUARE STEEL (IN)			TUBULAR STEEL Ø (IN)				SIGN FRAME REQUIRED	REMARKS	SIGN DETAIL			
								"A"	"B"	RETAIN	SALVAGE FROM	SALVAGE TO	REMOVE	RETAIN		REMOVE	1.75	2.00	2.50	3.00	3.50	4.00			5.00	DETAIL IN SHS	DETAIL ON SHEET NUMBER	DETAIL ON STD SHEET NUMBER
																	(LB / FT)			(LB / FT)								
WARDSBORO VT 100							FY-FLUORESCENT YELLOW FYG-FLUORESCENT YELLOW GREEN															"SHS"-STANDARD HIGHWAY SIGNS						
SB	7.095	G	VR-017	24	30		 * 	5.00							1		X							* SEE BELOW FOR STOP SIGN NOTE			E-141	
SB	7.090	H	R1-1	30	30		  					2 +												SALVAGED SEAT BELT SIGN ONTO NEW POST TH-45, SCHOOL DR				
		H	R1-1	30	30			6.25							1		X								X			
SB	7.000	F	VD-062B	72	16		BUSINESS SIGN			1																		
SB	6.960	F	VD-062B	72	16		BUSINESS SIGN			1																		
		F	VD-062B	72	16		BUSINESS SIGN			1																		
SB	6.940	F	VD-018	30	18							1																
		F	VD-018	30	18			3.75							1		X									E-128A		
SB	6.880	F	R2-1	30	36		SPEED LIMIT 35			1																		
SB	6.650	F	W1-1MaR	30	30		MODIFIED RIGHT TURN					1																
		F	W13-1	18	18		20 MPH PLAQUE					1																
SB	6.608	F	M1-5	30	24		VERMONT 100					1																
		F	M6-1	21	15		RIGHT --->					1																
		F	W1-1MaR	30	30	FY		6.25							1		X									8		
		F	W13-1	18	18	FY		2.25																	X			
SIGN SUMMARY SHEET							SHEET TOTALS	23.50	0.00	4	2	2	8	0	0	4	60							PROJECT NAME: Stamford-Andover VT100				
VERMONT AGENCY OF TRANSPORTATION							TOWN TOTALS	633.3	0.0	24.0	12.0	12.0	108	0.0	0.0	129	1935.0							PROJECT NUMBER: STPG SIGN(20)				
								SF	SF	EA	EA	EA	EA	EA	EA	EA	FT						FILE NAME: Wardsboro.xls					
																							PLOT DATE: 8/6/2009					
																							DESIGNED BY: J. Kelly					
																							CHECKED BY: T. Guazzoni					
																							WARDSBORO SHEET 11					
																							SHEET 129 OF 198					



DIRECTION	MILEPOINT	LOCATION CODE (SHEET 2)	SIGN CODE	WIDTH (IN)	HEIGHT (IN)	SHEETING REMARKS	SIGN LEGEND	NEW SIGNS		EXISTING SIGNS			EXIST POST		NUMBER OF NEW POSTS	SQUARE STEEL (IN)			TUBULAR STEEL Ø (IN)				SIGN FRAME REQUIRED	REMARKS	SIGN DETAIL				
								"A"	"B"	RETAIN	SALVAGE FROM	SALVAGE TO	REMOVE	RETAIN		REMOVE	1.75	2.00	2.50	FOUNDATION	3.00	3.50			4.00	5.00	DETAIL IN SHS	DETAIL ON SHEET NUMBER	DETAIL ON STD SHEET NUMBER
																	(LB / FT)				(LB / FT)								
WARDSBORO VT 100							FY-FLUORESCENT YELLOW FYG-FLUORESCENT YELLOW GREEN															"SHS"-STANDARD HIGHWAY SIGNS							
SB	6.190	F	R2-1	24	30						1		X																
		F	R2-1	24	30			5.00							1	X							X						
SB	5.990	F	W1-2R	30	30		CURVE RIGHT				1		X																
		F	W13-1	18	18		35 MPH (PLAQUE)				1																		
SB	5.970	F	W1-2R	30	30			6.25						1	X								INSTALL 100 FEET SOUTH OF EXISTING RIGHT CURVE ASSEMBLY	X					
		F	W13-1	18	18			2.25																X					
SB	5.193	G	VR-017	24	30						1		X										TH-16, BILLS RD (NORTH)						
		G	VR-017	24	30			5.00						1	X											E-141			
SB	5.188	H	R1-1	30	30						1		X										TH-16, BILLS RD (NORTH)						
		H	R1-1	30	30			6.25						1	X								SALVAGED STREET SIGN ONTO NEW POST	X					
SB	4.838	G	VR-017	24	30		LEGAL LOAD LIMIT 24,000 LBS				1		X										TH-16, BILLS RD (SOUTH)						
		G	R2-1	24	30		SPEED LIMIT 25 (TOWN)				1												INSTALL UNDER NEW LEGAL LOAD LIMIT 24,000 LBS SIGN						
		G	VR-017	24	30			5.00						1	X											E-141			
SB	4.832	H	R1-1	30	30						1		X										TH-16, BILLS RD (SOUTH)						
		H	R1-1	30	30			6.25						1	X									X					
SIGN SUMMARY SHEET							SHEET TOTALS	36.00	0.00	0	1	1	8	0	0	6	90							PROJECT NAME: Stamford-Andover VT100					
VERMONT AGENCY OF TRANSPORTATION							TOWN TOTALS	633.3	0.0	24.0	12.0	12.0	108	0.0	0.0	129	1935.0							PROJECT NUMBER: STPG SIGN(20)					
								SF	SF	EA	EA	EA	EA	EA	EA	EA	FT							FILE NAME: Wardsboro.xls	PLOT DATE: 8/6/2009				
																								PROJECT MANAGER: N. Avery	DRAWN BY: T. Guazzoni				
																								DESIGNED BY: J. Kelly	CHECKED BY: T. Guazzoni				
																								WARDSBORO SHEET 13	SHEET 131 OF 198				

DIRECTION	MILEPOINT	LOCATION CODE (SHEET 2)	SIGN CODE	WIDTH (IN)	HEIGHT (IN)	SHEETING REMARKS	SIGN LEGEND	NEW SIGNS		EXISTING SIGNS			EXIST POST		NUMBER OF NEW POSTS	SQUARE STEEL (IN)			TUBULAR STEEL Ø (IN)				SIGN FRAME REQUIRED	REMARKS	SIGN DETAIL				
								"A"	"B"	RETAIN	SALVAGE FROM	SALVAGE TO	REMOVE	RETAIN		REMOVE	1.75	2.00	2.50	FOUNDATION	3.00	3.50			4.00	5.00	DETAIL IN SHS	DETAIL ON SHEET NUMBER	DETAIL ON STD SHEET NUMBER
																	(LB / FT)				(LB / FT)								
WARDSBORO VT 100							FY-FLUORESCENT YELLOW FYG-FLUORESCENT YELLOW GREEN															"SHS"-STANDARD HIGHWAY SIGNS							
SB	4.305	F	W1-2R	30	30		RIGHT CURVE				1																		
		F	W13-1	18	18		35 MPH PLAQUE				1																		
																													
SB	4.258	F	W1-2R	30	30	FY		6.25																					
		F	W13-1	18	18	FY	 	2.25																X					
											1																		
SB	3.248	G	VR-017	24	30		LEGAL LOAD LIMIT 24,000 LBS																						
		G	R2-1	24	30		SPEED LIMIT 35 (TOWN)			1	1																		
		G	VR-017	24	30			5.00																	E-141				
											1																		
SB	3.242	H	R1-1	30	30			6.25																X					
		H	R1-1	30	30																								
SB	2.887	F	W3-5	36	36		SPEED REDUCTION (30)			1																			
SB	2.830 2.820	F	VD-018	30	18						1																		
		F	VD-018	30	18			3.75																	E-128A				
SB	2.766	F	R2-1	30	36		SPEED LIMIT 30			1																			
SB	2.763	G	VR-017	24	30		LEGAL LOAD LIMIT 24,000 LBS				1																		
		G	R2-1	24	30		SPEED LIMIT 35 (TOWN INSTALLED)			1	1																		
SIGN SUMMARY SHEET							SHEET TOTALS	23.50	0.00	1	3	2	8	0	0	4	60					PROJECT NAME: Stamford-Andover VT100							
VERMONT AGENCY OF TRANSPORTATION							TOWN TOTALS	633.3	0.0	24.0	12.0	12.0	108	0.0	0.0	129	1935.0					PROJECT NUMBER: STPG SIGN(20)							
								SF	SF	EA	EA	EA	EA	EA	EA	EA	FT					FILE NAME: Wardsboro.xls	PLOT DATE: 8/6/2009						
																						PROJECT MANAGER: N. Avery	DRAWN BY: T. Guazzoni						
																						DESIGNED BY: J. Kelly	CHECKED BY: T. Guazzoni						
																						WARDSBORO SHEET 14	SHEET 132 OF 198						









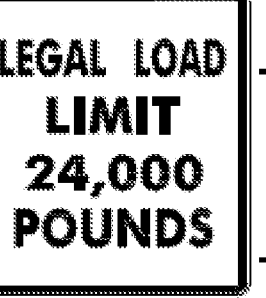
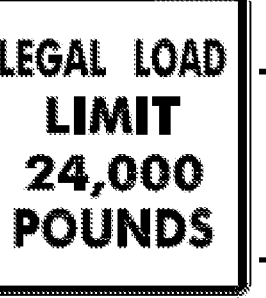




DIRECTION	MILEPOINT	LOCATION CODE (SHEET 2)	SIGN CODE	WIDTH (IN)	HEIGHT (IN)	SHEETING REMARKS	SIGN LEGEND	NEW SIGNS		EXISTING SIGNS			EXIST POST		NUMBER OF NEW POSTS	SQUARE STEEL (IN)			TUBULAR STEEL Ø (IN)				SIGN FRAME REQUIRED	REMARKS	SIGN DETAIL			
								"A"	"B"	RETAIN	SALVAGE FROM	SALVAGE TO	REMOVE	RETAIN		REMOVE	1.75	2.00	2.50	3.00	3.50	4.00			5.00	DETAIL IN SHS	DETAIL ON SHEET NUMBER	DETAIL ON STD SHEET NUMBER
																	(LB / FT)			(LB / FT)								
WARDSBORO VT 100							FY-FLUORESCENT YELLOW FYG-FLUORESCENT YELLOW GREEN															"SHS"-STANDARD HIGHWAY SIGNS						
			G VR-017	24	30			5.00						1	X								TH-10, SHELDON HILL RD			E-141		
SB	2.758		H R1-1	30	30							1		X														
			H R1-1	30	30			6.25						1	X								TH-10, SHELDON HILL RD	X				
SB	2.730		F R2-1	30	36		SPEED LIMIT 30				1			1	X								SALVAGED SIGN FROM M.P. 2.766					
												1		X														
			F R2-1	24	30			5.00						1	X									X				
SB	2.411		F W1-3L	36	36		LEFT REVERSE TURN			1				X									SALVAGE TO M.P. 2.403					
			F W13-1	24	24		20 MPH PLAQUE			1													SALVAGE TO M.P. 2.403					
SB	2.403		F W5-2	30	30		NARROW BRIDGE					1		X														
			F W1-3L	36	36		LEFT REVERSE TURN					1			X								SALVAGED FROM M.P. 2.411					
			F W13-1	24	24		20 MPH PLAQUE					1											SALVAGED FROM M.P. 2.411					
																												
SB	2.345		F W5-2	36	36			9.00							X								INSTALL 275 FT± SOUTH OF THE RELOCATED REVERSE TURN ASSEMBLY.	X				
SB	2.343		E W1-6	48	24							1		X														
			E W1-6	48	24	FY		8.00						2	X									X				
SB	2.338		G VR-017	24	30							1		X									TH-7, NEWELL RD					
SIGN SUMMARY SHEET							SHEET TOTALS	33.25	0.00	0	3	4	8	0	0	10	135							PROJECT NAME: Stamford-Andover VT100				
VERMONT AGENCY OF TRANSPORTATION							TOWN TOTALS	633.3	0.0	24.0	12.0	12.0	108	0.0	0.0	129	1935.0							PROJECT NUMBER: STPG SIGN(20)	FILE NAME: Wardsboro.xls	PLOT DATE: 8/6/2009		
								SF	SF	EA	EA	EA	EA	EA	EA	EA	FT							PROJECT MANAGER: N. Avery	DRAWN BY: T. Guazzoni			
																							DESIGNED BY: J. Kelly	CHECKED BY: T. Guazzoni				
																							WARDSBORO SHEET 15	SHEET 133 OF 198				

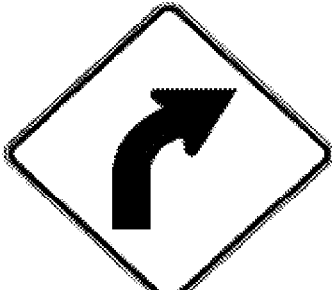DIRECTION	MILEPOINT	LOCATION CODE (SHEET 2)	SIGN CODE	WIDTH (IN)	HEIGHT (IN)	SHEETING REMARKS	SIGN LEGEND	NEW SIGNS		EXISTING SIGNS			EXIST POST		NUMBER OF NEW POSTS	SQUARE STEEL (IN)			TUBULAR STEEL Ø (IN)				SIGN FRAME REQUIRED	REMARKS	SIGN DETAIL																			
								"A"	"B"	RETAIN	SALVAGE FROM	SALVAGE TO	REMOVE	RETAIN		REMOVE	1.75	2.00	2.50	FOUNDATION	3.00	3.50			4.00	5.00	DETAIL IN SHS	DETAIL ON SHEET NUMBER	DETAIL ON STD SHEET NUMBER															
																	(LB / FT)				(LB / FT)																							
WARDSBORO VT 100							FY-FLUORESCENT YELLOW FYG-FLUORESCENT YELLOW GREEN															"SHS"-STANDARD HIGHWAY SIGNS																						
		G	VR-017	24	30			5.00						1	X										E-141																			
SB	2.334	H	R1-1	30	30	STOP				1	1	1		X	1	X								TH-7, NEWELL RD																				
SB	2.333	F	W1-6	60	30							1		X																														
		F	W1-6	60	30	FY		12.50						2	X									X																				
SB	2.323	F	OM-3R	12	36							1		X																														
		F	OM-3R	12	36			3.00						1	X									X																				
SB	2.313	E	OM-3L	12	36							1		X																														
		E	OM-3L	12	36			3.00						1	X									X																				
SB	2.280	F	R2-1	24	30							1		X																														
		F	R2-1	24	30			5.00						1	X									X																				
SB	2.278	G	VR-017	24	30							1		X																														
		H	R1-1	30	30																																							
		G	VR-017	24	30			5.00						1	X											E-141																		
SB	2.273	H	R1-1	30	30			6.25						1	X									X																				
SB	2.228	F	D1-1A	72	10							1		X																														
SIGN SUMMARY SHEET							SHEET TOTALS	39.75	0.00	0	1	1	7	0	0	9	135																											
VERMONT AGENCY OF TRANSPORTATION							TOWN TOTALS	633.3	0.0	24.0	12.0	12.0	108	0.0	0.0	129	1935.0																											
																					PROJECT NAME:	Stamford-Andover VT100					PROJECT NUMBER:	STPG SIGN(20)					FILE NAME:	Wardsboro.xls					PLOT DATE:	8/6/2009				
																					DESIGNED BY:	J. Kelly					CHECKED BY:	T. Guazzoni					PROJECT MANAGER:	N. Avery					DRAWN BY:	T. Guazzoni				
																					WARDSBORO SHEET 16																		SHEET	134 OF 198				

DIRECTION	MILEPOINT	LOCATION CODE (SHEET 2)	SIGN CODE	WIDTH (IN)	HEIGHT (IN)	SHEETING REMARKS	SIGN LEGEND	NEW SIGNS		EXISTING SIGNS			EXIST POST		NUMBER OF NEW POSTS	SQUARE STEEL (IN)			TUBULAR STEEL Ø (IN)				SIGN FRAME REQUIRED	REMARKS	SIGN DETAIL				
								"A"	"B"	RETAIN	SALVAGE FROM	SALVAGE TO	REMOVE	RETAIN		REMOVE	1.75	2.00	2.50	FOUNDATION	3.00	3.50			4.00	5.00	DETAIL IN SHS	DETAIL ON SHEET NUMBER	DETAIL ON STD SHEET NUMBER
																	(LB / FT)				(LB / FT)								
WARDSBORO VT 100							FY-FLUORESCENT YELLOW FYG-FLUORESCENT YELLOW GREEN															"SHS"-STANDARD HIGHWAY SIGNS							
			F D1-1A	72	10		 				1															5			
			F D1-1A	72	12			6.00						2		X													
			F D1-1A	72	12			6.00																				5	
SB	2.143		G VR-017	24	30						1																		
			G VR-017	24	30			5.00						1		X													
SB	2.138		H R1-1	30	30						1																		
			H R1-1	30	30			6.25						1		X													
SB	2.115		F M3-3S	24	12		SOUTH  				1																		
			F M1-5	30	24			VERMONT 100				1																	
			F R2-1	24	30			5.00						1		X											X		
SB	2.077		F M3-3	24	12																								
			F M1-5	30	24			2.00						1		X											X		
SB	2.040		F R2-1	24	30		SPEED LIMIT 50				1																		
SB	1.900		F W1-2R	30	30		RIGHT CURVE				1																		
			F W13-1	18	18		35 MPH PLAQUE				1																		
SIGN SUMMARY SHEET							SHEET TOTALS	35.25	0.00	0	3	1	8	0	0	6	90							PROJECT NAME: Stamford-Andover VT100					
VERMONT AGENCY OF TRANSPORTATION							TOWN TOTALS	633.3	0.0	24.0	12.0	12.0	108	0.0	0.0	129	1935.0							PROJECT NUMBER: STPG SIGN(20)					
								SF	SF	EA	EA	EA	EA	EA	EA	EA	FT							FILE NAME: Wardsboro.xls					
																								PLOT DATE: 8/6/2009					
																								DRAWN BY: T. Guazzoni					
																								DESIGNED BY: J. Kelly					
																								CHECKED BY: T. Guazzoni					
																								WARDSBORO SHEET 17					
																								SHEET 135 OF 198					





DIRECTION	MILEPOINT	LOCATION CODE (SHEET 2)	SIGN CODE	WIDTH (IN)	HEIGHT (IN)	SHEETING REMARKS	SIGN LEGEND	NEW SIGNS		EXISTING SIGNS			EXIST POST		NUMBER OF NEW POSTS	SQUARE STEEL (IN)			TUBULAR STEEL Ø (IN)				SIGN FRAME REQUIRED	REMARKS	SIGN DETAIL			
								"A"	"B"	RETAIN	SALVAGE FROM	SALVAGE TO	REMOVE	RETAIN		REMOVE	1.75	2.00	2.50	3.00	3.50	4.00			5.00	DETAIL IN SHS	DETAIL ON SHEET NUMBER	DETAIL ON STD SHEET NUMBER
																	(LB / FT)			(LB / FT)								
WARDSBORO VT 100							FY-FLUORESCENT YELLOW FYG-FLUORESCENT YELLOW GREEN															"SHS"-STANDARD HIGHWAY SIGNS						
SB	1.872	F	W1-2R	30	30		RIGHT CURVE				1			1	X								INSTALL 150 FT± SOUTH OF PREVIOUS POSITION	X				
		F	W13-1	18	18		35 MPH PLAQUE				1													X				
SB	0.990	F	W1-2R	30	30		RIGHT CURVE					1	X															
		F	W13-1	18	18		35 MPH PLAQUE					1																
	0.933	F	W1-2R	30	30	FY		6.25						1	X								INSTALL 300 FT± SOUTH OF PREVIOUS POSITION	X				
		F	W13-1	18	18	FY		2.25																X				
SB	0.760	F	VW-060	30	30		HIDDEN DRIVES					1	X															
SB	0.700	F	VW-054R	30	30			6.25						1	X								INSTALL 315 FT± SOUTH OF PREVIOUS HIDDEN DRIVES SIGN			E-154		
SIGN SUMMARY SHEET							SHEET TOTALS	14.75	0.00	0	0	2	3	0	0	3	45						PROJECT NAME: Stamford-Andover VT100					
VERMONT AGENCY OF TRANSPORTATION							TOWN TOTALS	633.3	0.0	24.0	12.0	12.0	108	0.0	0.0	129	1935.0						PROJECT NUMBER: STPG SIGN(20)					
								SF	SF	EA	EA	EA	EA	EA	EA	EA	FT						FILE NAME: Wardsboro.xls	PLOT DATE: 8/6/2009				
																							PROJECT MANAGER: N. Avery	DRAWN BY: T. Guazzoni				
																							DESIGNED BY: J. Kelly	CHECKED BY: T. Guazzoni				
																							WARDSBORO SHEET 18	SHEET 136 OF 198				

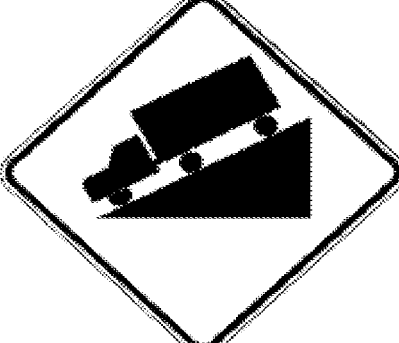






DIRECTION	MILEPOINT	LOCATION CODE (SHEET 2)	SIGN CODE	WIDTH (IN)	HEIGHT (IN)	SHEETING REMARKS	SIGN LEGEND	NEW SIGNS		EXISTING SIGNS			EXIST POST		NUMBER OF NEW POSTS	SQUARE STEEL (IN)			TUBULAR STEEL Ø (IN)				SIGN FRAME REQUIRED	REMARKS	SIGN DETAIL			
								"A"	"B"	RETAIN	SALVAGE FROM	SALVAGE TO	REMOVE	RETAIN		REMOVE	1.75	2.00	2.50	3.00	3.50	4.00			5.00	DETAIL IN SHS	DETAIL ON SHEET NUMBER	DETAIL ON STD SHEET NUMBER
																	(LB / FT)			(LB / FT)								
JAMAICA VT 100							FY-FLUORESCENT YELLOW FYG-FLUORESCENT YELLOW GREEN															"SHS"-STANDARD HIGHWAY SIGNS						
NB	0.000	C	VD-024	60	7.5		JAMAICA WARDBORO				1		X										INSTALL THE NEW SIGN ON TWO POSTS AT THE SAME LOCATION AS THE REMOVAL		4			
		C	VD-024	72	10			5.00						2	X								JAMAICA MILE MARKER. INSTALL ON THE LEFT-SIDE POST UNDER JAMAICA.					
		C	VD-700	6	10		1000-1309-0000			1	1												WARDSBORO MILE MARKER. INSTALL ON THE RIGHT-SIDE POST UNDER WARDBORO.					
		C	VD-700	6	10		1000-1319-0737			1	1																	
RETAIN SIGN AT NB 0.300 SEE PAGE I49																												
NB	0.475	A	W1-1R	30	30		RIGHT TURN SYMBOL				1		X															
		A	W13-1	18	18		25 MPH (PLAQUE)				1																	
NB	0.509	A	W1-1R	30	30	FY		6.25						1	X								INSTALL 180 FT ± NORTH OF PREVIOUS POSITION, 10 FT MIN NORTH OF POLE.	X				
		A	W13-1	18	18	FY		2.25																X				
NB	1.036 1.022	A	W1-4L	30	30		REVERSE CURVE LEFT				1		X										MOVED 75' NORTH OF PREVIOUS LOCATION					
		A	W1-3L	30	30	FY		6.25						1	X									X				
		A	W13-1	18	18	FY		2.25																X				
NB	1.073	A	S3-1	30	30		SCHOOL BUS STOP AHEAD			1			X															
NB	1.270	A	W1-2L	30	30		CURVE LEFT				1		X															
NB	1.298 1.310	A	W1-2L	30	30	FY		6.25						1	X								INSTALL 150 FT ± NORTH OF PREVIOUS POSITON.	X				
NB	1.746	A	W1-2R	30	30						1		X															
SIGN SUMMARY SHEET							SHEET TOTALS	28.25	0.00	1	2	2	6	0	0	5	75						PROJECT NAME: Stamford-Andover VT100					
VERMONT AGENCY OF TRANSPORTATION							TOWN TOTALS	391.9	0.0	33.0	4.0	4.0	69	0.0	0.0	66	990.0						PROJECT NUMBER: STPG SIGN(20)					
								SF	SF	EA	EA	EA	EA	EA	EA	EA	FT						FILE NAME: Jamaica.xls			PLOT DATE: 8/6/2009		
																							PROJECT MANAGER: N. Avery			DRAWN BY: T. Guazzoni		
																							DESIGNED BY: M. Miller			CHECKED BY: T. Guazzoni		
																							JAMAICA SHEET 1			SHEET 137 OF 198		

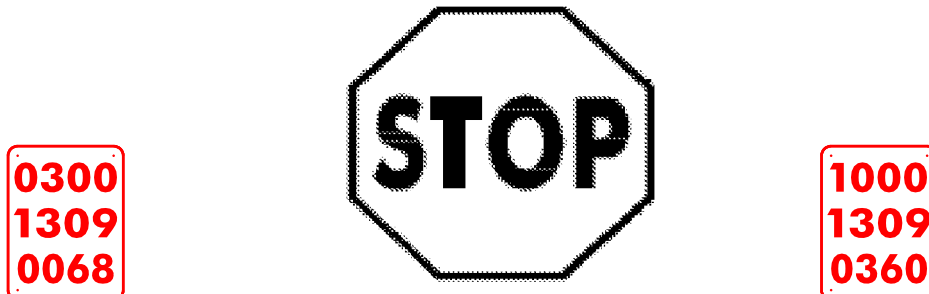

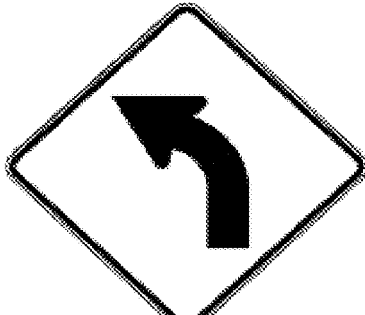
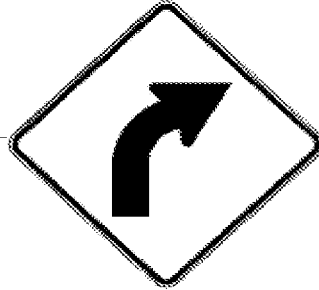
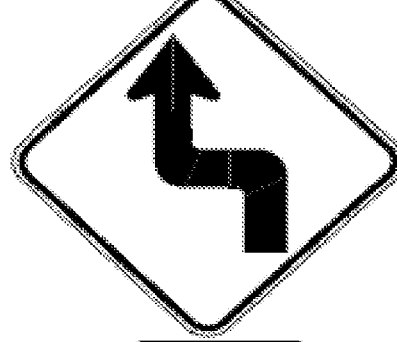

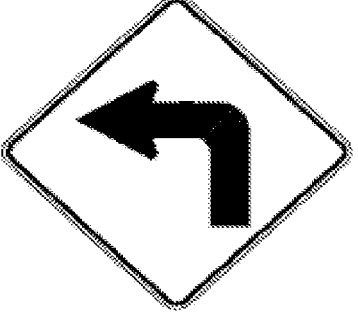

DIRECTION	MILEPOINT	LOCATION CODE (SHEET 2)	SIGN CODE	WIDTH (IN)	HEIGHT (IN)	SHEETING REMARKS	SIGN LEGEND	NEW SIGNS		EXISTING SIGNS			EXIST POST		NUMBER OF NEW POSTS	SQUARE STEEL (IN)			TUBULAR STEEL Ø (IN)				SIGN FRAME REQUIRED	REMARKS	SIGN DETAIL				
								"A"	"B"	RETAIN	SALVAGE FROM	SALVAGE TO	REMOVE	RETAIN		REMOVE	1.75	2.00	2.50	FOUNDATION	3.00	3.50			4.00	5.00	DETAIL IN SHS	DETAIL ON SHEET NUMBER	DETAIL ON STD SHEET NUMBER
																	(LB / FT)				(LB / FT)								
JAMAICA VT 100							FY-FLUORESCENT YELLOW FYG-FLUORESCENT YELLOW GREEN															"SHS"-STANDARD HIGHWAY SIGNS							
NB	1.746	A	W13-1	18	18							1																	
		A	W1-2R	30	30	FY		6.25										X					X						
		A	W13-1	18	18	FY		2.25															X						
NB	2.244	C	VR-017	24	30			5.00										X											
NB	2.252	D	R1-1	30	30							1																	
		D	R1-1	30	30			6.25										X					X						
NB	2.255	A	OM-3R	12	36			3.00				1						X					X						
NB	2.288	B	OM-3L	12	36							1																	
		B	OM-3L	12	36			3.00										X					X						
NB	2.491	C	VR-017	24	30			5.00				1						X						E-141					
NB	2.499	D	R1-1	30	30							1																	
		D	R1-1	30	30			6.25										X					X						
NB	2.953	A	W1-7B	30	30	FY		6.25										X					X						
		A	W16-4	30	24	FY		5.00															X						
NB	2.993	A	N/A				(EMPTY POST)																						
SIGN SUMMARY SHEET							SHEET TOTALS	48.25	0.00	0	0	0	6	0	0	8	120					PROJECT NAME: Stamford-Andover VT100							
								SF	SF	EA	EA	EA	EA	EA	EA	EA	FT					PROJECT NUMBER: STPG SIGN(20)							
VERMONT AGENCY OF TRANSPORTATION							TOWN TOTALS	391.9	0.0	33.0	4.0	4.0	69	0.0	0.0	66	990.0					FILE NAME: Jamaica.xls	PLOT DATE: 8/6/2009						
																					PROJECT MANAGER: N. Avery	DRAWN BY: T. Guazzoni							
																					DESIGNED BY: M. Miller	CHECKED BY: T. Guazzoni							
																					JAMAICA SHEET 2	SHEET 138 OF 198							

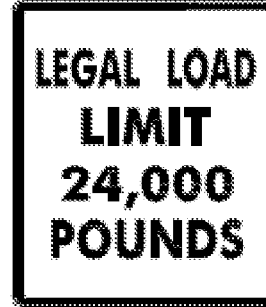
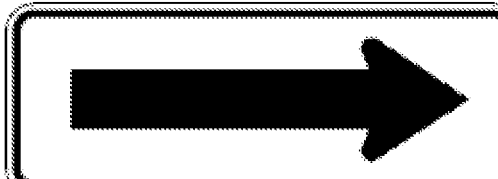
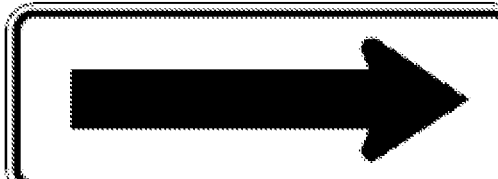




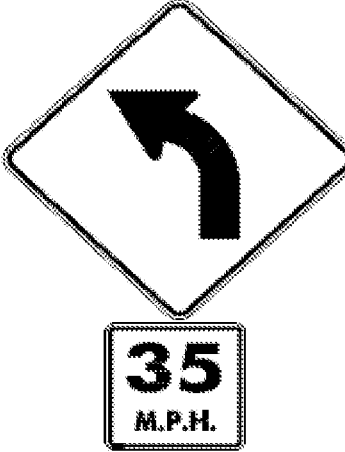





DIRECTION	MILEPOINT	LOCATION CODE (SHEET 2)	SIGN CODE	WIDTH (IN)	HEIGHT (IN)	SHEETING REMARKS	SIGN LEGEND	NEW SIGNS		EXISTING SIGNS			EXIST POST		NUMBER OF NEW POSTS	SQUARE STEEL (IN)			TUBULAR STEEL Ø (IN)				SIGN FRAME REQUIRED	REMARKS	SIGN DETAIL							
								"A"	"B"	RETAIN	SALVAGE FROM	SALVAGE TO	REMOVE	RETAIN		REMOVE	1.75	2.00	2.50	FOUNDATION	3.00	3.50			4.00	5.00	DETAIL IN SHS	DETAIL ON SHEET NUMBER	DETAIL ON STD SHEET NUMBER			
																	(LB / FT)				(LB / FT)											
JAMAICA VT 100							FY-FLUORESCENT YELLOW FYG-FLUORESCENT YELLOW GREEN															"SHS"-STANDARD HIGHWAY SIGNS										
NB	3.057	A	W7-1B	30	30		HILL SYMBOL w/ 6% GRADE					1		X																		
NB	3.104	A	N/A				(TWO POSTS w/ DUAL FLASHING BEAGONS)							X																		
NB	3.140	A	W3-5	36	36									2		X																
NB	3.138	A	R2-5A	24	30		REDUCED SPEED AHEAD					1		X																		
NB	3.220	A	S3-1	30	30		SCHOOL BUS STOP AHEAD					1		X																		
		A	W2-3Ma L	30	30									2		X																
		A	W16-8	30	8		Old Route 8																									
NB	3.225	A	VD-062B	72	16		BUSINESS SIGN			1				X																		
NB	3.265	A	R2-1	24	30							1		X																		
		A	R2-1	30	36									1		X																
NB	3.329	C	VR-017	24	30		LEGAL LOAD LIMIT 24,000 LBS			1				X																		
NB	3.337	D	R1-1	30	30		STOP OLD ROUTE 8 J-56					2		X																		
NB	3.387	C	VR-017	24	30		LEGAL LOAD LIMIT 24,000 LBS			1				X																		
NB	3.395	D	R1-1	30	30		STOP EATON RD J-43 1000 1309 0340					2		X																		
NB	3.463	A	M2-1	21	15		JCT			1				X																		
SIGN SUMMARY SHEET							SHEET TOTALS	24.42	0.00	8	0	0	4	0	0	5	60															
VERMONT AGENCY OF TRANSPORTATION							TOWN TOTALS	391.9	0.0	33.0	4.0	4.0	69	0.0	0.0	66	990.0															
PROJECT NAME: Stamford-Andover VT100																					PROJECT NUMBER: STPG SIGN(20)											
FILE NAME: Jamaica.xls												PLOT DATE: 8/6/2009																				
PROJECT MANAGER: N. Avery												DRAWN BY: T. Guazzoni																				
DESIGNED BY: M. Miller												CHECKED BY: T. Guazzoni																				
JAMAICA SHEET 3												SHEET 139 OF 198																				





DIRECTION	MILEPOINT	LOCATION CODE (SHEET 2)	SIGN CODE	WIDTH (IN)	HEIGHT (IN)	SHEETING REMARKS	SIGN LEGEND	NEW SIGNS		EXISTING SIGNS				EXIST POST		NUMBER OF NEW POSTS	SQUARE STEEL (IN)			TUBULAR STEEL Ø (IN)				SIGN FRAME REQUIRED	REMARKS	SIGN DETAIL			
								"A"	"B"	RETAIN	SALVAGE FROM	SALVAGE TO	REMOVE	RETAIN	REMOVE		1.75	2.00	2.50	FOUNDATION	3.00	3.50	4.00			5.00	DETAIL IN SHS	DETAIL ON SHEET NUMBER	DETAIL ON STD SHEET NUMBER
																	(LB / FT)				(LB / FT)								
JAMAICA VT 100							FY-FLUORESCENT YELLOW FYG-FLUORESCENT YELLOW GREEN															"SHS"-STANDARD HIGHWAY SIGNS							
		A	M1-5	24	24		VERMONT 30			1																			
NB	3.482	A	W3-1	36	36		STOP AHEAD SYMBOL			1																			
NB	3.503	A	D1-1A	72	10		<--- JAMAICA 3			1																			
		A	D1-1	72	10		<--- STRATTON MTN SKI AREA 10			1																			
		A	D1-1A	72	10		TOWNSEND 6 --->			1																			
		A	D1-1A	72	10		BRATTLEBORO 23 --->			1																			
NB	3.538	A	M3-1S	24	12		NORTH			1																			
		A	M1-5	24	24		VERMONT 30			1																			
		A	M6-1S	21	15		<--- LEFT			1																			
		A	M3-1S	24	12		NORTH			1																			
		A	M1-5	30	24		VERMONT 100			1																			
		A	M6-1S	21	15		<--- LEFT			1																			
		A	M3-3S	24	12		SOUTH			1																			
		A	M1-5	24	24		VERMONT 30			1																			
		A	M6-1S	21	15		RIGHT --->			1																			
SIGN SUMMARY SHEET							SHEET TOTALS		0.00	0.00	15	0	0	0	0	0	0	0	0	0	0	0	0	0	PROJECT NAME: Stamford-Andover VT100				
									SF	SF	EA	EA	EA	EA	EA	EA	EA	EA	EA	EA	EA	EA	EA	EA	PROJECT NUMBER: STPG SIGN(20)				
VERMONT AGENCY OF TRANSPORTATION							TOWN TOTALS		391.9	0.0	33.0	4.0	4.0	69	0.0	0.0	66	0	990.0	0	FILE NAME: Jamaica.xls			PLOT DATE: 8/6/2009					
																									PROJECT MANAGER: N. Avery				
																									DRAWN BY: T. Guazzoni				
																									DESIGNED BY: M. Miller				
																									CHECKED BY: T. Guazzoni				
																									SHEET 140 OF 198				








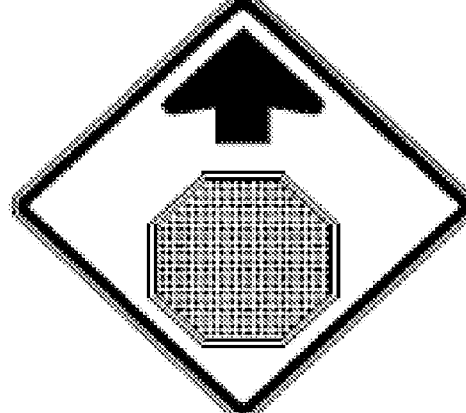
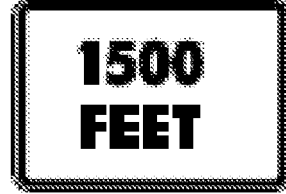
DIRECTION	MILEPOINT	LOCATION CODE (SHEET 2)	SIGN CODE	WIDTH (IN)	HEIGHT (IN)	SHEETING REMARKS	SIGN LEGEND	NEW SIGNS		EXISTING SIGNS			EXIST POST		NUMBER OF NEW POSTS	SQUARE STEEL (IN)			TUBULAR STEEL Ø (IN)				SIGN FRAME REQUIRED	REMARKS	SIGN DETAIL				
								"A"	"B"	RETAIN	SALVAGE FROM	SALVAGE TO	REMOVE	RETAIN		REMOVE	1.75	2.00	2.50	FOUNDATION	3.00	3.50			4.00	5.00	DETAIL IN SHS	DETAIL ON SHEET NUMBER	DETAIL ON STD SHEET NUMBER
																	(LB / FT)				(LB / FT)								
JAMAICA VT 100							FY-FLUORESCENT YELLOW FYG-FLUORESCENT YELLOW GREEN															"SHS"-STANDARD HIGHWAY SIGNS							
NB	3.570	A	R1-1	30	30						1		X										SALVAGE 2 MM ONTO NEW POSTS BACK-TO-BACK	X					
		A	R1-1	36	36			9.00						2	X														
VT 100 TURNS TO VT 30 FOR 8.146 MILES BEFORE RESUMING																													
SB	3.565	F	M3-3	24	12		SOUTH			1			X																
		F	M1-5	30	24		VERMONT 100			1																			
SB	3.545	F	R2-1	24	30						1		X																
		F	R2-1	24	30			5.00						1	X									X					
SB	3.520	F	D2-1	72	10		WARDSBORO 5			1			X																
		F	D2-1	72	10		WILMINGTON 24			1																			
SB	3.480	F	W2-1	30	30		CROSSROAD SYMBOL			1			X																
		F	W13-1	18	18		25 MPH (PLAQUE)				1																		
SB	3.407	G	VR-017	24	30		LEGAL LOAD LIMIT 24,000 LBS			1			X																
SB	3.399	H	R1-1	30	30		STOP 			1			X																
SB	3.275	F	R2-1	24	30		SPEED LIMIT 50 			1			X																
SB	2.520	F	W1-2L	30	30		-	6.25						1	X									X					
SIGN SUMMARY SHEET							SHEET TOTALS	20.25	0.00	8	0	0	3	0	0	4	60												
VERMONT AGENCY OF TRANSPORTATION							TOWN TOTALS	391.9	0.0	33.0	4.0	4.0	69	0.0	0.0	66	990.0												
PROJECT NAME: Stamford-Andover VT100																					PROJECT NUMBER: STPG SIGN(20)								
FILE NAME: Jamaica.xls												PLOT DATE: 8/6/2009																	
PROJECT MANAGER: N. Avery												DRAWN BY: T. Guazzoni																	
DESIGNED BY: M. Miller												CHECKED BY: T. Guazzoni																	
JAMAICA SHEET 5												SHEET 141 OF 198																	

DIRECTION	MILEPOINT	LOCATION CODE (SHEET 2)	SIGN CODE	WIDTH (IN)	HEIGHT (IN)	SHEETING REMARKS	SIGN LEGEND	NEW SIGNS		EXISTING SIGNS			EXIST POST		NUMBER OF NEW POSTS	SQUARE STEEL (IN)			TUBULAR STEEL Ø (IN)				SIGN FRAME REQUIRED	REMARKS	SIGN DETAIL				
								"A"	"B"	RETAIN	SALVAGE FROM	SALVAGE TO	REMOVE	RETAIN		REMOVE	1.75	2.00	2.50	FOUNDATION	3.00	3.50			4.00	5.00	DETAIL IN SHS	DETAIL ON SHEET NUMBER	DETAIL ON STD SHEET NUMBER
																	(LB / FT)				(LB / FT)								
JAMAICA VT 100							FY-FLUORESCENT YELLOW FYG-FLUORESCENT YELLOW GREEN															"SHS"-STANDARD HIGHWAY SIGNS							
SB	2.334	G	VR-017	24	30						1		X										HENDERSON RD ^{J-42B} (TH-42)			E-141			
		G	VR-017	24	30			5.00						1		X													
SB	2.326	H	R1-1	30	30		^{HENDERSON RD J-42B} 				1		X										HENDERSON RD ^{J-42B} (TH-42)						
		H	R1-1	30	30			6.25		I	I			1		X							^{SALVAGE STREET SIGN ONTO NEW POST}	X					
SB	2.305	F	VW-054	30	30		HIDDEN DRIVE RIGHT				1		X																
SB	2.285	F	OM-3R	12	36						1		X																
		F	OM-3R	12	36			3.00						1		X								X					
SB	2.250	E	OM-3L	12	36						1		X																
		E	OM-3L	12	36			3.00						1		X								X					
SB	2.230	F	VW-054R	30	30	FY		6.25						1		X							INSTALL 10 FT IN ADVANCE OF POLE, 100 FT ± BEYOND THE OBJECT MARKER JUST REPLACED.			E-154			
SB	1.940	F	W1-2L	30	30		CURVE LEFT				1		X																
		F	W13-1	18	18		35 MPH (PLAQUE)				1																		
SB	1.900	F	W1-2L	30	30	FY		6.25						1		X							INSTALL 210 FT ± SOUTH OF PREVIOUS POSITION.	X					
		F	W13-1	18	18	FY		2.25																X					
SB	1.835	F	W1-6	48	24	FY		8.00						2		X							INSTALL 80 FT ± NORTH OF THE EXISTING LEFT ARROW AT M.P. 1.820.	X					
SIGN SUMMARY SHEET							SHEET TOTALS	40.00	0.00	0	0	0	7	0	0	8	120							PROJECT NAME: Stamford-Andover VT100					
VERMONT AGENCY OF TRANSPORTATION							TOWN TOTALS	391.9	0.0	33.0	4.0	4.0	69	0.0	0.0	66	990.0							PROJECT NUMBER: STPG SIGN(20)	FILE NAME: Jamaica.xls	PLOT DATE: 8/6/2009			
								SF	SF	EA	EA	EA	EA	EA	EA	EA	FT							DESIGNED BY: M. Miller	DRAWN BY: T. Guazzoni	CHECKED BY: T. Guazzoni			
																								JAMAICA SHEET 6	SHEET 142 OF 198				




DIRECTION	MILEPOINT	LOCATION CODE (SHEET 2)	SIGN CODE	WIDTH (IN)	HEIGHT (IN)	SHEETING REMARKS	SIGN LEGEND	NEW SIGNS		EXISTING SIGNS			EXIST POST		NUMBER OF NEW POSTS	SQUARE STEEL (IN)			TUBULAR STEEL Ø (IN)				SIGN FRAME REQUIRED	REMARKS	SIGN DETAIL				
								"A"	"B"	RETAIN	SALVAGE FROM	SALVAGE TO	REMOVE	RETAIN		REMOVE	1.75	2.00	2.50	FOUNDATION	3.00	3.50			4.00	5.00	DETAIL IN SHS	DETAIL ON SHEET NUMBER	DETAIL ON STD SHEET NUMBER
																	(LB / FT)				(LB / FT)								
JAMAICA VT 100							FY-FLUORESCENT YELLOW FYG-FLUORESCENT YELLOW GREEN															"SHS"-STANDARD HIGHWAY SIGNS							
SB	1.834	E	W1-6	48	24	FY		8.00									X						INSTALL 5 FT ± SOUTH OF THE SB-FACING ARROW. THIS ARROW FACES NB TRAFFIC, IN THE SB LANE. FY SHEETING.	X					
SB	1.820	F	W1-6	48	24		<=== LARGE ARROW				1																		
SB	1.801	F	W1-6	48	24	FY	 1000 1309 0180	8.00									X					SALVAGE MM ONTO NEW POST	INSTALL 5 FT ± NORTH OF THE EXISTING RIGHT ARROW AT M.P. 1.800.	X					
SB	1.800	E	W1-6	48	24						1																		
		E	W1-6	48	24	FY		8.00									X						FACES NB TRAFFIC	X					
SB	1.382	F	W1-2R	30	30						1																		
		F	W1-2R	30	30	FY		6.25									X						ASSURE 10 FT MIN TO UTILITY POLE.	X					
SB	1.233	F	W1-4L	30	30		LEFT REVERSE CURVE 				1																		
		F	W1-3L	30	30	FY		6.25									X												
		F	W13-1	18	18	FY		2.25																					
<u>NEW SIGN SEE SHEET I49</u>																													
SB	0.727	F	W1-1RL	30	30		LEFT TURN 				1																		
		F	W13-1	18	18		25 MPH (PLAQUE) 				1																		
SB	0.680	F	W1-1RL	30	30	FY		6.25									X						INSTALL 250 FT ± SOUTH OF PREVIOUS POSITION.	X					
		F	W13-1	18	18	FY		2.25																					
SB	0.604	F	W1-6	48	24						1																		
SIGN SUMMARY SHEET							SHEET TOTALS	47.25	0.00	0	0	0	7	0	0	9	135							PROJECT NAME: Stamford-Andover VT100					
VERMONT AGENCY OF TRANSPORTATION							TOWN TOTALS	391.9	0.0	33.0	4.0	4.0	69	0.0	0.0	66	990.0							PROJECT NUMBER: STPG SIGN(20)					
								SF	SF	EA	EA	EA	EA	EA	EA	EA	FT						FILE NAME: Jamaica.xls						
																							PLOT DATE: 8/6/2009						
																							PROJECT MANAGER: N. Avery						
																							DRAWN BY: T. Guazzoni						
																							DESIGNED BY: M. Miller						
																							JAMAICA SHEET 7						
																							CHECKED BY: T. Guazzoni						
																								SHEET 143 OF 198					




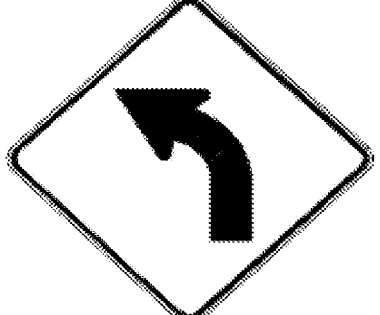



DIRECTION	MILEPOINT	LOCATION CODE (SHEET 2)	SIGN CODE	WIDTH (IN)	HEIGHT (IN)	SHEETING REMARKS	SIGN LEGEND	NEW SIGNS		EXISTING SIGNS			EXIST POST		NUMBER OF NEW POSTS	SQUARE STEEL (IN)			TUBULAR STEEL Ø (IN)				SIGN FRAME REQUIRED	REMARKS	SIGN DETAIL				
								"A"	"B"	RETAIN	SALVAGE FROM	SALVAGE TO	REMOVE	RETAIN		REMOVE	1.75	2.00	2.50	FOUNDATION	3.00	3.50			4.00	5.00	DETAIL IN SHS	DETAIL ON SHEET NUMBER	DETAIL ON STD SHEET NUMBER
																	(LB / FT)				(LB / FT)								
JAMAICA VT 100							FY-FLUORESCENT YELLOW FYG-FLUORESCENT YELLOW GREEN															"SHS"-STANDARD HIGHWAY SIGNS							
			F W1-6	48	24	FY		8.00						2		X									X				
SB	0.603		E W1-6	48	24						MISSING																		
			E W1-6	48	24	FY		8.00						2		X									X				
SB	0.587		F W1-6	48	24								1			X													
			F W1-6	48	24	FY		8.00																	X				
SB	0.586		E W1-6	48	24								1			X													
			E W1-6	48	24	FY		8.00						2		X									X				
SB	0.325		F VW-060	30	30																								
			F VW-060	30	30	FY		6.25						1		X										E-154			
SB	0.032		F W3-5	36	36		SPEED REDUCTION 40 MPH AHEAD			1						X													
VT 100 RESUMES																													
NB	3.600		B R1-1	30	30		STOP						1			X													
																													
NB	3.630		A M3-1S	24	12								1			X													
			A M1-5	30	24																								
			A M3-1	24	12			2.00						1		X													
SIGN SUMMARY SHEET							SHEET TOTALS	40.25	0.00	1	0	0	6	0	0	8	120												
VERMONT AGENCY OF TRANSPORTATION							TOWN TOTALS	391.9	0.0	33.0	4.0	4.0	69	0.0	0.0	66	990.0												
															PROJECT NAME:	Stamford-Andover VT100													
															PROJECT NUMBER:	STPG SIGN(20)													
															FILE NAME:	Jamaica.xls					PLOT DATE:	8/6/2009							
															PROJECT MANAGER:	N. Avery					DRAWN BY:	T. Guazzoni							
															DESIGNED BY:	M. Miller					CHECKED BY:	T. Guazzoni							
															JAMAICA SHEET	8					SHEET	144 OF 198							





DIRECTION	MILEPOINT	LOCATION CODE (SHEET 2)	SIGN CODE	WIDTH (IN)	HEIGHT (IN)	SHEETING REMARKS	SIGN LEGEND	NEW SIGNS		EXISTING SIGNS			EXIST POST		NUMBER OF NEW POSTS	SQUARE STEEL (IN)			TUBULAR STEEL Ø (IN)				SIGN FRAME REQUIRED	REMARKS	SIGN DETAIL				
								"A"	"B"	RETAIN	SALVAGE FROM	SALVAGE TO	REMOVE	RETAIN		REMOVE	1.75	2.00	2.50	3.00	3.50	4.00			5.00	DETAIL IN SHS	DETAIL ON SHEET NUMBER	DETAIL ON STD SHEET NUMBER	
																	(LB / FT)			(LB / FT)									
JAMAICA VT 100							FY-FLUORESCENT YELLOW FYG-FLUORESCENT YELLOW GREEN															"SHS"-STANDARD HIGHWAY SIGNS							
			A M1-5	30	24			5.00																			E-136B		
NB	3.663		A W1-4R	30	30		REVERSE CURVE RIGHT					1		X															
NB	3.687		A VD-062B	72	16		BUSINESS SIGN			1				X															
NB	3.735		A S3-1	30	30							1		X															
			A S3-1	30	30			6.25							1	X								X					
NB	3.813		A VS3-4A	30	30		SCHOOL BUS TURN AROUND AHEAD			-1	-1			X													SIGN PREVIOUSLY MOVED TO MM NB IN JAMAICA 2.140 RT.		
NB	3.935		A R2-1	24	30			5.00							1	X									X		INSTALL BEHIND RAIL 25 FT ± IN ADVANCE OF THE EXISTING SIGN, TO BE REMOVED.		
NB	3.940		A R2-1	24	30		SPEED LIMIT 50					1		X															
NB	4.300		A W1-2L	30	30		CURVE LEFT					1		X															
NB	4.345		A VW-054	30	30		HIDDEN DRIVE LEFT					1		X															
			A W1-2L	30	30			6.25							1	X								X					
NB	4.375		A VW-054	30	30	FY		6.25							1	X											INSTALL 160 FT ± NORTH OF THE PREVIOUS LOCATION.		
NB	4.490		A W11-7	30	30		EQUESTRIAN SYMBOL					1		X															
SB	4.255		F W1-4R	30	30		REVERSE CURVE RIGHT w/ MINOR SIDE RD RIGHT					1		X															
			F W13-1	18	18		45 MPH (PLAQUE) 					1																	
SIGN SUMMARY SHEET							SHEET TOTALS	28.75	0.00	1	0	0	8	0	0	5	75												
VERMONT AGENCY OF TRANSPORTATION							TOWN TOTALS	391.9	0.0	33.0	4.0	4.0	69	0.0	0.0	66	990.0												
																						PROJECT NAME:	Stamford-Andover VT100						
																						PROJECT NUMBER:	STPG SIGN(20)						
											FILE NAME:	Jamaica.xls					PLOT DATE:	8/6/2009											
											PROJECT MANAGER:	N. Avery					DRAWN BY:	T. Guazzoni											
											DESIGNED BY:	M. Miller					CHECKED BY:	T. Guazzoni											
											JAMAICA SHEET	9					SHEET	145 OF 198											


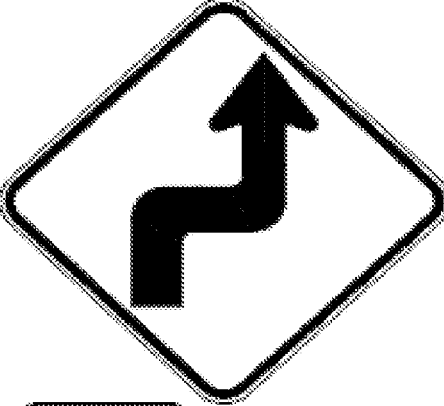


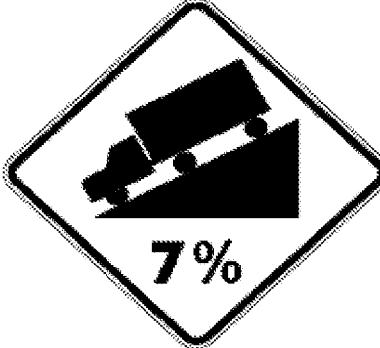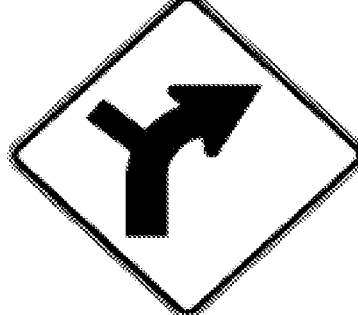

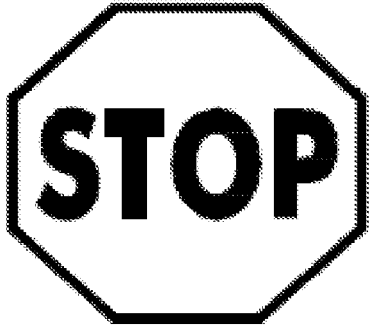

DIRECTION	MILEPOINT	LOCATION CODE (SHEET 2)	SIGN CODE	WIDTH (IN)	HEIGHT (IN)	SHEETING REMARKS	SIGN LEGEND	NEW SIGNS		EXISTING SIGNS			EXIST POST		NUMBER OF NEW POSTS	SQUARE STEEL (IN)			TUBULAR STEEL Ø (IN)				SIGN FRAME REQUIRED	REMARKS	SIGN DETAIL				
								"A"	"B"	RETAIN	SALVAGE FROM	SALVAGE TO	REMOVE	RETAIN		REMOVE	1.75	2.00	2.50	FOUNDATION	3.00	3.50			4.00	5.00	DETAIL IN SHS	DETAIL ON SHEET NUMBER	DETAIL ON STD SHEET NUMBER
																	(LB / FT)				(LB / FT)								
JAMAICA VT 100							FY-FLUORESCENT YELLOW FYG-FLUORESCENT YELLOW GREEN															"SHS"-STANDARD HIGHWAY SIGNS							
SB	4.072	F	S3-1	30	30						1																		
		F	S3-1	30	30			6.25															X						
SB	4.007	F	VS3-4A	30	30		SCHOOL BUS TURN AROUND AHEAD			+	+														NO WORK DONE - SIGN PREVIOUSLY MOVED TO MM SB IN JAMAICA 2.330 RT				
SB	3.896	G	VR-017	24	30		 COLEMAN HILLS RD				1														MILL BROOK RD (TH-62)				
		G	VR-017	24	30		  MILL BROOK RD	5.00																	E-141				
SB	3.890	H	R1-1	30	30						1														MILL BROOK RD (TH-62)				
		H	R1-1	30	30			6.25															X						
SB	3.888	G	VR-017	24	30						1														COLEMAN HILLS RD (TH-6)				
		G	VR-017	24	30			5.00																	E-141				
SB	3.882	H	R1-1	30	30						1														COLEMAN HILLS RD (TH-6)				
		H	R1-1	30	30			6.25															X						
SB	3.880	F	W3-1	36	36						1																		
		F	W16-2	24	18						1																		
		F	W3-1	36	36			9.00															X						
		F	W16-2	24	18			3.00															X		INSTALL PLAQUE ON LEFT-SIDE POST				
SIGN SUMMARY SHEET							SHEET TOTALS	40.75	0.00	0	+	+	7	0	0	7	120						PROJECT NAME: Stamford-Andover VT100						
VERMONT AGENCY OF TRANSPORTATION							TOWN TOTALS	391.9	0.0	33.0	4.0	4.0	69	0.0	0.0	66	990.0						PROJECT NUMBER: STPG SIGN(20)						
								SF	SF	EA	EA	EA	EA	EA	EA	EA	FT						FILE NAME: Jamaica.xls						
																						PLOT DATE: 8/6/2009							
																						PROJECT MANAGER: N. Avery							
																						DRAWN BY: T. Guazzoni							
																						DESIGNED BY: M. Miller							
																						JAMAICA SHEET 10							
																						CHECKED BY: T. Guazzoni							
																						SHEET 146 OF 198							


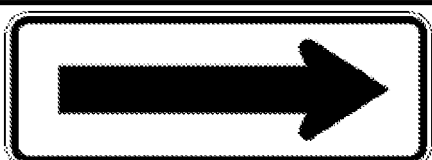
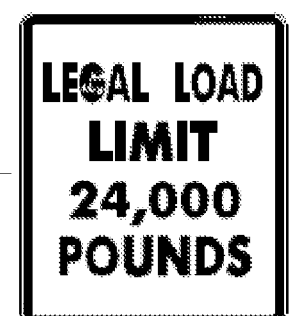

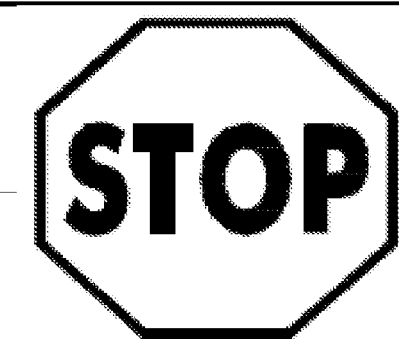
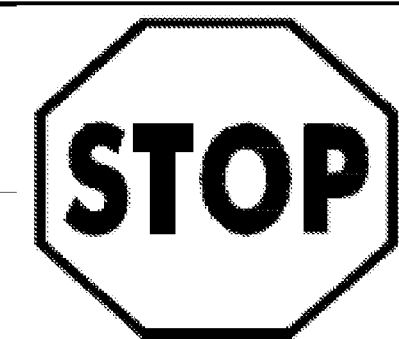


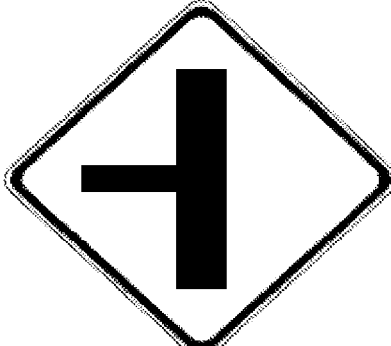DIRECTION	MILEPOINT	LOCATION CODE (SHEET 2)	SIGN CODE	WIDTH (IN)	HEIGHT (IN)	SHEETING REMARKS	SIGN LEGEND	NEW SIGNS		EXISTING SIGNS				EXIST POST		NUMBER OF NEW POSTS	SQUARE STEEL (IN)			TUBULAR STEEL Ø (IN)				SIGN FRAME REQUIRED	REMARKS	SIGN DETAIL				
								"A"	"B"	RETAIN	SALVAGE FROM	SALVAGE TO	REMOVE	RETAIN	REMOVE		1.75	2.00	2.50	3.00	3.50	4.00	5.00			DETAIL IN SHS	DETAIL ON SHEET NUMBER	DETAIL ON STD SHEET NUMBER		
																	(LB / FT)			(LB / FT)										
																	1.88	2.42	3.35	FOUNDATION	7.60	9.00	10.80						14.60	
JAMAICA VT 100							FY-FLUORESCENT YELLOW FYG-FLUORESCENT YELLOW GREEN															"SHS"-STANDARD HIGHWAY SIGNS								
SB	3.845	F	VD-062B	72	16		BUSINESS SIGN			1					X															
SB	3.770	F	W3-1	36	36																									
		F	W3-1	36	36			9.00							2		X										X			
SB	3.732	F	M2-1	21	15																									
		F	M1-5	24	24																									
		F	M2-1	21	15			2.19																						
		F	M1-5	24	24			4.00																						E-136B
SB	3.695	F	D1-1A	72	10																									
		F	D1-1A	72	10																									
		F	D1-1S	72	10																									
		F	D1-1A	72	10																									
		F	D1-1A	72	12			6.00																						5
		F	D1-1A	72	12			6.00																						5
		F	D1-1	72	12			6.00																						5
		F	D1-1A	72	12			6.00																						5
SIGN SUMMARY SHEET							SHEET TOTALS		39.19	0.00	1	0	0	7	0	0	5	75				PROJECT NAME: Stamford-Andover VT100								
VERMONT AGENCY OF TRANSPORTATION							SF	SF										EA	EA		PROJECT NUMBER: STPG SIGN(20)									
							TOWN TOTALS		391.9	0.0	33.0	4.0	4.0	69	0.0	0.0	66	990.0				FILE NAME: Jamaica.xls								
																						PLOT DATE: 8/6/2009								
																						DRAWN BY: T. Guazzoni								
																						DESIGNED BY: M. Miller								
																						CHECKED BY: T. Guazzoni								
																						SHEET 147 OF 198								




DIRECTION	MILEPOINT	LOCATION CODE (SHEET 2)	SIGN CODE	WIDTH (IN)	HEIGHT (IN)	SHEETING REMARKS	SIGN LEGEND	NEW SIGNS		EXISTING SIGNS			EXIST POST		NUMBER OF NEW POSTS	SQUARE STEEL (IN)			TUBULAR STEEL Ø (IN)				SIGN FRAME REQUIRED	REMARKS	SIGN DETAIL				
								"A"	"B"	RETAIN	SALVAGE FROM	SALVAGE TO	REMOVE	RETAIN		REMOVE	1.75	2.00	2.50	FOUNDATION	3.00	3.50			4.00	5.00	DETAIL IN SHS	DETAIL ON SHEET NUMBER	DETAIL ON STD SHEET NUMBER
																	(LB / FT)				(LB / FT)								
JAMAICA VT 100							FY-FLUORESCENT YELLOW FYG-FLUORESCENT YELLOW GREEN															"SHS"-STANDARD HIGHWAY SIGNS							
			F M3-1	24	12			2.00															GREEN ON WHITE SHEETING	X					
			F M1-5	24	24			4.00																	E-136B				
			F M6-1R	21	15			2.19															GREEN ON WHITE SHEETING	X					
SB	3.600		F R1-1	30	30							1	X																
			F R1-1	36	36			9.00						2	X										X				
SB	1.182		F WI-6	48	24			8.00						2	X								NEW SIGN ADDED TO PLANS PER REQUEST OF M. MILLER, TRAFFIC OPS.						
NB	0.300		F VW-619	36	36					X			X										SIGN RETAINED						
SIGN SUMMARY SHEET							SHEET TOTALS	25.19 47.19	0.00	0	0	0	1	0	0	4 2	30							PROJECT NAME: Stamford-Andover VT100					
VERMONT AGENCY OF TRANSPORTATION							TOWN TOTALS	391.9	0.0	33.0	4.0	4.0	69	0.0	0.0	66	990.0							PROJECT NUMBER: STPG SIGN(20)					
																							FILE NAME: Jamaica.xls						
																								PLOT DATE: 8/6/2009					
																								PROJECT MANAGER: N. Avery					
																								DRAWN BY: T. Guazzoni					
																								DESIGNED BY: M. Miller					
																									CHECKED BY: T. Guazzoni				
																									JAMAICA SHEET 13				
																									SHEET 149 OF 198				



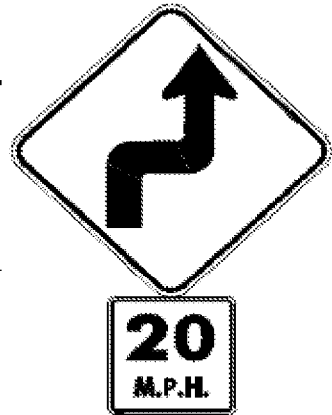




DIRECTION	MILEPOINT	LOCATION CODE (SHEET 2)	SIGN CODE	WIDTH (IN)	HEIGHT (IN)	SHEETING REMARKS	SIGN LEGEND	NEW SIGNS		EXISTING SIGNS			EXIST POST		NUMBER OF NEW POSTS	SQUARE STEEL (IN)			TUBULAR STEEL Ø (IN)				SIGN FRAME REQUIRED	REMARKS	SIGN DETAIL			
								"A"	"B"	RETAIN	SALVAGE FROM	SALVAGE TO	REMOVE	RETAIN		REMOVE	1.75	2.00	2.50	3.00	3.50	4.00			5.00	DETAIL IN SHS	DETAIL ON SHEET NUMBER	DETAIL ON STD SHEET NUMBER
																	(LB / FT)			(LB / FT)								
LONDONDERRY VT 100							FY-FLUORESCENT YELLOW FYG-FLUORESCENT YELLOW GREEN															"SHS"-STANDARD HIGHWAY SIGNS						
NB	0.477	A	W7-1	30	30		HILL SYMBOL																					
		A	W7-1b	30	30			6.25						1			X							X				
NB	0.812	A	W1-10R	30	30		RIGHT CURVE WITH LH SIDE ROAD																					
		A	W16-8	24	12		SPRING HILL RD																					
NB	0.900	A	W1-10R	30	30			6.25																				
		A	W16-8	30	8			1.67																	8			
NB	1.010	A	W1-2L	30	30		LEFT CURVE																					
		A	W1-2L	30	30			6.25																				
NB	1.320	A	VD-062AS	72	16		BUSINESS SIGN			1																		
NB	1.392	C	VR-017	24	30																							
		C	VR-017	24	30			5.00																	E-141			
NB	1.397	D	R1-1	30	30																							
		D	R1-1	30	30			6.25																				
NB	1.730	A	W2-1L	30	30		LEFT/RIGHT SEPARATED SIDE ROADS																					
SIGN SUMMARY SHEET							SHEET TOTALS	31.67	0.00	1	0	0	7	0	0	5	75					PROJECT NAME: Stamford-Andover VT100						
VERMONT AGENCY OF TRANSPORTATION							TOWN TOTALS	729.7	0.0	22.0	4.0	4.0	151	0.0	0.0	118	1770.0					PROJECT NUMBER: STPG SIGN(20)						
								SF	SF	EA	EA	EA	EA	EA	EA	EA	FT					FILE NAME: Londonderrv.xls	PLOT DATE: 8/6/2009					
																					PROJECT MANAGER: N. Avery	DRAWN BY: T. Guazzoni						
																					DESIGNED BY: J. Kelly	CHECKED BY: T. Guazzoni						
																					LONDONDERRY SHEET 1	SHEET 150 OF 198						

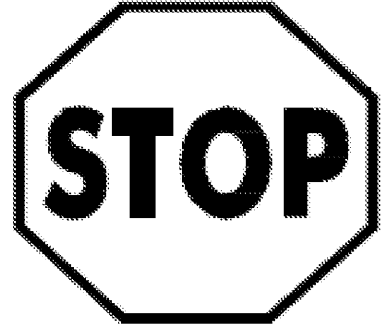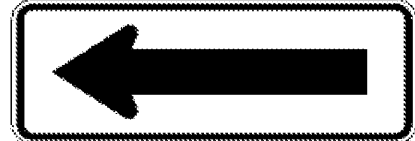



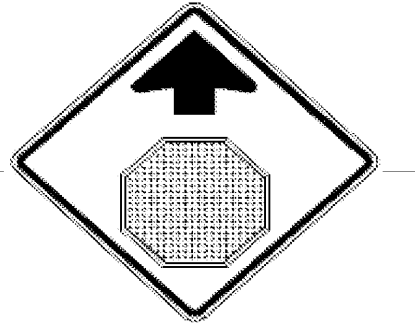
DIRECTION	MILEPOINT	LOCATION CODE (SHEET 2)	SIGN CODE	WIDTH (IN)	HEIGHT (IN)	SHEETING REMARKS	SIGN LEGEND	NEW SIGNS		EXISTING SIGNS			EXIST POST		NUMBER OF NEW POSTS	SQUARE STEEL (IN)			TUBULAR STEEL Ø (IN)				SIGN FRAME REQUIRED	REMARKS	SIGN DETAIL			
								"A"	"B"	RETAIN	SALVAGE FROM	SALVAGE TO	REMOVE	RETAIN		REMOVE	1.75	2.00	2.50	3.00	3.50	4.00			5.00	DETAIL IN SHS	DETAIL ON SHEET NUMBER	DETAIL ON STD SHEET NUMBER
																	(LB / FT)			(LB / FT)								
LONDONDERRY VT 100							FY-FLUORESCENT YELLOW FYG-FLUORESCENT YELLOW GREEN															"SHS"-STANDARD HIGHWAY SIGNS						
NB	1.750	A	W2-2MaL	30	30		 Glebe View Ln	6.25							1	X							INSTALL 400 FEET SOUTH OF INTERSECTION		6			
		A	W16-8	30	8			1.67																	8			
NB	2.070	A	W7-1	30	30						1																	
		A	W7-1b	30	30			6.25							1	X								X				
NB	2.155	A	VD-062AS	72	16		BUSINESS SIGN			1																		
		A	VD-062B	72	16			BUSINESS SIGN			1																	
		A	VD-062AS	72	16			BUSINESS SIGN			1																	
NB	2.454	C	VR-017	24	30						1												TH-49, WINDY RISE LANE EAST					
		C	VR-017	24	30			5.00							1	X										E-141		
NB	2.459	D	R1-1	30	30		 1000 1310 0247				1												TH-49, WINDY RISE LANE EAST		X			
		D	R1-1	30	30			6.25							1	X												
NB	2.657	A	W1-3R	48	48		RIGHT REVERSE TURN				1																	
		A	W16-2	24	18			1400 FEET				1																
NB	2.690	A	W3-5	36	36		SPEED REDUCTION (30)			1													SEE SEPARATE ENVELOPE FOR SIGN CHANGES IN THIS TOWN					
NB	2.755	A	VD-018	30	18						1																	
SIGN SUMMARY SHEET							SHEET TOTALS	25.42	0.00	4	0	0	6	0	0	4	60						PROJECT NAME: Stamford-Andover VT100					
								SF	SF	EA	EA	EA	EA	EA	EA	EA	FT						PROJECT NUMBER: STPG SIGN(20)					
VERMONT AGENCY OF TRANSPORTATION							TOWN TOTALS	729.7	0.0	22.0	4.0	4.0	151	0.0	0.0	118	1770.0						FILE NAME: Londonderrv.xls	PLOT DATE: 8/6/2009				
																						PROJECT MANAGER: N. Avery	DRAWN BY: T. Guazzoni					
																						DESIGNED BY: J. Kelly	CHECKED BY: T. Guazzoni					
																						LONDONDERRY SHEET 2	SHEET 151 OF 198					


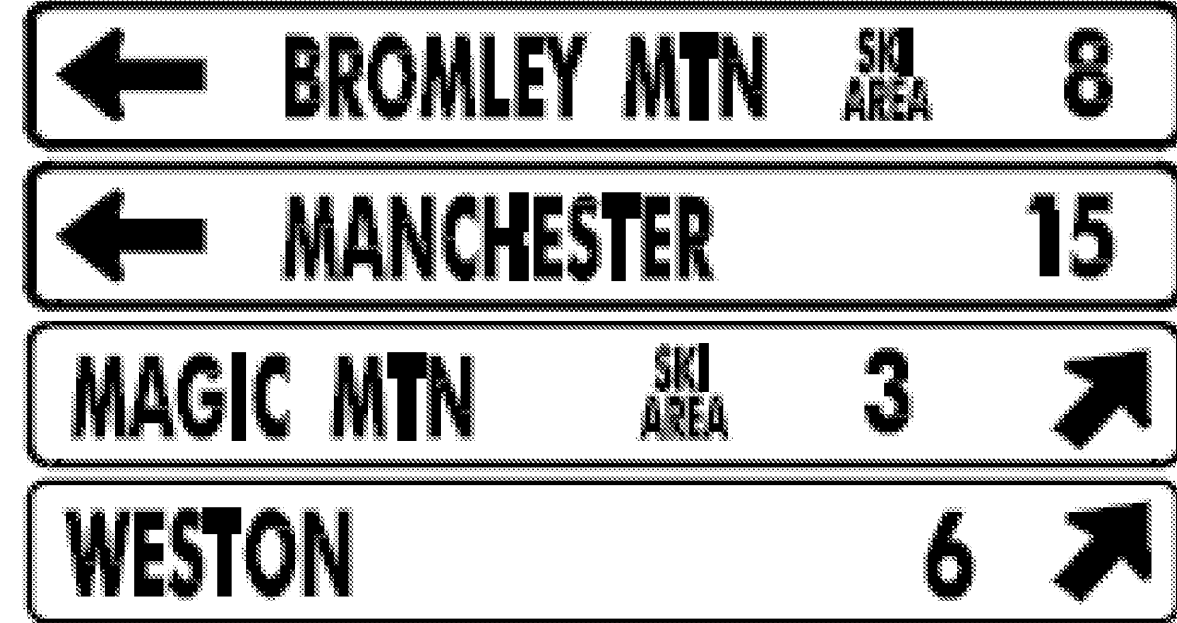
DIRECTION	MILEPOINT	LOCATION CODE (SHEET 2)	SIGN CODE	WIDTH (IN)	HEIGHT (IN)	SHEETING REMARKS	SIGN LEGEND	NEW SIGNS		EXISTING SIGNS			EXIST POST		NUMBER OF NEW POSTS	SQUARE STEEL (IN)			TUBULAR STEEL Ø (IN)				SIGN FRAME REQUIRED	REMARKS	SIGN DETAIL			
								"A"	"B"	RETAIN	SALVAGE FROM	SALVAGE TO	REMOVE	RETAIN		REMOVE	1.75	2.00	2.50	3.00	3.50	4.00			5.00	DETAIL IN SHS	DETAIL ON SHEET NUMBER	DETAIL ON STD SHEET NUMBER
																	(LB / FT)			(LB / FT)								
LONDONDERRY VT 100							FY-FLUORESCENT YELLOW FYG-FLUORESCENT YELLOW GREEN															"SHS"-STANDARD HIGHWAY SIGNS						
		A	VD-018	30	18			3.75						1	X										E-128A			
NB	2.795	A	W1-3R	48	48		 20 MPH PLAQUE					1		X														
		A	W13-1	24	24							1																
		A	W1-3R	36	36	FY			9.00						2	X								X				
		A	W16-2	24	18	FY			3.00															X		INSTALL ON LEFT POST		
NB	2.890 2.846	A	R2-1	30 24	36 30		SPEED LIMIT 30																					
		A	R2-1	30	36																							
NB	2.875	A	R2-1	30	36			7.50						+	X													
		A	W1-3R	30	30	FY		6.25						1	X								X		INSTALL 80 FEET SOUTH OF END OF GUARDRAIL.			
		A	W13-1	18	18	FY		2.25															X					
		C	VR-017	24	30			5.00						1	X										TH-48, W RIVER ST			
NB	2.952	D	R1-1	30	30							1		X											TH-48, W RIVER ST			
		D	R1-1	30	30			6.25						1	X								X					
NB	2.953	A	D1-1A	72	10		<--- LONDONDERRY 3					1		X														
NB	2.983	A	M3-1S	24	12							1		X														
		A	M1-5	30	24							1																
SIGN SUMMARY SHEET							SHEET TOTALS	35.50 43.00	0.00	0	0	0	7	0	0	7	105											
VERMONT AGENCY OF TRANSPORTATION							TOWN TOTALS	729.7	0.0	22.0	4.0	4.0	151	0.0	0.0	118	1770.0											
															PROJECT NAME:	Stamford-Andover VT100												
															PROJECT NUMBER:	STPG SIGN(20)												
															FILE NAME:	Londonderrv.xls					PLOT DATE:	8/6/2009						
															PROJECT MANAGER:	N. Avery					DRAWN BY:	T. Guazzoni						
															DESIGNED BY:	J. Kelly					CHECKED BY:	T. Guazzoni						
															LONDONDERRY SHEET 3					SHEET	152		OF	198				

DIRECTION	MILEPOINT	LOCATION CODE (SHEET 2)	SIGN CODE	WIDTH (IN)	HEIGHT (IN)	SHEETING REMARKS	SIGN LEGEND	NEW SIGNS		EXISTING SIGNS			EXIST POST		NUMBER OF NEW POSTS	SQUARE STEEL (IN)			TUBULAR STEEL Ø (IN)				SIGN FRAME REQUIRED	REMARKS	SIGN DETAIL													
								"A"	"B"	RETAIN	SALVAGE FROM	SALVAGE TO	REMOVE	RETAIN		REMOVE	1.75	2.00	2.50	3.00	3.50	4.00			5.00	DETAIL IN SHS	DETAIL ON SHEET NUMBER	DETAIL ON STD SHEET NUMBER										
																	(LB / FT)			(LB / FT)																		
LONDONDERRY VT 100							FY-FLUORESCENT YELLOW FYG-FLUORESCENT YELLOW GREEN															"SHS"-STANDARD HIGHWAY SIGNS																
			A M6-1S	21	15							1																										
			A M3-1	24	12			2.00							1	X								GREEN ON WHITE SHEETING	X													
			A M1-5	30	24			5.00																		E-136B												
			A M6-1L	21	15			2.19																GREEN ON WHITE SHEETING	X													
			B M3-3S	24	12																			NORTH														
			B M1-5	30	24																			VERMONT 100														
			B M6-3S	21	15																			LEFT ARROW														
NB	2.983		C W1-6	48	24	FY																		8.00											INSTALL AT END OF BRIDGE RAIL	X		
NB	2.994		C VR-017	24	30																															TH-2, MAIN ST		
			C VR-017	24	30																				5.00											INSTALL 20+ FEET FROM VT-100		E-141
NB	2.996		D R1-1	30	30																															TH-2, MAIN ST		
			D R1-1	30	30																				6.25										X			
NB	2.999		C VR-017	24	30																															TH-5, MIDDLETOWN RD		
			C VR-017	24	30																				5.00													
			C																																REMOVE TOWN SIGN. RETURN TO TOWN			
SIGN SUMMARY SHEET							SHEET TOTALS	33.44	0.00	0	0	0	8	0	0	6	90								PROJECT NAME: Stamford-Andover VT100													
VERMONT AGENCY OF TRANSPORTATION							TOWN TOTALS	729.7	0.0	22.0	4.0	4.0	151	0.0	0.0	118	1770.0								PROJECT NUMBER: STPG SIGN(20)													
								SF	SF	EA	EA	EA	EA	EA	EA	EA	FT									FILE NAME: Londonderry.xls												
																										PROJECT MANAGER: N. Avery												
																										DESIGNED BY: J. Kelly												
																										CHECKED BY: T. Guazzoni												
																										LONDONDERRY SHEET 4												
																										PLOT DATE: 8/6/2009												
																										DRAWN BY: T. Guazzoni												
																										CHECKED BY: T. Guazzoni												
																										SHEET 153 OF 198												

DIRECTION	MILEPOINT	LOCATION CODE (SHEET 2)	SIGN CODE	WIDTH (IN)	HEIGHT (IN)	SHEETING REMARKS	SIGN LEGEND	NEW SIGNS		EXISTING SIGNS				EXIST POST		NUMBER OF NEW POSTS	SQUARE STEEL (IN)			TUBULAR STEEL Ø (IN)				SIGN FRAME REQUIRED	REMARKS	SIGN DETAIL		
								"A"	"B"	RETAIN	SALVAGE FROM	SALVAGE TO	REMOVE	RETAIN	REMOVE		1.75	2.00	2.50	3.00	3.50	4.00	5.00			DETAIL IN SHS	DETAIL ON SHEET NUMBER	DETAIL ON STD SHEET NUMBER
																	(LB / FT)			(LB / FT)								
LONDONDERRY VT 100							FY-FLUORESCENT YELLOW FYG-FLUORESCENT YELLOW GREEN															"SHS"-STANDARD HIGHWAY SIGNS						
NB	3.010	D	R1-1	30	30																							
		D	R1-1	30	30			6.25																	X			
NB	3.007	A	M3-3S	24	12		SOUTH																					
		A	M1-5	30	24		VERMONT 100																					
		A	M6-1S	21	15		<--- LEFT																					
		A	M3-1S	24	12		NORTH																					
		A	M1-5	30	24		VERMONT 100																					
		A	M6-3S	21	15		^UP ARROW																					
		A	M3-1S	24	12		NORTH																					
		A	M1-5	24	24		VERMONT 100																					
		A	M6-1S	21	15		<--- LEFT																					
		A	W1-6	48	24	FY		8.00																	X			
NB	3.012	A	W1-3R	30	30		RIGHT REVERSE TURN WITH SIDE ROAD																					
		A	W13-1	18	18		20 MPH PLAQUE																					
																												
NB	3.017	A	M3-1	24	12			2.00																	X			
SIGN SUMMARY SHEET							SHEET TOTALS	16.25	0.00	0	0	0	12	0	0	4	60				PROJECT NAME: Stamford-Andover VT100							
								SF	SF	EA	EA	EA	EA	EA	EA	EA	FT				PROJECT NUMBER: STPG SIGN(20)							
VERMONT AGENCY OF TRANSPORTATION							TOWN TOTALS	729.7	0.0	22.0	4.0	4.0	151	0.0	0.0	118	1770.0				FILE NAME: Londonderrv.xls	PLOT DATE: 8/6/2009						
																					PROJECT MANAGER: N. Avery	DRAWN BY: T. Guazzoni						
																					DESIGNED BY: J. Kelly	CHECKED BY: T. Guazzoni						
																					LONDONDERRY SHEET 5	SHEET 154 OF 198						



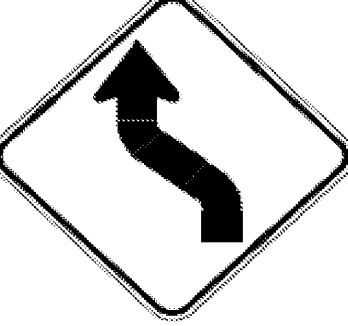




DIRECTION	MILEPOINT	LOCATION CODE (SHEET 2)	SIGN CODE	WIDTH (IN)	HEIGHT (IN)	SHEETING REMARKS	SIGN LEGEND	NEW SIGNS		EXISTING SIGNS			EXIST POST		NUMBER OF NEW POSTS	SQUARE STEEL (IN)			TUBULAR STEEL Ø (IN)				SIGN FRAME REQUIRED	REMARKS	SIGN DETAIL				
								"A"	"B"	RETAIN	SALVAGE FROM	SALVAGE TO	REMOVE	RETAIN		REMOVE	1.75	2.00	2.50	FOUNDATION	3.00	3.50			4.00	5.00	DETAIL IN SHS	DETAIL ON SHEET NUMBER	DETAIL ON STD SHEET NUMBER
																	(LB / FT)				(LB / FT)								
LONDONDERRY VT 100							FY-FLUORESCENT YELLOW FYG-FLUORESCENT YELLOW GREEN															"SHS"-STANDARD HIGHWAY SIGNS							
			A M1-5	30	24			5.00																		E-136B			
NB	3.080		C VR-017	24	24							1														TH-55, CRESCENT ST			
			C VR-017	24	30			5.00						1		X										E-141			
NB	3.084		D R1-1	30	30							1														TH-55, CRESCENT ST			
			D R1-1	30	30			6.25						1		X								X					
NB	3.177		A R2-1	24	30							1																	
			A R2-1	24	30			5.00						1		X								X		MAINTAIN 10+ FEET FROM UTILITY POLE			
NB	3.217		A W1-6	48	24							1																	
			A W1-6	48	24	FY		8.00						2		X								X					
NB	3.217		B W1-6	48	24							1																	
			B W1-6	48	24	FY		8.00						2		X								X		FACES SB TRAFFIC			
NB	3.282		A R2-1	24	30		40 	5.00						1		X								X		INSTALL 350 FEET NORTH OF BACK TO BACK LARGE ARROWS			
NB	3.460 3.402		A R2-1	24	30		SPEED LIMIT 50					+																	
NB	3.427		A VW-060	30	30		HIDDEN DRIVES					1																	
NB	3.502		A S3-1	30	30							1																	
SIGN SUMMARY SHEET							SHEET TOTALS	37.25 42.25	0.00	0	0	0	7 8	0	0	8	120												
VERMONT AGENCY OF TRANSPORTATION							TOWN TOTALS	729.7	0.0	22.0	4.0	4.0	151	0.0	0.0	118	1770.0												
PROJECT NAME: Stamford-Andover VT100																					PROJECT NUMBER: STPG SIGN(20)								
FILE NAME: Londonderrv.xls												PLOT DATE: 8/6/2009																	
PROJECT MANAGER: N. Avery												DRAWN BY: T. Guazzoni																	
DESIGNED BY: J. Kelly												CHECKED BY: T. Guazzoni																	
LONDONDERRY SHEET 6												SHEET 155 OF 198																	




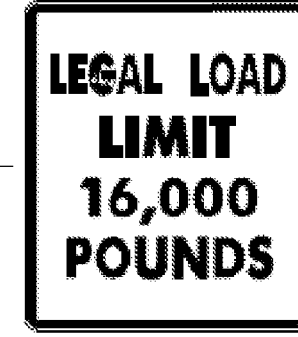
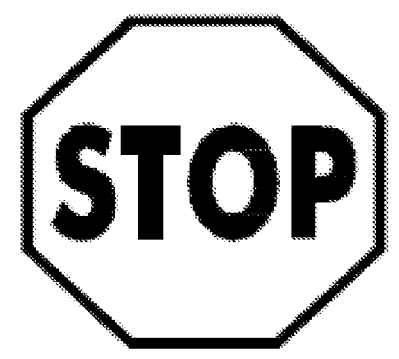

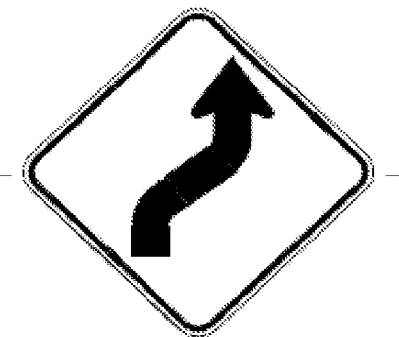

DIRECTION	MILEPOINT	LOCATION CODE (SHEET 2)	SIGN CODE	WIDTH (IN)	HEIGHT (IN)	SHEETING REMARKS	SIGN LEGEND	NEW SIGNS		EXISTING SIGNS				EXIST POST		NUMBER OF NEW POSTS	SQUARE STEEL (IN)			TUBULAR STEEL Ø (IN)				SIGN FRAME REQUIRED	REMARKS	SIGN DETAIL		
								"A"	"B"	RETAIN	SALVAGE FROM	SALVAGE TO	REMOVE	RETAIN	REMOVE		1.75	2.00	2.50	3.00	3.50	4.00	5.00			DETAIL IN SHS	DETAIL ON SHEET NUMBER	DETAIL ON STD SHEET NUMBER
																	(LB / FT)			(LB / FT)								
LONDONDERRY VT 100							FY-FLUORESCENT YELLOW FYG-FLUORESCENT YELLOW GREEN															"SHS"-STANDARD HIGHWAY SIGNS						
			A	VW-054R	30	30		6.25							2	X							INSTALL HIDDEN DRIVES RIGHT SIGN AT TOP			E-154		
			A	S3-1	30	30		6.25																X				
NB	3.712		A	W1-4L	30	30	LEFT REVERSE CURVE					1		X														
			A	W13-1	18	18	35 MPH PLAQUE					1																
																												
NB	3.778		A	W1-4L	30	30	LEFT REVERSE CURVE	6.25						1	X								INSTALL 350 FEET NORTH OF EXISTING LEFT REVERSE CURVE ASSEMBLY	X				
			A	W13-1	18	18	35 MPH PLAQUE	2.25																X				
																												
NB	3.827		A	W1-6	48	24	<=== LEFT			1				X														
NB	3.827		B	W1-6	48	24	RIGHT ==>			1				X														
NB	3.882		A	VW-054R	30	30	HIDDEN DRIVE RIGHT				1			X														
NB	3.892		A	VW-054R	30	30	HIDDEN DRIVE RIGHT					1			1	X							INSTALL SIGN ON NEW POST 50 FEET NORTH OF EXISTING LOCATION					
NB	5.432		A	VD-062C	72	16	BUSINESS SIGN			1				X														
			A	VD-062BC	72	16	BUSINESS SIGN			1																		
NB	5.619		A	W3-1	36	36							1		X													
			A	W3-1	36	36		9.00							2	X								X				
NB	5.690		A	M2-1S	21	15							1		X													
SIGN SUMMARY SHEET							SHEET TOTALS	30.00	0.00	4	1	1	4	0	0	6	90											
VERMONT AGENCY OF TRANSPORTATION								SF	SF	EA	EA	EA	EA	EA	EA	EA	FT											
							TOWN TOTALS	729.7	0.0	22.0	4.0	4.0	151	0.0	0.0	118	1770.0											
PROJECT NAME: Stamford-Andover VT100																					PROJECT NUMBER: STPG SIGN(20)							
FILE NAME: Londonderrv.xls												PLOT DATE: 8/6/2009																
PROJECT MANAGER: N. Avery												DRAWN BY: T. Guazzoni																
DESIGNED BY: J. Kelly												CHECKED BY: T. Guazzoni																
LONDONDERRY SHEET 7																					SHEET 156 OF 198							








DIRECTION	MILEPOINT	LOCATION CODE (SHEET 2)	SIGN CODE	WIDTH (IN)	HEIGHT (IN)	SHEETING REMARKS	SIGN LEGEND	NEW SIGNS		EXISTING SIGNS				EXIST POST		NUMBER OF NEW POSTS	SQUARE STEEL (IN)			TUBULAR STEEL Ø (IN)				SIGN FRAME REQUIRED	REMARKS	SIGN DETAIL		
								"A"	"B"	RETAIN	SALVAGE FROM	SALVAGE TO	REMOVE	RETAIN	REMOVE		1.75	2.00	2.50	3.00	3.50	4.00	5.00			DETAIL IN SHS	DETAIL ON SHEET NUMBER	DETAIL ON STD SHEET NUMBER
																	(LB / FT)			(LB / FT)								
LONDONDERRY VT 100							FY-FLUORESCENT YELLOW FYG-FLUORESCENT YELLOW GREEN															"SHS"-STANDARD HIGHWAY SIGNS						
			A	M1-5	24	24							1															
			A	M2-1	21	15		2.19							1	X								GREEN ON WHITE SHEETING	X			
			A	M1-5	24	24		4.00																		E-136B		
NB	5.722		A	D1-1G	72	10							1	X														
			A	D1-1A	72	10																						
			A	D1-1A	72	10																						
			A	D1-1S	72	10																						
			A	D1-1A	72	12		6.00																		5		
			A	D1-1A	72	12		6.00																		5		
			A	D1-1A	72	12		6.00																		5		
NB	5.768		A	M3-4S	24	12							1	X														
			A	M1-5	24	24																						
			A	M5-1S	21	15																						
			A	M3-2S	24	12																						
SIGN SUMMARY SHEET							SHEET TOTALS	30.19	0.00	0	0	0	9	0	0	1	15							PROJECT NAME: Stamford-Andover VT100				
								SF	SF	EA	EA	EA	EA	EA	EA	EA	FT							PROJECT NUMBER: STPG SIGN(20)				
							TOWN TOTALS	729.7	0.0	22.0	4.0	4.0	151	0.0	0.0	118	1770.0							FILE NAME: Londonderrv.xls				
VERMONT AGENCY OF TRANSPORTATION																									PROJECT MANAGER: N. Avery			
																									DRAWN BY: T. Guazzoni			
																										DESIGNED BY: J. Kelly		
																										CHECKED BY: T. Guazzoni		
																										PLOT DATE: 8/6/2009		
																										SHEET 157 OF 198		





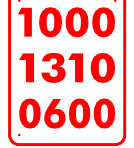

DIRECTION	MILEPOINT	LOCATION CODE (SHEET 2)	SIGN CODE	WIDTH (IN)	HEIGHT (IN)	SHEETING REMARKS	SIGN LEGEND	NEW SIGNS		EXISTING SIGNS			EXIST POST		NUMBER OF NEW POSTS	SQUARE STEEL (IN)			TUBULAR STEEL Ø (IN)				SIGN FRAME REQUIRED	REMARKS	SIGN DETAIL				
								"A"	"B"	RETAIN	SALVAGE FROM	SALVAGE TO	REMOVE	RETAIN		REMOVE	1.75	2.00	2.50	FOUNDATION	3.00	3.50			4.00	5.00	DETAIL IN SHS	DETAIL ON SHEET NUMBER	DETAIL ON STD SHEET NUMBER
																	(LB / FT)				(LB / FT)								
LONDONDERRY VT 100							FY-FLUORESCENT YELLOW FYG-FLUORESCENT YELLOW GREEN															"SHS"-STANDARD HIGHWAY SIGNS							
			A M1-5	24	24																								
			A M5-1S	21	15																								
			A M3-1S	24	12																								
			A M1-5	30	24																								
			A M5-1S	21	15																								
			A M3-4	24	12			2.00													#3A	GREEN ON WHITE SHEETING	X	7					
			A M1-5	24	24			4.00																		E-136B			
			A M6-1L	21	15			2.19																					
			A M3-2	24	12			2.00																					
			A M1-5	24	24			4.00																		E-136B			
			A M6-2R	21	15			2.19																					
			A M3-1	24	12			2.00																					
			A M1-5	30	24			5.00																		E-136B			
			A M6-2R	21	15			2.19																					
NB	5.795		A R1-1	36	36		STOP																						
SIGN SUMMARY SHEET							SHEET TOTALS										PROJECT NAME: Stamford-Andover VT100												
							25.57	0.00	1	0	0	5	0	0	0	0	0	0					PROJECT NUMBER: STPG SIGN(20)						
VERMONT AGENCY OF TRANSPORTATION							SF	SF	EA	EA	EA	EA	EA	EA	EA	EA	EA	EA	EA	EA	EA	EA	EA	EA	EA	EA	EA	EA	EA
							TOWN TOTALS										FILE NAME: Londonderrv.xls												
							729.7	0.0	22.0	4.0	4.0	151	0.0	0.0	118	1770.0									PLOT DATE: 8/6/2009				
																	DESIGNED BY: J. Kelly												
																	DRAWN BY: T. Guazzoni												
																	CHECKED BY: T. Guazzoni												
																	LONDONDERRY SHEET 9												
																	SHEET 158 OF 198												






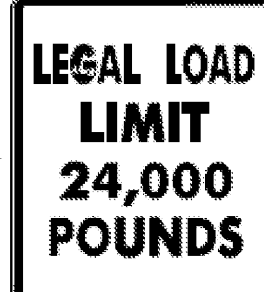


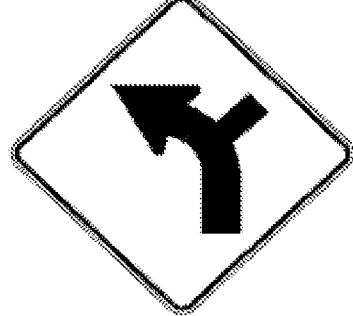

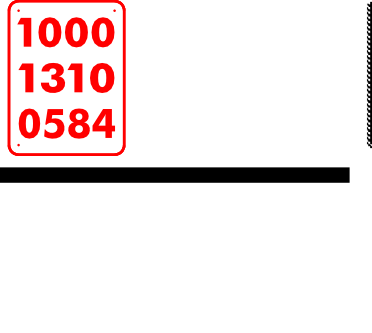

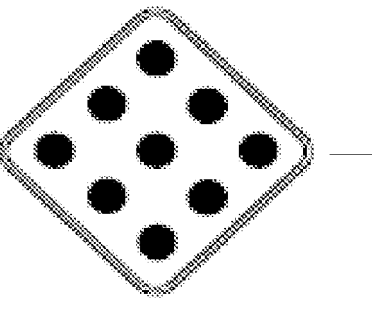

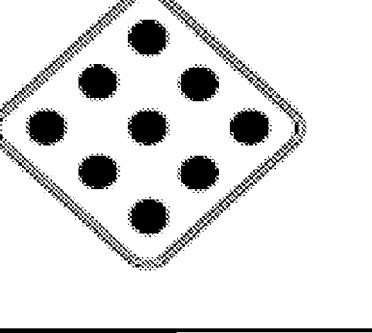

DIRECTION	MILEPOINT	LOCATION CODE (SHEET 2)	SIGN CODE	WIDTH (IN)	HEIGHT (IN)	SHEETING REMARKS	SIGN LEGEND	NEW SIGNS		EXISTING SIGNS			EXIST POST		NUMBER OF NEW POSTS	SQUARE STEEL (IN)			TUBULAR STEEL Ø (IN)				SIGN FRAME REQUIRED	REMARKS	SIGN DETAIL			
								"A"	"B"	RETAIN	SALVAGE FROM	SALVAGE TO	REMOVE	RETAIN		REMOVE	1.75	2.00	2.50	3.00	3.50	4.00			5.00	DETAIL IN SHS	DETAIL ON SHEET NUMBER	DETAIL ON STD SHEET NUMBER
																	(LB / FT)			(LB / FT)								
LONDONDERRY VT 100							FY-FLUORESCENT YELLOW FYG-FLUORESCENT YELLOW GREEN															"SHS"-STANDARD HIGHWAY SIGNS						
NB	5.842	A	VR-041	24	24		THROUGH WAY BEGINS HERE				1			X														
		A	R2-1	24	30						1																	
		B	VR-040	24	24		THROUGH WAY ENDS HERE				1																	
		A	R2-1	24	30			5.00						1		X						X						
NB	5.859	C	VR-017	24	24						1			X								TH-14, POND ST						
		C	VR-017	24	30			5.00						1		X								E-141				
NB	5.863	D	R1-1	30	30						1			X								TH-14, POND ST						
		D	R1-1	30	30			6.25						1		X						X						
NB	5.871	A	M3-1	24	12						1			X														
		A	M1-5A	24	24						1																	
		A	D2-1	72	12			6.00						2		X								5				
		A	D2-1	72	12			6.00																5				
		A	M3-1	24	12			2.00														X						
		A	M1-5	30	24			5.00														INSTALL ON LEFT POST			E-136B			
NB	5.911	A	S3-1	30	30						1			X														
SIGN SUMMARY SHEET							SHEET TOTALS	35.25	0.00	0	0	0	8	0	0	5	75					PROJECT NAME: Stamford-Andover VT100						
VERMONT AGENCY OF TRANSPORTATION							TOWN TOTALS	729.7	0.0	22.0	4.0	4.0	151	0.0	0.0	118	1770.0					PROJECT NUMBER: STPG SIGN(20)						
								SF	SF	EA	EA	EA	EA	EA	EA	EA	FT					FILE NAME: Londonderrv.xls	PLOT DATE: 8/6/2009					
																					PROJECT MANAGER: N. Avery	DRAWN BY: T. Guazzoni						
																					DESIGNED BY: J. Kelly	CHECKED BY: T. Guazzoni						
																					LONDONDERRY SHEET 10	SHEET 159 OF 198						


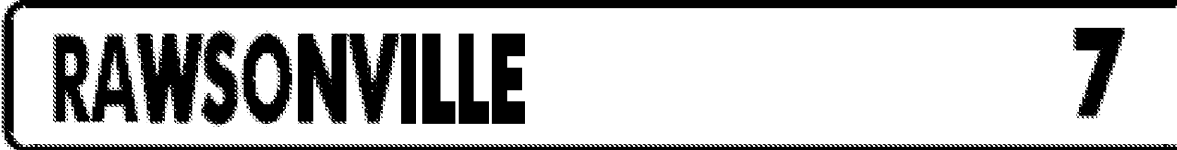

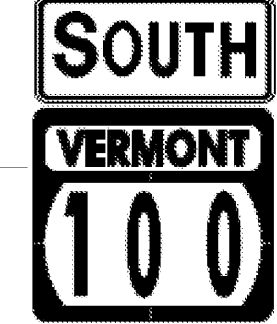
DIRECTION	MILEPOINT	LOCATION CODE (SHEET 2)	SIGN CODE	WIDTH (IN)	HEIGHT (IN)	SHEETING REMARKS	SIGN LEGEND	NEW SIGNS		EXISTING SIGNS			EXIST POST		NUMBER OF NEW POSTS	SQUARE STEEL (IN)			TUBULAR STEEL Ø (IN)				SIGN FRAME REQUIRED	REMARKS	SIGN DETAIL						
								"A"	"B"	RETAIN	SALVAGE FROM	SALVAGE TO	REMOVE	RETAIN		REMOVE	1.75	2.00	2.50	3.00	3.50	4.00			5.00	DETAIL IN SHS	DETAIL ON SHEET NUMBER	DETAIL ON STD SHEET NUMBER			
																	(LB / FT)			(LB / FT)											
LONDONDERRY VT 100							FY-FLUORESCENT YELLOW FYG-FLUORESCENT YELLOW GREEN															"SHS"-STANDARD HIGHWAY SIGNS									
			A S3-1	30	30			6.25						1	X									X							
NB	5.985		A W1-4ML	30	30		MODIFIED LEFT REVERSE CURVE						1		X																
			A W13-1	18	18		40 MPH PLAQUE						1																		
NB	5.965 6.273		A R2-1	24	30								1		X																
			A R2-1	24	30			5.00						1	X										NEW MM CHANGE, SEE SIGN CHANGE NOTE ON SHEET #151.	X					
NB	6.000		A VW-544	30	30		EMERGENCY VEHICLES						1		X																
NB	6.040		A VW-544	30	30			6.25						1	X											INSTALL 200 FEET NORTH OF EXISTING EMERGENCY VEHICLES ASSEMBLY			E-154		
NB	6.642		C VR-017	24	30								2 +		X											TH-15, COBBLE RIDGE RD					
			C VR-017	24	30			5.00						1	X											NO PARKING SIGN WAS REMOVED AND GIVEN TO THE TOWN. ILLEGAL SIGN.			E-141		
NB	6.647		D R1-1	30	30								1		X											TH-15, COBBLE RIDGE RD					
			D R1-1	30	30			6.25						1	X																
NB	7.470		A W1-4R	30	30								1		X																
			A W1-4R	30	30			6.25						1	X																
NB	7.520		A VW-081R	30	30								1		X																
			A VW-081R	30	30			6.25						1	X																
SIGN SUMMARY SHEET							SHEET TOTALS	41.25	0.00	0	0	0	9 8	0	0	7	105											PROJECT NAME: Stamford-Andover VT100			
VERMONT AGENCY OF TRANSPORTATION							TOWN TOTALS	729.7	0.0	22.0	4.0	4.0	151	0.0	0.0	118	1770.0											PROJECT NUMBER: STPG SIGN(20)			
								SF	SF	EA	EA	EA	EA	EA	EA	EA	FT											FILE NAME: Londonderrv.xls			
																												PLOT DATE: 8/6/2009			
																												PROJECT MANAGER: N. Avery			
																												DRAWN BY: T. Guazzoni			
																												DESIGNED BY: J. Kelly			
																												CHECKED BY: T. Guazzoni			
																												LONDONDERRY SHEET 11			
																												SHEET 160 OF 198			




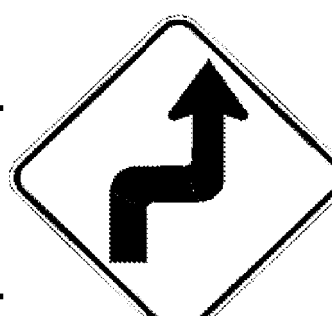

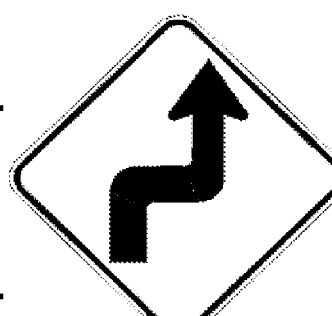
DIRECTION	MILEPOINT	LOCATION CODE (SHEET 2)	SIGN CODE	WIDTH (IN)	HEIGHT (IN)	SHEETING REMARKS	SIGN LEGEND	NEW SIGNS		EXISTING SIGNS			EXIST POST		NUMBER OF NEW POSTS	SQUARE STEEL (IN)			TUBULAR STEEL Ø (IN)				SIGN FRAME REQUIRED	REMARKS	SIGN DETAIL				
								"A"	"B"	RETAIN	SALVAGE FROM	SALVAGE TO	REMOVE	RETAIN		REMOVE	1.75	2.00	2.50	FOUNDATION	3.00	3.50			4.00	5.00	DETAIL IN SHS	DETAIL ON SHEET NUMBER	DETAIL ON STD SHEET NUMBER
																	(LB / FT)				(LB / FT)								
LONDONDERRY VT 100							FY-FLUORESCENT YELLOW FYG-FLUORESCENT YELLOW GREEN															"SHS"-STANDARD HIGHWAY SIGNS							
SB	7.220	F	VW-205	36	36																								
		F	VW-205	36	36			9.00										X							E-154				
SB	6.810	F	VW-054	30	30		HIDDEN DRIVE RIGHT																						
SB	6.765	F	S3-1	30	30		SCHOOL BUS STOP AHEAD																						
		F	VW-054R	30	30			6.25																	E-154				
		F	S3-1	30	30			6.25															X						
SB	6.593	G	VR-017	24	30		LEGAL LOAD LIMIT 24,000 POUNDS																						
		G	VR-017	24	30			5.00																	E-141				
SB	6.588	H	R1-1	30	30		STOP																						
		H	R1-1	30	30			6.25															X						
SB	6.550	F	VW-054	30	30		HIDDEN DRIVES RIGHT																						
								6.25																	E-154				
SB	6.480	F	VW-054R	30	30																								
SB	6.335	F	VW-544	30	30		EMERGENCY VEHICLES																						
								6.25																	E-154				
SB	6.259	F	VW-544	30	30																								
SB	6.190	F	VD-062BC	72	16		BUSINESS SIGN																						
SIGN SUMMARY SHEET							SHEET TOTALS	45.25	0.00	1	0	0	7	0	0	8	120	PROJECT NAME: Stamford-Andover VT100											
VERMONT AGENCY OF TRANSPORTATION							TOWN TOTALS	729.7	0.0	22.0	4.0	4.0	151	0.0	0.0	118	1770.0	PROJECT NUMBER: STPG SIGN(20)											
								SF	SF	EA	EA	EA	EA	EA	EA	EA	FT	FILE NAME: Londonderrv.xls											
																			PLOT DATE: 8/6/2009										
																			PROJECT MANAGER: N. Avery										
																		DRAWN BY: T. Guazzoni											
																		DESIGNED BY: J. Kelly											
																		CHECKED BY: T. Guazzoni											
																		SHEET 161 OF 198											



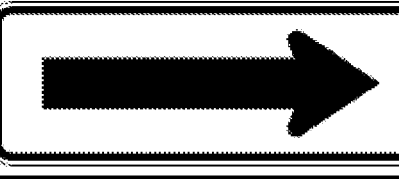


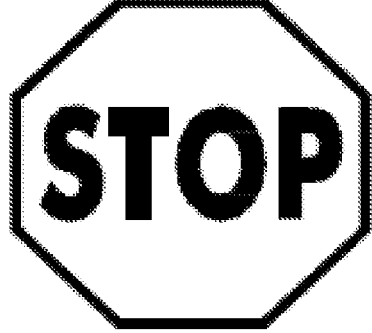

DIRECTION	MILEPOINT	LOCATION CODE (SHEET 2)	SIGN CODE	WIDTH (IN)	HEIGHT (IN)	SHEETING REMARKS	SIGN LEGEND	NEW SIGNS		EXISTING SIGNS			EXIST POST		NUMBER OF NEW POSTS	SQUARE STEEL (IN)			TUBULAR STEEL Ø (IN)				SIGN FRAME REQUIRED	REMARKS	SIGN DETAIL			
								"A"	"B"	RETAIN	SALVAGE FROM	SALVAGE TO	REMOVE	RETAIN		REMOVE	1.75	2.00	2.50	3.00	3.50	4.00			5.00	DETAIL IN SHS	DETAIL ON SHEET NUMBER	DETAIL ON STD SHEET NUMBER
																	(LB / FT)			(LB / FT)								
LONDONDERRY VT 100							FY-FLUORESCENT YELLOW FYG-FLUORESCENT YELLOW GREEN															"SHS"-STANDARD HIGHWAY SIGNS						
			F VD-062C	72	16		BUSINESS SIGN			1																		
SB	6.150		F W1-10L	30	30		LEFT CURVE WITH RH SIDE ROAD					1																
			F W13-1	18	18		40 MPH PLAQUE																					
SB	6.115		F S3-1	30	30		 					1																
			F W1-10L	30	30									6.25													X	
			F S3-1	30	30									6.25													X	
SB	6.080		F W3-5 R2-1	36 30	36		SPEED REDUCTION (30) ^{LIMIT}			1																		
SB	6.039		F W1-6	48	24		LEFT LARGE ARROW			1																		
SB	5.998		G VR-017	24	30							1																
			G VR-017	24	30									5.00													E-141	
SB	5.993		H R1-1	30	30		 					1																
			H R1-1	30	30									6.25													X	
SB	5.975		F W3-1	36	36		STOP AHEAD			1																		
SB	5.965		F R2-1	24	30																							
			F R2-1	30 24	30									7.50													6	
SIGN SUMMARY SHEET							SHEET TOTALS	23.75 31.25	0.00	4	0	0	5	0	0	5	75						PROJECT NAME: Stamford-Andover VT100					
VERMONT AGENCY OF TRANSPORTATION							TOWN TOTALS	729.7	0.0	22.0	4.0	4.0	151	0.0	0.0	118	1770.0						PROJECT NUMBER: STPG SIGN(20)					
										EA	EA	EA	EA	EA	EA	EA	FT						FILE NAME: Londonderrv.xls					
																							PLOT DATE: 8/6/2009					
																							DRAWN BY: T. Guazzoni					
																							DESIGNED BY: J. Kelly					
																							CHECKED BY: T. Guazzoni					
																							SHEET 162 OF 198					







DIRECTION	MILEPOINT	LOCATION CODE (SHEET 2)	SIGN CODE	WIDTH (IN)	HEIGHT (IN)	SHEETING REMARKS	SIGN LEGEND	NEW SIGNS		EXISTING SIGNS				EXIST POST		NUMBER OF NEW POSTS	SQUARE STEEL (IN)			TUBULAR STEEL Ø (IN)				SIGN FRAME REQUIRED	REMARKS	SIGN DETAIL			
								"A"	"B"	RETAIN	SALVAGE FROM	SALVAGE TO	REMOVE	RETAIN	REMOVE		1.75	2.00	2.50	3.00	3.50	4.00	5.00			DETAIL IN SHS	DETAIL ON SHEET NUMBER	DETAIL ON STD SHEET NUMBER	
																	(LB / FT)			(LB / FT)									
LONDONDERRY VT 100							FY-FLUORESCENT YELLOW FYG-FLUORESCENT YELLOW GREEN															"SHS"-STANDARD HIGHWAY SIGNS							
SB	5.926	F	M2-1S	21	15																								
		F	M1-5	24	24																								
		F	M2-1	21	15			2.19							1		X									GREEN ON WHITE SHEETING	X		
		F	M1-5	24	24			4.00																			E-136B		
SB	5.870	F	D1-1A	72	10																								
		F	D1-1A	72	10																								
		F	D1-1A	72	10																								
		F	D1-1A	72	10																								
		F	D1-1A	72	12			6.00							2		X											5	
		F	D1-1A	72	12			6.00																				5	
		F	D1-1A	72	12			6.00																				5	
		F	D1-1A	72	12			6.00																				5	
SB	5.844	G	VR-017	24	30																							TH-54, HIGH ST	
		G	VR-017	24	30			5.00							1		X										E-141		
SB	5.840	H	R1-1	24	24																						TH-54, HIGH ST		
SIGN SUMMARY SHEET							SHEET TOTALS	35.19	0.00	0	0	0	8	0	0	4	60							PROJECT NAME: Stamford-Andover VT100					
								SF	SF	EA	EA	EA	EA	EA	EA	EA	FT							PROJECT NUMBER: STPG SIGN(20)					
							TOWN TOTALS	729.7	0.0	22.0	4.0	4.0	151	0.0	0.0	118	1770.0							FILE NAME: Londonderrv.xls					
VERMONT AGENCY OF TRANSPORTATION																								PLOT DATE: 8/6/2009					
																								DRAWN BY: T. Guazzoni					
																								DESIGNED BY: J. Kelly					
																								CHECKED BY: T. Guazzoni					
																								SHEET 163 OF 198					



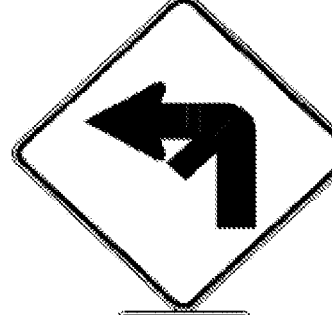


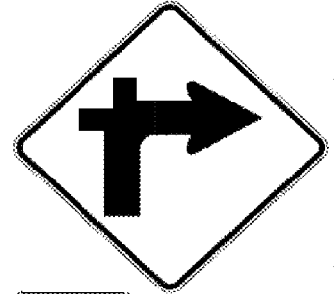
DIRECTION	MILEPOINT	LOCATION CODE (SHEET 2)	SIGN CODE	WIDTH (IN)	HEIGHT (IN)	SHEETING REMARKS	SIGN LEGEND	NEW SIGNS		EXISTING SIGNS			EXIST POST		NUMBER OF NEW POSTS	SQUARE STEEL (IN)			TUBULAR STEEL Ø (IN)				SIGN FRAME REQUIRED	REMARKS	SIGN DETAIL				
								"A"	"B"	RETAIN	SALVAGE FROM	SALVAGE TO	REMOVE	RETAIN		REMOVE	1.75	2.00	2.50	FOUNDATION	3.00	3.50			4.00	5.00	DETAIL IN SHS	DETAIL ON SHEET NUMBER	DETAIL ON STD SHEET NUMBER
																	(LB / FT)				(LB / FT)								
LONDONDERRY VT 100							FY-FLUORESCENT YELLOW FYG-FLUORESCENT YELLOW GREEN															"SHS"-STANDARD HIGHWAY SIGNS							
			H R1-1	30	30			6.25						1	X									X					
SB	5.820		F R1-1	30	30					1			X	X											REPLACED IN 2009 ON RT. II PROJECT.				
			F R1-1	36	36	1000 1310 0584		0.00 9.00						2	X										X				
SB	5.794		F OM1-1	18	18						1			X															
			E R1-1	30	30					1																			
			F OM1-1	18	18			2.25						1	X										INSTALL SIGNS BACK TO BACK AS EXISTING	X			
			E R1-1	30	30			6.25																	X				
SB	5.784		H R1-1	30	30						1			X															
			G OM1-1	18	18					1																			
			H R1-1	30	30			6.25						1	X										INSTALL SIGNS BACK TO BACK AS EXISTING	X			
			G OM1-1	18	18			2.25																	REPLACED IN 2009 ON RT. II PROJECT.	X			
SB	5.779		H R1-1	30	30							1		X															
			H R1-1	30	30			6.25						1	X										X				
SB	5.768		F M3-3S	24	12		SOUTH					1		X															
			F M1-5	30	24		VERMONT 100					1																	
SIGN SUMMARY SHEET							SHEET TOTALS	29.50 38.50	0.00	0	0	0	7	0	0	6	90												
VERMONT AGENCY OF TRANSPORTATION							TOWN TOTALS	729.7	0.0	22.0	4.0	4.0	151	0.0	0.0	118	1770.0												
PROJECT NAME: Stamford-Andover VT100																					PROJECT NUMBER: STPG SIGN(20)								
FILE NAME: Londonderrv.xls											PLOT DATE: 8/6/2009																		
PROJECT MANAGER: N. Avery											DRAWN BY: T. Guazzoni																		
DESIGNED BY: J. Kelly											CHECKED BY: T. Guazzoni																		
LONDONDERRY SHEET 15											SHEET 164 OF 198																		

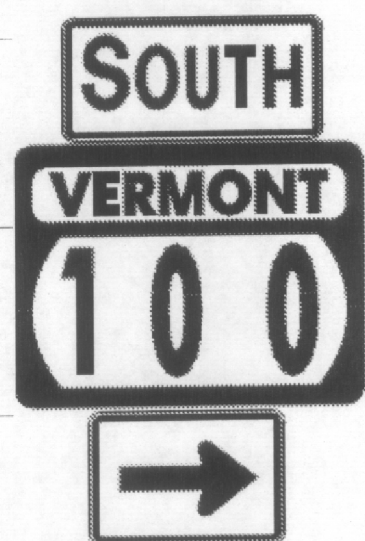
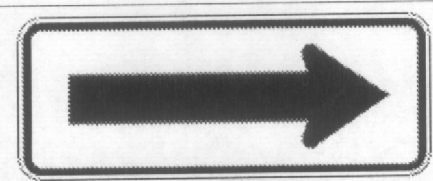
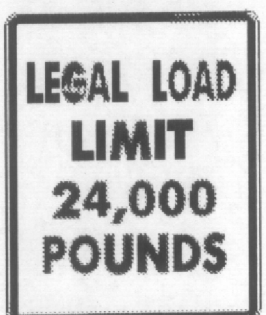


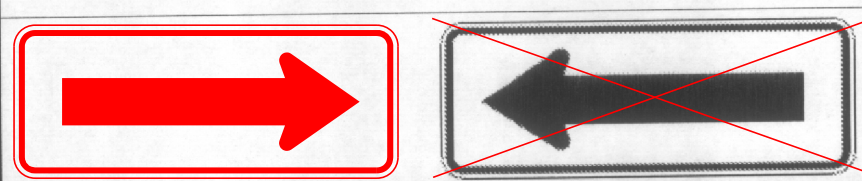
DIRECTION	MILEPOINT	LOCATION CODE (SHEET 2)	SIGN CODE	WIDTH (IN)	HEIGHT (IN)	SHEETING REMARKS	SIGN LEGEND	NEW SIGNS		EXISTING SIGNS				EXIST POST		NUMBER OF NEW POSTS	SQUARE STEEL (IN)			TUBULAR STEEL Ø (IN)				SIGN FRAME REQUIRED	REMARKS	SIGN DETAIL		
								"A"	"B"	RETAIN	SALVAGE FROM	SALVAGE TO	REMOVE	RETAIN	REMOVE		1.75	2.00	2.50	3.00	3.50	4.00	5.00			DETAIL IN SHS	DETAIL ON SHEET NUMBER	DETAIL ON STD SHEET NUMBER
																	(LB / FT)			(LB / FT)								
LONDONDERRY VT 100							FY-FLUORESCENT YELLOW FYG-FLUORESCENT YELLOW GREEN																"SHS"-STANDARD HIGHWAY SIGNS					
SB	5.750	F	D2-1	72	12			6.00							2		X									5		
		F	D2-1	72	12			6.00																		5		
		F	D2-1	72	12			6.00																		5		
		F	M3-3	24	12			2.00																X				
		F	M1-5	30	24			5.00																			E-136B	
SB	5.624	F	VD-062AL	72	16		BUSINESS SIGN			1																		
SB	5.564	F	R2-1	24	30		SPEED LIMIT 50					1																
		F	R2-1	24	30		SPEED LIMIT 50	5.00							1		X								X			
SB	5.240	F	VW-133R	30	30		HIDDEN DRIVES RIGHT			1																		
		F	W16-2	24	18		600 FEET			1																		
SB	4.783	F	VW-054R	30	30		HIDDEN DRIVE RIGHT			1																		
SB	4.049	F	W1-4L	30	30		LEFT REVERSE CURVE				1																	
		F	W13-1	18	18		35 MPH PLAQUE				1																	
SB	3.973	F	W1-4L	30	30		LEFT REVERSE CURVE					1					X										REINSTALL SIGNS 400 FEET SOUTH OF EXISTING LEFT REVERSE CURVE ASSEMBLY	
		F	W13-1	18	18		35 MPH PLAQUE					1																
SIGN SUMMARY SHEET							SHEET TOTALS	30.00	0.00	4	2	2	1	0	0	4	60					PROJECT NAME: Stamford-Andover VT100						
								SF	SF	EA	EA	EA	EA	EA	EA	EA	FT					PROJECT NUMBER: STPG SIGN(20)						
VERMONT AGENCY OF TRANSPORTATION							TOWN TOTALS	729.7	0.0	22.0	4.0	4.0	151	0.0	0.0	118	1770.0					FILE NAME: Londonderrv.xls	PLOT DATE: 8/6/2009					
																						PROJECT MANAGER: N. Avery	DRAWN BY: T. Guazzoni					
																						DESIGNED BY: J. Kelly	CHECKED BY: T. Guazzoni					
																						LONDONDERRY SHEET 16	SHEET 165 OF 198					

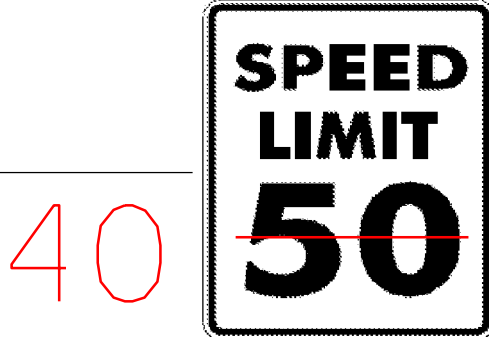

DIRECTION	MILEPOINT	LOCATION CODE (SHEET 2)	SIGN CODE	WIDTH (IN)	HEIGHT (IN)	SHEETING REMARKS	SIGN LEGEND	NEW SIGNS		EXISTING SIGNS			EXIST POST		NUMBER OF NEW POSTS	SQUARE STEEL (IN)			TUBULAR STEEL Ø (IN)				SIGN FRAME REQUIRED	REMARKS	SIGN DETAIL									
								"A"	"B"	RETAIN	SALVAGE FROM	SALVAGE TO	REMOVE	RETAIN		REMOVE	1.75	2.00	2.50	3.00	3.50	4.00			5.00	DETAIL IN SHS	DETAIL ON SHEET NUMBER	DETAIL ON STD SHEET NUMBER						
																	(LB / FT)			(LB / FT)														
LONDONDERRY VT 100							FY-FLUORESCENT YELLOW FYG-FLUORESCENT YELLOW GREEN															"SHS"-STANDARD HIGHWAY SIGNS												
SB	3.809	F	S3-1	30	30		SCHOOL BUS STOP AHEAD					1																						
SB	3.674	F	VW-054L	30	30																													
		F	VW-054L	30	30				6.25																									E-154
SB	3.574	F	W3-5	36	36		SPEED REDUCTION (30)			1	+																							
SB	3.423	F	W3-5	36	36		SPEED REDUCTION (30)			1	+																							
SB	3.414	F	VD-018	30	18		SOUTH LONDONDERRY RAWSONVILLE 4					1																						
SB	3.404	F	R2-1	24	30		SPEED LIMIT 30					1																						
SB	3.414 3.362	F	VD-018	30	18		 	3.75																										
SB	3.350	F	W1-3R	30	30		RIGHT REVERSE TURN					1																						
SB	3.324	F	VD-062AS	72	16		BUSINESS SIGN			1																								
		F	VD-062AS	72	16		BUSINESS SIGN			1																								
SB	3.282	F	R2-1	30	36		 	7.50																										
SB	3.244	F	W1-3R	30	30	FY		6.25																										
SB	3.154	F	W1-1L	30	30		LEFT TURN WITH LH SIDE ROAD					1																						
		F	W13-1	18	18		20 MPH PLAQUE					1																						
SIGN SUMMARY SHEET							SHEET TOTALS	16.25 23.75	0.00	2	0	0	7	0	0	6	90										PROJECT NAME: Stamford-Andover VT100							
VERMONT AGENCY OF TRANSPORTATION							TOWN TOTALS	729.7	0.0	22.0	4.0	4.0	151	0.0	0.0	118	1770.0										PROJECT NUMBER: STPG SIGN(20)							
								SF	SF	EA	EA	EA	EA	EA	EA	EA	FT										FILE NAME: Londonderrv.xls							
																											PLOT DATE: 8/6/2009							
																											DRAWN BY: T. Guazzoni							
																											DESIGNED BY: J. Kelly							
																											CHECKED BY: T. Guazzoni							
																											SHEET 166 OF 198							


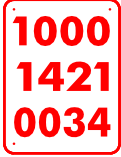


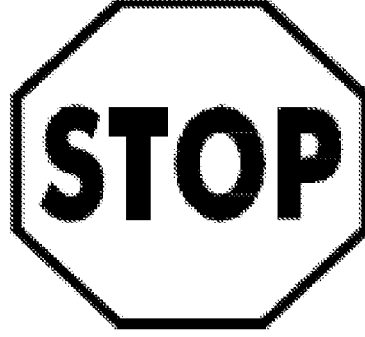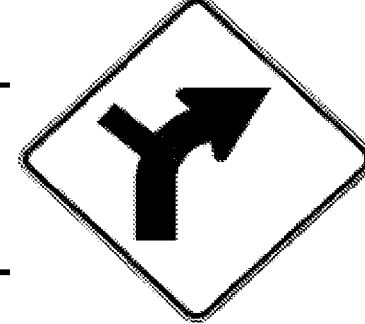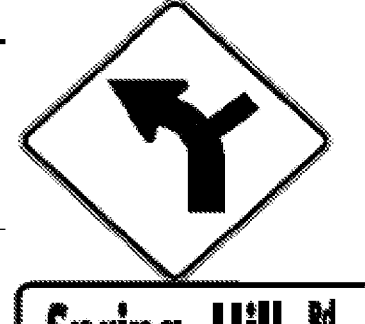

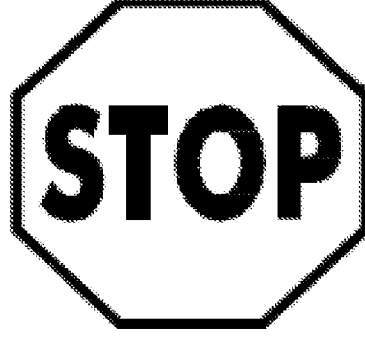



DIRECTION	MILEPOINT	LOCATION CODE (SHEET 2)	SIGN CODE	WIDTH (IN)	HEIGHT (IN)	SHEETING REMARKS	SIGN LEGEND	NEW SIGNS		EXISTING SIGNS			EXIST POST		NUMBER OF NEW POSTS	SQUARE STEEL (IN)			TUBULAR STEEL Ø (IN)				SIGN FRAME REQUIRED	REMARKS	SIGN DETAIL				
								"A"	"B"	RETAIN	SALVAGE FROM	SALVAGE TO	REMOVE	RETAIN		REMOVE	1.75	2.00	2.50	FOUNDATION	3.00	3.50			4.00	5.00	DETAIL IN SHS	DETAIL ON SHEET NUMBER	DETAIL ON STD SHEET NUMBER
																	(LB / FT)				(LB / FT)								
LONDONDERRY VT 100							FY-FLUORESCENT YELLOW FYG-FLUORESCENT YELLOW GREEN																"SHS"-STANDARD HIGHWAY SIGNS						
SB	3.144	F	W1-1fM L	30	30	FY		6.25						1	X									INSTALL 50 FEET SOUTH OF EXISTING LEFT TURN ASSEMBLY		6			
		F	W13-1	18	18	FY			2.25															X					
SB	3.119	E	W1-6	48	24						1		X																
		E	W1-6	48	24	FY			8.00						2	X									FACES NB TRAFFIC	X			
SB	3.104	F	W1-6	48	24						1		X																
		F	W1-6	48	24	FY			8.00						2	X								X					
SB	3.084	E	W1-6	48	24						1		X																
		E	W1-6	48	24	FY			8.00						2	X									FACES NB TRAFFIC	X			
SB	3.067	F	W1-1McR	36	36		MODIFIED RIGHT TURN				1		X																
		F	W13-1	24	24		20 MPH PLAQUE				1																		
SB	3.037	F	R2-1	24	30		SPEED LIMIT 30				1		X																
		F	W1-1McR	36	36	FY		9.00						2	X											X			
		F	W13-1	24	24	FY			4.00															X	INSTALL ON LH POST				
SB	3.012	F	M3-3S	24	12		SOUTH				1		X																
		F	M1-5	24	24		VERMONT				1																		
SIGN SUMMARY SHEET							SHEET TOTALS	45.50	0.00	0	0	0	8	0	0	9	135						PROJECT NAME: Stamford-Andover VT100						
VERMONT AGENCY OF TRANSPORTATION								SF	SF	EA	EA	EA	EA	EA	EA	EA	FT						PROJECT NUMBER: STPG SIGN(20)						
							TOWN TOTALS	729.7	0.0	22.0	4.0	4.0	151	0.0	0.0	118	1770.0						FILE NAME: Londonderrv.xls	PLOT DATE: 8/6/2009					
																						PROJECT MANAGER: N. Avery	DRAWN BY: T. Guazzoni						
																						DESIGNED BY: J. Kelly	CHECKED BY: T. Guazzoni						
																						LONDONDERRY SHEET 18	SHEET 167 OF 198						






DIRECTION	MILEPOINT	LOCATION CODE (SHEET 2)	SIGN CODE	WIDTH (IN)	HEIGHT (IN)	SHEETING REMARKS	SIGN LEGEND	NEW SIGNS		EXISTING SIGNS			EXIST POST		NUMBER OF NEW POSTS	SQUARE STEEL (IN)			TUBULAR STEEL Ø (IN)				SIGN FRAME REQUIRED	REMARKS	SIGN DETAIL			
								"A"	"B"	RETAIN	SALVAGE FROM	SALVAGE TO	REMOVE	RETAIN		REMOVE	(LB / FT)			(LB / FT)					DETAIL IN SHS	DETAIL ON SHEET NUMBER	DETAIL ON STD SHEET NUMBER	
																	1.75	2.00	2.50	3.00	3.50	4.00						5.00
LONDONDERRY VT 100							FY-FLUORESCENT YELLOW FYG-FLUORESCENT YELLOW GREEN															"SHS"-STANDARD HIGHWAY SIGNS						
	SB 3.012	F	M6-1S	21	15		RIGHT ==>>																					
		F	M3-3	24	12			2.00							1			X						X				
		F	M1-5	24	24			5.00																	E-136B			
		F	M6-1R	21	15			2.19																X				
		F	M6-1R	21	15			2.19																X				
	SB 2.951	E	W1-6	48	24																							
		E	W1-6	48	24	FY		8.00								2			X					X				
	SB 2.950	G	VR-017	24	30																							
		G	VR-017	24	30			5.00								1			X						E-141			
		G	VR-660	24	30	NO PARKING ON TRAVEL LANE										1												
	SB 2.946	H	R1-1	30	30																							
		H	R1-1	30	30			6.25								1			X					X				
	SB 2.933	F	M3-3	24	12			2.00																				
		F	M1-5	30	24			5.00								1			X						E-136B			
	SB 2.933	E	W1-6	48	24																							
		E	W1-6	48	24	FY		8.00								2			X					X				
SIGN SUMMARY SHEET							SHEET TOTALS	43.44	0.00	0	0	0	6	0	0	8	120						PROJECT NAME: Stamford-Andover VT100					
								SF	SF	EA	EA	EA	EA	EA	EA	EA	FT						PROJECT NUMBER: STPG SIGN(20)					
VERMONT AGENCY OF TRANSPORTATION							TOWN TOTALS	729.7	0.0	22.0	4.0	4.0	151	0.0	0.0	118	1770.0						FILE NAME: Londonderrv.xls PLOT DATE: 8/6/2009					
																						PROJECT MANAGER: N. Avery DRAWN BY: T. Guazzoni						
																						DESIGNED BY: J. Kelly CHECKED BY: T. Guazzoni						
																						LONDONDERRY SHEET 19 SHEET 168 OF 198						









DIRECTION	MILEPOINT	LOCATION CODE (SHEET 2)	SIGN CODE	WIDTH (IN)	HEIGHT (IN)	SHEETING REMARKS	SIGN LEGEND	NEW SIGNS		EXISTING SIGNS			EXIST POST		NUMBER OF NEW POSTS	SQUARE STEEL (IN)			TUBULAR STEEL Ø (IN)				SIGN FRAME REQUIRED	REMARKS	SIGN DETAIL				
								"A"	"B"	RETAIN	SALVAGE FROM	SALVAGE TO	REMOVE	RETAIN		REMOVE	1.75	2.00	2.50	FOUNDATION	3.00	3.50			4.00	5.00	DETAIL IN SHS	DETAIL ON SHEET NUMBER	DETAIL ON STD SHEET NUMBER
																	(LB / FT)				(LB / FT)								
LONDONDERRY VT 100							FY-FLUORESCENT YELLOW FYG-FLUORESCENT YELLOW GREEN															"SHS"-STANDARD HIGHWAY SIGNS							
SB	2.873	G	VR-017	24	30						1		X										TH-27, MELENDY HILL RD						
		G	VR-017	24	30			5.00							1	X									E-141				
SB	2.868	H	R1-1	30	30						1		X										TH-27, MELENDY HILL RD						
		H	R1-1	30	30			6.25							1	X							SEE NOTE FOR SIGN CHANGES ON SHEET #151	X					
SB	2.863	F	R2-1	24	30								X																
		F	R2-1	24	30			5.00								X								X					
SB	2.813	F	M3-3	24	12		SOUTH				1		X										MM. STILL THERE						
		F	M1-5A	24	24		VERMONT 100				1																		
SB	2.494	G	VR-017	24	30						1		X										TH-49, WINDY RISE LANE WEST						
		G	VR-017	24	30			5.00							1	X									E-141				
SB	2.490	H	R1-1	30	30						1		X										TH-49, WINDY RISE LANE WEST						
		H	R1-1	30	30			6.25							1	X								X					
SB	1.821	G	VR-017	24	30						1		X										TH-45, GLEBE VIEW LANE						
		G	VR-017	24	30			5.00							1	X									E-141				
		G					WATCH FOR CHILDREN																REMOVE TOWN'S ILLEGAL SIGN: RETURN TO TOWN MISSING						
SIGN SUMMARY SHEET							SHEET TOTALS	27.50 32.50	0.00	0	0	0	7 9	0	0	5 6	90						PROJECT NAME: Stamford-Andover VT100						
VERMONT AGENCY OF TRANSPORTATION							TOWN TOTALS	729.7	0.0	22.0	4.0	4.0	151	0.0	0.0	118	1770.0						PROJECT NUMBER: STPG SIGN(20)	FILE NAME: Londonderrv.xls	PLOT DATE: 8/6/2009				
																						DESIGNED BY: J. Kelly	PROJECT MANAGER: N. Avery	DRAWN BY: T. Guazzoni					
																						LONDONDERRY SHEET 20	CHECKED BY: T. Guazzoni	SHEET 169 OF 198					





DIRECTION	MILEPOINT	LOCATION CODE (SHEET 2)	SIGN CODE	WIDTH (IN)	HEIGHT (IN)	SHEETING REMARKS	SIGN LEGEND	NEW SIGNS		EXISTING SIGNS			EXIST POST		NUMBER OF NEW POSTS	SQUARE STEEL (IN)			TUBULAR STEEL Ø (IN)				SIGN FRAME REQUIRED	REMARKS	SIGN DETAIL			
								"A"	"B"	RETAIN	SALVAGE FROM	SALVAGE TO	REMOVE	RETAIN		REMOVE	1.75	2.00	2.50	3.00	3.50	4.00			5.00	DETAIL IN SHS	DETAIL ON SHEET NUMBER	DETAIL ON STD SHEET NUMBER
																	(LB / FT)			(LB / FT)								
LONDONDERRY VT 100							FY-FLUORESCENT YELLOW FYG-FLUORESCENT YELLOW GREEN															"SHS"-STANDARD HIGHWAY SIGNS						
SB	1.815	H	R1-1	30	30																		TH-45, GLEBE VIEW LANE					
		H	R1-1	30	30			6.25																X				
SB	1.628	F	W1-10R	30	30		RIGHT CURVE WITH LEFT SIDE ROAD																					
SB	1.610	F	VD-062AS	72	16		BUSINESS SIGN			1																		
																												
SB	1.505	F	W1-10R	30	30			6.25																INSTALL 650 FEET SOUTH OF EXISTING RIGHT CURVE ASSEMBLY	X			
SB	1.128	F	W1-10L	30	30		LEFT CURVE WITH RH SIDE ROAD																					
		F	W16-8	24	12		SPRING HILL RD																					
																												
SB	1.050	F	W1-10L	30	30			6.25																INSTALL 300 FEET NORTH OF THE SPRING HILL RD INTERSECTION	X			
		F	W16-8	30	8																					8		
																												
SB	0.988	G	VR-017	24	30			5.00																TH-41, SPRING HILL RD			E-141	
																												
SB	0.984	H	R1-1	30	30			6.25																TH-41, SPRING HILL RD	X			
		H	R1-1	30	30																							
SB	0.180	F	W11-7	30	30		EQUESTRIAN																					
SB	0.054	F	W7-1	30	30																							
SIGN SUMMARY SHEET							SHEET TOTALS	31.67	0.00	1	0	0	8	0	0	5	75							PROJECT NAME: Stamford-Andover VT100				
VERMONT AGENCY OF TRANSPORTATION							TOWN TOTALS	729.7	0.0	22.0	4.0	4.0	151	0.0	0.0	118	1770.0							PROJECT NUMBER: STPG SIGN(20)	FILE NAME: Londonderrv.xls	PLOT DATE: 8/6/2009		
								SF	SF	EA	EA	EA	EA	EA	EA	EA	FT							PROJECT MANAGER: N. Avery	DRAWN BY: T. Guazzoni			
																								DESIGNED BY: J. Kelly	CHECKED BY: T. Guazzoni			
																								LONDONDERRY SHEET 21	SHEET 170 OF 198			





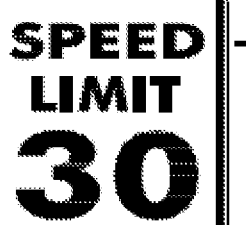

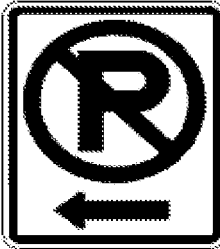DIRECTION	MILEPOINT	LOCATION CODE (SHEET 2)	SIGN CODE	WIDTH (IN)	HEIGHT (IN)	SHEETING REMARKS	SIGN LEGEND	NEW SIGNS		EXISTING SIGNS			EXIST POST		NUMBER OF NEW POSTS	SQUARE STEEL (IN)			TUBULAR STEEL Ø (IN)				SIGN FRAME REQUIRED	REMARKS	SIGN DETAIL				
								"A"	"B"	RETAIN	SALVAGE FROM	SALVAGE TO	REMOVE	RETAIN		REMOVE	1.75	2.00	2.50	3.00	3.50	4.00			5.00	DETAIL IN SHS	DETAIL ON SHEET NUMBER	DETAIL ON STD SHEET NUMBER	
																	(LB / FT)			(LB / FT)									
LONDONDERRY VT 100							FY-FLUORESCENT YELLOW FYG-FLUORESCENT YELLOW GREEN															"SHS"-STANDARD HIGHWAY SIGNS							
			F	W7-1b	30	30		6.25						1	X									X					
SB	0.010		F	VW-133R	30	30						1		X															
			F	VW-054R	30	30		6.25						1	X												E-154		
SB	0.000		G	VR-024	60	7.5						1		X															
			G	VR-024	72	10	JAMAICA LONDONDERRY	5.00						2	X										4				
			G	VR-700	6	10	1000 1309 0456	0.42																			E-138		
			G	VR-700	6	10	1000 1310 0000	0.42																			E-138		
NB	5.700		D	RI-I	30	30						I	I			X										THIS SIGN WAS REMOVED AND SALVAGED TO THE PLAZA ENTRANCE (SOUTH) PER REQUEST OF M. MILLER, TRAFFIC OPS.			
																										THIS SIGN WAS REMOVED AND SALVAGED ONTO A NEW POST AT THE PLAZA ENTRANCE (NORTH) PER REQUEST OF M. MILLER, TRAFFIC OPS.			
NB	5.850		D	RI-I	30	30						I	I	I			X									THIS SIGN WAS REMOVED AND SALVAGED ONTO A NEW POST DUE TO THE OLD POST BEING FOUND DAMAGED. THIS LOCATION IS FOR MOTORISTS TRAVELING FROM VT. RT. 100 NORTH TO VT. RT. 11 WEST. REQUEST OF M. MILLER, TRAFFIC OPS.			
NB	5.800		G	RI-I	30	30						I	I	I			X									THIS SIGN WAS REMOVED AND SALVAGED ONTO A NEW POST DUE TO THE OLD POST BEING FOUND DAMAGED. THIS LOCATION IS FOR MOTORISTS TRAVELING FROM VT. RT. 100 NORTH TO VT. RT. 11 WEST. REQUEST OF M. MILLER, TRAFFIC OPS.			
SIGN SUMMARY SHEET							SHEET TOTALS	18.34	0.00	0	2	3	5	0	0	7	60											PROJECT NAME: Stamford-Andover VT100	
VERMONT AGENCY OF TRANSPORTATION							TOWN TOTALS	729.7	0.0	22.0	4.0	4.0	151	0.0	0.0	118	1770.0											PROJECT NUMBER: STPG SIGN(20)	
							SF	SF	EA	EA	EA	EA	EA	EA	EA	EA	EA	EA	EA	EA	EA	EA	EA	EA	EA	EA	EA	FILE NAME: Londonderrv.xls	
																												PLOT DATE: 8/6/2009	
																												PROJECT MANAGER: N. Avery	
																												DRAWN BY: T. Guazzoni	
																												DESIGNED BY: J. Kelly	
																												CHECKED BY: T. Guazzoni	
																													SHEET 171 OF 198











DIRECTION	MILEPOINT	LOCATION CODE (SHEET 2)	SIGN CODE	WIDTH (IN)	HEIGHT (IN)	SHEETING REMARKS	SIGN LEGEND	NEW SIGNS		EXISTING SIGNS			EXIST POST		NUMBER OF NEW POSTS	SQUARE STEEL (IN)			TUBULAR STEEL Ø (IN)				SIGN FRAME REQUIRED	REMARKS	SIGN DETAIL				
								"A"	"B"	RETAIN	SALVAGE FROM	SALVAGE TO	REMOVE	RETAIN		REMOVE	1.75	2.00	2.50	FOUNDATION	3.00	3.50			4.00	5.00	DETAIL IN SHS	DETAIL ON SHEET NUMBER	DETAIL ON STD SHEET NUMBER
																	(LB / FT)				(LB / FT)								
WESTON VT 100							FY-FLUORESCENT YELLOW FYG-FLUORESCENT YELLOW GREEN															"SHS"-STANDARD HIGHWAY SIGNS							
		D	R1-1	30	30		LONGLEY LOOP  	6.25						1		X								X					
NB	0.415	C	VR-017	24	30			5.00						1		X									TH-48, LONGLEY LOOP		E-141		
NB	0.420	D	R1-1	30	30			6.25				1		X										X		TH-48, LONGLEY LOOP			
NB	0.430	C	VR-017	24	24			5.00				1		X												TH-48, LONGLEY LOOP		E-141	
NB	0.440	D	R1-1	30	30		LONGLEY LOOP 	6.25				1		X										X		TH-48, LONGLEY LOOP			
NB	0.647	C	VR-017	24	24			5.00				1		X												TH-36, BOYNTON RD		E-141	
NB	0.653	D	R1-1	24	24		 	6.25				1		X										X		TH-36, BOYNTON RD			
NB	1.510	A	VD-062B	72	16		BUSINESS SIGN			1				X															
NB	1.863	C	VR-017	24	30		DALE RD 	5.00				1		X												TH-33, DALE RD		E-141	
SIGN SUMMARY SHEET							SHEET TOTALS	45.00	0.00	1	3	3	6	0	0	8	120							PROJECT NAME: Stamford-Andover VT100					
VERMONT AGENCY OF TRANSPORTATION							TOWN TOTALS	774.4	0.0	26.0	12.0	12.0	139	0.0	0.0	140	2100.0							PROJECT NUMBER: STPG SIGN(20)	FILE NAME: Weston.xls	PLOT DATE: 8/6/2009			
								SF	SF	EA	EA	EA	EA	EA	EA	EA	FT							DESIGNED BY: J. Kelly	DRAWN BY: T. Guazzoni	CHECKED BY: T. Guazzoni			
																								WESTON SHEET 2	SHEET 173 OF 198				




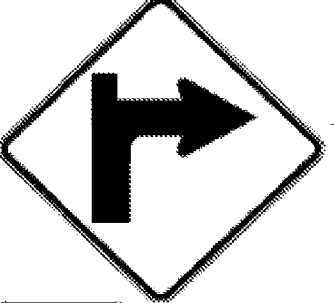



DIRECTION	MILEPOINT	LOCATION CODE (SHEET 2)	SIGN CODE	WIDTH (IN)	HEIGHT (IN)	SHEETING REMARKS	SIGN LEGEND	NEW SIGNS		EXISTING SIGNS			EXIST POST		NUMBER OF NEW POSTS	SQUARE STEEL (IN)			TUBULAR STEEL Ø (IN)				SIGN FRAME REQUIRED	REMARKS	SIGN DETAIL			
								"A"	"B"	RETAIN	SALVAGE FROM	SALVAGE TO	REMOVE	RETAIN		REMOVE	1.75	2.00	2.50	3.00	3.50	4.00			5.00	DETAIL IN SHS	DETAIL ON SHEET NUMBER	DETAIL ON STD SHEET NUMBER
																	(LB / FT)			(LB / FT)								
WESTON VT 100							FY-FLUORESCENT YELLOW FYG-FLUORESCENT YELLOW GREEN															"SHS"-STANDARD HIGHWAY SIGNS						
NB	1.873	D	R1-1	30	30						1												TH-33, DALE RD					
		D	R1-1	30	30			6.25															X					
NB	2.155	A	W1-2MgL	30	30		MODIFIED LEFT CURVE				1																	
																							INSTALL 650 FEET NORTH OF EXISTING LEFT CURVE ASSEMBLY		7			
NB	2.278	A	W1-2MgL	30	30																							
		D	R1-1	30	30			6.25															X					
NB	2.360	D	R1-1	30	30																		INSTALL AT EXISTING LEGAL LOAD LIMIT LOCATION	X				
		C	VR-017	24	30			5.00															TH-44, FOSTER RD					
		C	VR-017	24	30						+											INSTALL 50' BEYOND EXISTING LOCATION ON TH-44			E-141			
NB	2.360	C	VR-017	24	30																							
NB	2.363	D	R1-1	30	30						1												TH-44, FOSTER RD					
		D	R1-1	30	30			6.25																X				
NB	2.365	A	M3-1S	24	12		NORTH			1																		
		A	M1-5	30	24		VERMONT 100			1																		
		A	M6-2S	21	15		UP LH ARROW			1																		
NB	2.445	A	VD-062AS	72	16		BUSINESS SIGN			1																		
NB	2.530	A	W3-5	36	36		SPEED REDUCTION (40)			1																		
NB	2.662	A	R2-1	24	30		SPEED LIMIT 40				1																	
SIGN SUMMARY SHEET							SHEET TOTALS	30.00	0.00	5	0	0	5	0	0	5	75						PROJECT NAME: Stamford-Andover VT100					
								SF	SF	EA	EA	EA	EA	EA	EA	EA	FT						PROJECT NUMBER: STPG SIGN(20)					
VERMONT AGENCY OF TRANSPORTATION							TOWN TOTALS	774.4	0.0	26.0	12.0	12.0	139	0.0	0.0	140	2100.0						FILE NAME: Weston.xls	PLOT DATE: 8/6/2009				
																						PROJECT MANAGER: N. Avery	DRAWN BY: T. Guazzoni					
																						DESIGNED BY: J. Kelly	CHECKED BY: T. Guazzoni					
																						WESTON SHEET 3	SHEET 174 OF 198					


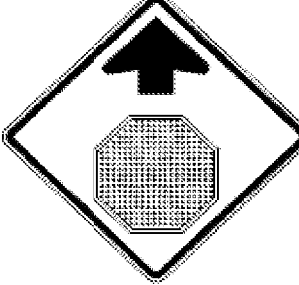

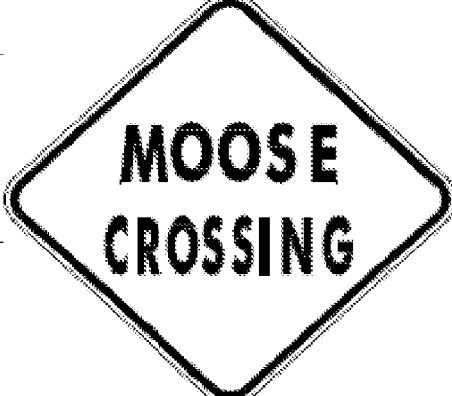

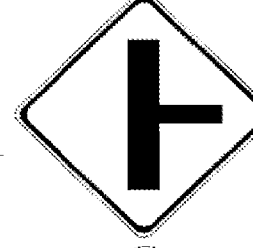

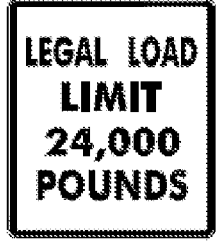
DIRECTION	MILEPOINT	LOCATION CODE (SHEET 2)	SIGN CODE	WIDTH (IN)	HEIGHT (IN)	SHEETING REMARKS	SIGN LEGEND	NEW SIGNS		EXISTING SIGNS			EXIST POST		NUMBER OF NEW POSTS	SQUARE STEEL (IN)			TUBULAR STEEL Ø (IN)				SIGN FRAME REQUIRED	REMARKS	SIGN DETAIL				
								"A"	"B"	RETAIN	SALVAGE FROM	SALVAGE TO	REMOVE	RETAIN		REMOVE	1.75	2.00	2.50	FOUNDATION	3.00	3.50			4.00	5.00	DETAIL IN SHS	DETAIL ON SHEET NUMBER	DETAIL ON STD SHEET NUMBER
																	(LB / FT)				(LB / FT)								
WESTON VT 100							FY-FLUORESCENT YELLOW FYG-FLUORESCENT YELLOW GREEN															"SHS"-STANDARD HIGHWAY SIGNS							
NB	2.668	A	R2-1	30	36			7.50						1	X									INSTALL 30 FEET NORTH OF EXISTING SPEED LIMIT 40 SIGN		6			
NB	2.736	C	VR-017	24	30							1		X										TH-44, PIPER HILL RD					
		C	VR-017	24	30			5.00						1	X											E-141			
NB	2.741	D	R1-1	30	30							1		X										TH-44, PIPER HILL RD					
		D	R1-1	30	30			6.25						1	X											X			
NB	2.767	A	W3-5	36	36		SPEED REDUCTION (30)			1			X																
NB	2.810	A	VD-018	30	18							1		X															
		A	VD-018	30	18			3.75						1	X											E-128A			
NB	2.850	A	R2-1	24	30		SPEED LIMIT 30					1		X															
NB	2.895	A	R2-1	30	36			7.50						1	X									INSTALL 240 FEET NORTH OF EXISTING AND SOUTH OF UTILITY POLE		6			
NB	2.942	A	W11-2	30	30		PEDESTRIAN			1			X																
		A	W16-9	24	12		AHEAD			1																			
NB	3.010	A	R2-1	24	30							1		X															
		A	R2-1	24	30			5.00						1	X											X			
NB	3.052	A	W11-2	30	30		PEDESTRIAN			1			X																
SIGN SUMMARY SHEET							SHEET TOTALS	35.00	0.00	4	0	0	5	0	0	6	90							PROJECT NAME: Stamford-Andover VT100					
								SF	SF	EA	EA	EA	EA	EA	EA	EA	FT							PROJECT NUMBER: STPG SIGN(20)					
VERMONT AGENCY OF TRANSPORTATION							TOWN TOTALS	774.4	0.0	26.0	12.0	12.0	139	0.0	0.0	140	2100.0							FILE NAME: Weston.xls	PLOT DATE: 8/6/2009				
																							PROJECT MANAGER: N. Avery	DRAWN BY: T. Guazzoni					
																							DESIGNED BY: J. Kelly	CHECKED BY: T. Guazzoni					
																							WESTON SHEET 4	SHEET 175 OF 198					


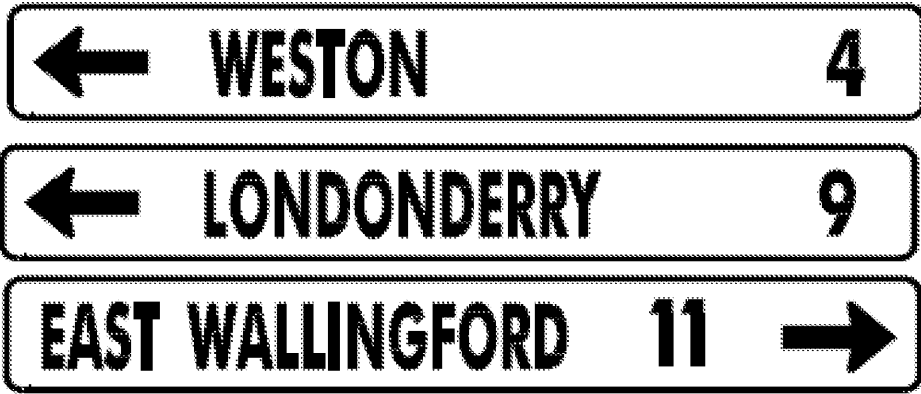
DIRECTION	MILEPOINT	LOCATION CODE (SHEET 2)	SIGN CODE	WIDTH (IN)	HEIGHT (IN)	SHEETING REMARKS	SIGN LEGEND	NEW SIGNS		EXISTING SIGNS			EXIST POST		NUMBER OF NEW POSTS	SQUARE STEEL (IN)			TUBULAR STEEL Ø (IN)				SIGN FRAME REQUIRED	REMARKS	SIGN DETAIL				
								"A"	"B"	RETAIN	SALVAGE FROM	SALVAGE TO	REMOVE	RETAIN		REMOVE	1.75	2.00	2.50	FOUNDATION	3.00	3.50			4.00	5.00	DETAIL IN SHS	DETAIL ON SHEET NUMBER	DETAIL ON STD SHEET NUMBER
																	(LB / FT)				(LB / FT)								
WESTON VT 100							FY-FLUORESCENT YELLOW FYG-FLUORESCENT YELLOW GREEN															"SHS"-STANDARD HIGHWAY SIGNS							
NB	3.052	A	W16-4	24	18		NEXT 1000 FEET			1																			
NB	3.060	C	VR-052L	24	30		NO PARKING (LEFT ARROW)			+			* X														OLD POST WAS REPLACED		
NB	3.075	C	VR-052	24	30		NO PARKING (DOUBLE ARROW)			1 1			X	1			X										RETAIN SIGN, INSTALL ON NEW POST		
NB	3.120	C	VR-052R	12	18		NO PARKING (RIGHT ARROW)			1																	RELOCATE SIGN 35 FEET NORTH		
NB	3.127	C	VR-052R	12	18		NO PARKING (RIGHT ARROW)							1			X										INSTALL 35 FEET NORTH OF EXISTING		
NB	3.155	A	W1-1R	30	30		RIGHT TURN						1																
		A	W13-1	18	18		25 MPH PLAQUE						1																
		C	VR-052L	24	30			5.00						1			X										INSTALL 50 FEET SOUTH OF EXISTING		
NB	3.165	C	VR-052L	24	30		NO PARKING (LEFT ARROW)						1																
NB	3.187	C	VR-017	24	24			5.00					1				X										TH-39, MARKHAM LANE		
		C	VR-017	24	30									1			X										E-141		
NB	3.193	D	R1-1	30	30								1														TH-39, MARKHAM LANE		
		D	R1-1	30	30			6.25						1			X										X		
NB	3.216 3.210	C	VR-052	12	18		NO PARKING (DOUBLE ARROW)			+			* X														THIS SIGN WAS RELOCATED TO NB MM 3.216 RT. WHERE NEW HIDDEN DRIVE RIGHT WAS INSTALLED. SEE SHEET #194		
NB	3.259	A	R2-1	24	30								1				X												
SIGN SUMMARY SHEET							SHEET TOTALS	16.25	0.00	3	4	4	8	0	0	5	75							PROJECT NAME: Stamford-Andover VT100					
VERMONT AGENCY OF TRANSPORTATION							TOWN TOTALS	774.4	0.0	26.0	12.0	12.0	139	0.0	0.0	140	2100.0							PROJECT NUMBER: STPG SIGN(20)					
								SF	SF	EA	EA	EA	EA	EA	EA	EA	FT							FILE NAME: Weston.xls					
																								PLOT DATE: 8/6/2009					
																								DRAWN BY: T. Guazzoni					
																								DESIGNED BY: J. Kelly					
																								CHECKED BY: T. Guazzoni					
																								WESTON SHEET 5					
																								SHEET 176 OF 198					

DIRECTION	MILEPOINT	LOCATION CODE (SHEET 2)	SIGN CODE	WIDTH (IN)	HEIGHT (IN)	SHEETING REMARKS	SIGN LEGEND	NEW SIGNS		EXISTING SIGNS			EXIST POST		NUMBER OF NEW POSTS	SQUARE STEEL (IN)			TUBULAR STEEL Ø (IN)				SIGN FRAME REQUIRED	REMARKS	SIGN DETAIL				
								"A"	"B"	RETAIN	SALVAGE FROM	SALVAGE TO	REMOVE	RETAIN		REMOVE	1.75	2.00	2.50	FOUNDATION	3.00	3.50			4.00	5.00	DETAIL IN SHS	DETAIL ON SHEET NUMBER	DETAIL ON STD SHEET NUMBER
																	(LB / FT)				(LB / FT)								
WESTON VT 100							FY-FLUORESCENT YELLOW FYG-FLUORESCENT YELLOW GREEN															"SHS"-STANDARD HIGHWAY SIGNS							
			A M6-2L	21	15			2.19															GREEN ON WHITE SHEETING	X					
NB	3.405	C	VR-052R	24	30			5.00						1		X							INSTALL PARALLEL TO ROADWAY BESIDE ROUTE MARKER ASSEMBLY		7				
NB	3.435	C	VR-017	24	24							1		X									TH-1, CHESTER MOUNTAIN RD			E-141			
NB	3.435	D	R1-1	30	30							1		X									TH-1, CHESTER MOUNTAIN RD						
		D	R1-1	30	30			6.25						1		X									X				
NB	3.465	A	R2-1	24	30							1		X											X				
		A	R2-1	24	30			5.00						1		X									X				
NB	3.517	A	M3-1S	24	12		NORTH			1			X																
		A	M1-5	30	24		VERMONT 100			1																			
NB	3.670	A	R2-1	24	30							1		X											X				
		A	R2-1	24	30			5.00						1		X									X				
NB	3.973	C	VR-017	24	24							1		X									TH-20, BURTON RD			E-141			
		C	VR-017	24	30			5.00						1		X													
NB	3.979	D	R1-1	30	30							1		X									TH-20, BURTON RD						
SIGN SUMMARY SHEET							SHEET TOTALS	33.44	0.00	2	0	0	6	0	0	6	90							PROJECT NAME: Stamford-Andover VT100					
								SF	SF	EA	EA	EA	EA	EA	EA	EA	FT							PROJECT NUMBER: STPG SIGN(20)					
VERMONT AGENCY OF TRANSPORTATION							TOWN TOTALS	774.4	0.0	26.0	12.0	12.0	139	0.0	0.0	140	2100.0							FILE NAME: Weston.xls	PLOT DATE: 8/6/2009				
																							PROJECT MANAGER: N. Avery	DRAWN BY: T. Guazzoni					
																							DESIGNED BY: J. Kelly	CHECKED BY: T. Guazzoni					
																							WESTON SHEET 7	SHEET 178 OF 198					







DIRECTION	MILEPOINT	LOCATION CODE (SHEET 2)	SIGN CODE	WIDTH (IN)	HEIGHT (IN)	SHEETING REMARKS	SIGN LEGEND	NEW SIGNS		EXISTING SIGNS			EXIST POST		NUMBER OF NEW POSTS	SQUARE STEEL (IN)			TUBULAR STEEL Ø (IN)				SIGN FRAME REQUIRED	REMARKS	SIGN DETAIL				
								"A"	"B"	RETAIN	SALVAGE FROM	SALVAGE TO	REMOVE	RETAIN		REMOVE	1.75	2.00	2.50	3.00	3.50	4.00			5.00	DETAIL IN SHS	DETAIL ON SHEET NUMBER	DETAIL ON STD SHEET NUMBER	
																	(LB / FT)			(LB / FT)									
WESTON VT 100							FY-FLUORESCENT YELLOW FYG-FLUORESCENT YELLOW GREEN															"SHS"-STANDARD HIGHWAY SIGNS							
			D R1-1	30	30		 	6.25			I	I			1		X							X					
NB	4.552		C VR-017	24	30								1				X								TH-56, MAPLE HILL RD				
			C VR-017	24	30			5.00							1		X									E-141			
NB	4.558		D R1-1	30	30								1				X								TH-56, MAPLE HILL RD				
			D R1-1	30	30			6.25							1		X							X					
NB	5.005		A VD-062B	72	16		BUSINESS SIGN			1				X															
			A VD-062AS	72	16		BUSINESS SIGN			1																			
NB	5.225		A R2-1	24	30		SPEED LIMIT 50						1				X												
								5.00							1		X							X		INSTALL 400 FEET NORTH OF EXISTING SPEED LIMIT 50 SIGN			
NB	5.472		C VR-017	24	30								1				X								TH-15, FELTON RD				
			C VR-017	24	30			5.00							1		X									E-141			
NB	5.478		D R1-1	30	30								1				X								TH-15, FELTON RD				
			D R1-1	30	30			6.25							1		X							X					
NB	5.975		C VR-017	24	30								1				X								TH-14, KILE RD				
			C VR-017	24	30			5.00							1		X									E-141			
SIGN SUMMARY SHEET							SHEET TOTALS	38.75	0.00	2	0	0	6	0	0	7	105												
VERMONT AGENCY OF TRANSPORTATION							TOWN TOTALS	774.4	0.0	26.0	12.0	12.0	139	0.0	0.0	140	2100.0												
															PROJECT NAME:	Stamford-Andover VT100													
															PROJECT NUMBER:	STPG SIGN(20)													
															FILE NAME:	Weston.xls					PLOT DATE:	8/6/2009							
															PROJECT MANAGER:	N. Avery					DRAWN BY:	T. Guazzoni							
															DESIGNED BY:	J. Kelly					CHECKED BY:	T. Guazzoni							
															WESTON SHEET 8						SHEET	179 OF 198							







DIRECTION	MILEPOINT	LOCATION CODE (SHEET 2)	SIGN CODE	WIDTH (IN)	HEIGHT (IN)	SHEETING REMARKS	SIGN LEGEND	NEW SIGNS		EXISTING SIGNS			EXIST POST		NUMBER OF NEW POSTS	SQUARE STEEL (IN)			TUBULAR STEEL Ø (IN)				SIGN FRAME REQUIRED	REMARKS	SIGN DETAIL				
								"A"	"B"	RETAIN	SALVAGE FROM	SALVAGE TO	REMOVE	RETAIN		REMOVE	1.75	2.00	2.50	FOUNDATION	3.00	3.50			4.00	5.00	DETAIL IN SHS	DETAIL ON SHEET NUMBER	DETAIL ON STD SHEET NUMBER
																	(LB / FT)				(LB / FT)								
WESTON VT 100							FY-FLUORESCENT YELLOW FYG-FLUORESCENT YELLOW GREEN															"SHS"-STANDARD HIGHWAY SIGNS							
NB	5.981	D	R1-1	30	30		 				1												TH-14, KILE RD						
		D	R1-1	30	30				6.25					1		X							X						
NB	6.420	A	M2-1	21	15																		INSTALL 200 FEET SOUTH OF EXISTING JCT VT-155 ASSEMBLY. GREEN ON WHITE SHEETING						
		A	M1-5	30	24				2.19					1		X								X			E-136B		
NB	6.460	A	M2-1	21	15		JCT				1																		
		A	M1-5	30	24		VERMONT 155				1																		
		A	W1-1MbR	36	36	FY	 																		6				
		A	W13-1	24	24	FY			9.00					2		X								INSTALL ON LEFT POST	X				
NB	6.505	A	D1-1A	72	10		 				1																		
		A	D1-1A	72	10							1																	
		A	D1-1A	72	12				6.00					2		X										5			
		A	D1-1A	72	12				6.00																	5			
NB	6.540	A	M3-1S	24	12						1																		
		A	M1-5	30	24						1																		
		A	M6-3S	21	15						1																		
SIGN SUMMARY SHEET							SHEET TOTALS	38.44	0.00	0	0	0	8	0	0	6	90						PROJECT NAME: Stamford-Andover VT100						
VERMONT AGENCY OF TRANSPORTATION							TOWN TOTALS	774.4	0.0	26.0	12.0	12.0	139	0.0	0.0	140	2100.0						PROJECT NUMBER: STPG SIGN(20)						
																						FILE NAME: Weston.xls PLOT DATE: 8/6/2009							
																						PROJECT MANAGER: N. Avery DRAWN BY: T. Guazzoni							
																						DESIGNED BY: J. Kelly CHECKED BY: T. Guazzoni							
																						WESTON SHEET 9 SHEET 180 OF 198							




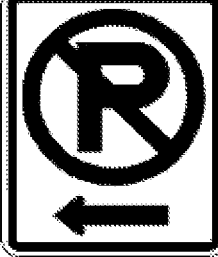
DIRECTION	MILEPOINT	LOCATION CODE (SHEET 2)	SIGN CODE	WIDTH (IN)	HEIGHT (IN)	SHEETING REMARKS	SIGN LEGEND	NEW SIGNS		EXISTING SIGNS			EXIST POST		NUMBER OF NEW POSTS	SQUARE STEEL (IN)			TUBULAR STEEL Ø (IN)				SIGN FRAME REQUIRED	REMARKS	SIGN DETAIL				
								"A"	"B"	RETAIN	SALVAGE FROM	SALVAGE TO	REMOVE	RETAIN		REMOVE	1.75	2.00	2.50	FOUNDATION	3.00	3.50			4.00	5.00	DETAIL IN SHS	DETAIL ON SHEET NUMBER	DETAIL ON STD SHEET NUMBER
																	(LB / FT)				(LB / FT)								
WESTON VT 100							FY-FLUORESCENT YELLOW FYG-FLUORESCENT YELLOW GREEN															"SHS"-STANDARD HIGHWAY SIGNS							
			A M1-5	30	24			5.00															INSTALL ON LEFT POST			E-136B			
NB	6.630		A D2-1	72	10		LUDLOW 7					1	X																
NB	6.720		A R2-1	24	30							1	X																
			A R2-1	24	30			5.00						1	X								X						
NB	6.760		B W3-1	36	36							1	X																
			B W3-1	36	36			9.00						2	X														
NB	6.910		A VW-000	30	30							1	X																
			A W7-3A	24	18							1																	
			A VW-000	30	30			6.25						1	X										E-153				
			A W7-3A	24	18			3.00															X						
NB	7.010		A S3-1	30	30							1	X																
			A W2-2MaR	30	30			6.25						2	X									6					
			A S3-1	30	30		NOT INSTALLED HERE, SEE SHEET # 139.	-6.25															X						
NB	7.101		C VR-017	24	30							1	X																
			C VR-017	24	30			5.00						1	X										E-141				
SIGN SUMMARY SHEET							SHEET TOTALS	39.50 45.75	0.00	0	0	0	7	0	0	7	105												
VERMONT AGENCY OF TRANSPORTATION							TOWN TOTALS	774.4	0.0	26.0	12.0	12.0	139	0.0	0.0	140	2100.0												
PROJECT NAME: Stamford-Andover VT100																					PROJECT NUMBER: STPG SIGN(20)								
FILE NAME: Weston.xls												PLOT DATE: 8/6/2009																	
PROJECT MANAGER: N. Avery												DRAWN BY: T. Guazzoni																	
DESIGNED BY: J. Kelly												CHECKED BY: T. Guazzoni																	
WESTON SHEET 11												SHEET 182 OF 198																	





DIRECTION	MILEPOINT	LOCATION CODE (SHEET 2)	SIGN CODE	WIDTH (IN)	HEIGHT (IN)	SHEETING REMARKS	SIGN LEGEND	NEW SIGNS		EXISTING SIGNS				EXIST POST		NUMBER OF NEW POSTS	SQUARE STEEL (IN)			TUBULAR STEEL Ø (IN)				SIGN FRAME REQUIRED	REMARKS	SIGN DETAIL			
								"A"	"B"	RETAIN	SALVAGE FROM	SALVAGE TO	REMOVE	RETAIN	REMOVE		1.75	2.00	2.50	3.00	3.50	4.00	5.00			DETAIL IN SHS	DETAIL ON SHEET NUMBER	DETAIL ON STD SHEET NUMBER	
																	(LB / FT)			(LB / FT)									
WESTON VT 100							FY-FLUORESCENT YELLOW FYG-FLUORESCENT YELLOW GREEN															"SHS"-STANDARD HIGHWAY SIGNS							
			F	M2-1	21	15		2.19							1	X								GREEN ON WHITE SHEETING	X				
			F	M1-5	30	24		5.00																			E-136B		
SB	6.675		F	D1-1A	72	10							1	X															
			F	D1-1A	72	10							1																
			F	D1-1A	72	10							1																
			F	D1-1A	72	12		6.00							2	X											5		
			F	D1-1A	72	12		6.00																			5		
			F	D1-1A	72	12		6.00																			5		
SB	6.600		F	M3-3S	24	12						1	X																
			F	M1-5	30	24						1																	
			F	M6-1S	21	15						1																	
			F	M3-1S	24	12						1																	
			F	M1-5	30	24						1																	
			F	M6-1S	21	15						1																	
			F	M3-3	24	12								2	X							#2B	GREEN ON WHITE SHEETING	X		7			
SIGN SUMMARY SHEET							SHEET TOTALS	27.19	0.00	0	0	0	9	0	0	5	75							PROJECT NAME: Stamford-Andover VT100					
VERMONT AGENCY OF TRANSPORTATION								SF	SF	EA	EA	EA	EA	EA	EA	EA	FT							PROJECT NUMBER: STPG SIGN(20)					
TOWN TOTALS							774.4	0.0	26.0	12.0	12.0	139	0.0	0.0	140	2100.0								FILE NAME: Weston.xls	PLOT DATE: 8/6/2009				
																								PROJECT MANAGER: N. Avery	DRAWN BY: T. Guazzoni				
																									DESIGNED BY: J. Kelly	CHECKED BY: T. Guazzoni			
																									WESTON SHEET 13	SHEET 184 OF 198			









DIRECTION	MILEPOINT	LOCATION CODE (SHEET 2)	SIGN CODE	WIDTH (IN)	HEIGHT (IN)	SHEETING REMARKS	SIGN LEGEND	NEW SIGNS		EXISTING SIGNS			EXIST POST		NUMBER OF NEW POSTS	SQUARE STEEL (IN)			TUBULAR STEEL Ø (IN)				SIGN FRAME REQUIRED	REMARKS	SIGN DETAIL				
								"A"	"B"	RETAIN	SALVAGE FROM	SALVAGE TO	REMOVE	RETAIN		REMOVE	1.75	2.00	2.50	FOUNDATION	3.00	3.50			4.00	5.00	DETAIL IN SHS	DETAIL ON SHEET NUMBER	DETAIL ON STD SHEET NUMBER
																	(LB / FT)				(LB / FT)								
WESTON VT 100							FY-FLUORESCENT YELLOW FYG-FLUORESCENT YELLOW GREEN															"SHS"-STANDARD HIGHWAY SIGNS							
			F M1-5	30	24			5.00																		E-136B			
			F M6-1L	21	15			2.19																GREEN ON WHITE SHEETING	X				
			F M3-1	24	12			2.00																GREEN ON WHITE SHEETING	X				
			F M1-5	30	24			5.00																		E-136B			
			F M6-1R	21	15			2.19																GREEN ON WHITE SHEETING	X				
SB 6.565			F R1-1	30	30						1		X											VT-155 INTERSECTION					
			F R1-1	36	36			9.00						2		X									X				
SB 6.550			G W1-7	48	24						1		X																
			G W1-7	48	24	FY		8.00						2		X									X				
SB 6.520			F M3-3S	24	12						1		X																
			F M1-5	30	24						1																		
			F M3-3	24	12			2.00						1		X								GREEN ON WHITE SHEETING	X				
			F M1-5	30	24			5.00																		E-136B			
SB 6.495			F R2-1	24	30						1		X																
			F R2-1	24	30			5.00						1		X									X				
SIGN SUMMARY SHEET							SHEET TOTALS	45.38	0.00	0	0	0	5	0	0	6	90							PROJECT NAME: Stamford-Andover VT100					
VERMONT AGENCY OF TRANSPORTATION							TOWN TOTALS	774.4	0.0	26.0	12.0	12.0	139	0.0	0.0	140	2100.0							PROJECT NUMBER: STPG SIGN(20)					
																								FILE NAME: Weston.xls	PLOT DATE: 8/6/2009				
																									PROJECT MANAGER: N. Avery	DRAWN BY: T. Guazzoni			
																									DESIGNED BY: J. Kelly	CHECKED BY: T. Guazzoni			
																										WESTON SHEET 14	SHEET 185 OF 198		








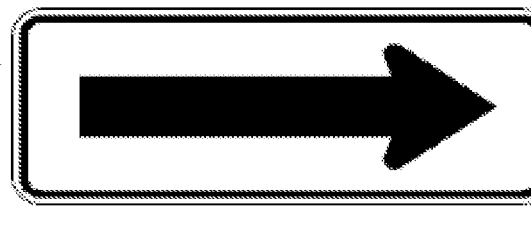

DIRECTION	MILEPOINT	LOCATION CODE (SHEET 2)	SIGN CODE	WIDTH (IN)	HEIGHT (IN)	SHEETING REMARKS	SIGN LEGEND	NEW SIGNS		EXISTING SIGNS			EXIST POST		NUMBER OF NEW POSTS	SQUARE STEEL (IN)			TUBULAR STEEL Ø (IN)				SIGN FRAME REQUIRED	REMARKS	SIGN DETAIL				
								"A"	"B"	RETAIN	SALVAGE FROM	SALVAGE TO	REMOVE	RETAIN		REMOVE	1.75	2.00	2.50	FOUNDATION	3.00	3.50			4.00	5.00	DETAIL IN SHS	DETAIL ON SHEET NUMBER	DETAIL ON STD SHEET NUMBER
																	(LB / FT)				(LB / FT)								
WESTON VT 100							FY-FLUORESCENT YELLOW FYG-FLUORESCENT YELLOW GREEN															"SHS"-STANDARD HIGHWAY SIGNS							
SB	6.455	F	D2-1	72	10						1			X															
		F	D2-1	72	10						1																		
		F	D2-1	72	12			6.00							2		X							5					
		F	D2-1	72	12			6.00																5					
SB	5.920	F	VR-017	24	30						1			X									TH-55, STEVENS LOOP (NORTH)						
		F	VR-017	24	30			5.00							1	X									E-141				
SB	5.915	F	R1-1	30	30						1			X									TH-55, STEVENS LOOP (NORTH)						
		F	R1-1	30	30			6.25							1	X								X					
SB	5.750	F	VR-017	24	30						1			X									TH-55, STEVENS LOOP (SOUTH)						
		F	VR-017	24	30			5.00							1	X									E-141				
SB	5.740	F	R1-1	30	30						1			X									TH-55, STEVENS LOOP (SOUTH)						
		F	R1-1	30	30			6.25							1	X								X					
SB	5.288	F	VW-054R	30	30		HIDDEN DRIVE RIGHT			1				X															
SB	5.110	F	VD-062B	72	16		BUSINESS SIGN			1				X															
SB	5.080	F	R2-1	24	30		SPEED LIMIT 50				1			X															
SIGN SUMMARY SHEET							SHEET TOTALS	34.50	0.00	2	0	0	7	0	0	6	90					PROJECT NAME: Stamford-Andover VT100							
VERMONT AGENCY OF TRANSPORTATION							TOWN TOTALS	774.4	0.0	26.0	12.0	12.0	139	0.0	0.0	140	2100.0					PROJECT NUMBER: STPG SIGN(20)							
								SF	SF	EA	EA	EA	EA	EA	EA	EA	FT					FILE NAME: Weston.xls	PLOT DATE: 8/6/2009						
																						PROJECT MANAGER: N. Avery	DRAWN BY: T. Guazzoni						
																						DESIGNED BY: J. Kelly	CHECKED BY: T. Guazzoni						
																						WESTON SHEET 15	SHEET 186 OF 198						

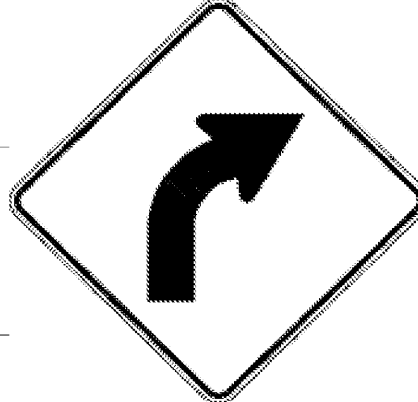

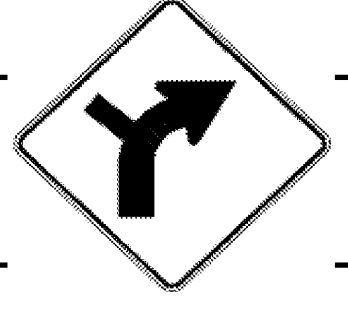

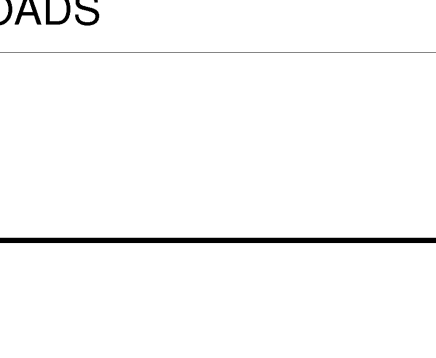

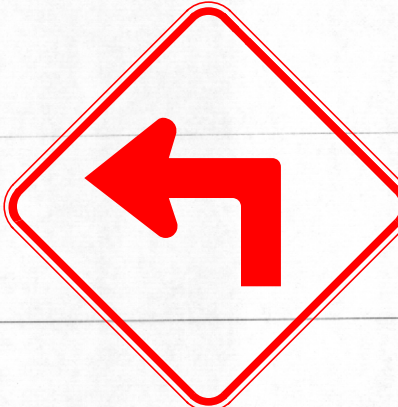


DIRECTION	MILEPOINT	LOCATION CODE (SHEET 2)	SIGN CODE	WIDTH (IN)	HEIGHT (IN)	SHEETING REMARKS	SIGN LEGEND	NEW SIGNS		EXISTING SIGNS			EXIST POST		NUMBER OF NEW POSTS	SQUARE STEEL (IN)			TUBULAR STEEL Ø (IN)				SIGN FRAME REQUIRED	REMARKS	SIGN DETAIL				
								"A"	"B"	RETAIN	SALVAGE FROM	SALVAGE TO	REMOVE	RETAIN		REMOVE	1.75	2.00	2.50	FOUNDATION	3.00	3.50			4.00	5.00	DETAIL IN SHS	DETAIL ON SHEET NUMBER	DETAIL ON STD SHEET NUMBER
																	(LB / FT)				(LB / FT)								
WESTON VT 100							FY-FLUORESCENT YELLOW FYG-FLUORESCENT YELLOW GREEN															"SHS"-STANDARD HIGHWAY SIGNS							
SB	5.038	G	VR-017	24	24						1		X										TH-22, GREENDALE RD						
		G	VR-017	24	30			5.00							1	X										E-141			
SB	5.032	H	R1-1	30	30						1		X										TH-22, GREENDALE RD						
		H	R1-1	30	30			6.25							1	X									X				
SB	5.020	F	R2-1	24	30			5.00						1	X								INSTALL 80 FEET SOUTH OF INTERSECTION	X					
SB	3.836	F	W3-5	36	36		SPEED REDUCTION (40)			1				2	X								RELOCATED 50 FEET NORTH OF EXISTING						
SB	3.827	F	W3-5	36	36		SPEED REDUCTION (40)			1																			
SB	3.715	F	VD-018	30	18						1		X																
		F	VD-018	30	18			3.75							1	X										E-128A			
SB	3.670	F	R2-1	24	30						1		X																
		F	R2-1	30	36			7.50							1	X										6			
SB	3.620	F	VD-062AS	72	16		BUSINESS SIGN			1			X																
SB	3.560	F	W3-5	36	36		SPEED REDUCTION (30)			1			X																
SB	3.522	F	W11-2YG	30	30		PEDESTRIAN			1			X																
		F	W16-9YG	24	12		AHEAD			1																			
SIGN SUMMARY SHEET							SHEET TOTALS	27.50	0.00	4	1	1	4	0	0	7	105							PROJECT NAME: Stamford-Andover VT100					
VERMONT AGENCY OF TRANSPORTATION							TOWN TOTALS	774.4	0.0	26.0	12.0	12.0	139	0.0	0.0	140	2100.0							PROJECT NUMBER: STPG SIGN(20)					
								SF	SF	EA	EA	EA	EA	EA	EA	EA	FT							FILE NAME: Weston.xls	PLOT DATE: 8/6/2009				
																								PROJECT MANAGER: N. Avery	DRAWN BY: T. Guazzoni				
																									DESIGNED BY: J. Kelly	CHECKED BY: T. Guazzoni			
																									WESTON SHEET 16	SHEET 187 OF 198			

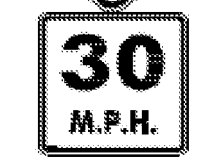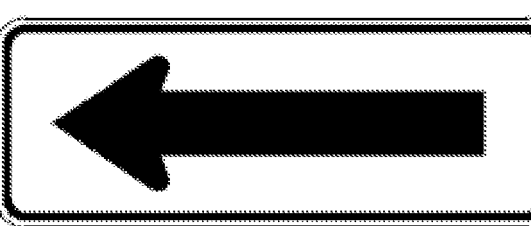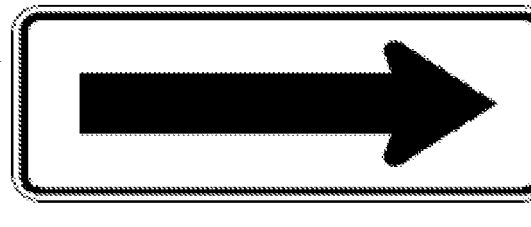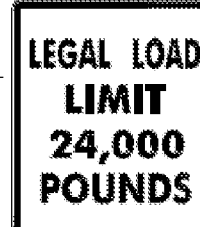DIRECTION	MILEPOINT	LOCATION CODE (SHEET 2)	SIGN CODE	WIDTH (IN)	HEIGHT (IN)	SHEETING REMARKS	SIGN LEGEND	NEW SIGNS		EXISTING SIGNS			EXIST POST		NUMBER OF NEW POSTS	SQUARE STEEL (IN)			TUBULAR STEEL Ø (IN)				SIGN FRAME REQUIRED	REMARKS	SIGN DETAIL			
								"A"	"B"	RETAIN	SALVAGE FROM	SALVAGE TO	REMOVE	RETAIN		REMOVE	1.75	2.00	2.50	3.00	3.50	4.00			5.00	DETAIL IN SHS	DETAIL ON SHEET NUMBER	DETAIL ON STD SHEET NUMBER
																	(LB / FT)			(LB / FT)								
WESTON VT 100							FY-FLUORESCENT YELLOW FYG-FLUORESCENT YELLOW GREEN															"SHS"-STANDARD HIGHWAY SIGNS						
SB	3.467	F	R2-1	24	30						1		X															
		F	R2-1	30	36			7.50						1	X										6			
SB	3.467	F	D1-1A	54	7.5						1		X															
		F	D1-1A	72	10 12			6.00						2	X										5			
SB	3.380	F	R2-1	24	30						1		X															
		F	R2-1	24 30	30 36			7.50 5.00						1	X										X			
SB	3.345	G	VR-052L	24	30			5.00						1	X										7			
SB	3.335	F	W1-1L	30	30		LEFT TURN				1		X															
		F	W13-1	18	18		25 MPH PLAQUE				1																	
		G	VR-052L	12	18		NO PARKING (LEFT ARROW)				1																	
		F	W11-2YG	30	30		PEDESTRIAN				1			1	X										SALVAGED FROM M.P. 3.298			
		F	W16-4YG	24	18		NEXT 1000 FEET				1																	
SB	3.298	F	W11-2YG	30	30		PEDESTRIAN				1		X															
		F	W16-4YG	24	18		NEXT 1000 FEET				1														THIS ASSEMBLY WAS REMOVED AGAIN AND REINSTALLED ON 4/26/11 WITH THE HIDDEN DRIVE LEFT SIGN BEING ADDED PER REQUEST OF M. MILLER, TRAFFIC OPS. SEE SHEET * 194			
		F	W1-1L	30	30			6.25						1	X										X			
SIGN SUMMARY SHEET							SHEET TOTALS	32.25 29.75	0.00	0	2	2	6	0	0	7	105						PROJECT NAME: Stamford-Andover VT100					
								SF	SF	EA	EA	EA	EA	EA	EA	EA	FT						PROJECT NUMBER: STPG SIGN(20)					
VERMONT AGENCY OF TRANSPORTATION							TOWN TOTALS	774.4	0.0	26.0	12.0	12.0	139	0.0	0.0	140	2100.0						FILE NAME: Weston.xls	PLOT DATE: 8/6/2009				
																							PROJECT MANAGER: N. Avery	DRAWN BY: T. Guazzoni				
																							DESIGNED BY: J. Kelly	CHECKED BY: T. Guazzoni				
																							WESTON SHEET 17	SHEET 188 OF 198				

DIRECTION	MILEPOINT	LOCATION CODE (SHEET 2)	SIGN CODE	WIDTH (IN)	HEIGHT (IN)	SHEETING REMARKS	SIGN LEGEND	NEW SIGNS		EXISTING SIGNS			EXIST POST		NUMBER OF NEW POSTS	SQUARE STEEL (IN)			TUBULAR STEEL Ø (IN)				SIGN FRAME REQUIRED	REMARKS	SIGN DETAIL				
								"A"	"B"	RETAIN	SALVAGE FROM	SALVAGE TO	REMOVE	RETAIN		REMOVE	1.75	2.00	2.50	FOUNDATION	3.00	3.50			4.00	5.00	DETAIL IN SHS	DETAIL ON SHEET NUMBER	DETAIL ON STD SHEET NUMBER
																	(LB / FT)				(LB / FT)								
WESTON VT 100							FY-FLUORESCENT YELLOW FYG-FLUORESCENT YELLOW GREEN															"SHS"-STANDARD HIGHWAY SIGNS							
SB	3.155	H	R1-1	30	30		 				1												TH-2, LAWRENCE HILL RD						
		H	R1-1	30	30			6.25						1		X								INTERSECTION ISLAND	X				
SB	3.155	F	D1-1	54	7.5		LANDGROVE --->				1																		
		F	D1-1G	54	7.5		HAPGOOD POND --->				1																		
		E	D1-1	54	7.5		<--- LANDGROVE				1																		
		E	D1-1G	54	7.5		<--- HAPGOOD POND				1																		
SB	3.155	G	VR-052R	24	30		NO PARKING (RIGHT ARROW)																NEW STOP INSTALL ON EXISTING- DESTINATION SIGN POST - SEE SB MM 3.150						
SB	3.150	D	R1-1	30	30																		SALVAGED NO PARKING (RIGHT ARROW) TO HERE.						
		D	R1-1	30	30			6.25						1		X									X				
SB	3.110	F	M3-3S	24	12		SOUTH			1	1				X	1		X					RETAIN ROUTE MARKER SIGNS AND REPLACE POST						
		F	M1-5	30	24		VERMONT100			1	1																		
		C	VR-660	12	18		NO PARKING ON TRAVEL WAY				1																		
SB	3.030	F	R2-1	24	30						1				X														
		F	R2-1	24	30			5.00						1		X									X				
SB	3.020	G	VR-052L	24	30						1				X														
SIGN SUMMARY SHEET							SHEET TOTALS	17.50	0.00	0	3	3	9	0	0	4	60						PROJECT NAME: Stamford-Andover VT100						
VERMONT AGENCY OF TRANSPORTATION							TOWN TOTALS	774.4	0.0	26.0	12.0	12.0	139	0.0	0.0	140	2100.0						PROJECT NUMBER: STPG SIGN(20)						
								SF	SF	EA	EA	EA	EA	EA	EA	EA	FT						FILE NAME: Weston.xls	PLOT DATE: 8/6/2009					
																						PROJECT MANAGER: N. Avery	DRAWN BY: T. Guazzoni						
																						DESIGNED BY: J. Kelly	CHECKED BY: T. Guazzoni						
																						WESTON SHEET 19	SHEET 190 OF 198						

DIRECTION	MILEPOINT	LOCATION CODE (SHEET 2)	SIGN CODE	WIDTH (IN)	HEIGHT (IN)	SHEETING REMARKS	SIGN LEGEND	NEW SIGNS		EXISTING SIGNS				EXIST POST		NUMBER OF NEW POSTS	SQUARE STEEL (IN)			TUBULAR STEEL Ø (IN)				SIGN FRAME REQUIRED	REMARKS	SIGN DETAIL					
								"A"	"B"	RETAIN	SALVAGE FROM	SALVAGE TO	REMOVE	RETAIN	REMOVE		(LB / FT)			(LB / FT)						DETAIL IN SHS	DETAIL ON SHEET NUMBER	DETAIL ON STD SHEET NUMBER			
																	1.75	2.00	2.50	3.00	3.50	4.00	5.00								
WESTON VT 100							FY-FLUORESCENT YELLOW FYG-FLUORESCENT YELLOW GREEN																"SHS"-STANDARD HIGHWAY SIGNS								
			F W13-1	18	18																										
			F W1-2R	30	30				6.25																					X	
			F W13-1	18	18				2.25																					X	
SB	1.035		F VW-054R	30	30		HIDDEN DRIVE RIGHT																								
																															
SB	0.997		F VW-054R	30	30				6.25																						
SB	0.935		F VW-054R	30	30		HIDDEN DRIVE RIGHT																								
																															
SB	0.827		F W1-2R	30	30			RIGHT CURVE																							
SB	0.750		F W1-10R	30	30			6.25																							
																															
SB	0.625		F VW-054R	30	30			HIDDEN DRIVE RIGHT																							
SB	0.565		F VW-054R	30	30			6.25																							
																															
SB	0.537		F VW-081L	30	30			TRUCKS ENTERING																							
SB	0.500		F VW-081L	30	30			6.25																							
																															
SB	0.460		F W1-1ML	30	30			LEFT TURN WITH CROSSROADS																							
																															
			F W13-1	18	18			30 MPH PLAQUE																							
SB	0.435		F S3-1	30	30		SCHOOL BUS STOP AHEAD																								
SIGN SUMMARY SHEET							SHEET TOTALS		33.50	0.00	0	0	0	9	0	0	5	75													
							SF	SF	EA	EA	EA	EA	EA	EA	EA	EA	EA	EA	FT												
VERMONT AGENCY OF TRANSPORTATION							TOWN TOTALS		774.4	0.0	26.0	12.0	12.0	139	0.0	0.0	140	2100.0													
PROJECT NAME: Stamford-Andover VT100																					DETAIL IN SHS			DETAIL ON SHEET NUMBER			DETAIL ON STD SHEET NUMBER				
PROJECT NUMBER: STPG SIGN(20)																					FILE NAME: Weston.xls			PLOT DATE: 8/6/2009							
DESIGNED BY: J. Kelly																					DRAWN BY: T. Guazzoni			CHECKED BY: T. Guazzoni							
WESTON SHEET 21																					SHEET 192 OF 198										

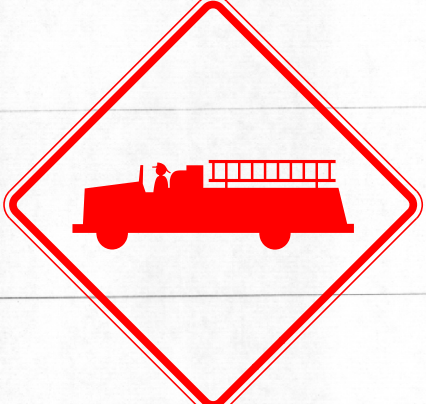
DIRECTION	MILEPOINT	LOCATION CODE (SHEET 2)	SIGN CODE	WIDTH (IN)	HEIGHT (IN)	SHEETING REMARKS	SIGN LEGEND	NEW SIGNS		EXISTING SIGNS			EXIST POST		NUMBER OF NEW POSTS	SQUARE STEEL (IN)			TUBULAR STEEL Ø (IN)				SIGN FRAME REQUIRED	REMARKS	SIGN DETAIL				
								"A"	"B"	RETAIN	SALVAGE FROM	SALVAGE TO	REMOVE	RETAIN		REMOVE	1.75	2.00	2.50	FOUNDATION	3.00	3.50			4.00	5.00	DETAIL IN SHS	DETAIL ON SHEET NUMBER	DETAIL ON STD SHEET NUMBER
																	(LB / FT)				(LB / FT)								
WESTON VT 100							FY-FLUORESCENT YELLOW FYG-FLUORESCENT YELLOW GREEN															"SHS"-STANDARD HIGHWAY SIGNS							
			F S3-1	30	30										1		X							X					
SB	0.397		F W1-1MdL	30	30	FY									1		X								6				
			F W13-1	18	18	FY																		X					
SB	0.370		F W1-6	48	24							I		X															
			F W1-6	48	24	FY									2		X							X					
SB	0.355		E W1-6	48	24							I		X															
			E W1-6	48	24	FY									2		X							X					
SB	0.343		G VR-017	24	30								1		X														
			G VR-017	24	30										1		X								E-141				
SB	0.337		H R1-1	30	30		JOHNSON HILL RD						1		X														
			H R1-1	30	30											1		X							X				
SB	0.345		E W1-6	48	24							I		X															
			E W1-6	48	24	FY									2		X							X					
SB	0.335		F W1-6	48	24							I		X															
			F W1-6	48	24	FY									2		X							X					
SIGN SUMMARY SHEET							SHEET TOTALS		58.00	0.00	0	0	0	6	2	0	0	12	180										
VERMONT AGENCY OF TRANSPORTATION							SF	SF	EA	EA	EA	EA	EA	EA	EA	EA	EA	EA	EA	EA	EA	EA	EA	EA	EA	EA	EA		
							TOWN TOTALS		774.4	0.0	26.0	12.0	12.0	139	0.0	0.0	140	2100.0											
PROJECT NAME: Stamford-Andover VT100																					PROJECT NUMBER: STPG SIGN(20)								
FILE NAME: Weston.xls												PLOT DATE: 8/6/2009																	
PROJECT MANAGER: N. Avery												DRAWN BY: T. Guazzoni																	
DESIGNED BY: J. Kelly												CHECKED BY: T. Guazzoni																	
WESTON SHEET 22												SHEET 193 OF 198																	

DIRECTION	MILEPOINT	LOCATION CODE (SHEET 2)	SIGN CODE	WIDTH (IN)	HEIGHT (IN)	SHEETING REMARKS	SIGN LEGEND	NEW SIGNS		EXISTING SIGNS				EXIST POST		NUMBER OF NEW POSTS	SQUARE STEEL (IN)			TUBULAR STEEL Ø (IN)				SIGN FRAME REQUIRED	REMARKS	SIGN DETAIL		
								"A"	"B"	RETAIN	SALVAGE FROM	SALVAGE TO	REMOVE	RETAIN	REMOVE		1.75	2.00	2.50	3.00	3.50	4.00	5.00			DETAIL IN SHS	DETAIL ON SHEET NUMBER	DETAIL ON STD SHEET NUMBER
																	(LB / FT)			(LB / FT)								
WESTON VT 100							FY-FLUORESCENT YELLOW FYG-FLUORESCENT YELLOW GREEN															"SHS"-STANDARD HIGHWAY SIGNS						
SB	0.145	F	VW-060	30	30	HIDDEN DRIVES																						
SB	0.100	F	VW-202	30	30																							
		F	VW-060	30	30																							
		F	VW-202	30	30																							
NB	3.216	A	VW-054	30	30			6.25																				
		C	VR-052	12	18																							
NB	3.384	A	WII-8	30	30																							
SB	3.298	F	VW-054	30	30			6.25																				
		F	WI-IL	30	30																							
		F	WI3-1	18	18																							
SB	3.220	G	VR-052	12	18			1.50																				
SIGN SUMMARY SHEET							SHEET TOTALS	26.50 12.50	0.00	1	2	2	4	0	0	4	30											
VERMONT AGENCY OF TRANSPORTATION							TOWN TOTALS	774.4	0.0	26.0	12.0	12.0	139	0.0	0.0	140	2100.0											
PROJECT NAME: Stamford-Andover VT100																					PROJECT NUMBER: STPG SIGN(20)							
FILE NAME: Weston.xls															PLOT DATE: 8/6/2009													
PROJECT MANAGER: N. Avery															DRAWN BY: T. Guazzoni													
DESIGNED BY: J. Kelly															CHECKED BY: T. Guazzoni													
WESTON SHEET 23															SHEET 194 OF 198													

Requested by: LEAH B. TRAFFIC COUNTS Action: Actual
 W.O. No.: 09-433
 W.O. Date: 10/10/09
 Page 1 of 4

Vermont Agency of Transportation
TRAFFIC SHOP WORKORDER

Route: N-100 Street Range: TR-#3650 Route 100
 Town(s): Lowell (Town) Lowell (County) VT T.I.: T.C.

ID No.	Dir.	M.P.	L	Sign Code	Color	Sign Size	Action	Legend of New Sign	Legend of Existing Sign	Installation Information	New Posts Installed
	NB	2.355	A	N13-S	8x4	36"	NEW			SEE SKETCH: 40 FT ± 10 FT ± IN FRONT OF THE BELOW RAIL SECTION. PLEASE PAUSE DRIVE #2317	
	NS	2.445	A	R2-1	8/1	30x36"	NEW	SL 40 (30x36")		SEE SKETCH: 40 FT ± South of Pole # 40 NEXT TO 40/5/111/2, INSTALL THE UPWARD SL-40, THEN PAUSE FRONT THIS SIGN INSTALL THE NEW SL-50 PER SB.	
	SB	2.445	F	R2-1	8/1	24x36"	NEW	SL 50			

Prepared by: A. G. [Signature] Date: 10/10/09
 Reviewed by: [Signature] Date: 10/10/09
 Approved by: A. G. [Signature] Date: 10/10/09
 Traffic Operations Engineer

Digest No. _____ Date Completed _____
 Date _____ Leader _____
 Elec. _____
 Gas _____
 Other _____



Subcontractor: _____
 District No. _____
 Requesting Party _____
 Planning (HAL # _____)
 Other: None (e.g., Highway, etc.)
 Signs: None Site Sign (20) _____

FOR YOUR INFORMATION
 Time _____
 Date _____
 Helper _____
 Vehicle _____

COPY

* PLEASE EXPEDITE *

Vermont Agency of Transportation TRAFFIC SHOP WORKORDER										W.O. No.: 09-413				
										W.O. Date: 10/19/09				
										Page 2 of 4				
Route: VT-100 Street Address Range: SEE P. 1 Town(s): Londonderry (Boundary) CIT: 1310 T.I.: T.C.														
ID No.	Dir.	M.P.	L	Sign Code	Color	Sign Size	Action	Legend of New Sign	Legend of Existing Sign	Installation Information	New Posts Installed Type	Quan	Length	Anch
	NS	2.552	A	R2-1	9/4	24x36"	NEW	SL 40		150 FT. ASBEST OF THE CL. IMPROVEMENT W/ DRIVE #7540 INSTALLED THIS SIGN BEHIND RAIL. SEE SKETCH.				
9830	NB	2.857	A	R2-1	9/4	24x36"	REMOVE	SL 30		REMOVE THIS SIGN AND POST.				
9831	SB	2.857	F	R2-1	9/4	24x36"	REMOVE	SL 50		REMOVE THE SIGN THE EXISTING POST LOOSE or; INSTALL THE NEW SIGN HERE.				
				↓				SL 40						
				↓										
	NB	2.890	A	R2-1	9/4	30x36"	NEW	SL 30 (30x36")		40 FEET SOUTH OF POST # VZ24/S1/S, INSTALL THIS NEW UP SPEED SIGN BEHIND RAIL.				

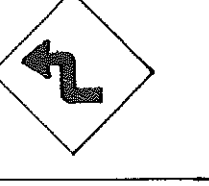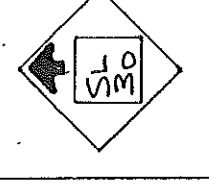Vermont Agency of Transportation TRAFFIC SHOP WORKORDER													
Route: VT-100		Street Address Range: SEE P. 1		Town(s): Londonderry (Somerset) D/T: 1310		W.O. No.: 03-433		W.O. Date: 10/19/09					
						Page 3 of 4		T.I.: T.C.					
ID No.	Dir.	M.P.	L	Sign Code	Color	Sign Size	Action	Legend of New Sign	Legend of Existing Sign	Installation Information	New Posts Installed Type	Cuan Length	Anch
	NB	3.283	A	R2-1	8/1	24x36"	NEW	SL 40		SEE SHEET: 75 FT ± NORTH OF Pole # 0/0, INSTALL THIS NEW SL-40. THEN ADJUS THE LAND FOR SB TRAFFIC. INSTALL THIS NEW UPRAD SL-30.			
	SB	3.283	F	R2-1	8/1	30x36"	NEW	SL 30 (30x36")					
9875	SB	3.356	F	W1-3R	8/1	36"	REMOVE			REMOVE THE EXISTING COVE WARNING SIGN AND POST. IN THIS SAME LOCATION AS 2 NEW POSTS, INSTALL THE SAVED SPEED REDUCED SIGN PLAN FURNISH ALONG (AT SB 3.563)			
(10555)	V		V	W3-S	8/1	36"	INSTALL SAVED TO						

* PLEASE EXPEDITE *

Vermont Agency of Transportation TRAFFIC SHOP WORKORDER													
Route: $\sqrt{1}$ 100		Street Address Range: SEE P. 1		Town(s): (See Attachment) CIT: 1310 T.I.: T.C.		W.O. No.: 07-473		W.O. Date: 10/13/09					
ID No.	Dir.	M.P.	L	Sign Code	Color	Sign Size	Action	Legend of New Sign	Legend of Existing Sign	Installation Information	New Posts Installed Type	Cuan Length	Anch
9874	NB	3.394	A	R2-1	9/16	24x36"	Remove		SL SO	Remove the Sign and Post.			
9874	SB	3.394	F	R2-1	9/16	24x36"	Remove		SL 30	Same as Above			
	NB	3.460	A	R2-1	9/16	24x36"	NEW	SL SO		SEE SKETCH: 15 FEET ² SIGN OF APO ACCESS FROM POLE #16 INSTALLED THIS NEW SIGN, THEN ADDRESS THE ROAD / INSTALLED THE NEW SL-40 FOR SB.			
	SB	3.460	F	R2-1	9/16	36x36"	NEW	SL 40 (30x36")					
11636	SB	3.563	F	W3-5	5/8x1/4	36"	REMOVE / SIGNAGE FROM		SL 30	SALVAGE THE EXISTING SIGN TO SB 3.356; INSTALL THE NEW SIGN			
						36"	NEW	SL TD		HOW EXISTING POSTS SALVAGE? N.O.			

