

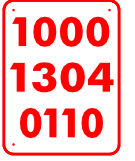




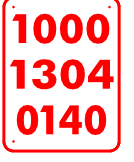
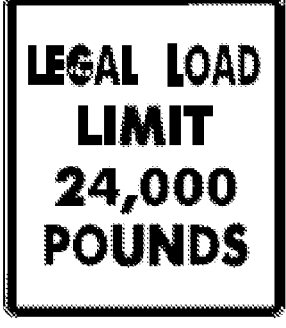


DIRECTION	MILEPOINT	LOCATION CODE (SHEET 2)	SIGN CODE	WIDTH (IN)	HEIGHT (IN)	SHEETING REMARKS	SIGN LEGEND	NEW SIGNS		EXISTING SIGNS			EXIST POST		NUMBER OF NEW POSTS	SQUARE STEEL (IN)			TUBULAR STEEL Ø (IN)				SIGN FRAME REQUIRED	REMARKS	SIGN DETAIL			
								"A"	"B"	RETAIN	SALVAGE FROM	SALVAGE TO	REMOVE	RETAIN		REMOVE	1.75	2.00	2.50	3.00	3.50	4.00			5.00	DETAIL IN SHS	DETAIL ON SHEET NUMBER	DETAIL ON STD SHEET NUMBER
																	(LB / FT)			(LB / FT)								
DOVER VT 100							FY-FLUORESCENT YELLOW FYG-FLUORESCENT YELLOW GREEN															"SHS"-STANDARD HIGHWAY SIGNS						
			D R1-1	30	30		  	6.25						1		X							SALVAGED STREET SIGN AND MM ONTO NEW POST.	INSTALL IN POSITION OF BUS STOP SIGN. SEE NB 1.106 BELOW. SALVAGE SIGN TO M.P. 1.106	X			
			D N/A				BUS STOP SIGN			+																		
NB	1.106		A N/A				BUS STOP SIGN				+			1		X							NO WORK WAS DONE. SALVAGED SIGN FROM M.P. 1.104					
NB	1.200		A R2-1	24	30							1																
			B W14-3	48	36							1																
			A R2-1	24	30		 	5.00						1		X									X			
			B W14-3	40	30			3.86															INSTALL ON BACK	X				
NB	1.314 1.235		A M3-1	24	12			2.00						1		X							THIS SIGN WAS MOVED FOR BETTER VISIBILITY	GREEN ON WHITE SHEETING. 600 INSTALL 200 FT ± NORTH OF SPEED LIMIT 40. MAINTAIN 10 FT MIN TO UTILITY POLE.	X			
			A M1-5	30	24			5.00																	E-136B			
NB	1.410		A R2-1	24	30		 	5.00				1		X									SALVAGED MM ONTO NEW POST.		X			
			A R2-1	24	30									1		X												
NB	1.500		A VD-062AS	72	16		BUSINESS SIGN				1			X														
			A VD-062AS	72	16		BUSINESS SIGN				1																	
NB	1.581		C VR-017	24	30							1		X									WINDY HILL RD (TH-14)					
			C VR-017	24	30			5.00						1		X									E-141			
SIGN SUMMARY SHEET							SHEET TOTALS	32.11	0.00	2	1	1	4	0	0	6		90						PROJECT NAME: Stamford-Andover VT100				
								SF	SF	EA	EA	EA	EA	EA	EA	EA		FT						PROJECT NUMBER: STPG SIGN(20)				
VERMONT AGENCY OF TRANSPORTATION							TOWN TOTALS	648.1	0.0	30.0	3.0	1.0	116	0.0	0.0	112		1680.0						FILE NAME: Dover.xls	PLOT DATE: 8/6/2009			
																							PROJECT MANAGER: N. Avery	DRAWN BY: I. Shea				
																							DESIGNED BY: M. Miller	CHECKED BY: T. Guazzoni				
																							DOVER SHEET 4	SHEET 101 OF 198				