
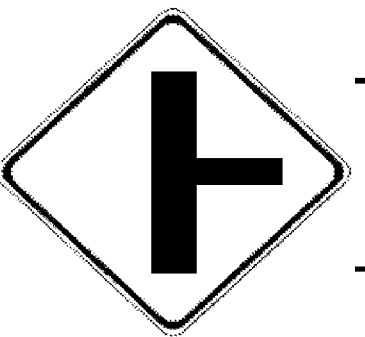
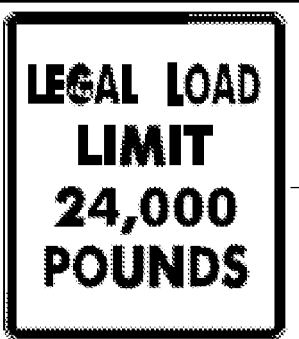


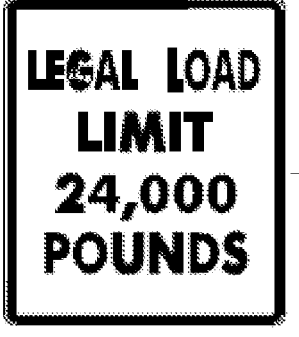
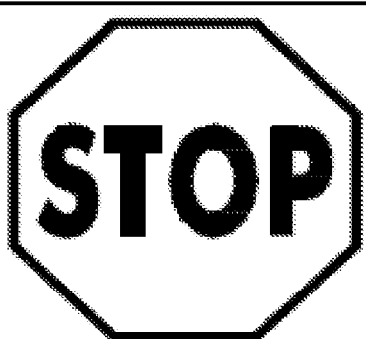

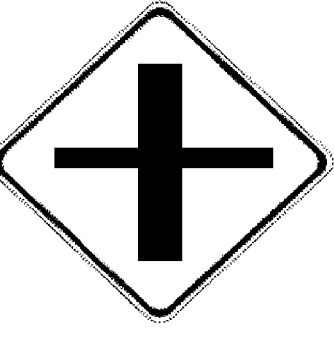


DIRECTION	MILEPOINT	LOCATION CODE (SHEET 2)	SIGN CODE	WIDTH (IN)	HEIGHT (IN)	SHEETING REMARKS	SIGN LEGEND	NEW SIGNS		EXISTING SIGNS			EXIST POST		NUMBER OF NEW POSTS	SQUARE STEEL (IN)			TUBULAR STEEL Ø (IN)				SIGN FRAME REQUIRED	REMARKS	SIGN DETAIL			
								"A"	"B"	RETAIN	SALVAGE FROM	SALVAGE TO	REMOVE	RETAIN		REMOVE	1.75	2.00	2.50	3.00	3.50	4.00			5.00	DETAIL IN SHS	DETAIL ON SHEET NUMBER	DETAIL ON STD SHEET NUMBER
																	(LB / FT)			(LB / FT)								
<b>DOVER VT 100</b>							FY-FLUORESCENT YELLOW FYG-FLUORESCENT YELLOW GREEN															"SHS"-STANDARD HIGHWAY SIGNS						
NB	5.461	D	R1-1	30	30						1												DUNCAN RD (TH-33)					
		D	R1-1	30	30			6.25										X						X				
SB	5.470	F	W11-6H	30	30		SNOWMOBILE SYMBOL				+	*											SNOWMOBILES USE THIS CROSSING. NO WORK WAS DONE.					
SB	4.570	F	W2-2Ma R	30	30			6.25															INSTALL 500 FT ± IN ADVANCE OF TH-50.		6			
SB	4.474	G	VR-017	24	30						1												UPPER HIGHLANDS LOOP (TH-50)					
		G	VR-017	24	30			5.00																		E-141		
SB	4.466	H	R1-1	30	30							1											UPPER HIGHLANDS LOOP (TH-50)					
		H	R1-1	30	30			6.25																X				
SB	4.390	G	VR-017	24	30						1												LOWER HIGHLANDS RD (TH-53)					
		G	VR-017	24	30			5.00																		E-141		
SB	4.380	H	R1-1	30	30							1											LOWER HIGHLANDS RD (TH-53)					
		H	R1-1	30	30			6.25																X				
SB	4.360	F	VD-062AS	72	16		BUSINESS SIGN			1																		
SB	4.240	F	W2-1M	30	30						1																	
		F	W2-1Mb	30	30			6.25																	6			
<b>SIGN SUMMARY SHEET</b>							SHEET TOTALS	41.25	0.00	2	2	2	7	0	0	7	105					PROJECT NAME: <b>Stamford-Andover VT100</b>						
VERMONT AGENCY OF TRANSPORTATION							TOWN TOTALS	648.1	0.0	30.0	3.0	1.0	116	0.0	0.0	112	1680.0					PROJECT NUMBER: <b>STPG SIGN(20)</b>						
								SF	SF	EA	EA	EA	EA	EA	EA	EA	FT					FILE NAME: <b>Dover.xls</b>	PLOT DATE: <b>8/6/2009</b>					
																						PROJECT MANAGER: <b>N. Avery</b>	DRAWN BY: <b>I. Shea</b>					
																						DESIGNED BY: <b>M. Miller</b>	CHECKED BY: <b>T. Guazzoni</b>					
																						DOVER SHEET 11	SHEET <b>108</b> OF <b>198</b>					