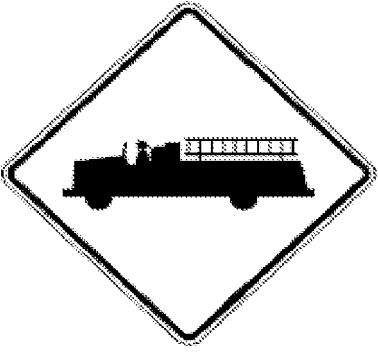

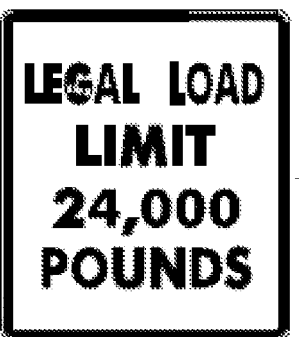





| DIRECTION | MILEPOINT | LOCATION CODE (SHEET 2) | SIGN CODE | WIDTH (IN) | HEIGHT (IN) | SHEETING REMARKS | SIGN LEGEND | NEW SIGNS | | EXISTING SIGNS | | | EXIST POST | | NUMBER OF NEW POSTS | SQUARE STEEL (IN) | | | TUBULAR STEEL Ø (IN) | | | | SIGN FRAME REQUIRED | REMARKS | SIGN DETAIL | | | |
|----------------------------------|-----------|-------------------------|-----------|---------------------|-------------|------------------|--|--------------|------|----------------|--------------|------------|------------|--------|---------------------|-------------------|-----------|------|----------------------|-----------|------|------------------------------|---|--|-------------|---------------|------------------------|----------------------------|
| | | | | | | | | "A" | "B" | RETAIN | SALVAGE FROM | SALVAGE TO | REMOVE | RETAIN | | REMOVE | 1.75 | 2.00 | 2.50 | 3.00 | 3.50 | 4.00 | | | 5.00 | DETAIL IN SHS | DETAIL ON SHEET NUMBER | DETAIL ON STD SHEET NUMBER |
| | | | | | | | | | | | | | | | | | (LB / FT) | | | (LB / FT) | | | | | | | | |
| DOVER VT 100 | | | | | | | FY-FLUORESCENT YELLOW FYG-FLUORESCENT YELLOW GREEN | | | | | | | | | | | | | | | "SHS"-STANDARD HIGHWAY SIGNS | | | | | | |
| SB | 2.482 | F | W11-8 | 30 | 30 | |  | 6.25 | | | | | | 1 | X | | | | | | | | SNOWMOBILES SIGN ATTACHED TO LONGER, NEW POST. SEE SHEET #116 | INSTALL 150 FT ± SOUTH OF THE ORIGINAL LOCATION. | X | | | |
| SB | 2.430 | G | VR-017 | 30 24 | 30 | |  | | | | | 1 | | X | | | | | | | | | | STUGGER RD, NORTH (TH-66) | | | | |
| | | G | VR-017 | 30 24 | 30 | | | 6.25 5.00 | | | | | | 1 | X | | | | | | | | | | | | | E-141 |
| SB | 2.422 | H | R1-1 | 24 30 | 30 | |  | | | | | 1 | | X | | | | | | | | | | STUGGER RD, NORTH (TH-66) | | | | |
| | | H | R1-1 | 24 30 | 30 | | | 5.00 6.25 | | | | | | 1 | X | | | | | | | | | | | X | | |
| SB | 2.330 | G | VR-017 | 24 | 30 | |  | | | | | 1 | | X | | | | | | | | | | STUGGER RD, SOUTH (TH-66) | | | | |
| | | G | VR-017 | 24 | 30 | | | 6.25 5.00 | | | | | | 1 | X | | | | | | | | | | | | | E-141 |
| SB | 2.322 | H | R1-1 | 30 | 30 | |  | | | | | 1 | | X | | | | | | | | | | STUGGER RD, SOUTH (TH-66) | | | | |
| | | H | R1-1 | 30 | 30 | | | 6.25 | | | | | | 1 | X | | | | | | | | | | | X | | |
| SB | 2.215 | F | R2-1 | 24 | 30 | | SPEED LIMIT 40 | | | | | 1 | | X | | | | | | | | | | | | | | |
| | | F | R2-1 | 24 | 30 | |  | 5.00 | | | | | | 1 | X | | | | | | | | | 340 FT ± SOUTH OF ORIGINAL LOCATION | X | | | |
| SB | 1.940 | F | R2-1 | 24 | 30 | | SPEED LIMIT 40 | | | | | 1 | | X | | | | | | | | | | | | | | |
| SB | 1.880 | F | VD-062AS | 72 | 16 | | BUSINESS SIGN | | | 1 | | | | X | | | | | | | | | | | | | | |
| | | F | VD-062AS | 72 | 16 | | BUSINESS SIGN | | | 1 | | | | | | | | | | | | | | | | | | |
| SB | 1.789 | G | VR-017 | 24 | 30 | | LEGAL LOAD LIMIT 24,000 LBS | | | 1 | | | | X | | | | | | | | | | COUNTRY CLUB RD (TH-9) | | | | |
| SIGN SUMMARY SHEET | | | | | | | SHEET TOTALS | 33.75 | 0.00 | 3 | 0 | 0 | 6 | 0 | 0 | 6 | 90 | | | | | | | PROJECT NAME: Stamford-Andover VT100 | | | | |
| VERMONT AGENCY OF TRANSPORTATION | | | | | | | TOWN TOTALS | 648.1 | 0.0 | 30.0 | 3.0 | 1.0 | 116 | 0.0 | 0.0 | 112 | 1680.0 | | | | | | | PROJECT NUMBER: STPG SIGN(20) | | | | |
| | | | | | | | | SF | SF | EA | EA | EA | EA | EA | EA | EA | FT | | | | | | FILE NAME: Dover.xls | PLOT DATE: 8/6/2009 | | | | |
| | | | | | | | | | | | | | | | | | | | | | | | PROJECT MANAGER: N. Avery | DRAWN BY: I. Shea | | | | |
| | | | | | | | | | | | | | | | | | | | | | | | DESIGNED BY: M. Miller | CHECKED BY: T. Guazzoni | | | | |
| | | | | | | | | | | | | | | | | | | | | | | | DOVER SHEET 15 | SHEET 112 OF 198 | | | | |