

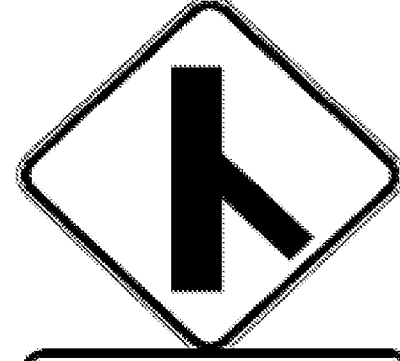

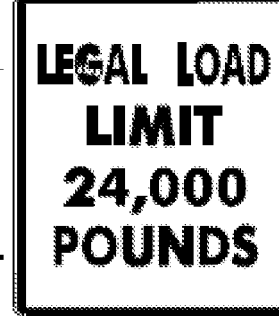
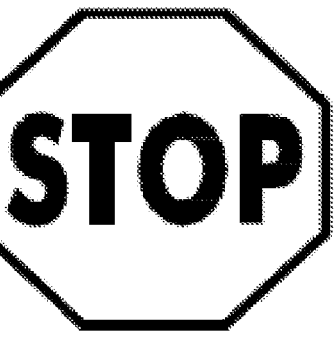



DIRECTION	MILEPOINT	LOCATION CODE (SHEET 2)	SIGN CODE	WIDTH (IN)	HEIGHT (IN)	SHEETING REMARKS	SIGN LEGEND	NEW SIGNS		EXISTING SIGNS			EXIST POST		NUMBER OF NEW POSTS	SQUARE STEEL (IN)			TUBULAR STEEL Ø (IN)				SIGN FRAME REQUIRED	REMARKS	SIGN DETAIL						
								"A"	"B"	RETAIN	SALVAGE FROM	SALVAGE TO	REMOVE	RETAIN		REMOVE	1.75	2.00	2.50	FOUNDATION	3.00	3.50			4.00	5.00	DETAIL IN SHS	DETAIL ON SHEET NUMBER	DETAIL ON STD SHEET NUMBER		
																	(LB / FT)				(LB / FT)										
DOVER VT 100							FY-FLUORESCENT YELLOW FYG-FLUORESCENT YELLOW GREEN															"SHS"-STANDARD HIGHWAY SIGNS									
			E W14-3	48	36		 				1																				
			F R2-1	24	30				5.00										X					X							
			F VR-417	30	30				6.25																	E-141					
			E W14-3	40	30	FY			3.86																	PENNANT INSTALLED ON BACK OF SPEED LIMIT 50 SIGN					
SB	0.260 0.245		F W2-3Ma L	30	30			6.25						1				X								INSTALL ¹⁶⁰ 80 FT ± NORTH OF THE CONCRETE BLOCK RETAINING WALL. INSTALL SIGN AS SHOWN		6			
			F W16-8	24	8				1.33																	X					
SB	0.145		G VR-017	24	30		 				1																ABROAD RD (TH-11)				
			G VR-017	24	30				5.00											X								E-141			
SB	0.135		H R1-1	30	30						1																ABROAD RD (TH-11)				
			H R1-1	30	30	1000 1304 0014			6.25											X						X					
SB	0.000		G VD-024	60	7.5						1																WILMINGTON I DOVER				
SB	2.482	A	WII-6	30	30			6.25																				NEW FOLDING SNOWMOBILE SIGN WAS INSTALLED. FIRE ENGINE SIGN WAS SALVAGED ONTO POST.			
SIGN SUMMARY SHEET							SHEET TOTALS	40.19 33.94	0.00	0	1	1	5	0	0	4	60														
VERMONT AGENCY OF TRANSPORTATION							TOWN TOTALS	648.1	0.0	30.0	3.0	1.0	116	0.0	0.0	112	1680.0														
																					PROJECT NAME:	Stamford-Andover VT100									
																					PROJECT NUMBER:	STPG SIGN(20)									
												FILE NAME:	Dover.xls					PLOT DATE:	8/6/2009												
												PROJECT MANAGER:	N. Avery					DRAWN BY:	I. Shea												
												DESIGNED BY:	M. Miller					CHECKED BY:	T. Guazzoni												
												DOVER SHEET 19						SHEET	116 OF 198												