






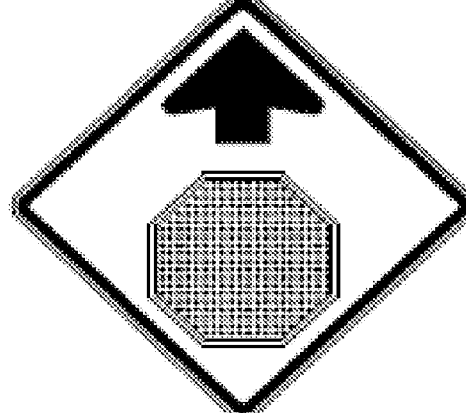
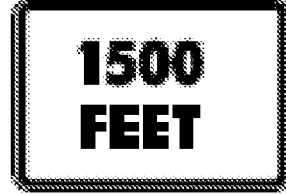


DIRECTION	MILEPOINT	LOCATION CODE (SHEET 2)	SIGN CODE	WIDTH (IN)	HEIGHT (IN)	SHEETING REMARKS	SIGN LEGEND	NEW SIGNS		EXISTING SIGNS			EXIST POST		NUMBER OF NEW POSTS	SQUARE STEEL (IN)			TUBULAR STEEL Ø (IN)				SIGN FRAME REQUIRED	REMARKS	SIGN DETAIL				
								"A"	"B"	RETAIN	SALVAGE FROM	SALVAGE TO	REMOVE	RETAIN		REMOVE	1.75	2.00	2.50	FOUNDATION	3.00	3.50			4.00	5.00	DETAIL IN SHS	DETAIL ON SHEET NUMBER	DETAIL ON STD SHEET NUMBER
																	(LB / FT)				(LB / FT)								
JAMAICA VT 100							FY-FLUORESCENT YELLOW FYG-FLUORESCENT YELLOW GREEN															"SHS"-STANDARD HIGHWAY SIGNS							
SB	4.072	F	S3-1	30	30						1																		
		F	S3-1	30	30			6.25															X						
SB	4.007	F	VS3-4A	30	30		SCHOOL BUS TURN AROUND AHEAD			+ +													NO WORK DONE - SIGN PREVIOUSLY MOVED TO MM SB IN JAMAICA 2.330 RT						
SB	3.896	G	VR-017	24	30		 COLEMAN HILLS RD				1												MILL BROOK RD (TH-62)						
		G	VR-017	24	30		  MILL BROOK RD	5.00																	E-141				
SB	3.890	H	R1-1	30	30						1												MILL BROOK RD (TH-62)						
		H	R1-1	30	30			6.25																X					
SB	3.888	G	VR-017	24	30						1												COLEMAN HILLS RD (TH-6)						
		G	VR-017	24	30			5.00																	E-141				
SB	3.882	H	R1-1	30	30						1												COLEMAN HILLS RD (TH-6)						
		H	R1-1	30	30			6.25																X					
SB	3.880	F	W3-1	36	36						1																		
		F	W16-2	24	18						1																		
		F	W3-1	36	36			9.00																X					
		F	W16-2	24	18			3.00															INSTALL PLAQUE ON LEFT-SIDE POST	X					
SIGN SUMMARY SHEET							SHEET TOTALS	40.75	0.00	0	0	0	7	0	0	7	120							PROJECT NAME: Stamford-Andover VT100					
								SF	SF	EA	EA	EA	EA	EA	EA	EA	FT							PROJECT NUMBER: STPG SIGN(20)					
VERMONT AGENCY OF TRANSPORTATION							TOWN TOTALS	391.9	0.0	33.0	4.0	4.0	69	0.0	0.0	66	990.0							FILE NAME: Jamaica.xls	PLOT DATE: 8/6/2009				
																							PROJECT MANAGER: N. Avery	DRAWN BY: T. Guazzoni					
																							DESIGNED BY: M. Miller	CHECKED BY: T. Guazzoni					
																							JAMAICA SHEET 10	SHEET 146 OF 198					