



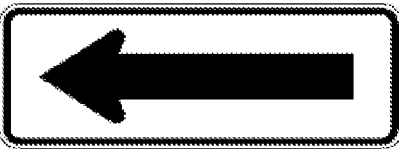




DIRECTION	MILEPOINT	LOCATION CODE (SHEET 2)	SIGN CODE	WIDTH (IN)	HEIGHT (IN)	SHEETING REMARKS	SIGN LEGEND	NEW SIGNS		EXISTING SIGNS			EXIST POST		NUMBER OF NEW POSTS	SQUARE STEEL (IN)			TUBULAR STEEL Ø (IN)				SIGN FRAME REQUIRED	REMARKS	SIGN DETAIL				
								"A"	"B"	RETAIN	SALVAGE FROM	SALVAGE TO	REMOVE	RETAIN		REMOVE	1.75	2.00	2.50	FOUNDATION	3.00	3.50			4.00	5.00	DETAIL IN SHS	DETAIL ON SHEET NUMBER	DETAIL ON STD SHEET NUMBER
																	(LB / FT)				(LB / FT)								
<b>LONDONDERRY VT 100</b>							FY-FLUORESCENT YELLOW FYG-FLUORESCENT YELLOW GREEN															"SHS"-STANDARD HIGHWAY SIGNS							
			A M1-5	30	24			5.00																		E-136B			
NB	3.080		C VR-017	24	24							1														TH-55, CRESCENT ST			
			C VR-017	24	30			5.00						1		X										E-141			
NB	3.084		D R1-1	30	30							1														TH-55, CRESCENT ST			
			D R1-1	30	30			6.25						1		X								X					
NB	3.177		A R2-1	24	30							1																	
			A R2-1	24	30			5.00						1		X								X		MAINTAIN 10+ FEET FROM UTILITY POLE			
NB	3.217		A W1-6	48	24							1																	
			A W1-6	48	24	FY		8.00						2		X								X					
NB	3.217		B W1-6	48	24							1																	
			B W1-6	48	24	FY		8.00						2		X								X		FACES SB TRAFFIC			
NB	3.282		A R2-1	24	30		40 	5.00						1		X								X		INSTALL 350 FEET NORTH OF BACK TO BACK LARGE ARROWS			
NB	3.460 3.402		A R2-1	24	30		SPEED LIMIT 50					+																	
NB	3.427		A VW-060	30	30		HIDDEN DRIVES					1																	
NB	3.502		A S3-1	30	30							1																	
<b>SIGN SUMMARY SHEET</b>							SHEET TOTALS	37.25 42.25	0.00	0	0	0	7 8	0	0	8	120												
VERMONT AGENCY OF TRANSPORTATION							TOWN TOTALS	729.7	0.0	22.0	4.0	4.0	151	0.0	0.0	118	1770.0												
PROJECT NAME: Stamford-Andover VT100																					PROJECT NUMBER: STPG SIGN(20)								
FILE NAME: Londonderrv.xls												PLOT DATE: 8/6/2009																	
PROJECT MANAGER: N. Avery												DRAWN BY: T. Guazzoni																	
DESIGNED BY: J. Kelly												CHECKED BY: T. Guazzoni																	
LONDONDERRY SHEET 6												SHEET 155 OF 198																	