


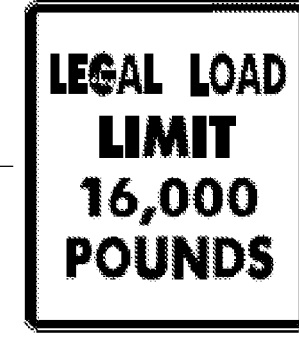


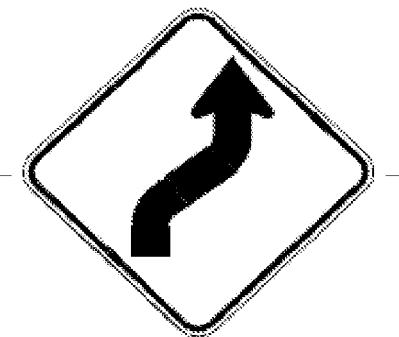



DIRECTION	MILEPOINT	LOCATION CODE (SHEET 2)	SIGN CODE	WIDTH (IN)	HEIGHT (IN)	SHEETING REMARKS	SIGN LEGEND	NEW SIGNS		EXISTING SIGNS			EXIST POST		NUMBER OF NEW POSTS	SQUARE STEEL (IN)			TUBULAR STEEL Ø (IN)				SIGN FRAME REQUIRED	REMARKS	SIGN DETAIL				
								"A"	"B"	RETAIN	SALVAGE FROM	SALVAGE TO	REMOVE	RETAIN		REMOVE	1.75	2.00	2.50	3.00	3.50	4.00			5.00	DETAIL IN SHS	DETAIL ON SHEET NUMBER	DETAIL ON STD SHEET NUMBER	
																	(LB / FT)			(LB / FT)									
<b>LONDONDERRY VT 100</b>							FY-FLUORESCENT YELLOW FYG-FLUORESCENT YELLOW GREEN															"SHS"-STANDARD HIGHWAY SIGNS							
			A S3-1	30	30			6.25						1	X									X					
NB	5.985		A W1-4ML	30	30		MODIFIED LEFT REVERSE CURVE						1	X															
			A W13-1	18	18		40 MPH PLAQUE						1																
NB	<del>5.965</del> 6.273		A R2-1	24	30								1	X															
			A R2-1	24	30			5.00					1	X										NEW MM CHANGE, SEE SIGN CHANGE NOTE ON SHEET #151.	X				
NB	6.000		A VW-544	30	30		EMERGENCY VEHICLES						1	X															
NB	6.040		A VW-544	30	30			6.25					1	X											INSTALL 200 FEET NORTH OF EXISTING EMERGENCY VEHICLES ASSEMBLY		E-154		
NB	6.642		C VR-017	24	30							2	X												TH-15, COBBLE RIDGE RD				
			C VR-017	24	30			5.00					1	X											NO PARKING SIGN WAS REMOVED AND GIVEN TO THE TOWN. ILLEGAL SIGN.		E-141		
NB	6.647		D R1-1	30	30								1	X												TH-15, COBBLE RIDGE RD			
			D R1-1	30	30			6.25					1	X											X				
NB	7.470		A W1-4R	30	30								1	X															
			A W1-4R	30	30			6.25					1	X											X				
NB	7.520		A VW-081R	30	30								1	X															
			A VW-081R	30	30			6.25					1	X													6		
<b>SIGN SUMMARY SHEET</b>							SHEET TOTALS	41.25	0.00	0	0	0	9	0	0	7	105												
VERMONT AGENCY OF TRANSPORTATION							TOWN TOTALS	729.7	0.0	22.0	4.0	4.0	151	0.0	0.0	118	1770.0												
																					PROJECT NAME:	Stamford-Andover VT100							
																					PROJECT NUMBER:	STPG SIGN(20)							
										FILE NAME:	Londonderrv.xls					PLOT DATE:	8/6/2009												
										PROJECT MANAGER:	N. Avery					DRAWN BY:	T. Guazzoni												
										DESIGNED BY:	J. Kelly					CHECKED BY:	T. Guazzoni												
										LONDONDERRY SHEET 11					SHEET 160 OF 198														