

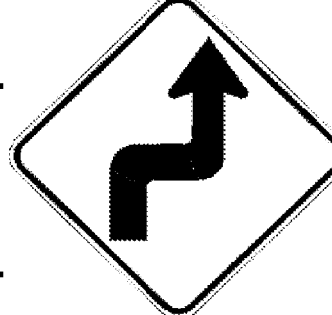

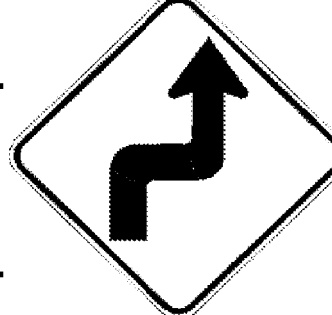


DIRECTION	MILEPOINT	LOCATION CODE (SHEET 2)	SIGN CODE	WIDTH (IN)	HEIGHT (IN)	SHEETING REMARKS	SIGN LEGEND	NEW SIGNS		EXISTING SIGNS			EXIST POST		NUMBER OF NEW POSTS	SQUARE STEEL (IN)			TUBULAR STEEL Ø (IN)				SIGN FRAME REQUIRED	REMARKS	SIGN DETAIL				
								"A"	"B"	RETAIN	SALVAGE FROM	SALVAGE TO	REMOVE	RETAIN		REMOVE	1.75	2.00	2.50	3.00	3.50	4.00			5.00	DETAIL IN SHS	DETAIL ON SHEET NUMBER	DETAIL ON STD SHEET NUMBER	
																	(LB / FT)			(LB / FT)									
<b>LONDONDERRY VT 100</b>							FY-FLUORESCENT YELLOW FYG-FLUORESCENT YELLOW GREEN															"SHS"-STANDARD HIGHWAY SIGNS							
SB	3.809	F	S3-1	30	30		SCHOOL BUS STOP AHEAD					1																	
SB	3.674	F	VW-054L	30	30																								
		F	VW-054L	30	30			6.25																				E-154	
SB	3.574	F	W3-5	36	36		SPEED REDUCTION (30)			1	+																		
SB	3.423	F	W3-5	36	36		SPEED REDUCTION (30)			1	+																	SEE SHEET # 151 FOR SIGN CHANGE NOTE. INSTALL SIGN 800 FEET SOUTH OF EXISTING LOCATION	
SB	3.414	F	VD-018	30	18		SOUTH LONDONDERRY RAWSONVILLE 4					1																	
SB	3.404	F	R2-1	24	30		SPEED LIMIT 30					1																	
SB	3.414 3.362	F	VD-018	30	18		 SOUTH LONDONDERRY RAWSONVILLE 5	3.75																				SAME LOCATION AS OLD SIGN INSTALL 200 FEET NORTH OF BUSINESS SIGN ASSEMBLY	
SB	3.350	F	W1-3R	30	30		RIGHT REVERSE TURN					1																	
SB	3.324	F	VD-062AS	72	16		BUSINESS SIGN			1																			
		F	VD-062AS	72	16		BUSINESS SIGN			1																			
SB	3.282	F	R2-1	30	36		 	7.50																					IN GOOD CONDITION - REPLACED 10/09 INSTALL 225 FEET SOUTH OF BUSINESS SIGN AND ACROSS FROM SPEED LIMIT 50 SIGN
SB	3.244	F	W1-3R	30	30	FY		6.25																					INSTALL 200 FEET SOUTH OF NEW SPEED LIMIT 30 SIGN
SB	3.154	F	W1-1L	30	30		LEFT TURN WITH LH SIDE ROAD					1																	
		F	W13-1	18	18		20 MPH PLAQUE					1																	
<b>SIGN SUMMARY SHEET</b>							SHEET TOTALS	16.25 23.75	0.00	2	0	0	7	0	0	6	90							PROJECT NAME: <b>Stamford-Andover VT100</b> PROJECT NUMBER: <b>STPG SIGN(20)</b>					
VERMONT AGENCY OF TRANSPORTATION							TOWN TOTALS	729.7	0.0	22.0	4.0	4.0	151	0.0	0.0	118	1770.0							FILE NAME: <b>Londonderrv.xls</b> PLOT DATE: <b>8/6/2009</b> PROJECT MANAGER: <b>N. Avery</b> DRAWN BY: <b>T. Guazzoni</b> DESIGNED BY: <b>J. Kelly</b> CHECKED BY: <b>T. Guazzoni</b> LONDONDERRY SHEET 17 SHEET <b>166</b> OF <b>198</b>					