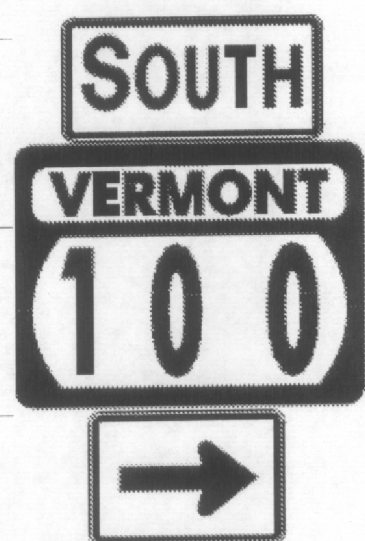
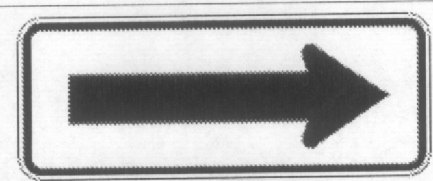
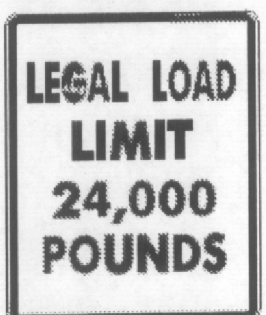


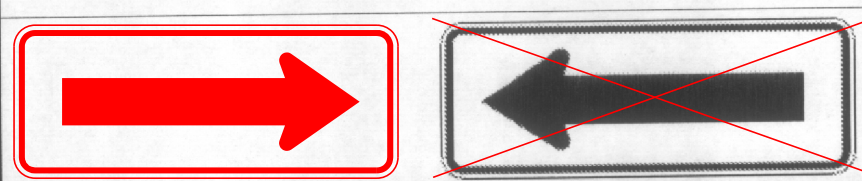


| DIRECTION | MILEPOINT | LOCATION CODE (SHEET 2) | SIGN CODE | WIDTH (IN) | HEIGHT (IN) | SHEETING REMARKS | SIGN LEGEND | NEW SIGNS | | EXISTING SIGNS | | | EXIST POST | | NUMBER OF NEW POSTS | SQUARE STEEL (IN) | | | TUBULAR STEEL Ø (IN) | | | | SIGN FRAME REQUIRED | REMARKS | SIGN DETAIL | | | |
|----------------------------------|-----------|-------------------------|-----------|------------|-------------|------------------|--|-----------|------|----------------|--------------|------------|------------|--------|---------------------|-------------------|-----------|------|----------------------|-----------|------|------------------------------|---|---------|---------------|------------------------|----------------------------|------|
| | | | | | | | | "A" | "B" | RETAIN | SALVAGE FROM | SALVAGE TO | REMOVE | RETAIN | | REMOVE | (LB / FT) | | | (LB / FT) | | | | | DETAIL IN SHS | DETAIL ON SHEET NUMBER | DETAIL ON STD SHEET NUMBER | |
| | | | | | | | | | | | | | | | | | 1.75 | 2.00 | 2.50 | 3.00 | 3.50 | 4.00 | | | | | | 5.00 |
| LONDONDERRY VT 100 | | | | | | | FY-FLUORESCENT YELLOW FYG-FLUORESCENT YELLOW GREEN | | | | | | | | | | | | | | | "SHS"-STANDARD HIGHWAY SIGNS | | | | | | |
| | SB 3.012 | F | M6-1S | 21 | 15 | | RIGHT ==>> | | | | | | | | | | | | | | | | | | | | | |
| | | F | M3-3 | 24 | 12 | |  | 2.00 | | | | | | | 1 | | | X | | | | | | X | | | | |
| | | F | M1-5 | 24 | 24 | | | 5.00 | | | | | | | | | | | | | | | | | E-136B | | | |
| | | F | M6-1R | 21 | 15 | | | 2.19 | | | | | | | | | | | | | | | | X | | | | |
| | | F | M6-1R | 21 | 15 | | | 2.19 | | | | | | | | | | | | | | | | X | | | | |
| | SB 2.951 | E | W1-6 | 48 | 24 | |  | | | | | | | | | | | | | | | | | | | | | |
| | | E | W1-6 | 48 | 24 | FY | | 8.00 | | | | | | | | 2 | | | X | | | | | X | | | | |
| | SB 2.950 | G | VR-017 | 24 | 30 | |  | | | | | | | | | | | | | | | | | | | | | |
| | | G | VR-017 | 24 | 30 | | | 5.00 | | | | | | | | 1 | | | X | | | | | | E-141 | | | |
| | | G | VR-660 | 24 | 30 | | | 5.00 | | | | | | | | 1 | | | X | | | | | | | | | |
| | SB 2.946 | H | R1-1 | 30 | 30 | |  | | | | | | | | | | | | | | | | | | | | | |
| | | H | R1-1 | 30 | 30 | | | 6.25 | | | | | | | | 1 | | | X | | | | | X | | | | |
| | SB 2.933 | F | M3-3 | 24 | 12 | |  | 2.00 | | | | | | | | | | | | | | | | | | | | |
| | | F | M1-5 | 30 | 24 | | | 5.00 | | | | | | | | 1 | | | X | | | | | X | E-136B | | | |
| | SB 2.933 | E | W1-6 | 48 | 24 | |  | | | | | | | | | | | | | | | | | | | | | |
| | | E | W1-6 | 48 | 24 | FY | | 8.00 | | | | | | | | 2 | | | X | | | | | X | | | | |
| SIGN SUMMARY SHEET | | | | | | | SHEET TOTALS | 43.44 | 0.00 | 0 | 0 | 0 | 6 | 0 | 0 | 8 | 120 | | | | | | PROJECT NAME: Stamford-Andover VT100 | | | | | |
| | | | | | | | | SF | SF | EA | EA | EA | EA | EA | EA | EA | FT | | | | | | PROJECT NUMBER: STPG SIGN(20) | | | | | |
| VERMONT AGENCY OF TRANSPORTATION | | | | | | | TOWN TOTALS | 729.7 | 0.0 | 22.0 | 4.0 | 4.0 | 151 | 0.0 | 0.0 | 118 | 1770.0 | | | | | | FILE NAME: Londonderrv.xls | | | | | |
| | | | | | | | | | | | | | | | | | | | | | | | PLOT DATE: 8/6/2009 | | | | | |
| | | | | | | | | | | | | | | | | | | | | | | | DRAWN BY: T. Guazzoni | | | | | |
| | | | | | | | | | | | | | | | | | | | | | | | CHECKED BY: T. Guazzoni | | | | | |
| | | | | | | | | | | | | | | | | | | | | | | | SHEET 168 OF 198 | | | | | |