

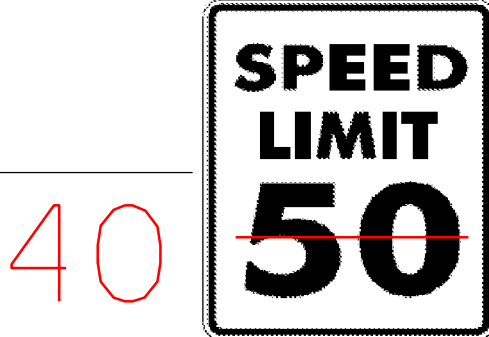





DIRECTION	MILEPOINT	LOCATION CODE (SHEET 2)	SIGN CODE	WIDTH (IN)	HEIGHT (IN)	SHEETING REMARKS	SIGN LEGEND	NEW SIGNS		EXISTING SIGNS			EXIST POST		NUMBER OF NEW POSTS	SQUARE STEEL (IN)			TUBULAR STEEL Ø (IN)				SIGN FRAME REQUIRED	REMARKS	SIGN DETAIL				
								"A"	"B"	RETAIN	SALVAGE FROM	SALVAGE TO	REMOVE	RETAIN		REMOVE	1.75	2.00	2.50	FOUNDATION	3.00	3.50			4.00	5.00	DETAIL IN SHS	DETAIL ON SHEET NUMBER	DETAIL ON STD SHEET NUMBER
																	(LB / FT)				(LB / FT)								
LONDONDERRY VT 100							FY-FLUORESCENT YELLOW FYG-FLUORESCENT YELLOW GREEN															"SHS"-STANDARD HIGHWAY SIGNS							
SB	2.873	G	VR-017	24	30						1		X										TH-27, MELENDY HILL RD						
		G	VR-017	24	30			5.00						1	X										E-141				
SB	2.868	H	R1-1	30	30						1		X										TH-27, MELENDY HILL RD						
		H	R1-1	30	30			6.25						1	X								SEE NOTE FOR SIGN CHANGES ON SHEET #151	X					
SB	2.863	F	R2-1	24	30						+		X																
		F	R2-1	24	30			5.00						+	X									X					
SB	2.813	F	M3-3	24	12		SOUTH				1		X										MM. STILL THERE						
		F	M1-5A	24	24		VERMONT 100				1																		
SB	2.494	G	VR-017	24	30						1		X										TH-49, WINDY RISE LANE WEST						
		G	VR-017	24	30			5.00						1	X										E-141				
SB	2.490	H	R1-1	30	30						1		X										TH-49, WINDY RISE LANE WEST						
		H	R1-1	30	30			6.25						1	X									X					
SB	1.821	G	VR-017	24	30						1		X										TH-45, GLEBE VIEW LANE						
		G	VR-017	24	30			5.00						1	X										E-141				
		G					WATCH FOR CHILDREN				+												REMOVE TOWN'S ILLEGAL SIGN: RETURN TO TOWN MISSING						
SIGN SUMMARY SHEET							SHEET TOTALS	27.50 32.50	0.00	0	0	0	7 9	0	0	5 6	90						PROJECT NAME: Stamford-Andover VT100						
VERMONT AGENCY OF TRANSPORTATION							TOWN TOTALS	729.7	0.0	22.0	4.0	4.0	151	0.0	0.0	118	1770.0						PROJECT NUMBER: STPG SIGN(20)	FILE NAME: Londonderrv.xls	PLOT DATE: 8/6/2009				
								SF	SF	EA	EA	EA	EA	EA	EA	EA	FT						DESIGNED BY: J. Kelly	DRAWN BY: T. Guazzoni	CHECKED BY: T. Guazzoni				
																							LONDONDERRY SHEET 20	SHEET 169 OF 198					