


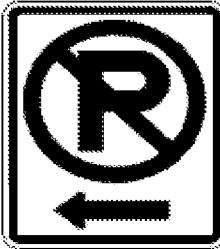


DIRECTION	MILEPOINT	LOCATION CODE (SHEET 2)	SIGN CODE	WIDTH (IN)	HEIGHT (IN)	SHEETING REMARKS	SIGN LEGEND	NEW SIGNS		EXISTING SIGNS			EXIST POST		NUMBER OF NEW POSTS	SQUARE STEEL (IN)			TUBULAR STEEL Ø (IN)				SIGN FRAME REQUIRED	REMARKS	SIGN DETAIL						
								"A"	"B"	RETAIN	SALVAGE FROM	SALVAGE TO	REMOVE	RETAIN		REMOVE	1.75	2.00	2.50	FOUNDATION	3.00	3.50			4.00	5.00	DETAIL IN SHS	DETAIL ON SHEET NUMBER	DETAIL ON STD SHEET NUMBER		
																	(LB / FT)				(LB / FT)										
WESTON VT 100							FY-FLUORESCENT YELLOW FYG-FLUORESCENT YELLOW GREEN															"SHS"-STANDARD HIGHWAY SIGNS									
NB	3.052	A	W16-4	24	18		NEXT 1000 FEET			1																					
NB	3.060	C	VR-052L	24	30		NO PARKING (LEFT ARROW)			+			* X													OLD POST WAS REPLACED					
NB	3.075	C	VR-052	24	30		NO PARKING (DOUBLE ARROW)			1 1			X	1		X											RETAIN SIGN, INSTALL ON NEW POST				
NB	3.120	C	VR-052R	12	18		NO PARKING (RIGHT ARROW)			1																	RELOCATE SIGN 35 FEET NORTH				
NB	3.127	C	VR-052R	12	18		NO PARKING (RIGHT ARROW)				1			1		X											INSTALL 35 FEET NORTH OF EXISTING				
NB	3.155	A	W1-1R	30	30		RIGHT TURN						1			X															
		A	W13-1	18	18		25 MPH PLAQUE						1																		
		C	VR-052L	24	30			5.00						1		X												INSTALL 50 FEET SOUTH OF EXISTING		7	
NB	3.165	C	VR-052L	24	30		NO PARKING (LEFT ARROW)						1			X															
NB	3.187	C	VR-017	24	24			5.00					1			X												TH-39, MARKHAM LANE			E-141
		C	VR-017	24	30									1		X															
NB	3.193	D	R1-1	30	30								1			X												TH-39, MARKHAM LANE			
		D	R1-1	30	30			6.25						1		X															
NB	3.216 3.210	C	VR-052	12	18		NO PARKING (DOUBLE ARROW)			+			* X														THIS SIGN WAS RELOCATED TO NB MM 3.216 RT. WHERE NEW HIDDEN DRIVE RIGHT WAS INSTALLED. SEE SHEET #194				
NB	3.259	A	R2-1	24	30								1			X															
SIGN SUMMARY SHEET							SHEET TOTALS	16.25	0.00	3	4	4	8	0	0	5	75							PROJECT NAME: Stamford-Andover VT100 PROJECT NUMBER: STPG SIGN(20)							
VERMONT AGENCY OF TRANSPORTATION							TOWN TOTALS	774.4	0.0	26.0	12.0	12.0	139	0.0	0.0	140	2100.0							FILE NAME: Weston.xls PLOT DATE: 8/6/2009 PROJECT MANAGER: N. Avery DRAWN BY: T. Guazzoni DESIGNED BY: J. Kelly CHECKED BY: T. Guazzoni WESTON SHEET 5 SHEET 176 OF 198							