
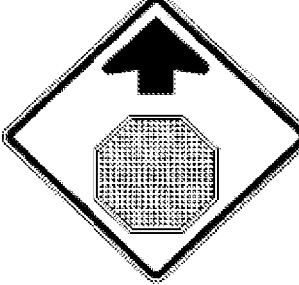

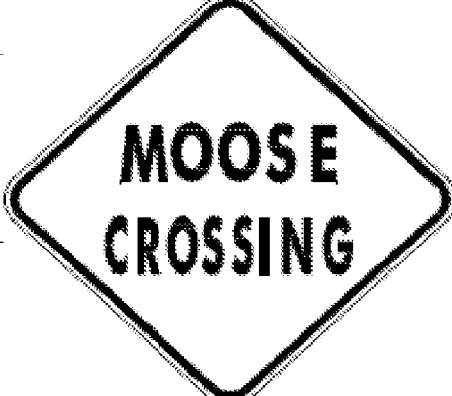

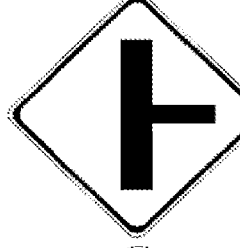

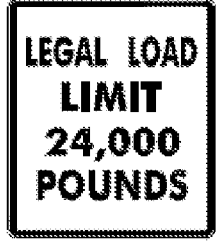


DIRECTION	MILEPOINT	LOCATION CODE (SHEET 2)	SIGN CODE	WIDTH (IN)	HEIGHT (IN)	SHEETING REMARKS	SIGN LEGEND	NEW SIGNS		EXISTING SIGNS			EXIST POST		NUMBER OF NEW POSTS	SQUARE STEEL (IN)			TUBULAR STEEL Ø (IN)				SIGN FRAME REQUIRED	REMARKS	SIGN DETAIL				
								"A"	"B"	RETAIN	SALVAGE FROM	SALVAGE TO	REMOVE	RETAIN		REMOVE	1.75	2.00	2.50	FOUNDATION	3.00	3.50			4.00	5.00	DETAIL IN SHS	DETAIL ON SHEET NUMBER	DETAIL ON STD SHEET NUMBER
																	(LB / FT)				(LB / FT)								
WESTON VT 100							FY-FLUORESCENT YELLOW FYG-FLUORESCENT YELLOW GREEN															"SHS"-STANDARD HIGHWAY SIGNS							
			A M1-5	30	24			5.00															INSTALL ON LEFT POST			E-136B			
NB	6.630		A D2-1	72	10		LUDLOW 7					1		X															
NB	6.720		A R2-1	24	30							1		X															
			A R2-1	24	30			5.00							1		X						X						
NB	6.760		B W3-1	36	36							1		X									MM. FACES SB TRAFFIC (BACK-TO-BACK) WITH W3-1.						
			B W3-1	36	36			9.00							2		X						INSTALL BETWEEN PAVEMENT STENCILS AND ACROSS FROM SB ASSEMBLY	X					
NB	6.910		A VW-000	30	30							1		X															
			A W7-3A	24	18							1																	
			A VW-000	30	30			6.25							1		X									E-153			
			A W7-3A	24	18			3.00															X						
NB	7.010		A S3-1	30	30							1		X															
			A W2-2MaR	30	30			6.25							2		X						INSTALL ABOVE SCHOOL BUS STOP AHEAD SIGN		6				
			A S3-1	30	30		NOT INSTALLED HERE, SEE SHEET # 139.	-6.25															X						
NB	7.101		C VR-017	24	30							1		X									TH-42, CIDER MILL RD						
			C VR-017	24	30			5.00							1		X									E-141			
SIGN SUMMARY SHEET							SHEET TOTALS	39.50 45.75	0.00	0	0	0	7	0	0	7	105							PROJECT NAME: Stamford-Andover VT100					
								SF	SF	EA	EA	EA	EA	EA	EA	EA	FT							PROJECT NUMBER: STPG SIGN(20)					
VERMONT AGENCY OF TRANSPORTATION							TOWN TOTALS	774.4	0.0	26.0	12.0	12.0	139	0.0	0.0	140	2100.0							FILE NAME: Weston.xls	PLOT DATE: 8/6/2009				
																							PROJECT MANAGER: N. Avery	DRAWN BY: T. Guazzoni					
																							DESIGNED BY: J. Kelly	CHECKED BY: T. Guazzoni					
																							WESTON SHEET 11	SHEET 182 OF 198					