



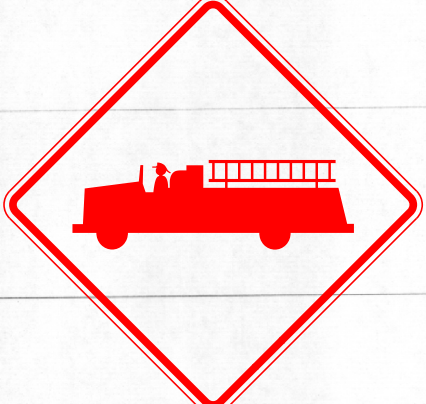

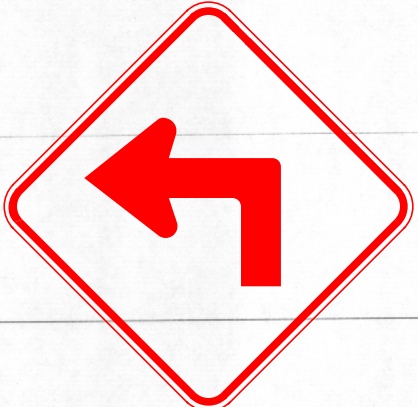




DIRECTION	MILEPOINT	LOCATION CODE (SHEET 2)	SIGN CODE	WIDTH (IN)	HEIGHT (IN)	SHEETING REMARKS	SIGN LEGEND	NEW SIGNS		EXISTING SIGNS				EXIST POST		NUMBER OF NEW POSTS	SQUARE STEEL (IN)			TUBULAR STEEL Ø (IN)				SIGN FRAME REQUIRED	REMARKS	SIGN DETAIL		
								"A"	"B"	RETAIN	SALVAGE FROM	SALVAGE TO	REMOVE	RETAIN	REMOVE		1.75	2.00	2.50	3.00	3.50	4.00	5.00			DETAIL IN SHS	DETAIL ON SHEET NUMBER	DETAIL ON STD SHEET NUMBER
																	(LB / FT)			(LB / FT)								
WESTON VT 100							FY-FLUORESCENT YELLOW FYG-FLUORESCENT YELLOW GREEN															"SHS"-STANDARD HIGHWAY SIGNS						
SB	0.145	F	VW-060	30	30	HIDDEN DRIVES																						
SB	0.100	F	VW-202	30	30																							
		F	VW-060	30	30																							
		F	VW-202	30	30																							
NB	3.216	A	VW-054	30	30			6.25																				
		C	VR-052	12	18																							
NB	3.384	A	WII-8	30	30																							
SB	3.298	F	VW-054	30	30			6.25																				
		F	WI-IL	30	30																							
		F	WI3-1	18	18																							
SB	3.220	G	VR-052	12	18			1.50																				
SIGN SUMMARY SHEET							SHEET TOTALS	26.50 12.50	0.00	1 0	2 0	2 0	4 2	0	0	4 2	30											
VERMONT AGENCY OF TRANSPORTATION							TOWN TOTALS	774.4	0.0	26.0	12.0	12.0	139	0.0	0.0	140	2100.0											
PROJECT NAME: Stamford-Andover VT100																					PROJECT NUMBER: STPG SIGN(20)							
FILE NAME: Weston.xls															PLOT DATE: 8/6/2009													
PROJECT MANAGER: N. Avery															DRAWN BY: T. Guazzoni													
DESIGNED BY: J. Kelly															CHECKED BY: T. Guazzoni													
WESTON SHEET 23															SHEET 194 OF 198													