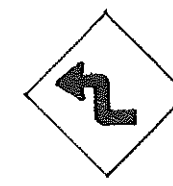


Vermont Agency of Transportation TRAFFIC SHOP WORKORDER													
Route: VT-100		Street Address Range:		SEE P. 1		Town(s): Londonderry (Somerset) D/T: 1310		W.O. No.: 03-433 W.O. Date: 10/19/09					
ID No.	Dir.	M.P.	L	Sign Code	Color	Sign Size	Action	Legend of New Sign	Legend of Existing Sign	Installation Information	New Posts Installed Type	Cuan Length	Anch
	NB	3.283	A	R2-1	8/1	24x36"	NEW	SL 40		SEE SHEET: 75 FT ± NORTH OF Pole # 0/0, INSTALL THIS NEW SL-40. THEN ADJUS THE LAND FOR SB TRAFFIC. INSTALL THIS NEW UPRAD SL-30.			
	SB	3.283	F	R2-1	8/1	30x36"	NEW	SL 30 (30x36")					
9875	SB	3.356	F	W1-3R	8/1	36"	REMOVE			REMOVE THE EXISTING COVE WARNING SIGN AND POST. IN THIS SAME POSITION AS 2 NEW POSTS, INSTALL THE SAVED SPEED REDUCED SIGN PLAN FURNISH ALONG (AT SB 3.563)			
(10555)	V		V	W3-S	8/1	36"	INSTALL SAVED TO		