

# STATE OF VERMONT AGENCY OF TRANSPORTATION




## PROPOSED IMPROVEMENT TOWNS OF DERBY - BLOOMFIELD COUNTIES ORLEANS AND ESSEX VERMONT ROUTE 105

BEGINNING AT THE INTERSECTION OF US ROUTE 105 AND VT ROUTE 111 IN THE TOWN OF DERBY AT MILE MARKER 0.00 AND EXTENDING EASTERLY ALONG VT ROUTE 105 FOR A DISTANCE OF 35.358 MILES TO THE VERMONT - NEW HAMPSHIRE STATE LINE IN BLOOMFIELD AT MILE MARKER 4.262, EXCLUDING CLASS 1 SECTIONS WITHIN THE PROJECT CORRIDOR.


LENGTH OF ROADWAY = 35.358 MILES  
LENGTH OF PROJECT = 34.069 MILES

WORK TO BE PERFORMED UNDER THIS PROJECT INCLUDES THE REMOVAL OF EXISTING SIGNS AND POSTS AND THE INSTALLATION OF NEW SIGNS AND SIGN POSTS AND INCIDENTAL ITEMS.

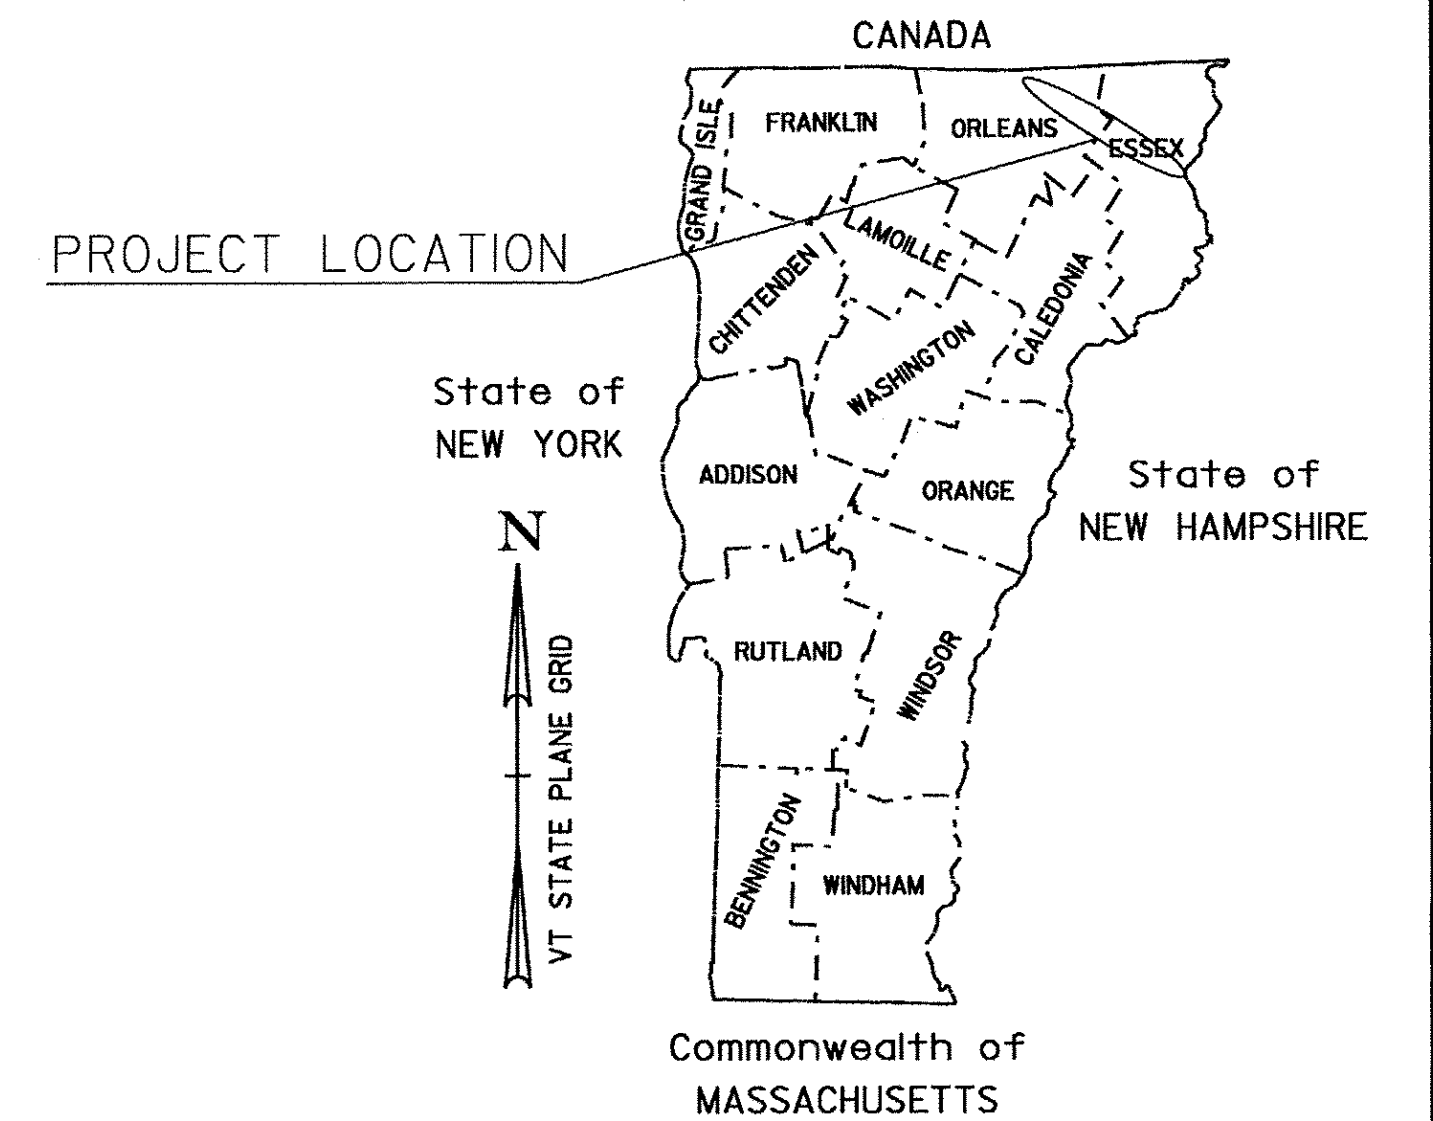

INDEX OF SHEETS  
SEE SHEET 2

| RECORD PLANS   |  |
|--|--|
| CONTRACTOR:  | F. R. LAFAYETTE, INC. - ESSEX JUNCTION, VT |
| RESIDENT ENGINEER:   | SETH HISMAN                                |
| CONSTRUCTION BEGAN:  | SEPTEMBER 16, 2009                         |
| CONSTRUCTION COMPLETE:   | APRIL 25, 2011                             |
| RECORD PLANS BY:   | SETH HISMAN & C. PIERCE                    |
| I HEREBY CERTIFY THAT ALL THE CONSTRUCTION REQUIRED BY THIS SET OF DRAWINGS HAS BEEN ACCOMPLISHED AS INDICATED HEREIN.   |  |
| BY:  | RESIDENT ENGINEER                          |
| DATE:  | 5/17/12                                    |
| NOTE: Any further information concerning final quantities, amounts or other details relative to this project may be found at Central Files in the electronic archives. |  |

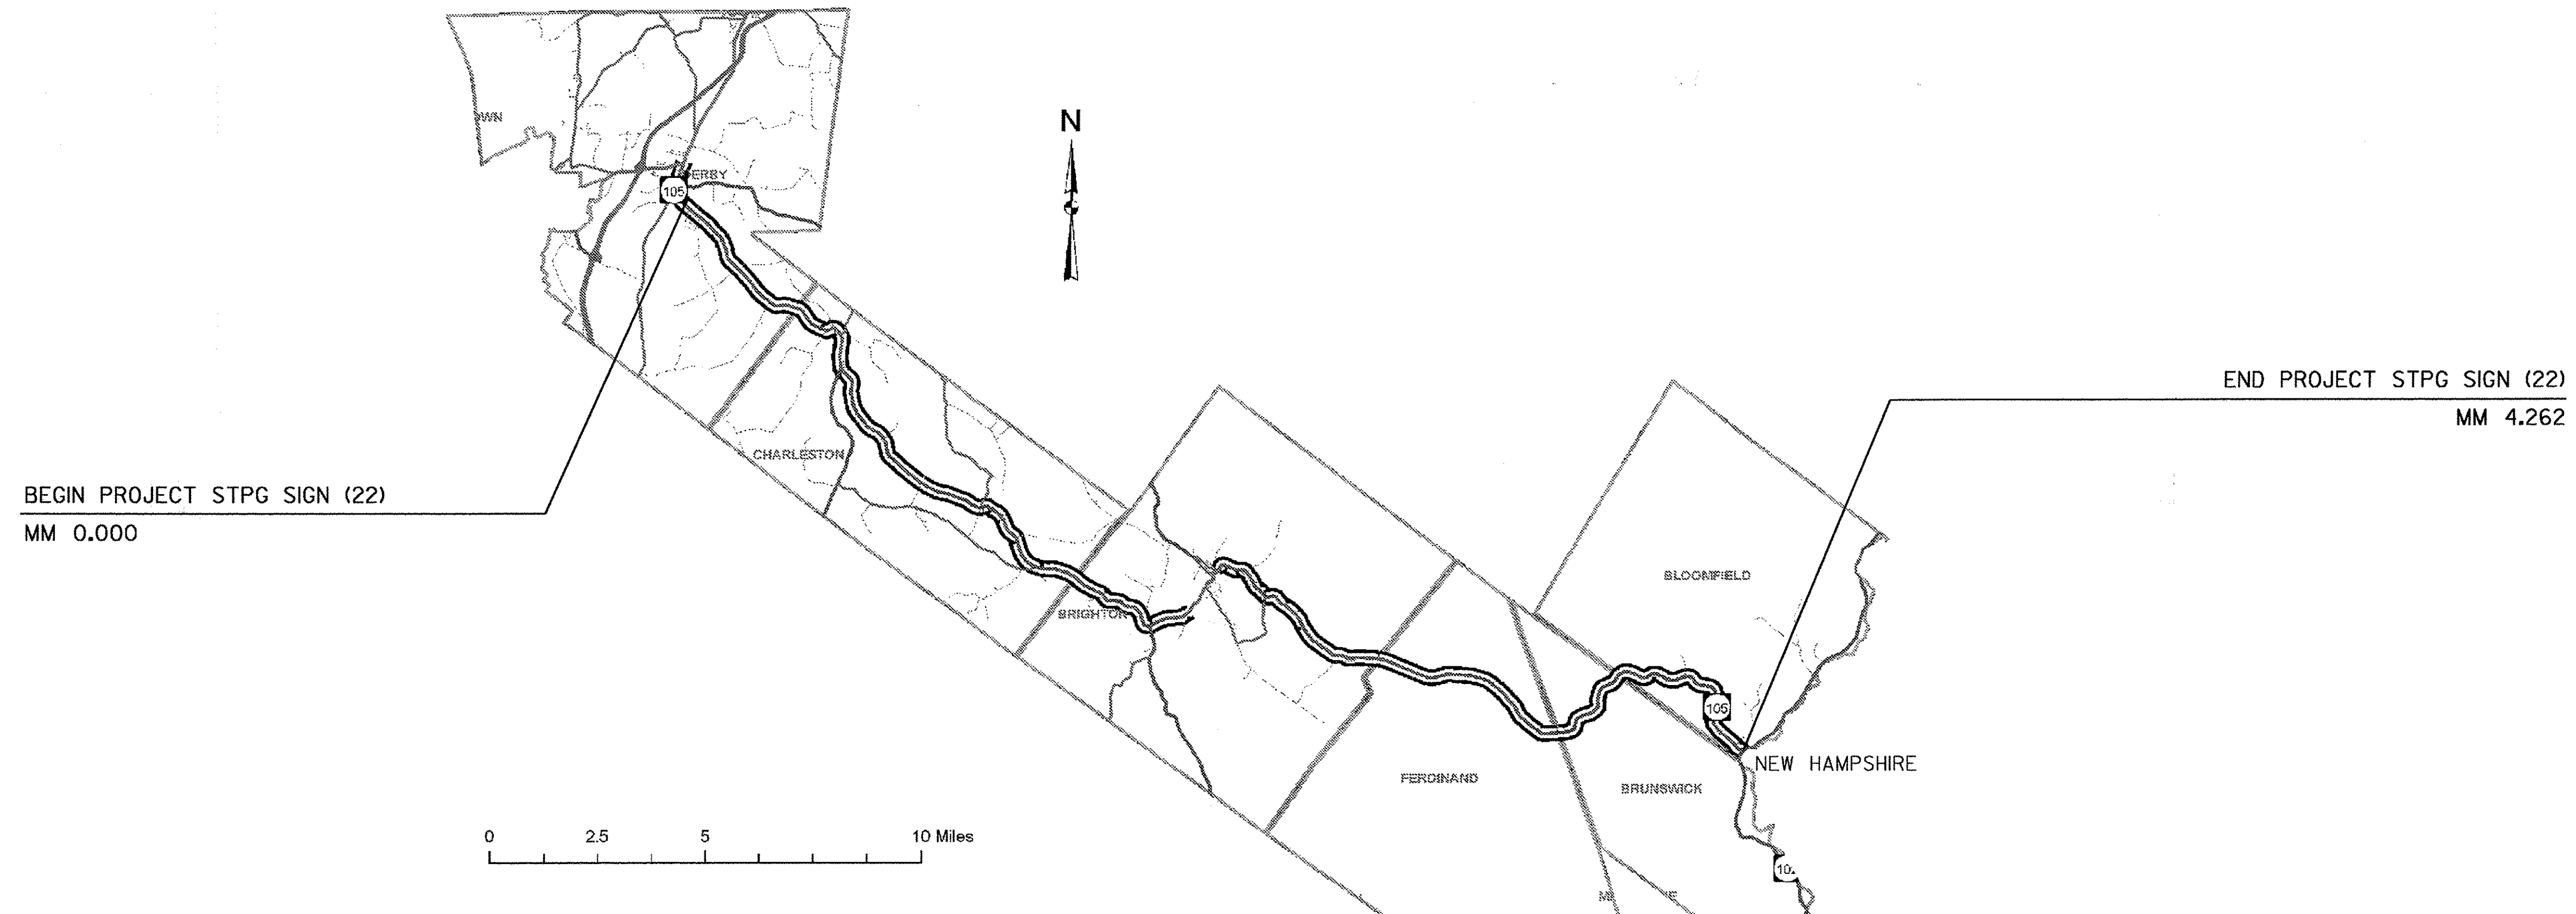

### CONVENTIONAL SYMBOLS

|                    |  |
|--------------------|--|
| COUNTY LINE        |  |
| TOWN LINE          |  |
| LIMITS OF ACCESS   |  |
| POINT OF ACCESS    |  |
| FENCE LINE         |  |
| STONE WALL         |  |
| TRAVELED WAY       |  |
| GUARD RAIL         |  |
| RAILROAD           |  |
| SURVEY LINE        |  |
| CULVERT            |  |
| POWER POLE         |  |
| TELEPHONE POLE     |  |
| TREES              |  |
| CONTROL OF ACCESS  |  |
| PROPERTY LINE      |  |
| R.O.W. TAKING LINE |  |
| SLOPE RIGHTS       |  |
| TOP OF CUT         |  |
| TOE OF SLOPE       |  |

SURVEYED BY : N/A  
SURVEYED DATE : N/A

DATUM  
VERTICAL N/A  
HORIZONTAL N/A

THESE PLANS ARE SUBJECT TO SUCH ENGINEERING CHANGES AS MAY BE REQUIRED BY THE FEDERAL HIGHWAY ADMINISTRATION OR THE DIRECTOR OF PROGRAM DEVELOPMENT.

CONSTRUCTION IS TO BE CARRIED ON IN ACCORDANCE WITH THESE PLANS AND THE STANDARD SPECIFICATIONS FOR CONSTRUCTION DATED 2006, AS APPROVED BY THE FEDERAL HIGHWAY ADMINISTRATION ON JUNE 15, 2006 FOR USE ON THIS PROJECT, INCLUDING ALL SUBSEQUENT REVISIONS AND SUCH REVISED SPECIFICATIONS AND SPECIAL PROVISIONS AS ARE INCORPORATED IN THESE PLANS.

|                                   |            |
|-----------------------------------|------------|
| DIRECTOR OF PROGRAM DEVELOPMENT   |            |
| APPROVED _____                    | DATE _____ |
| PROJECT MANAGER : AMY GAMBLE      |            |
| PROJECT NAME : DERBY - BLOOMFIELD |            |
| PROJECT NUMBER : STPG SIGN (22)   |            |
| SHEET 1 OF 79 SHEETS              |            |