


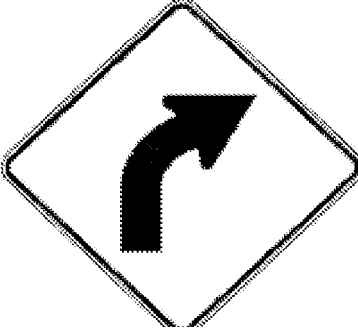




DIRECTION	MILEPOINT	LOCATION CODE (SHEET 2)	SIGN CODE	WIDTH (IN)	HEIGHT (IN)	SHEETING REMARKS	SIGN LEGEND	NEW SIGNS		EXISTING SIGNS				EXIST POST		NUMBER OF NEW POSTS	SQUARE STEEL (IN)			TUBULAR STEEL Ø (IN)				SIGN FRAME REQUIRED	REMARKS	SIGN DETAIL						
								"A"	"B"	RETAIN	SALVAGE FROM	SALVAGE TO	REMOVE	RETAIN	REMOVE		1.75	2.00	2.50	FOUNDATION	3.00	3.50	4.00			5.00	DETAIL IN SHS	DETAIL ON SHEET NUMBER	DETAIL ON STD SHEET NUMBER			
																	(LB / FT)				(LB / FT)											
DERBY VT 105							FY-FLUORESCENT YELLOW FYG-FLUORESCENT YELLOW GREEN															"SHS"-STANDARD HIGHWAY SIGNS										
			F R2-1	30	36			7.50										15.8						INSTALL ACROSS FROM EASTBOUND SPEED LIMIT 50 SIGN.		6						
WB	1.350		F VD-018	30	18			3.75										14						INSTALL BEHIND RAIL, 260 FT ± WEST OF SPEED LIMIT 40 SIGN.			E-128A					
WB	1.275		F R2-5A	24	30		REDUCED SPEED AHEAD						1		X									NOT REQUIRED								
WB	1.200		F R2-1	24	30								1		X																	
			F R2-1	30	36			7.50										14									6					
WB	0.885		F W1-2R	30	30								1		X																	
			F W1-2R	30	30			6.25										15.3								X						
WB	0.830		F R2-1	24	30			5.00 5.00		VANDALISM		I						14						INSTALL BEHIND RAIL 290 FT ± WEST OF CURVE RIGHT SIGN.		X						
WB	0.650		F M2-1	21	15								1		X																	
			F M1-5A	24	24								1																			
			F M2-1	21	15			2.19										11.8						GREEN ON WHITE SHEETING		X						
			F M1-5	30	24			5.00																		E-136B						
WB	0.610		F D1-1A	54	7.5								1		X																	
			F D1-1A	54	7.5								1																			
			F D1-1A	54	7.5								1																			
SIGN SUMMARY SHEET							SHEET TOTALS	42.19 37.19	0.00	0	0	0	9 8	0	0	6										PROJECT NAME: Derby-Bloomfield VT105						
								SF	SF	EA	EA	EA	EA	EA	EA	EA	EA	EA											PROJECT NUMBER: STPG SIGN(22)			
																													FILE NAME: Derby.xls	PLOT DATE: 6/11/2009		
VERMONT AGENCY OF TRANSPORTATION							TOWN TOTALS	421.4	0.0	7.0	1.0	1.0	90	0.0	0.0	62								PROJECT MANAGER: N. Avery	DRAWN BY: T. Guazzoni							
																							DESIGNED BY: M. Miller	CHECKED BY: S. Menard								
																								DERBY SHEET 9	SHEET 16 OF 79							