





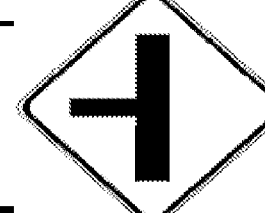


DIRECTION	MILEPOINT	LOCATION CODE (SHEET 2)	SIGN CODE	WIDTH (IN)	HEIGHT (IN)	SHEETING REMARKS	SIGN LEGEND	NEW SIGNS		EXISTING SIGNS				EXIST POST		NUMBER OF NEW POSTS	SQUARE STEEL (IN)			TUBULAR STEEL Ø (IN)				SIGN FRAME REQUIRED	REMARKS	SIGN DETAIL			
								"A"	"B"	RETAIN	SALVAGE FROM	SALVAGE TO	REMOVE	RETAIN	REMOVE		1.75	2.00	2.50	FOUNDATION	3.00	3.50	4.00			5.00	DETAIL IN SHS	DETAIL ON SHEET NUMBER	DETAIL ON STD SHEET NUMBER
																	(LB / FT)				(LB / FT)								
<b>BRIGHTON VT 105</b>							FY-FLUORESCENT YELLOW FYG-FLUORESCENT YELLOW GREEN																"SHS"-STANDARD HIGHWAY SIGNS						
		D	R1-1	30	30			6.25							1		13								X				
EB	0.885	A	W1-6	48	24								1		X														
		A	OM1-1	18	18		CLUSTER						1																
		A	W1-6L	48	24			8.00						2		14	15.5								X				
		B	W1-6R	48	24			8.00						2		14	15.5								X				
EB	0.905	A	W1-8	18	24		CHEVRON					1		X															
EB	0.920	A	W1-8	18	24		CHEVRON					1		X															
		A	W1-6L	48	24			8.00						2		14	14.3								X				
		B	W1-6R	48	24			8.00						2		14	14.3								X				
EB	0.935	A	W1-8	18	24		CHEVRON					1		X															
EB	1.300	A	W11-4	30	30		CATTLE					1		X															
EB	1.340	A	VW-054L	30	30		HIDDEN DRIVE LEFT		6.25				1		X														
		A	VW-060	30	30			6.25						1		14.5	15.8									E-154			
EB	1.720	A	W2-2L	30	30		SIDE ROAD LEFT					1		X															
EB	1.760	A	W2-2MaL	30	30			6.25						1		14.3													
<b>SIGN SUMMARY SHEET</b>							<b>SHEET TOTALS</b>	57 <del>50.75</del>	0.00	0	0	0	8	0	0	11		<del>165</del> 173.2											
								SF	SF	EA	EA	EA	EA	EA	EA	EA		FT											
VERMONT AGENCY OF TRANSPORTATION							<b>TOWN TOTALS</b>	729.8	0.0	4.0	2.0	2.0	165	0.0	0.0	129		1935.0											
																					PROJECT NAME:	<b>Derby-Bloomfield VT105</b>							
																					PROJECT NUMBER:	<b>STPG SIGN(22)</b>							
												FILE NAME:	<b>Brighton.xls</b>			PLOT DATE:	<b>6/11/2009</b>												
												PROJECT MANAGER:	<b>N. Avery</b>			DRAWN BY:	<b>T. Guazzoni</b>												
												DESIGNED BY:	<b>J. Kelly</b>			CHECKED BY:	<b>S. Menard</b>												
												BRIGHTON SHEET 2				SHEET	<b>38</b>		OF	<b>79</b>									