
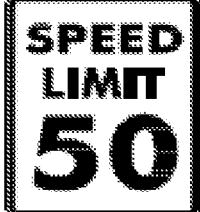


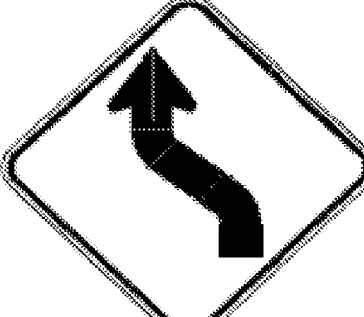
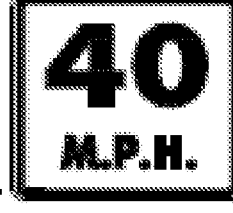



DIRECTION	MILEPOINT	LOCATION CODE (SHEET 2)	SIGN CODE	WIDTH (IN)	HEIGHT (IN)	SHEETING REMARKS	SIGN LEGEND	NEW SIGNS		EXISTING SIGNS				EXIST POST		NUMBER OF NEW POSTS	SQUARE STEEL (IN)			TUBULAR STEEL Ø (IN)				SIGN FRAME REQUIRED	REMARKS	SIGN DETAIL			
								"A"	"B"	RETAIN	SALVAGE FROM	SALVAGE TO	REMOVE	RETAIN	REMOVE		1.75	2.00	2.50	FOUNDATION	3.00	3.50	4.00			5.00	DETAIL IN SHS	DETAIL ON SHEET NUMBER	DETAIL ON STD SHEET NUMBER
																	(LB / FT)				(LB / FT)								
<b>BRIGHTON VT 105</b>							FY-FLUORESCENT YELLOW FYG-FLUORESCENT YELLOW GREEN																"SHS"-STANDARD HIGHWAY SIGNS						
		D	R1-1	30	30			6.25																		X			
EB	4.680	A	R2-1	24	30								1		X														
		A	R2-1	24	30			5.00		VANDALISM																X			
EB	4.770	C	VR-017	24	30								1		X														
		C	VR-017	24	30			5.00																			E-141		
EB	4.785	D	R1-1	30	30								1		X														
		D	R1-1	30	30			6.25																		X			
EB	4.910	A	W1-4L	30	30		LEFT REVERSE CURVE						1		X														
		A	W13-1	18	18		40 MPH PLAQUE 						1																
EB	4.948	A	W1-4L	30	30			6.25																		X			
		A	W13-1	18	18			2.25																		X			
EB	5.084	C	VR-017	24	24								1		X														
		C	VR-017	24	30			5.00																			E-141		
		C	R2-1	24	30		SPEED LIMIT 35				1	1																	
EB	5.080	D	R1-1	24	24								1		X														
<b>SIGN SUMMARY SHEET</b>							SHEET TOTALS	41.00 <del>36.00</del>	0.00	0	1	1	8 <del>7</del>	0	0	6													
VERMONT AGENCY OF TRANSPORTATION							TOWN TOTALS	729.8	0.0	4.0	2.0	2.0	165	0.0	0.0	129													
																	PROJECT NAME:	Derby-Bloomfield VT105											
																	PROJECT NUMBER:	STPG SIGN(22)											
																	FILE NAME:	Brighton.xls					PLLOT DATE:	6/11/2009					
																	PROJECT MANAGER:	N. Avery					DRAWN BY:	T. Guazzoni					
																	DESIGNED BY:	J. Kelly					CHECKED BY:	S. Menard					
																	BRIGHTON SHEET	8					SHEET	44 OF 79					