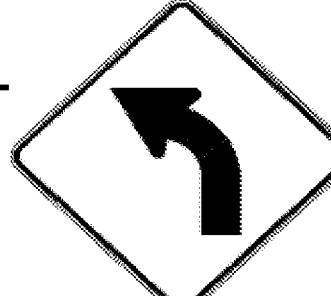

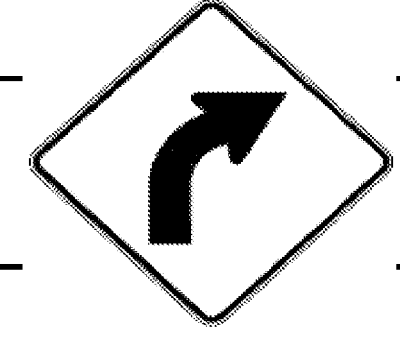
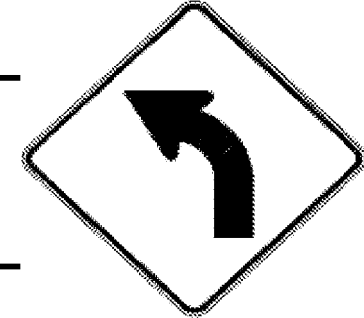


DIRECTION	MILEPOINT	LOCATION CODE (SHEET 2)	SIGN CODE	WIDTH (IN)	HEIGHT (IN)	SHEETING REMARKS	SIGN LEGEND	NEW SIGNS		EXISTING SIGNS			EXIST POST		NUMBER OF NEW POSTS	SQUARE STEEL (IN)			TUBULAR STEEL Ø (IN)				SIGN FRAME REQUIRED	REMARKS	SIGN DETAIL							
								"A"	"B"	RETAIN	SALVAGE FROM	SALVAGE TO	REMOVE	RETAIN		REMOVE	1.75	2.00	2.50	FOUNDATION	3.00	3.50			4.00	5.00	DETAIL IN SHS	DETAIL ON SHEET NUMBER	DETAIL ON STD SHEET NUMBER			
																	(LB / FT)				(LB / FT)											
BRUNSWICK VT 105							FY-FLUORESCENT YELLOW FYG-FLUORESCENT YELLOW GREEN															"SHS"-STANDARD HIGHWAY SIGNS										
EB	0.000	C	VD-024	72	10		BRUNSWICK FERDINAND	5.00						2				12 12 X							4							
		C	VD-700	6	10		1050 0505 0000	0.42																		E-138						
		C	VD-700	6	10		1050 0509 0483	0.42																		E-138						
EB	0.185	A	W1-2L	30	30		LEFT CURVE																									
		A	W13-1	18	18		40 MPH PLAQUE																									
EB	0.285	A	W1-2L	30	30	FY		6.25						1				17.3 X							X		INSTALL 500 FT +/- EAST OF EXISTING					
		A	W13-1	18	18	FY		2.25																	X							
EB	0.320 TO 0.490	A	N/A	6	8		18 WHITE DELINEATORS	6.00						9				7 x 2 6 6.5 x 2 6 6.3 x 3 6.8								5	INSTALL BACK TO BACK AT 100' SPACING, STARTING AT UTIL. POLE TO EXISTING CURVE RT SIGN					
EB	0.490	A	W1-2R	30	30		RIGHT CURVE																									
EB	0.560	A	W1-2R	30	30	FY		6.25						1				15 X							X		INSTALL BETWEEN 2 DRIVES (CIRCULAR DRIVE)					
EB	0.910	A	W1-2L	30	30			6.25						1				15.5 X							X		INSTALL EAST OF WOODS ACCESS WITH CULVERT AND AT BEGINNING OF LEFT CURVE					
EB	0.955 TO 1.035	A	N/A	6	8		10 WHITE DELINEATORS	3.33						5				6.8 x 3 6.5 6.3								5	INSTALL BACK TO BACK AT 100' SPACING, STARTING 450 FT +/- WEST OF GRAVEL PULLOFF TO PULLOFF					
EB	1.090	A	W7-1	30	30																											
		A	W7-2B	18	24																											
SIGN SUMMARY SHEET							SHEET TOTALS	36.17	0.00	0	0	0	5	0	0	19				-285	-163.7											
VERMONT AGENCY OF TRANSPORTATION								SF	SF	EA	EA	EA	EA	EA	EA	EA				FT												
TOWN TOTALS							160.6	0.0	0.0	0.0	0.0	22	0.0	0.0	54				810.0													
															PROJECT NAME:	Derby-Bloomfield VT105																
															PROJECT NUMBER:	STPG SIGN(22)																
															FILE NAME:	Brunswick.xls					PLOT DATE:	6/11/2009										
															PROJECT MANAGER:	N. Avery					DRAWN BY:	I. Shea										
															DESIGNED BY:	M. Miller					CHECKED BY:	S. Menard										
															BRUNSWICK SHEET 1						SHEET	61					OF	79				