
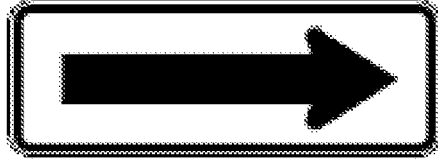



DIRECTION	MILEPOINT	LOCATION CODE (SHEET 2)	SIGN CODE	WIDTH (IN)	HEIGHT (IN)	SHEETING REMARKS	SIGN LEGEND	NEW SIGNS		EXISTING SIGNS			EXIST POST		NUMBER OF NEW POSTS	SQUARE STEEL (IN)			TUBULAR STEEL Ø (IN)				SIGN FRAME REQUIRED	REMARKS	SIGN DETAIL											
								"A"	"B"	RETAIN	SALVAGE FROM	SALVAGE TO	REMOVE	RETAIN		REMOVE	1.75	2.00	2.50	FOUNDATION	3.00	3.50			4.00	5.00	DETAIL IN SHS	DETAIL ON SHEET NUMBER	DETAIL ON STD SHEET NUMBER							
																	(LB / FT)				(LB / FT)															
BRUNSWICK VT 105							FY-FLUORESCENT YELLOW FYG-FLUORESCENT YELLOW GREEN															"SHS"-STANDARD HIGHWAY SIGNS														
WB	0.660 TO 0.590	F		6	8		10 WHITE DELINEATORS	3.33							5	6 x 4 6.3 X										5										
WB	0.650	F	W1-6	48	24							1																								
		F	W1-6L	48	24	FY			8.00						2	13 13.5 X															X					
WB	0.615	E	W1-6R	48	24	FY		8.00						2	12.5 13.5 X																X	INSTALL 80 FT +/- EAST OF EXISTING, BETWEEN 2 CLOSELY SPACED UTILITY POLES				
WB	0.600	E	W1-6	48	24		EB FACING RIGHT ARROW					1																								
WB	0.555	F	W1-2R	30	30		RIGHT CURVE					1																								
		F	W13-1	24	24		40 MPH PLAQUE					1																								
WB	0.495	F	W1-2R	30	30			6.25						1	17 X																X	INSTALL 300 FT +/- WEST OF EXISTING				
		F	W13-1	24	24				4.00																							X				
WB	0.000	G	VD-024	60	7.5		TOWNLINER SIGN																													
SIGN SUMMARY SHEET								SHEET TOTALS		29.58	0.00	0	0	0	7 -5	0	0	10	150-99.8																	
								SF	SF			EA	EA	EA	EA	EA	EA	EA	EA	EA	EA	EA	EA	EA	EA	EA	EA	EA	EA	EA	EA	EA	EA			
								TOWN TOTALS		160.6	0.0	0.0	0.0	0.0	24 -22	0.0	0.0	54	810.0																	
VERMONT AGENCY OF TRANSPORTATION																		PROJECT NAME: Derby-Bloomfield VT105																		
																		PROJECT NUMBER: STPG SIGN(22)																		
																		FILE NAME: Brunswick.xls	PLOT DATE: 6/11/2009																	
																		PROJECT MANAGER: N. Avery	DRAWN BY: I. Shea																	
																		DESIGNED BY: M. Miller	CHECKED BY: S. Menard																	
																		BRUNSWICK SHEET 4	SHEET 64 OF 79																	