




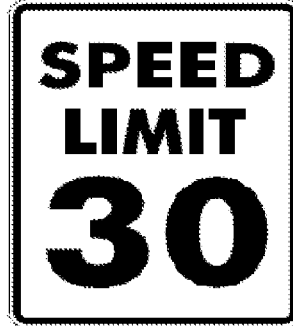


DIRECTION	MILEPOINT	LOCATION CODE (SHEET 2)	SIGN CODE	WIDTH (IN)	HEIGHT (IN)	SHEETING REMARKS	SIGN LEGEND	NEW SIGNS		EXISTING SIGNS				EXIST POST		NUMBER OF NEW POSTS	SQUARE STEEL (IN)			TUBULAR STEEL Ø (IN)				SIGN FRAME REQUIRED	REMARKS	SIGN DETAIL			
								"A"	"B"	RETAIN	SALVAGE FROM	SALVAGE TO	REMOVE	RETAIN	REMOVE		1.75	2.00	2.50	FOUNDATION	3.00	3.50	4.00			5.00	DETAIL IN SHS	DETAIL ON SHEET NUMBER	DETAIL ON STD SHEET NUMBER
																	(LB / FT)				(LB / FT)								
<b>BLOOMFIELD VT 105</b>							FY-FLUORESCENT YELLOW FYG-FLUORESCENT YELLOW GREEN																"SHS"-STANDARD HIGHWAY SIGNS						
EB	4.080	A	R2-1	24	30																								
		A	R2-1	30	36			7.50																		X			
EB	4.108	A	M2-1	21	15		JCT																						
		A	M1-5A	24	24		VERMONT 102																						
		A	M2-1	21	15			2.19																		X			
		A	M1-5	30	24			5.00																			E-136B		
EB	4.142	A	D1-1	72	12																								
		A	D1-1A	72	12																								
		A	D1-1A	72	12																								
		A	D1-1A	72	12																								
		A	D1-1	72	12		STRATFORD 	6.00																					
		A	D1-1A	72	12			6.00																					
		A	D1-1A	72	12			6.00																					
		A	D1-1A	72	12			6.00																					
EB	4.240	A	M3-2	24	12		EAST																						
<b>SIGN SUMMARY SHEET</b>							SHEET TOTALS	44.69 38.69	0.00	0	0	0	9 8	0	0	4 3									PROJECT NAME: <b>Derby-Bloomfield VT105</b>				
								SF	SF	EA	EA	EA	EA	EA	EA	EA								PROJECT NUMBER: <b>STPG SIGN(22)</b>					
VERMONT AGENCY OF TRANSPORTATION							TOWN TOTALS	427.5	0.0	2.0	0.0	0.0	87	0.0	0.0	59								FILE NAME: <b>Bloomfield.xls</b>	PLOT DATE: <b>6/11/2009</b>				
																							PROJECT MANAGER: <b>N. Averv</b>	DRAWN BY: <b>I. Shea</b>					
																							DESIGNED BY: <b>M. Miller</b>	CHECKED BY: <b>S. Menard</b>					
																							BLOOMFIELD SHEET 4	SHEET <b>68</b>	OF <b>79</b>				