
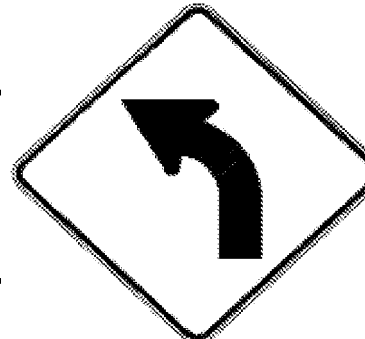


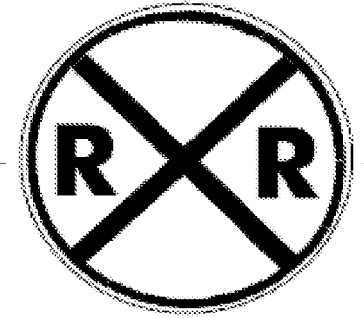
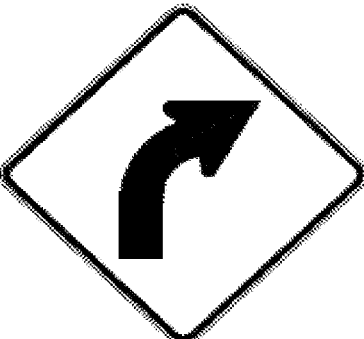
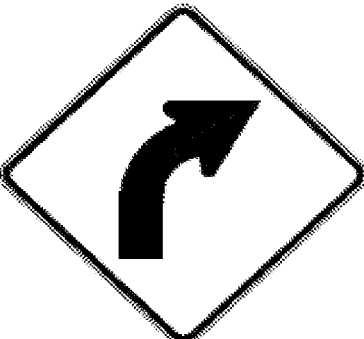


DIRECTION	MILEPOINT	LOCATION CODE (SHEET 2)	SIGN CODE	WIDTH (IN)	HEIGHT (IN)	SHEETING REMARKS	SIGN LEGEND	NEW SIGNS		EXISTING SIGNS			EXIST POST		NUMBER OF NEW POSTS	SQUARE STEEL (IN)			TUBULAR STEEL Ø (IN)				SIGN FRAME REQUIRED	REMARKS	SIGN DETAIL						
								"A"	"B"	RETAIN	SALVAGE FROM	SALVAGE TO	REMOVE	RETAIN		REMOVE	1.75	2.00	2.50	FOUNDATION	3.00	3.50			4.00	5.00	DETAIL IN SHS	DETAIL ON SHEET NUMBER	DETAIL ON STD SHEET NUMBER		
																	(LB / FT)				(LB / FT)										
<b>BLOOMFIELD VT 105</b>							FY-FLUORESCENT YELLOW FYG-FLUORESCENT YELLOW GREEN															"SHS"-STANDARD HIGHWAY SIGNS									
WB	1.685	H	R1-1	24	24																										
		H	R1-1	30	30			6.25																	TH-7, EAST BRANCH RD	X					
WB	1.070	F	W2-1L	30	30			6.25																	INSTALL ACROSS FROM GRAVEL PULLOFF	X					
WB	0.895	F	W11-6H	30	30																										
		F	W11-6H	30	30			6.25																	INSTALL IN CLOSED POSTION						
WB	0.855	F	W1-2R	30	30		RIGHT CURVE																								
		F	W13-1	18	18		35 MPH PLAQUE																								
WB	0.820	F	W10-1	36	36																										
		F	W10-1	36	36			7.07																							
WB	0.780	F	W1-2R	30	30			6.25																	INSTALL BEHIND RAIL EAST OF EASTERLY ABUTMENT OF BRIDGE #96	X					
		F	W13-1	18	18			2.25																							
WB	0.730	G	VR-023B	24	30		\$500 TRASH																								
WB	0.000	G	VD-024	60	7.5		TOWNLIN SIGN																		NEW SIGN WILL BE IN EB DIRECTION						
<b>SIGN SUMMARY SHEET</b>							SHEET TOTALS	34.32	0.00	1	0	0	<del>7</del> -6	0	0	5	<del>75</del> -73.8						PROJECT NAME: <b>Derby-Bloomfield VT105</b>								
							SF	SF	EA	EA	EA	EA	EA	EA	EA	EA	FT						PROJECT NUMBER: <b>STPG SIGN(22)</b>								
VERMONT AGENCY OF TRANSPORTATION							TOWN TOTALS	427.5	0.0	2.0	0.0	0.0	<del>89</del> -87	0.0	0.0	<del>60</del> -59	885.0						FILE NAME: <b>Bloomfield.xls</b>				PLOT DATE: <b>6/11/2009</b>				
																						PROJECT MANAGER: <b>N. Avery</b>				DRAWN BY: <b>I. Shea</b>					
																					DESIGNED BY: <b>M. Miller</b>				CHECKED BY: <b>S. Menard</b>						
																					BLOOMFIELD SHEET 12				SHEET <b>76</b>				OF <b>79</b>		